

Fill out in triplicate.
Make \$15.00 check payable:
Howard County Health Dept. - Sanitation

Signed boundary plat must be submitted by Reg. Eng. or Field Sup.
4-12' *Leads*

APPLICATION

A 17134
P _____

SEWAGE DISPOSAL TESTING

MARYLAND STATE DEPARTMENT OF HEALTH

HOWARD COUNTY

ELLICOTT CITY

DISTRICT FIFTH

DATE MAY 29, 1972

Preliminary

*8/1/72
9:30 - 1:30*

TO: THE COUNTY HEALTH OFFICER
ELLICOTT CITY, MARYLAND

I, HEREBY, APPLY FOR THE NECESSARY TESTS IN ORDER TO CONSTRUCT (OR RECONSTRUCT) A SEWAGE DISPOSAL SYSTEM.

PROPERTY OWNER FREDERICK J. GREEN

ADDRESS 11091 SCAGGSVILLE RD, LAUREL, MD. 20810 PHONE 953-7100 EXT. 541
BUSINESS PHONE
NO HOME PHONE

PROPERTY LOCATION:

SUBDIVISION _____ LOT NO. _____

ROAD AND DESCRIPTION BROWNS BRIDGE ROAD - ABOUT 2 BLOCKS
NORTH OF THE INTERSECTION OF RT. 216 & BROWN BRIDGE RD. ON BROWN BRIDGE RD.

OCCUPANT _____ PHONE _____

PERSON TO CONSTRUCT SYSTEM _____

ADDRESS _____ PHONE _____

SIZE OF LOT 1.437 ACRES TYPE BLDG. 3 Bedroom
NUMBER OF BEDROOMS

IF NOT SINGLE RESIDENCE DESCRIBE _____

SIGNATURE OF APPLICANT Frederick J. Green

APPROVED BY _____ FOR _____ DATE _____
(KIND OF SYSTEM)

REJECTED BY DW Monaghan FOR Septic System DATE 8/1/72
(KIND OF SYSTEM)

HOLD PENDING FURTHER TESTS _____ DATE _____

REASONS FOR REJECTION OR HOLDING 8/1/72 - high water table - poor soil (clg)
5 to 6 ft from grade

THIS IS NOT A PERMIT

APPLICATION

SEWAGE DISPOSAL TESTING

A 17134

P _____

MARYLAND STATE DEPARTMENT OF HEALTH

HOWARD COUNTY

ELLICOTT CITY

DISTRICT FIFTH

DATE May 29, 1972

TO: THE COUNTY HEALTH OFFICER
ELLICOTT CITY, MARYLAND

I, HEREBY, APPLY FOR THE NECESSARY TESTS IN ORDER TO CONSTRUCT (OR RECONSTRUCT) A SEWAGE DISPOSAL SYSTEM.

PROPERTY OWNER FREDERICK J. GREEN

ADDRESS 11091 SCAGGSVILLE RD, LAUREL, MD. 20810 PHONE 953-7100-EXT. 541
Business Phone
No home phone

PROPERTY LOCATION:

SUBDIVISION _____ LOT NO. _____

ROAD AND DESCRIPTION BROWNS BRIDGE RD. - ABOUT 2 BLOCKS NORTH OF RT. 216
ON BROWNS BRIDGE RD. (wooded site) look for stakes

OCCUPANT _____ PHONE with name Green

PERSON TO CONSTRUCT SYSTEM _____

ADDRESS _____ PHONE _____

SIZE OF LOT 1.427 ACRES TYPE BLDG. 3 Bed Rooms
NUMBER OF BEDROOMS

IF NOT SINGLE RESIDENCE DESCRIBE _____

SIGNATURE OF APPLICANT Frederick J. Green

APPROVED BY _____ FOR _____ (KIND OF SYSTEM) DATE _____


REJECTED BY DW Moneyhan FOR Septic System (KIND OF SYSTEM) DATE 8/1/72

HOLD PENDING FURTHER TESTS _____ DATE _____

REASONS FOR REJECTION OR HOLDING 8/1/72 High water table - poor soil (clay)
5 ft up from road

THIS IS NOT A PERMIT

45
 75 - 180
 225
 96
 161

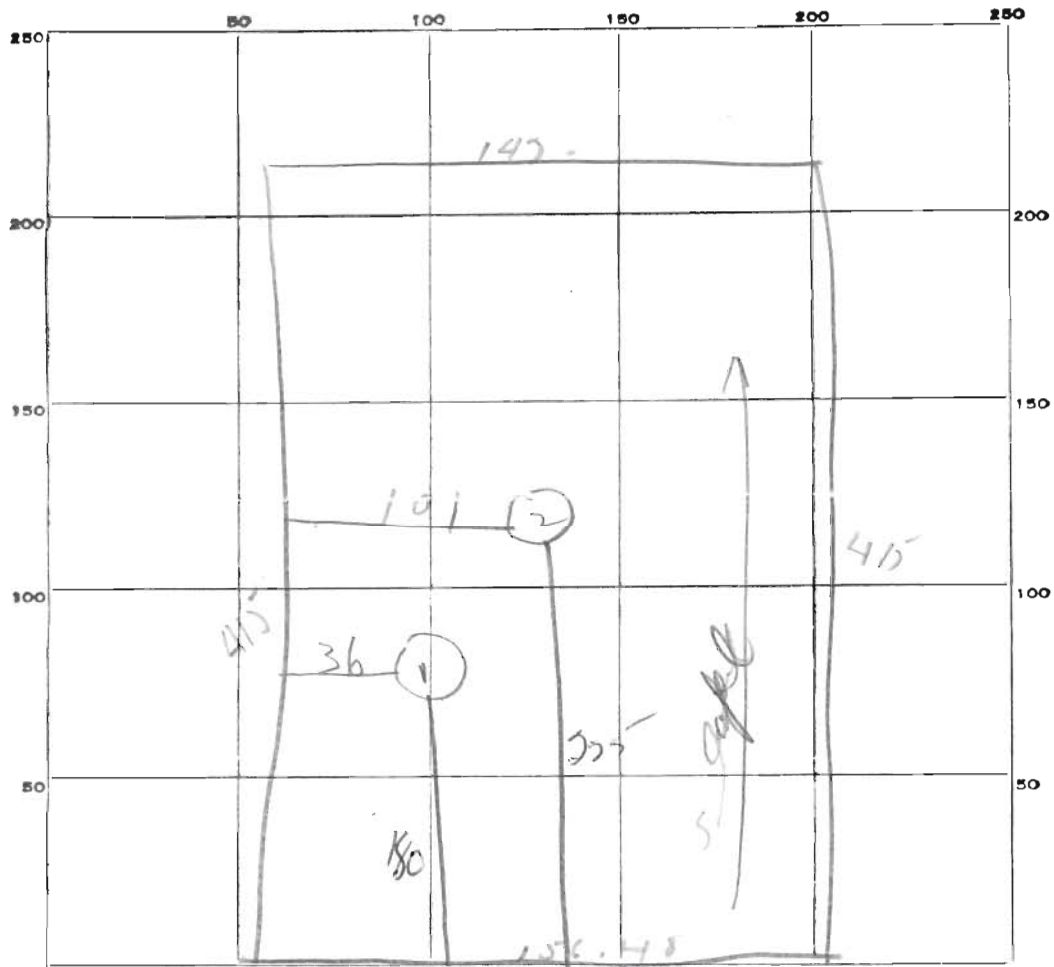

INDICATE NORTH. - NAME ADJOINING ROADWAY AS BASE LINE.

Brown Bridge Rd

DATE	TEST NO.	DEPTH	PRE-WET		TEST - 1" DROP		TIME
			START	STOP	START	STOP	
8/1/74	1	10 ft	first 6 ft clay		19 ft	from grade	
	2	10 ft	first 5 1/2 ft clay			at 8 ft from grade	

SOIL AUGER FINDING _____
 TESTED BY Dum
 REMARKS Pit 1 high - Pit 2 low