

APPLICATION

A 23889

SEWAGE DISPOSAL TESTING

P _____

STATE OF MARYLAND - DEPARTMENT OF HEALTH AND MENTAL HYGIENE

HOWARD COUNTY HEALTH DEPARTMENT
ENVIRONMENTAL HEALTH SERVICES
P. O. BOX 476, ELLICOTT CITY, MARYLAND 21043
TELEPHONE: 465-5000, EXT. 356

DISTRICT 5

DATE 9/8/76

TO: THE COUNTY HEALTH OFFICER
ELLICOTT CITY, MARYLAND

I, HEREBY, APPLY FOR THE NECESSARY TEST IN ORDER TO CONSTRUCT (OR RECONSTRUCT) A SEWAGE DISPOSAL SYSTEM.

PROPERTY OWNER Redmiles Services (David Redmiles)

ADDRESS 7355 Brown Bridge Road, Fulton, Md. 20759 PHONE 286-2328

PROPERTY LOCATION:

SUBDIVISION _____ LOT NO. _____

ROAD AND DESCRIPTION Brown Bridge Road - see plat for directions

SIZE OF LOT 1.427 acres TYPE BLDG. 3 or 4

NUMBER OF BEDROOMS _____

IF NOT SINGLE RESIDENCE DESCRIBE _____

THE SYSTEM INSTALLED UNDER THIS APPLICATION IS ACCEPTABLE ONLY UNTIL PUBLIC FACILITIES BECOME AVAILABLE.

SIGNATURE OF APPLICANT /s/ Mrs. Phyllis Redmiles

APPROVED BY _____ FOR _____ DATE _____
(KIND OF SYSTEM)


REJECTED BY _____ FOR _____ DATE _____
(KIND OF SYSTEM)

HOLD PENDING FURTHER TESTS _____ DATE _____

REASONS FOR REJECTION OR HOLDING _____

THIS IS NOT A PERMIT

A23889

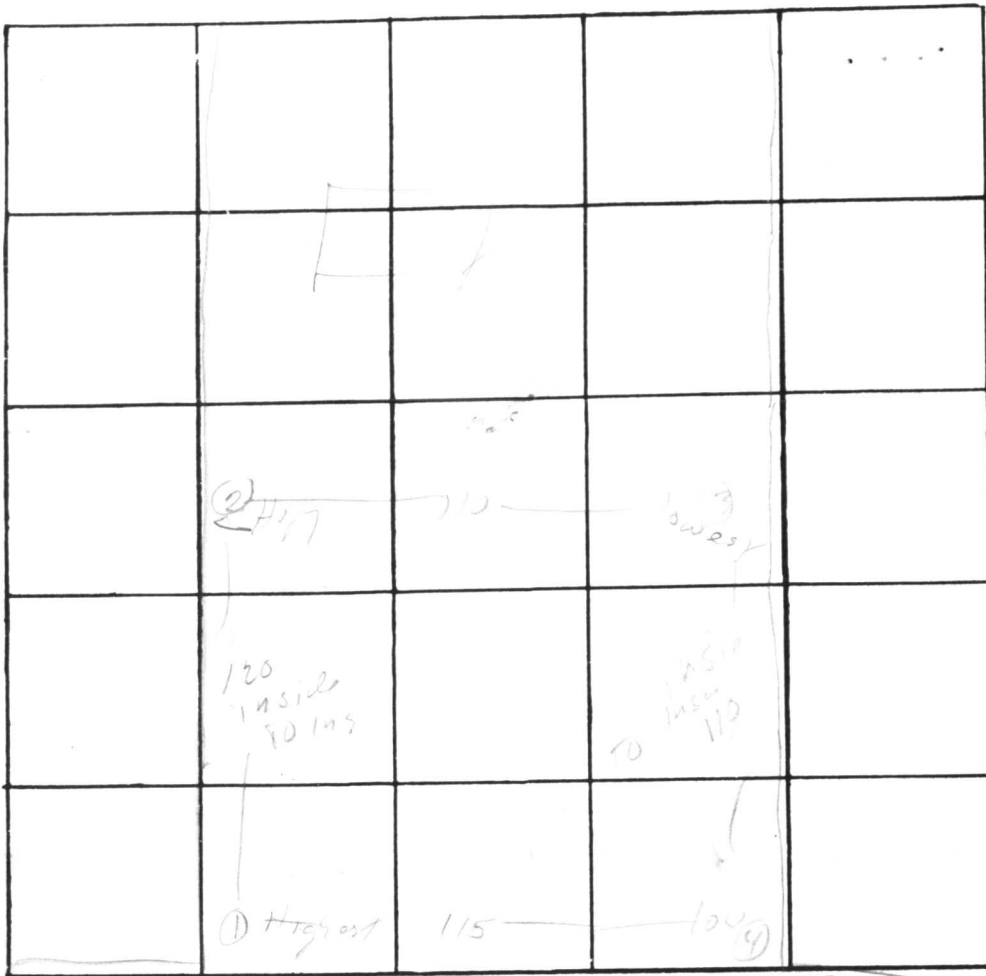

INDICATE NORTH. - NAME ADJOINING ROADWAY AS BASE LINE.

Brown Bull P.

DATE	TEST NO.	DEPTH	PRE-WET		TEST - 1" DROP		TIME
			START	STOP	START	STOP	
9/9	2 S	5'	9 ³⁵	9 ⁴³	9 ⁴³	9 ⁵⁹	14
	d	12'	9 ³⁷	9 ⁴⁰	9 ^{58³⁰}	9 ⁴¹	2 ³⁰
	3 S	6*	9 ⁴⁴	9 ⁵⁰	9 ⁵⁰	10 ⁰⁵	15
	d	13	9 ⁴¹	9 ⁵⁵	9 ⁵²	10 ¹⁵	23
	4 S	4 1/2'	10 ⁰⁰	10 ¹⁰			20 ^{est}
	d	12 1/2'	10 ⁰⁷	10 ¹⁹	10 ¹⁹	10 ²²	3
	1	12' - Visual	Red clay	loam			

14
650
30

REMARKS * good soil starts 5' 1"

TYPE OF SOIL _____


TESTED BY _____ ALSO PRESENT: _____

A23889

PLAN FROM DEED FOR


DAVID L. & PHYLLIS L. REDMILES
FIFTH ELECTION DISTRICT
HOWARD COUNTY, MARYLAND

BROWNS BRIDGE ROAD

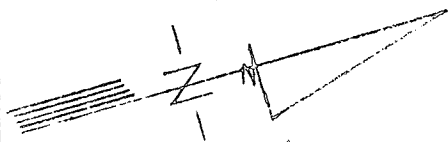

NOTE:

⊕ Denotes percolation test holes.

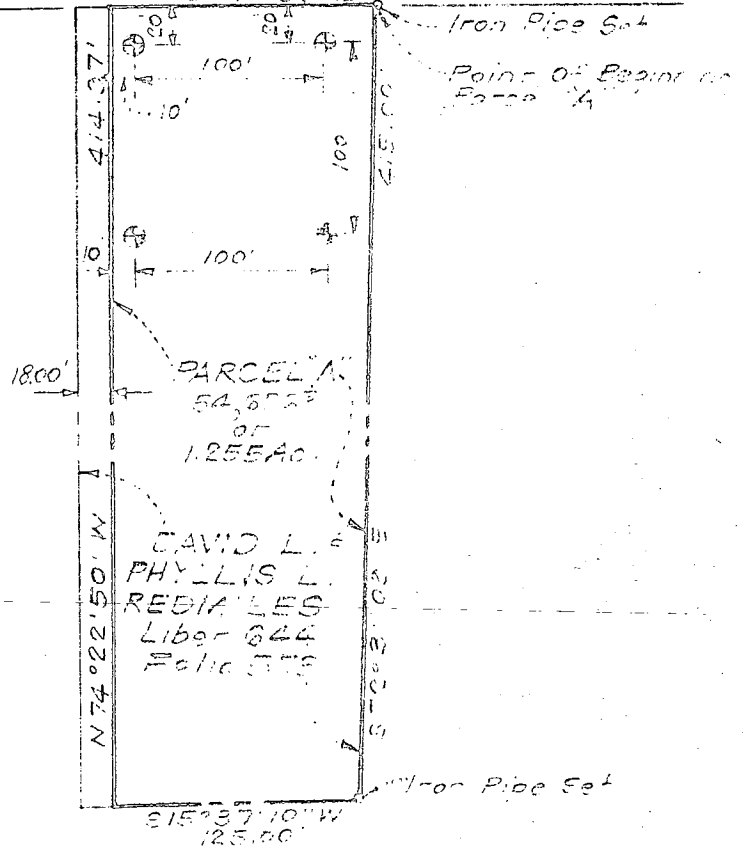

NOTE: The lot shown hereon complies with the minimum ownership and lot area as required by the Maryland State Health Department.

APPROVED:
FOR PRIVATE WATER & PRIVATE SEWER

Donald B. Sackett

[Signature] p/15/76
 HOWARD COUNTY HEALTH OFFICER DATE

CLARK · FINEFROCK & SACKETT ENGINEERS · PLANNERS · SURVEYORS 11315 LOCKWOOD DRIVE SILVER SPRING, MARYLAND 20904 TEL. NO. 893-3400	DRAWN BY <i>KWC</i>	SCALE 1"=100'	DATE Dec., 1976
	CHECKED BY <i>DBS</i>	JOB NO.	FILE NO.
	APPROVED BY		412-L