


A23889

24
26
50

300
492

180
4
720

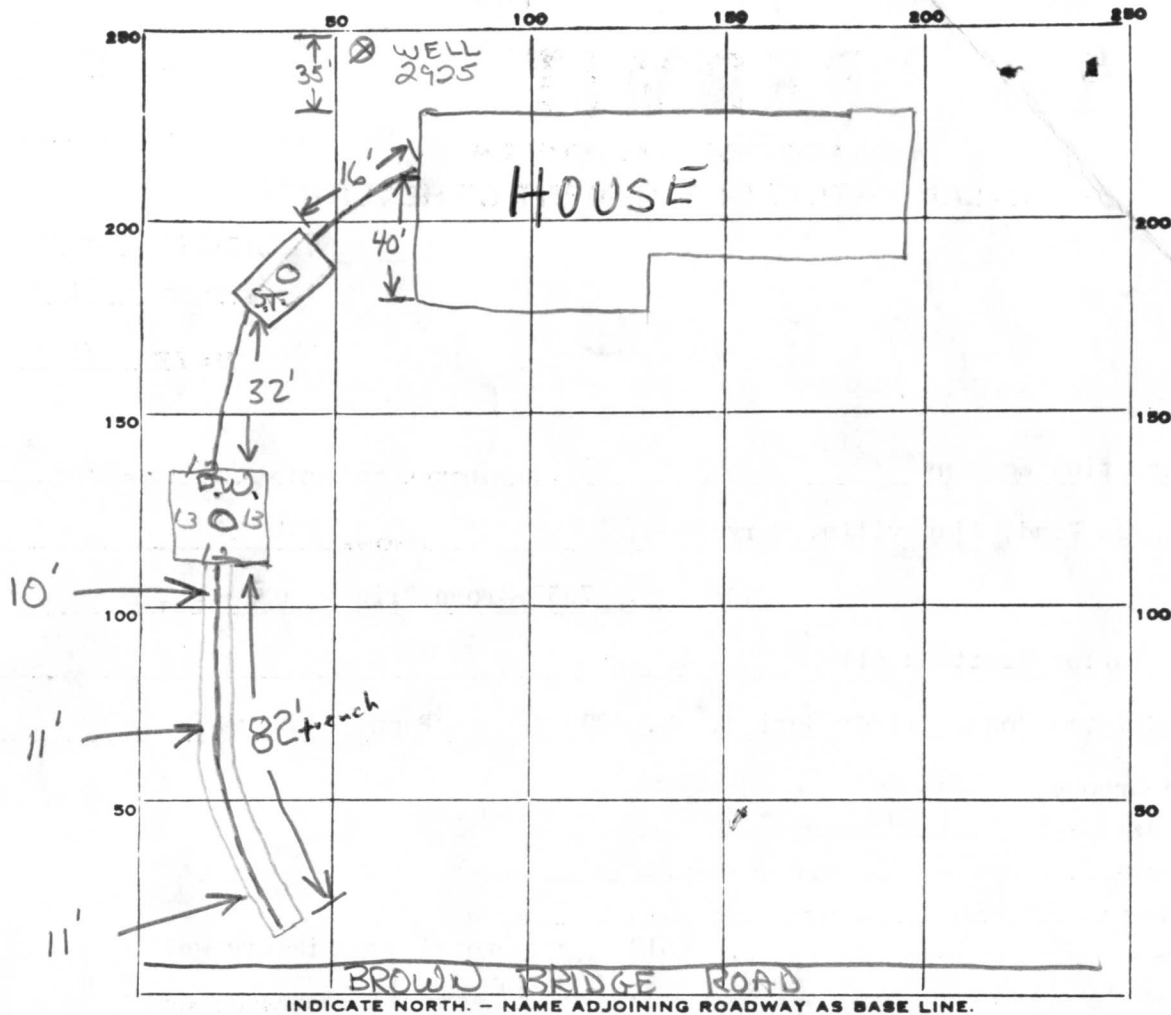

PERMIT CARD

SEPTIC TANK, LEVEL CLEANOUTS

| | |
|-----|-----|
| ST. | DW |
| 4 | 1/2 |

 cast iron

DISTRIBUTION BOX, LEVEL N/A

TILE FIELD, DEPTH 10 1/2 FT. TRENCH WIDTH 2 FT.

GRAVEL DEPTH 6 IN. TOTAL LENGTH 82 FT.

NUMBER OF TRENCHES 1 TOTAL BOTTOM AREA 492

SEEPAGE PITS, INSIDE DIAMETER 50 FT. DEPTH BELOW INLET 6 FT.

ABSORBENT AREA 792 SQ. FT.

REMARKS 9/7/79 - OK TO ADD GRAVEL TO TRENCH P.D. & CRS


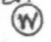
10/30/79 - OK to cover all work of

DATE SYSTEM APPROVED 10/30/79 INSPECTOR J. Stayer



Handwritten initials/signature

A23889

LEGEND:

- 1. Contour Interval 2 Ft
- 2. Exist. Contour $\cdots\cdots\cdots$ 400
- 3. Prop. Contour --- 400
- 4. Spot Elevation + 905
- 5. Direction of Drainage \rightarrow
- 6. Exist. Tree to be Saved 
- 7. Prop. Well 

Note: Property shown is recorded in Liber's 804 & 842 at Folio's 710 & 652.

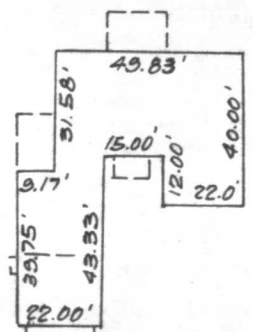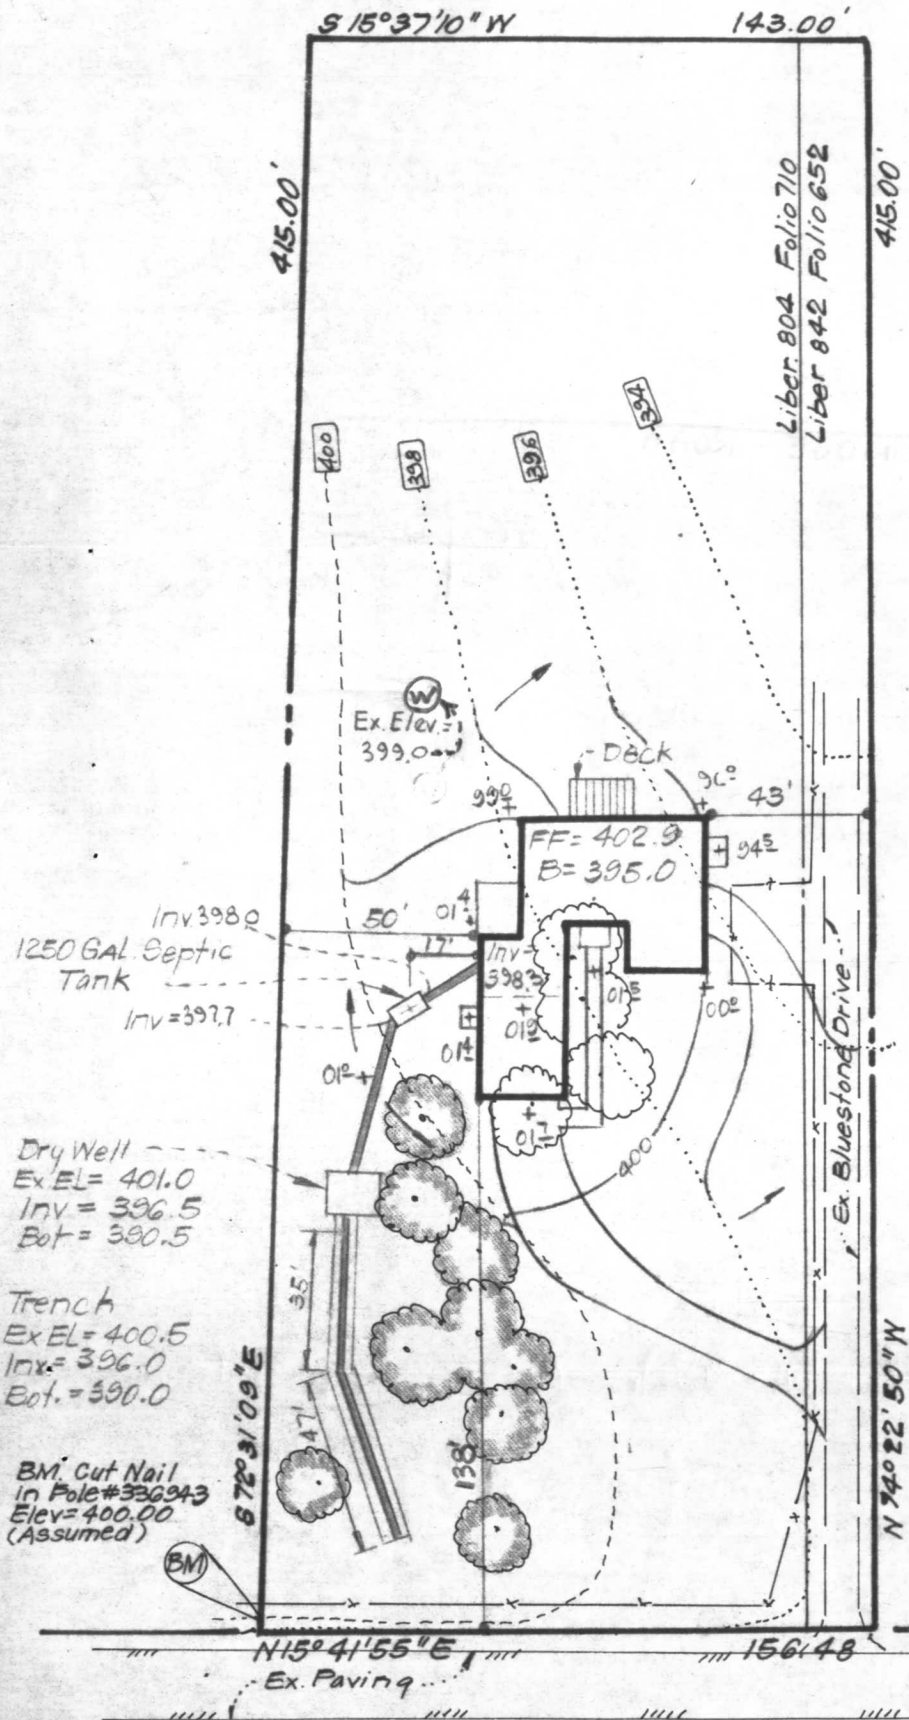

HOUSE DIMENSIONS