

APPLICATION

A 08471

P _____

SEWAGE DISPOSAL TESTING

MARYLAND STATE DEPARTMENT OF HEALTH

HOWARD COUNTY

ELLICOTT CITY

DISTRICT 5DATE 5/25/64

Septic tank - 750 gal.

Leaching bed - 15 ft. wide by 22 ft. long.

Bottom of ground to be from 5 1/2 ft. to

8 1/2 ft. below original grade.

Locate leaching bed in the area between 38 ft. to 88 ft. from back lot line and in the area between 20 ft. to 70 ft. from left side line as lot is seen when facing it from Brown Bridge Road.

TO: THE COUNTY HEALTH OFFICER
ELLICOTT CITY, MARYLAND

I, HEREBY, APPLY FOR THE NECESSARY TESTS IN ORDER TO CONSTRUCT (OR RECONSTRUCT) A SEWAGE DISPOSAL SYSTEM.

PROPERTY OWNER R. H. PhillipsSimpson RoadADDRESS Clarksville, MarylandPHONE AT 6-2677

PROPERTY LOCATION:

SUBDIVISION _____ LOT NO. _____

ROAD AND DESCRIPTION Brown Bridge Road - between Rt. 37 & Hall Shop Rd.216

OCCUPANT _____ PHONE _____

PERSON TO CONSTRUCT SYSTEM _____

ADDRESS _____ PHONE _____


SIZE OF LOT 1 acre TYPE BLDG. 2 NUMBER OF BEDROOMS _____

IF NOT SINGLE RESIDENCE DESCRIBE _____

SIGNATURE OF APPLICANT R. H. PhillipsAPPROVED BY R. J. Lister FOR Leaching Bed DATE 6/3/64
(KIND OF SYSTEM)REJECTED BY _____ FOR _____ DATE _____
(KIND OF SYSTEM)HOLD PENDING FURTHER TESTS R. J. Lister DATE 5/27/64

REASONS FOR REJECTION OR HOLDING _____

THIS IS NOT A PERMIT

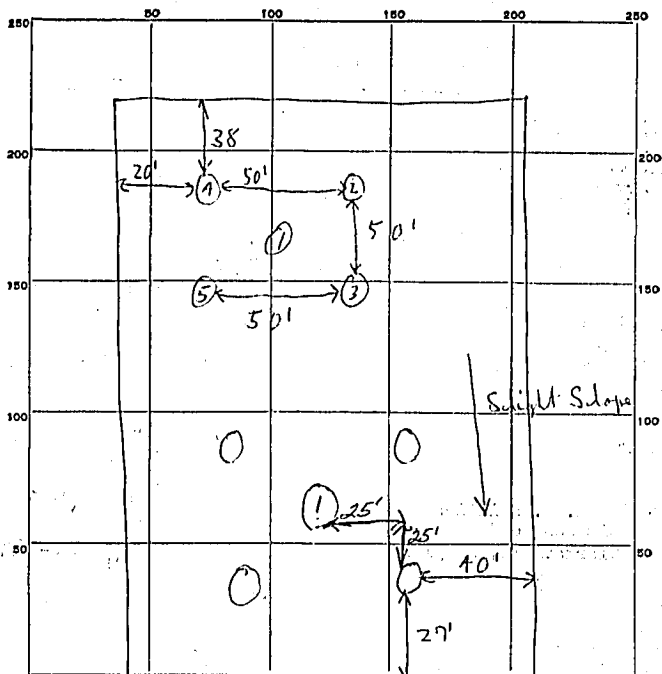

INDICATE NORTH—NAME ADJOINING ROADWAY TO BASE LINE

Brown Bridge Rd.

DATE	TEST NO.	DEPTH	PRE-WET		TEST - 1" DROP		TIME
			START	STOP	START	STOP	
5/21/64	1	water	at	9 ft.			
				1207			
6/3/64	1	9 1/2 ft	1202	1208	1208	1220	12 min.
	2	5 1/2 ft	1207	1212	1212	1220	8 min.
	3	↓	1208	1213	1213	1222	9 min.
	4	↓	1208	1214	1214	1224	10 min.
	5	↓	1208	1216	1216	1225	9 min.
							AP

SOIL AUGER FINDING water at 9 ft. - red clay down to 4 1/2 ft.
 brownish clay very wet from 4 1/2 ft. to water

TESTED BY R D F 5/27/64

R D F 6/3/64

REMARKS

ALSO PRESENT R Heppner Phillips LOT NO. South Section