


COUNTY #

SOIL PROFILE

0' 1220 1221B
 3' 1218
 3 1/2' 1217
 1214
 1222
 1223
 pink
 tan
 yellow
 salm
 10-15%
 frags

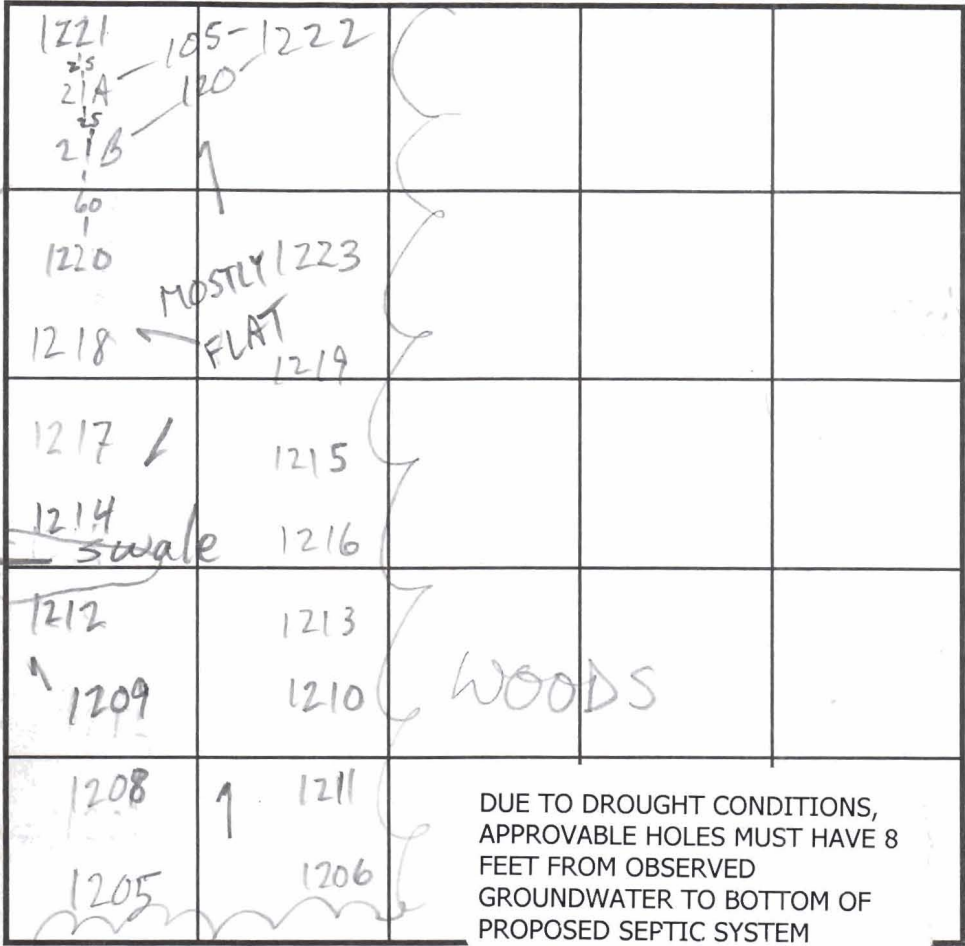

SOIL PROFILE

0' 1221
 4-5' brn red
 cl lm
 15-20% frags
 tan sa
 lm
 30-40%
 structured
 frags
 11' HARD BOT
 1221A
 brn saclm
 15% frags
 3 1/2' brn salm
 15% frags
 5 1/2' 40% + Rx
 7'

INDICATE NORTH - NAME ADJOINING ROADWAY AS BASE LINE.

DATE	TEST NO.	DEPTH	PRE-WET		TEST - 1" DROP		TIME	
			START	STOP	START	STOP		
5/15/01	1221 V	12" 11	FAIL DUE TO HEAVY Rock Structure					
	1220	4 1/2' 13 1/2	3:13	3:14	3:14	3:18	4	
	1218	3' 9" 14 1/2	3:21	3:28	3:28	3:32	4	
	1221A	7	FAIL RX					
	1221B	12' 4"	OK					
	1217	4' 14	3:51	3:54	3:54	3:59	5	
	1214	5' 12 1/2	3:56	3:59	3:59	4:03	4	
5/16/01	1212	5' 5 1/2" 13 1/2	10:09	10:17	slow 1/2" or less 10:31	10:43	12	
	1209	4 1/2' 13 1/2	10:13	10:18	10:18	10:28	10	
	1208	5' 14	10:33	10:38	10:38	10:46	8	

REMARKS ALL HOLES PER PLAN, EXCEPT 1221A, 1221B

TYPE OF SOIL _____
 TESTED BY M. Ritkin ALSO PRESENT M. Johnson
 TRENCH DESIGN DATA: AVERAGE PERCOLATION TIME _____ TRENCH WIDTH _____
 INLET DEPTH _____ MAXIMUM BOTTOM DEPTH _____ SQ. FT./BEDROOM _____

COUNTY #

SOIL PROFILE

Empty rectangular box for soil profile notes.

Empty rectangular box for soil profile notes.

Empty rectangular box for soil profile notes.

SOIL PROFILE

Empty rectangular box for soil profile notes.

DUE TO DROUGHT CONDITIONS, APPROVABLE HOLES MUST HAVE 8 FEET FROM OBSERVED GROUNDWATER TO BOTTOM OF PROPOSED SEPTIC SYSTEM

INDICATE NORTH - NAME ADJOINING ROADWAY AS BASE LINE.

DATE	TEST NO.	DEPTH	PRE-WET		TEST - 1" DROP		TIME
			START	STOP	START	STOP	
5/1/01	1205	5' 14"	10:42	10:47	10:42	10:53	6
	1206	5' 8" 14"	10:50	10:53	10:53	11:08	5
	1207	5' 3" 14"	10:59	11:00	11:00	11:02	2
	1210	5' 14"	11:04	11:05	11:05	11:08	3
	1213	5' 14"	11:07	11:10	11:10	11:10	0
	1216	5' 14"	11:12	11:12	11:12	11:21	5
	1215	5' 14"	11:18	11:20	11:20	11:36	13
	1219	5' 14"	11:21	11:24	11:24	11:30	6
	1223	5' 14"	11:26	11:27	11:27	11:31	4
	1222	5' 14"	11:34	11:38	11:38	11:43	5

4

REMARKS _____

TYPE OF SOIL _____

TESTED BY M. R. R. R. ALSO PRESENT M. Johnson

TRENCH DESIGN DATA: AVERAGE PERCOLATION TIME _____ TRENCH WIDTH _____


INLET DEPTH 4 1/2 MAXIMUM BOTTOM DEPTH 6 1/2 SQ. FT./BEDROOM _____

HEATHERWOOD
SECTION 7, AREA 1
PLAT No. 4401

PLAT No. 4401

LOT 16
HEATHERWOOD
SECTION 7, AREA 1
PLAT No. 4400

P-02-05
SIGNED 9/04/02

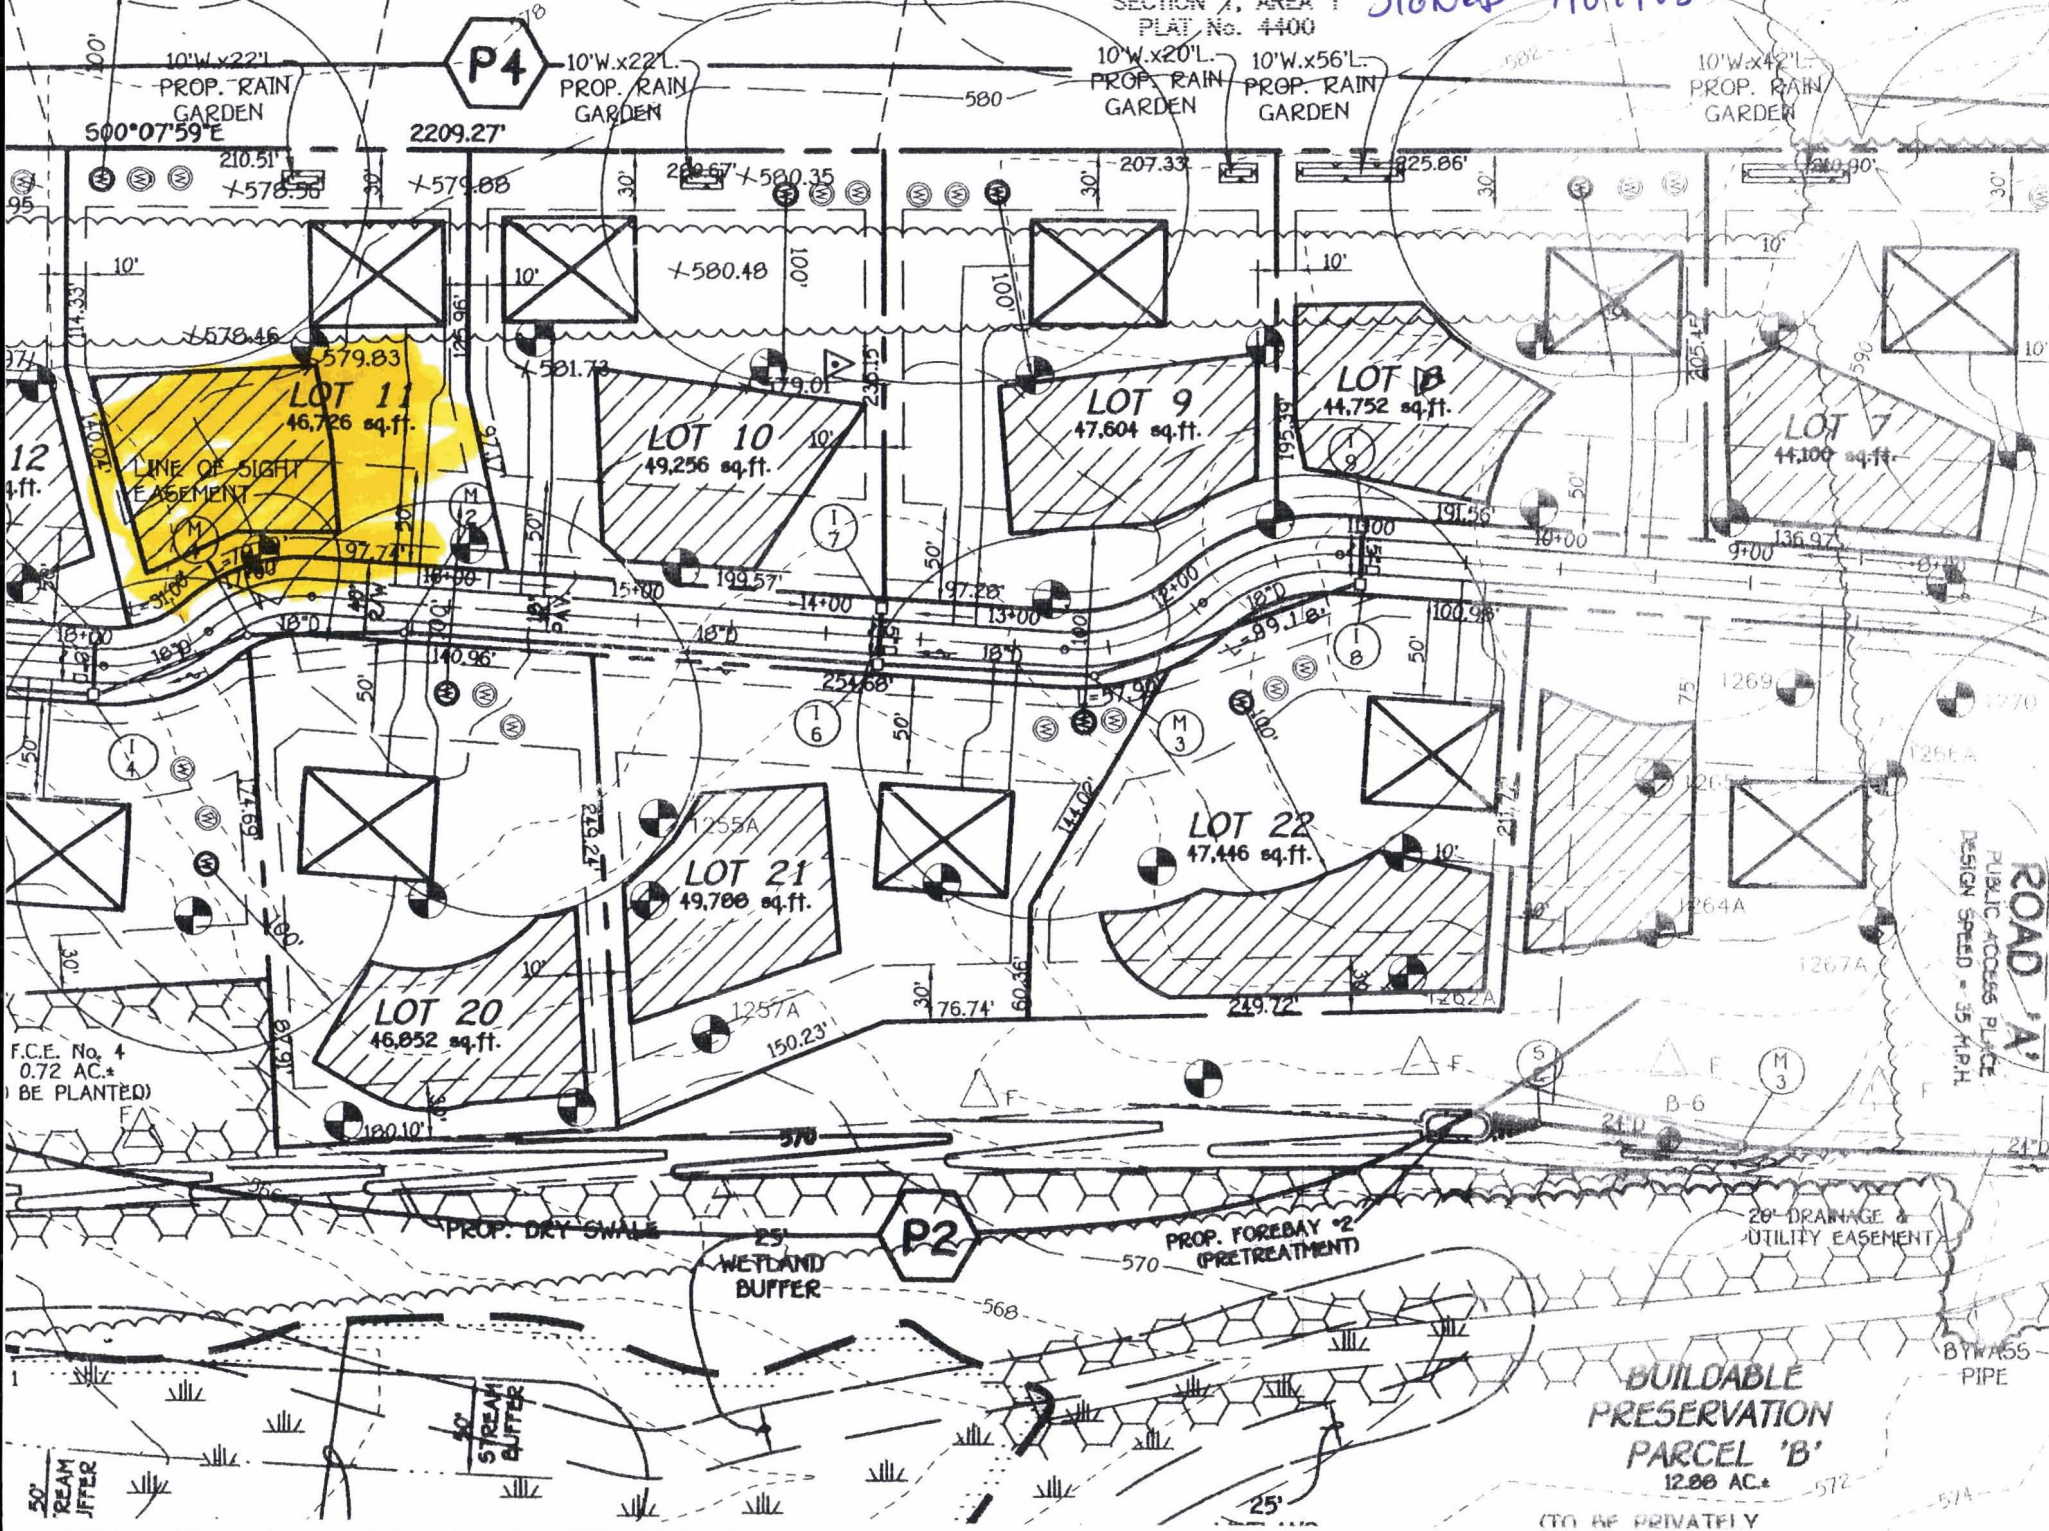

ROAD 'A'
PUBLIC ACCESS PLACE
DESIGN SPEED = 35 MPH

BUILDABLE
PRESERVATION
PARCEL 'B'
12.00 AC.±

(TO BE PRIVATELY)

Copy of signed perc cert
4/21/03

