

3/17/65
etcw 147m

PERMIT

SEWAGE DISPOSAL SYSTEM

P-08649

A-08471

MARYLAND STATE DEPARTMENT OF HEALTH

HOWARD COUNTY

ELLCOTT CITY

DISTRICT 5

INDEXED

DATE 6/19/64

R. H. Phillips IS PERMITTED TO INSTALL ALTER

ADDRESS Simpson Road, Clarksville, Maryland PHONE AT 6-2677

A SEWAGE DISPOSAL SYSTEM LOCATED AT _____

SUBDIVISION _____ ROAD Brown Bridge LOT _____

PROPERTY OWNER R. H. Phillips

ADDRESS same as above

SPECIFICATIONS 3 bedrooms

DRAIN FIELD _____ DEPTH _____ FEET, BOTTOM AREA _____ SQ. FT.

SEEPAGE PITS _____ ABSORBENT SIDE-WALL AREA _____ SQ. FT.

SEPTIC TANK CAPACITY 750 GALLONS

FOR GARBAGE GRINDER, INCREASE DISPOSAL AREA 22% & TANK CAPACITY 50%.


OTHER Leaching bed - 15 ft. wide by 22 ft. long. Bottom of gravel to be from 5 1/2 ft. to 6 1/2 ft. below original grade. Locate leaching bed in the area between 38 ft. to 88 ft. from back lot line and in the area between 20 ft. to 70 ft. from left side line as lot is seen when facing it from Brown Bridge Road.

PLANS APPROVED BY R. D. Fletcher DATE 6/3/64

FILL SEPTIC TANK AND DISTRIBUTION BOX WITH WATER BEFORE CALLING FOR AN INSPECTION. COVER NO WORK UNTIL INSPECTED AND APPROVED.

NEITHER THE HOWARD COUNTY COMMISSIONERS NOR THE HEALTH DEPARTMENT IS RESPONSIBLE FOR THE SUCCESSFUL OPERATION OF ANY SYSTEM.

11-80
08471

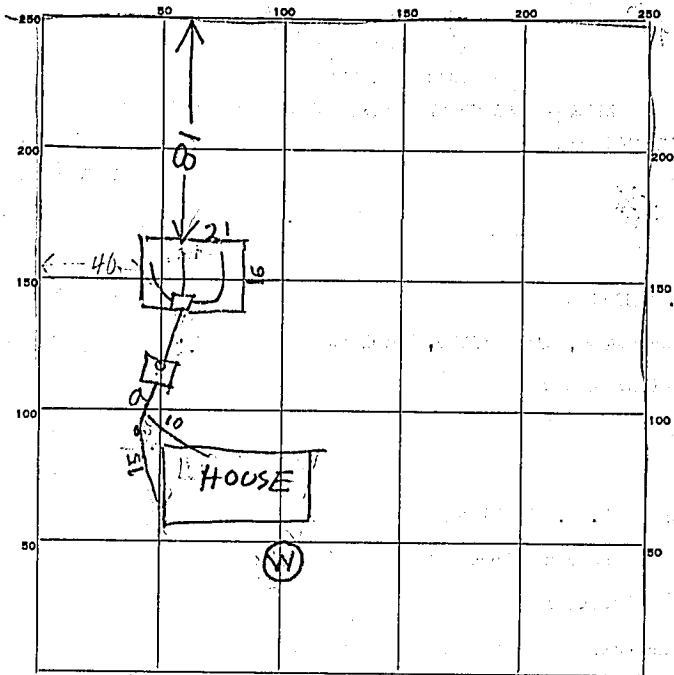

INDICATE NORTH. - NAME ADJOINING ROADWAY AS BASE LINE.

PERMIT CARD _____

SEPTIC TANK, LEVEL OK 750 concrete CLEANOUTS OK

DISTRIBUTION BOX, LEVEL _____

TILE FIELD, DEPTH 5-6 FT. TRENCH WIDTH 16 FT.

GRAVEL DEPTH 3 ft probably IN. TOTAL LENGTH 21 FT.

NUMBER OF TRENCHES _____ TOTAL BOTTOM AREA 346

SEEPAGE PITS, INSIDE DIAMETER _____ FT. DEPTH BELOW INLET _____ FT.

ABSORBENT AREA _____ SQ. FT.

REMARKS _____

DATE SYSTEM APPROVED 17 MAR 65 INSPECTOR Raymond Hodges

31
 7/8
 126
 21
 346
 01

22
 15
 7-0