

APPLICATION

SEWAGE DISPOSAL TESTING

MARYLAND STATE DEPARTMENT OF HEALTH

HOWARD COUNTY

ELLICOTT CITY

DISTRICT 5

DATE 2-16-59

March 2

*Holding
for ch*

9:30

*Dry Well 414 sq ft sidewalk area below top 3' of clay
Place the Dry Well behind the house*

TO: THE COUNTY HEALTH OFFICER
ELLICOTT CITY, MARYLAND

I, HEREBY, APPLY FOR THE NECESSARY TESTS IN ORDER TO CONSTRUCT (OR RECONSTRUCT) A SEWAGE DISPOSAL SYSTEM.

PROPERTY OWNER

Jett Hubert F.

ADDRESS

6895 Redtop Rd. Takoma Park - Apt. 5

PHONE

(None)

PROPERTY LOCATION:

SUBDIVISION

Greenwood Farms

LOT NO.

Lot 11 - Sect 2

ROAD AND DESCRIPTION

Green Lane - Brown Bridge Rd.

OCCUPANT

PHONE

PERSON TO CONSTRUCT SYSTEM

ADDRESS

PHONE

SIZE OF LOT

951 x

1 acre plus

TYPE BLDG

residence (3)

NUMBER OF BEDROOMS

IF NOT SINGLE RESIDENCE DESCRIBE

SIGNATURE OF APPLICANT

Hubert F. Jett

APPROVED BY

Raymond Hodge

FOR

Dry Well

DATE

7/16/59

REJECTED BY

FOR

(KIND OF SYSTEM)

DATE

HOLD PENDING FURTHER TESTS


DATE

REASONS FOR REJECTION OR HOLDING

THIS IS NOT A PERMIT

20521

A#00521

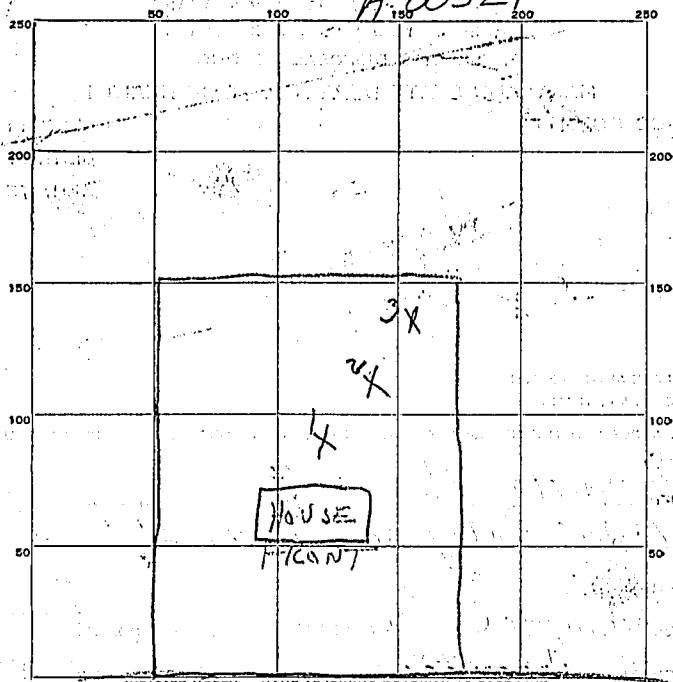

INDICATE NORTH - NAME ADJOINING ROADWAY AS BASE LINE.

BROWN BRIDGE RD.

DATE	TEST NO.	DEPTH	PRE-WET		TEST - 1" DROP		TIME
			START	STOP	START	STOP	
3-2-59	1	2 1/2'	9:46				
	2		9:48				
	3	3 1/2'	9:49	10:16	10:16		
	1	3 1/2'	10:04	10:13	10:13	10:27	14 1/2 minutes
	2		10:12	10:47	10:47	over	40 "
	3		11:03	No Perm.			
7/16/59	7	9.11	12:59	12:07	12:07	12:14	14 min

SOIL AUGER FINDING \odot Top 3' clay Bottom 6' sand

TESTED BY J. Hennigan

REMARKS #9 hole in same location as #1 2 ft deep

ALSO PRESENT 11 Hubert St Lot #11 sect 2
711615 9 Hubert St Lot #11