

9/25/01
L. Wright

10/3/01-PM

03-317277

ISSUE DATE: 9/5/2001

P 516018-A

APPROVAL DATE: 10/3/01

A 38138

PERMIT INDEXED

ON-SITE SEWAGE DISPOSAL SYSTEM HOWARD COUNTY HEALTH DEPARTMENT BUREAU OF ENVIRONMENTAL HEALTH

Fogles Septic Clean, Inc _____ IS PERMITTED TO INSTALL ALTER

ADDRESS: 580 Obrecht Road, Sykesville PHONE NUMBER: 410-795-5670

SUBDIVISION: Meadowood LOT NUMBER: 58

ADDRESS: 1360 Crows Foot Road PROPERTY OWNER: Zeskind

SEPTIC TANK CAPACITY (GALLONS): 1000 (TOPSEAM)

TANK DEPTH &

PUMP CHAMBER CAPACITY (GALLONS): N/A

LOCATION.

NUMBER OF BEDROOMS: 3

CRITICAL

SQUARE FEET PER BEDROOM: 180

- WORK OUT DURING LAYOUT -

LINEAR FEET OF TRENCH REQUIRED: 135

TRENCHES:	Trench to be 2.0 feet wide. Inlet 3.5 feet below original grade. Bottom maximum depth 7.5 feet below original grade. Effective area begins at 3.5 feet below original grade. 4.0 feet of stone below distribution pipe.
LOCATION:	Beginning from the intersection of the 394.54' and 465.95' lot lines, begin trenches 130 feet up the 394.54' lot line and 100 feet off that same lot line. Run trenches on contour toward the house.
NOTES:	TANKS TO BE SET SO AMOUNT OF COVER TO LIDS IS NO > THAN 3' (THREE)

PLANS APPROVED: Amy Mc Millen OK SRK 6/28/01 DATE: 6-27-01


- NOTE: PERMIT VOID AFTER 2 YEARS
- NOTE: CONTRACTOR RESPONSIBLE FOR SCHEDULING A PRE-CONSTRUCTION INSPECTION FOR ALL INSTALLATIONS
- NOTE: WATERTIGHT SEPTIC TANKS REQUIRED
- NOTE: ALL PARTS OF SEPTIC SYSTEM SHALL BE 100 FEET FROM ANY WATER WELL
- NOTE: MANHOLE RISERS REQUIRED ON ALL SEPTIC TANKS AND PUMP CHAMBERS

NEITHER THE HOWARD COUNTY COUNCIL NOR THE HEALTH DEPARTMENT IS RESPONSIBLE FOR THE SUCCESSFUL OPERATION OF ANY SYSTEM PERMITTEE RESPONSIBLE FOR OBTAINING FINAL APPROVAL ON THIS PERMIT CALL 410-313-2640 FOR INSPECTION OF SEPTIC SYSTEM

A38138

6' Snyder
Schedule 35

NOT TO SCALE

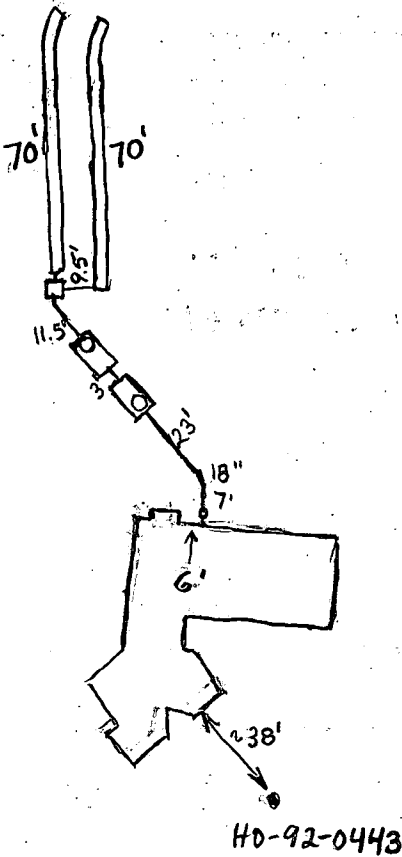

TRENCH DATA

TRENCH WIDTH 2'
 TRENCH INLET DEPTH 3.5'-4.5'
 TRENCH BOTTOM DEPTH 7.5'-8.5'
 DEPTH OF STONE 4'
 NUMBER OF TRENCHES 2
 TOTAL TRENCH LENGTH 140'
 ABSORBENT AREA 560 sq. ft.
 DISTRIBUTION BOX LEVEL Yes
 BAFFLE IN DISTRIBUTION BOX Levelers

SEPTIC TANK DATA

SEPTIC TANK 1250 Plastic GALLONS
 MANHOLE RISER Yes
 6 INCH INSPECTION PORT No

PUMP CHAMBER DATA

PUMP CHAMBER GALLONS 1250 Plastic
 MANHOLE RISER Yes
 ALARM N/A
 PUMP PERFORMANCE TEST N/A

PRE-CONSTRUCTION INSPECTION: To Crows Foot Road 9/25/01 To install 2 - 70' trenches.

Distribution box to be placed directly following second septic tank

INSPECTION COMMENTS: in order to keep trenches as high as possible. (BB)

10/3/01 Two 1250 gallon plastic tanks used. First tank ~ 3.5' below grade.

Upper trench 1' deeper than lower trench to make gravity. O.K. to cover everything. (BB)

INSPECTOR B. Baker

DATE SYSTEM APPROVED 10/3/01

HOWARD COUNTY HEALTH DEPARTMENT
 Bureau of Environmental Health
 3520-N Ellicott Mills Drive
 Ellicott City, MD 21043
 313-2640 ~~ext-9555~~ 313-2648 (fax)

APPLICATION FOR PITLESS ADAPTER, WELL PUMP AND PRESSURE TANK INSTALLATION

New Installation
 Replacement

Receipt #
 Date 7-29-02

Name of installer D.B. ROCKWOOD PLBA INC

Telephone 410-857-4648

License Number 8439

Certified Well Pump Installer

Well Driller

Registered Plumber

Name of Property Owner Richard Zaskind

Telephone 410-747-3273

Subdivision Meadowood Lot # 58

Well Tag # 10926193

Site Address 1360 Crows Feet

Pump

1. Type
 - a. Deep well jet
 - b. Shallow well jet
 - c. Submersible
2. Make Jacuzzi

Motor

1. Horsepower 3/4
2. RPM
3. Voltage
 - a. 110
 - b. 220

Pitless Adapter

1. Make American Grundy
2. Model # PT800
3. Depth 48"

3. Model # TS4512P-SZ
4. Capacity 5 GPM

5. Pump exceeds well capacity Yes No
6. If Yes, is low pressure cutoff switch installed? Yes No
7. What methods are used to protect the pump and electrical wiring from vibrations? Torque arrestors Cable guards Other

Tank

1. Capacity PM036
2. Pressure relief valve? yes

Piping

1. Type 300 PSI
2. Size 1"
3. NSF and/or BUCACode approved yes
4. Depth of supply line 365'

Well data

1. Depth 400 ft.
2. Yield 2 GPM
3. Static water level 27 ft.
4. Will water supply be disinfected by installer? yes

I understand that it is my responsibility to notify the Howard County Health Department when the installation is ready for inspection (otherwise this permit is null and void).

All information given above is true to the best of my knowledge.

Signature of Applicant: D.B. Rockwood

Date: 4/30/02

Note: A sticker indicating approval/status of the installation will be placed on the well casing at the time of the inspection.

HD-215

9/28/01 **(BB)** SRM
 OK

C1 0525

SEQUENCE NO. (DENV USE ONLY)

STATE OF MARYLAND WELL COMPLETION REPORT

FILL IN THIS FORM COMPLETELY PLEASE PRINT OR TYPE

THIS REPORT MUST BE SUBMITTED WITHIN 45 DAYS AFTER WELL IS COMPLETED.

COUNTY NUMBER

A# 38138

ST/CO USE ONLY

DATE RECEIVED

DATE WELL COMPLETED

Depth of Well

PERMIT NO. FROM "PERMIT TO DRILL WELL"

DATE RECEIVED grid

DATE WELL COMPLETED grid: 062794

Depth of Well grid: 400

PERMIT NO. grid: 40-92-0443

OWNER: SPENTING HILL ASSOC last name: CRAWL first name: FORT TOWN: CYRUSVILLE SUBDIVISION: MEADOWWOOD SECTION: 21 LOT: 50

WELL LOG Not required for driven wells STATE THE KIND OF FORMATIONS PENETRATED, THEIR COLOR, DEPTH, THICKNESS AND IF WATER BEARING

Table with columns: DESCRIPTION (Use additional sheets if needed), FEET (FROM, TO), Check if water bearing. Rows include: TOP SOIL (0-2), Sandy clay (2-6), brown shale (6-15), Sandstone (15-35), Mica (25-55), Sandstone (55-56), Mica (56-400).

GROUTING RECORD WELL HAS BEEN GROUTED (Circle appropriate box) TYPE OF GROUTING MATERIAL CEMENT CM BENTONITE CLAY BC NO. OF BAGS 14 NO. OF POUNDS 1400 GALLONS OF WATER 70 DEPTH OF GROUT SEAL (to nearest foot) from 0 ft. to 52 ft.

CASING RECORD casing types insert appropriate code below ST CO STEEL CONCRETE PL OT PLASTIC OTHER MAIN CASING TYPE ST Nominal diameter top (main) casing (nearest inch) 6 Total depth of main casing (nearest foot) 58

OTHER CASING (if used) diameter inch depth (feet) from to

SCREEN RECORD screen type or open hole insert appropriate code below ST BR HO STEEL BRASS BRONZE OPEN HOLE PL OT PLASTIC OTHER

DEPTH (nearest ft.) grid: 40, 45, 400

A A WELL WAS ABANDONED AND SEALED WHEN THIS WELL WAS COMPLETED E ELECTRIC LOG OBTAINED P TEST WELL CONVERTED TO PRODUCTION WELL

I HEREBY CERTIFY THAT THIS WELL HAS BEEN CONSTRUCTED IN ACCORDANCE WITH COMAR 26.04.04 "WELL CONSTRUCTION" AND IN CONFORMANCE WITH ALL CONDITIONS STATED IN THE ABOVE CAPTIONED PERMIT, AND THAT THE INFORMATION PRESENTED HEREIN IS ACCURATE AND COMPLETE TO THE BEST OF MY KNOWLEDGE.

DRILLERS IDENT. NO. 40 DRILLERS SIGNATURE (MUST MATCH SIGNATURE ON APPLICATION)

SITE SUPERVISOR (sign. of driller or journeyman responsible for sitework if different from permittee)

SLOT SIZE 1 2 3 DIAMETER OF SCREEN (NEAREST INCH) grid: 56 to 60

GRAVEL PACK IF WELL DRILLED-WAS FLOWING WELL INSERT F IN BOX 68

OEP USE ONLY (NOT TO BE FILLED IN BY DRILLER) T (E.R.O.S.) WQ (74-75-76) TELESCOPE CASING LOG INDICATOR OTHER DATA

PUMPING TEST HOURS PUMPED (nearest hour) 6 PUMPING RATE (gal. per min. to nearest gal.) 7 METHOD USED TO MEASURE PUMPING RATE float WATER LEVEL (distance from land surface) BEFORE PUMPING 27 WHEN PUMPING 176 TYPE OF PUMP USED (for test) C centrifugal R rotary O other (describe below) J jet S submersible

PUMP INSTALLED DRILLER WILL INSTALL PUMP YES NO IF DRILLER INSTALLS PUMP, THIS SECTION MUST BE COMPLETED FOR ALL WELLS EXCEPT HOME USE TYPE OF PUMP INSTALLED PLACE (A,C,J,P,R,S,T,O) IN BOX - SEE ABOVE: 29 CAPACITY: GALLONS PER MINUTE (to nearest gallon) 31-35 PUMP HORSE POWER 37-41 PUMP COLUMN LENGTH (nearest ft.) 43 CASING HEIGHT (circle appropriate box and enter casing height) + above } LAND SURFACE 2 (nearest foot) - below }

LOCATION OF WELL ON LOT SHOW PERMANENT STRUCTURE SUCH AS BUILDING, SEPTIC TANKS, AND/OR LANDMARKS AND INDICATE NOT LESS THAN TWO DISTANCES (MEASUREMENTS TO WELL) Well 75' side line 500' CRAWL FORT RD.

SAT 7-9-94

Spring Hill Assoc

Review OK 9/30/94 DKS

FIELD DATA SHEET
HOWARD COUNTY WELL YIELD TEST

Well Permit No. HO - 92-0443
 Location of property (road) CROWS FOOT ROAD
 Subdivision MEADOWOOD Lot 58 Block - Plat - Sec. 2
 Well Driller G. EASTERDAY Owner SPRING HILL ASSOC

Depth of well 400 29PM
 Distance of measuring point (M.P.) above ground, + 2
 Static water level (S.W.L.) below M.P. 27

I. High rate pumping -- reservoir drawdown

Time pump started 7:30 AM Pumping rate 10 gpm
 Total time 45 mins to reach pumping water level 177 ft. below M.P.

II. Recovery pump test data - observations to be recorded every 15 minutes

TIME (in 15 minute intervals)	WATER LEVEL below M.P.	PUMPING RATE time to fill 1 gallon bucket	FLOW METER READING (if used)	CALCULATED FLOW (gallons per minute)
8:30	177	30 SEC.		2
8:45	177	30 SEC.		2
9:00	177	30 SEC.		2
9:15	177	30 SEC.		2
9:30	177	30 SEC.		2
9:45	177	30 SEC.		2
10:00	177	30 SEC.		2
10:15	177	30 SEC.		2
10:30	176	30 SEC.		2
10:45	176	30 SEC.		2
11:00	176	30 SEC.		2
11:15	176	30 SEC.		2
11:30	176	30 SEC.		2
11:45	176	30 SEC.		2
12:00	176	30 SEC.		2
12:15	176	30 SEC.		2
12:30	176	30 SEC.		2
12:45	176	30 SEC.		2
1:00	176	30 SEC.		2
1:15	175	30 SEC.		2
1:30	175	30 SEC.		2
1:45	175	30 SEC.		2
2:15	175	30 SEC.		2
2:30	175	30 SEC.		2

B 1 **05492** SEQUENCE NO. (DP USE ONLY)
1 2 3 4 5 6
(THIS NUMBER IS TO BE PUNCHED IN COLS. 3-6 ON ALL CARDS)


STATE OF MARYLAND
PERMIT TO DRILL WELL
please print or type

STATE PERMIT NUMBER
HO-92-0443
70 fill in this form completely 79

Date Received (APA) **062493**
8 13
OWNER INFORMATION
SPRINGHILL ASSOC
15 Last Name Owner First Name 34
1432 RT 32
36 Street or RFD 55
SYKESVILLE MD 21784
57 Town 70 State 72 Zip 76

B 3 LOCATION OF WELL
1 2
HOWARD
8 COUNTY 21
MEADOWOOD
23 SUBDIVISION 42
SECTION **2** LOT **58**
44 46 48 50
SYKESVILLE
52 NEAREST TOWN 71
MILES FROM TOWN (enter 0 if in town) **2** M I
73 76 77 78

DRILLER INFORMATION
George F. Easterday
Driller's Name 40
L. Franklin Easterday, Inc.
Firm Name 77 License No. 80
9265 Brown Church Rd., Mt. Airy, Md. 21771
Address
Signature *George F. Easterday* Date

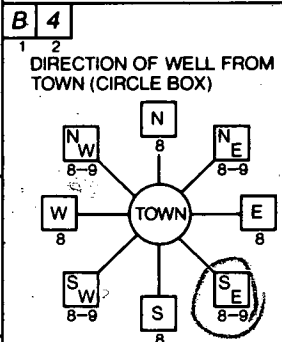

CROWS FOOT
11 NEAR WHAT ROAD 30
ON WHICH SIDE OF ROAD (CIRCLE APPROPRIATE BOX)

34 **500** 37
DISTANCE FROM ROAD
ENTER FT OR MI **FT**
38 39

B 2 WELL INFORMATION
1 2
APPROX. PUMPING RATE (GAL. PER MIN.) **5**
8 12
AVERAGE DAILY QUANTITY NEEDED (GAL. PER DAY) **500**
14 20

NOT TO BE FILLED IN BY DRILLER HEALTH DEPARTMENT APPROVAL
HOWARD **A 3813A**
COUNTY NAME COUNTY NO.
STATE SIGNATURE _____ INSERT S 41
DATE ISSUED **083193** *Charles J. ...* 18/31/94
43 48 CO SIGNATURE EXP. DATE
NORTH GRID **540000** EAST GRID **0818000**
50 55 57 63

USE FOR WATER (CIRCLE APPROPRIATE BOX)
 D HOME (SINGLE OR DOUBLE HOUSEHOLD UNIT ONLY)
 F FARMING (LIVESTOCK WATERING & AGRICULTURAL IRRIGATION)
22 I INDUSTRIAL, COMMERCIAL, STATE AND FEDERAL GOV. OTHER (REQUIRES APPROPRIATION PERMIT)
 P PUBLIC OR PRIVATE WATER COMPANY (REQUIRES APPROPRIATION PERMIT AND STATE HEALTH DEPARTMENT APPROVAL)
 T TEST, OBSERVATION, MONITORING (MAY REQUIRE APPROPRIATION PERMIT)

APPROXIMATE DEPTH OF WELL **200** FEET
24 28

SHOW MAJOR FEATURES OF BOX & LOCATE WELL WITH AN X
SOURCES OF DRILLING WATER
1. wells
2. *58' casing*
52' open hole
10 bags
3. WRITE THE BOX NUMBER FROM THE MAP HERE

DRAW A SKETCH BELOW SHOWING LOCATION OF WELL IN RELATION TO NEARBY TOWNS AND ROADS AND GIVE DISTANCE FROM WELL TO NEAREST ROAD JUNCTION
6/27/94 10:30 grout
tag checked location OK
6/27/94 DKS


APPROXIMATE DIAMETER OF WELL **6** INCH
NEAREST INCH


METHOD OF DRILLING (circle one)
BORED (or Augered) JETTED Jetted & DRIVEN
30 AIR-ROTary AIR-PERcussion ROTARY (Hydraulic Rotary)
37 CABLE REVerse-ROTary Drive-POINT
other _____

REPLACEMENT OR DEEPEMED WELLS (CIRCLE APPROPRIATE BOX)
 N THIS WELL WILL NOT REPLACE AN EXISTING WELL
 Y THIS WELL WILL REPLACE A WELL THAT WILL BE ABANDONED AND SEALED
39 S THIS WELL WILL REPLACE A WELL THAT WILL BE USED AS A STANDBY
 D THIS WELL WILL DEEPEM AN EXISTING WELL
PERMIT NUMBER OF WELL TO BE REPLACED OR DEEPEMED (IF AVAILABLE) 41 _____ 52

Not to be filled in by driller (OEP USE ONLY)
APPROP. PERMIT NUMBER _____ GAP _____
54 63
FORCE WRITE INITIALS IN BOX PERMIT No. **HO-92-0443**
67 68 70 71 72 73 74 75 76 77 78 79

SPECIAL CONDITIONS

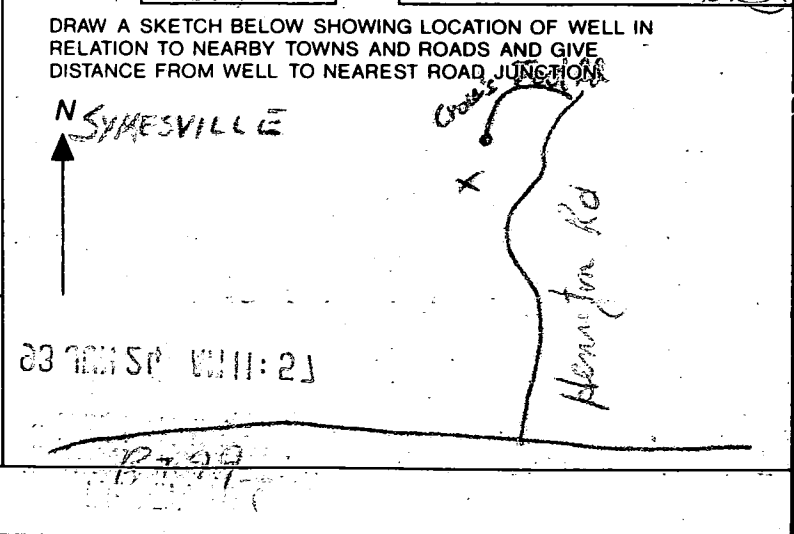

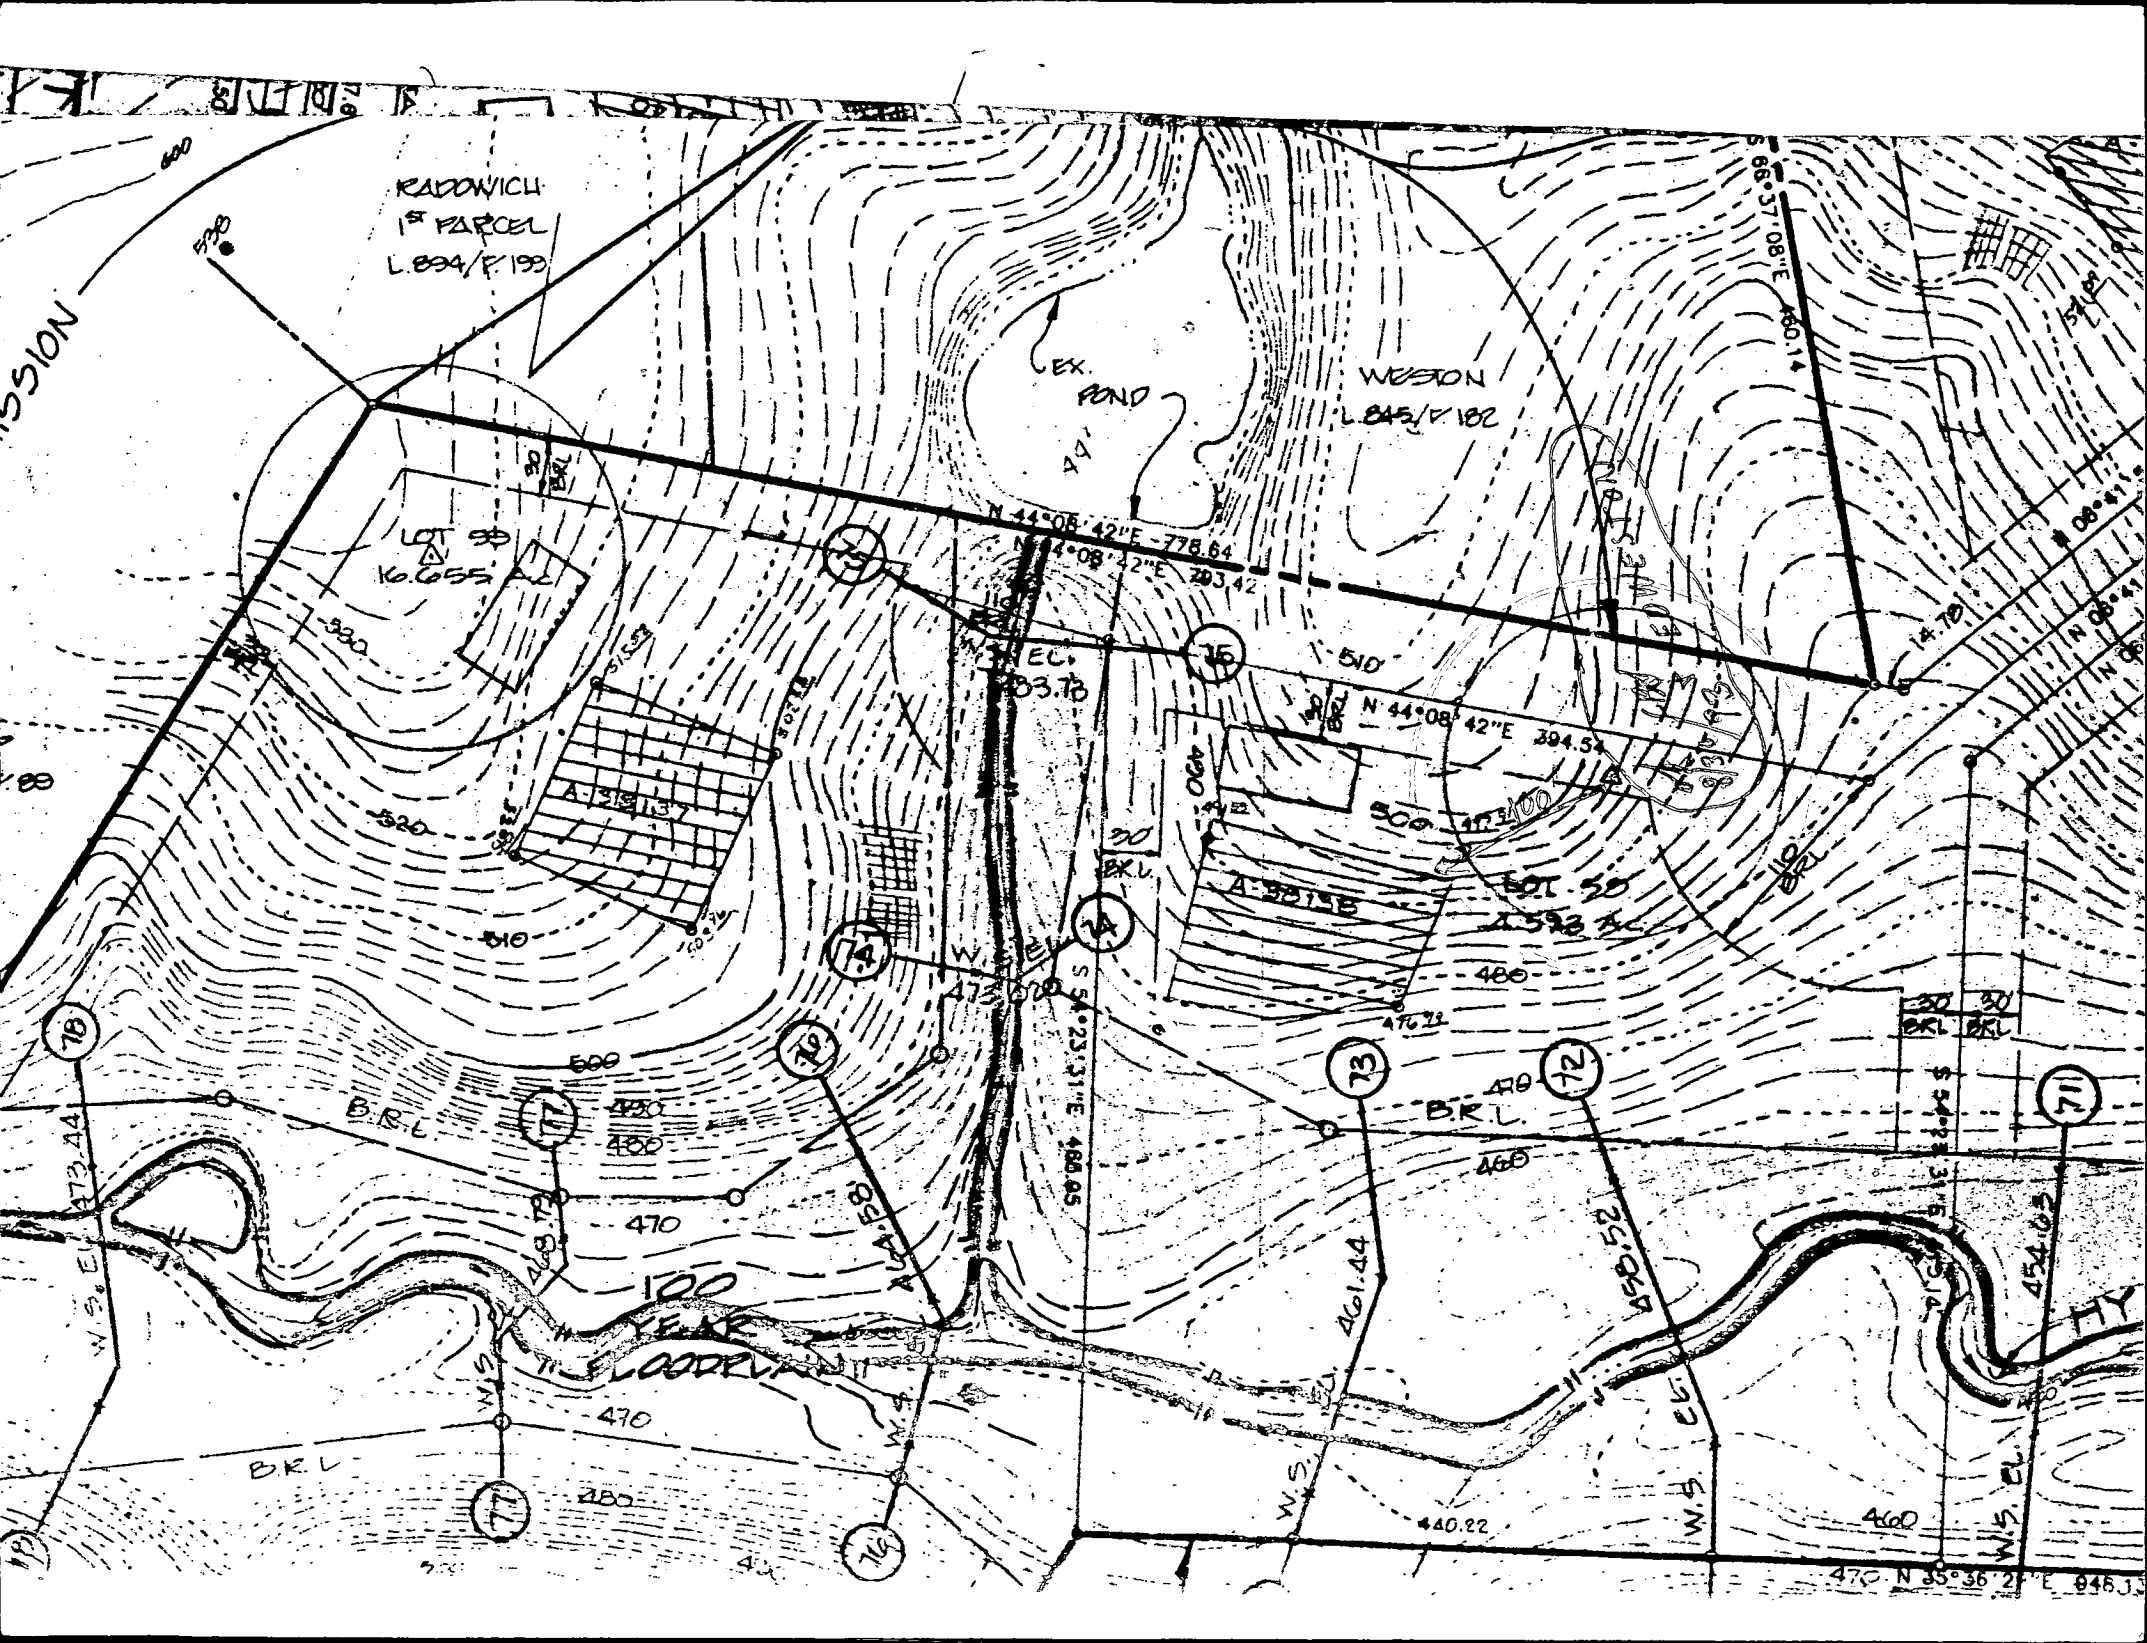

APPLICATION

PERCOLATION TESTING

A 38138

P _____

HOWARD COUNTY HEALTH DEPARTMENT
BUREAU OF ENVIRONMENTAL HEALTH
P.O. BOX 476 ELLICOTT CITY, MARYLAND 21043
TELEPHONE: 461-9933

DISTRICT 3RD

DATE _____

TO: THE COUNTY HEALTH OFFICER
ELLICOTT CITY, MARYLAND

I, HEREBY, APPLY FOR THE NECESSARY TEST IN ORDER TO CONSTRUCT (OR RECONSTRUCT) A SEWAGE DISPOSAL SYSTEM.

PROPERTY OWNER Springhill Associates - c/o D.S. Thaler & Associates, Inc.

ADDRESS 11 Warren Road, Baltimore, MD 21208 PHONE (301) 484-4100

PROSPECTIVE BUYER N/A

ADDRESS _____ PHONE _____

PROPERTY LOCATION:

SUBDIVISION Meadowood Sec. 2 Area 3 LOT NO. 31/58 ^{LOT 50} OLD/NEW

ROAD AND DESCRIPTION Henryton Road - approximately 4000' north of Tunnel Road
Howard County, Maryland

TAX MAP 10 PARCEL # 139

SIZE OF LOT 3+ Acres TYPE BLDG. Single Family
(SINGLE FAMILY DWELLING OR COMMERCIAL)

THE SYSTEM INSTALLED UNDER THIS APPLICATION IS ACCEPTABLE ONLY UNTIL PUBLIC FACILITIES BECOME AVAILABLE. I FULLY UNDERSTAND THE FEE CONNECTED WITH THE FILING OF THIS PERC TEST APPLICATION IS NON-REFUNDABLE UNDER ANY CIRCUMSTANCES. I ALSO AGREE TO COMPLY WITH ALL M.O.S.H.A. REQUIREMENTS IN TESTING THIS LOT. *Timothy H. Miller (agent)*
(SIGNATURE OF APPLICANT)

APPROVED BY _____ FOR _____ DATE _____


REJECTED BY _____ FOR _____ DATE _____

HOLD PENDING FURTHER TESTS _____ DATE _____

REASONS FOR REJECTION OR HOLDING 1-11-88 Due. Satisfactory - hold for PLAT. SRA

THIS IS NOT A PERMIT

SOIL PROFILE

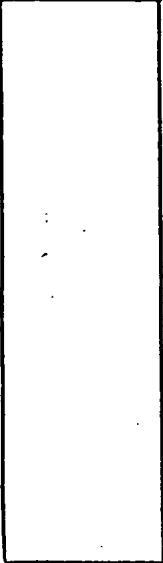0' 

INDICATE NORTH - NAME ADJOINING ROADWAY AS BASE LINE.

DATE	TEST NO.	DEPTH	PRE-WET		TEST - 1" DROP		TIME
			START	STOP	START	STOP	

REMARKS _____

TYPE OF SOIL _____

TESTED BY _____ ALSO PRESENT _____

EH-12-1079

APPLICATION

PERCOLATION TESTING

A 38/38

P _____

HOWARD COUNTY HEALTH DEPARTMENT
BUREAU OF ENVIRONMENTAL HEALTH
P.O. BOX 476 ELLICOTT CITY, MARYLAND 21043
TELEPHONE: 461-9933

DISTRICT _____

DATE 11/28/86

TO: THE COUNTY HEALTH OFFICER
ELLICOTT CITY, MARYLAND

I, HEREBY, APPLY FOR THE NECESSARY TEST IN ORDER TO CONSTRUCT (OR RECONSTRUCT) A SEWAGE DISPOSAL SYSTEM.

PROPERTY OWNER Springhill Associates - c/o D.S. Thaler & Associates, Inc.

ADDRESS 11 Warren Road, Baltimore, MD 21208 PHONE (301) 484-4100

PROSPECTIVE BUYER N/A

ADDRESS _____ PHONE _____

PROPERTY LOCATION:

SUBDIVISION Meadowood LOT NO. 31

ROAD AND DESCRIPTION Henryton Road - approximately 4000' north of Tunnel Road
Howard County, Maryland

TAX MAP 10 PARCEL # 139

SIZE OF LOT 3+ Acres TYPE BLDG. Single Family
(SINGLE FAMILY DWELLING OR COMMERCIAL)

THE SYSTEM INSTALLED UNDER THIS APPLICATION IS ACCEPTABLE ONLY UNTIL PUBLIC FACILITIES BECOME AVAILABLE. I FULLY UNDERSTAND THE FEE CONNECTED WITH THE FILING OF THIS PERC TEST APPLICATION IS NON-REFUNDABLE UNDER ANY CIRCUMSTANCES. I ALSO AGREE TO COMPLY WITH ALL M.O.S.H.A. REQUIREMENTS IN TESTING THIS LOT.

Mike Sedgwick
(SIGNATURE OF APPLICANT)

APPROVED BY _____ FOR _____ DATE _____

REJECTED BY _____ FOR _____ DATE _____


HOLD PENDING FURTHER TESTS _____ DATE _____

REASONS FOR REJECTION OR HOLDING 1-16-87 LOT NOT TESTED PER REQUEST, SAME

THIS IS NOT A PERMIT

① - ④
SOIL PROFILE

0	A-3
3"	RED BROWN SILT CLM 10-15% FRAGS
4"	Yell Br SILT LOAM 70 SAND LOAM 15-25% FRAGS
5.5"	
12.5"	

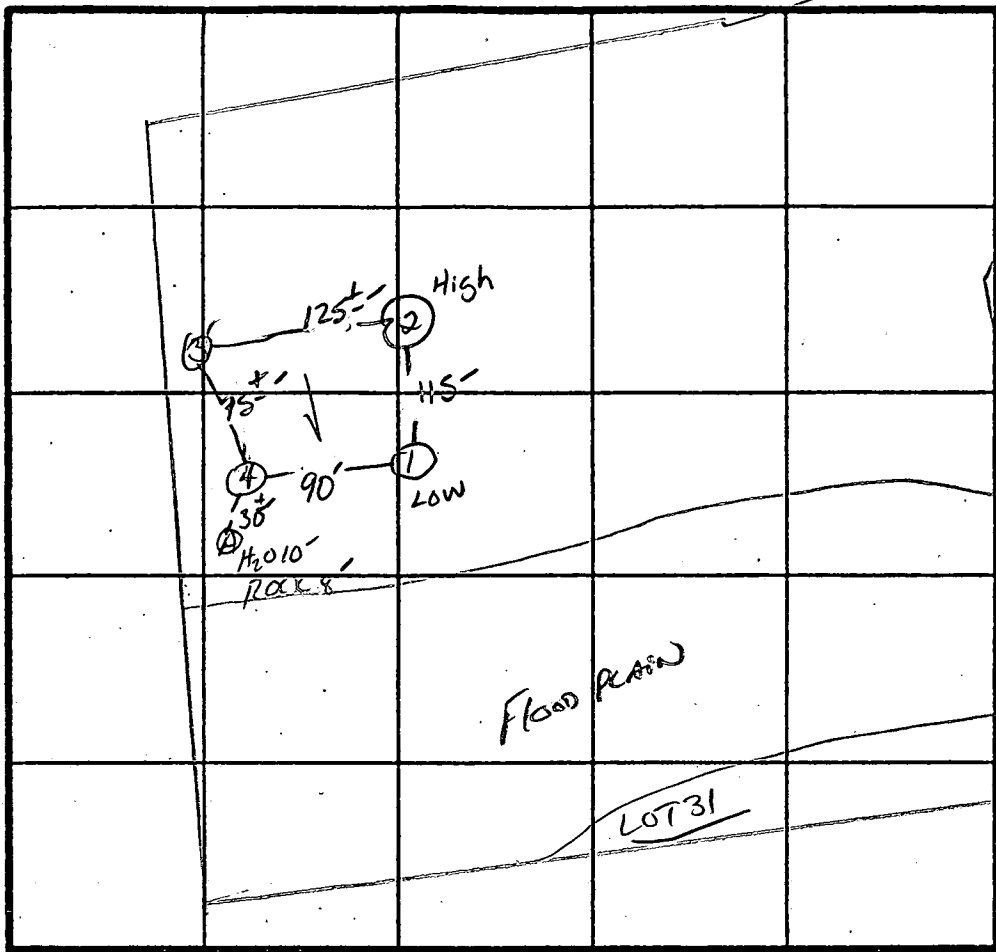

Inital Syst
only
X Perc
8 min
180 D/B.R
Inlet 3.5'
Bottom 7.5'
All Repairs
Inlet 3.5'
Bottom 5.5'
210 D/B.R

④ REDIG

Sims above
w/org
25%
mica
saprolite
FRAGS
moist
@ bot
HARD BOT

INDICATE NORTH - NAME ADJOINING ROADWAY AS BASE LINE.

DATE	TEST NO.	DEPTH	PRE-WET		TEST - 1" DROP		TIME
			START	STOP	START	STOP	
1/11/88	1 S	3.5'	10:43	10:53	10:53	11:12	19 min
	1 V	12.5'	CLAY TO	4" + 1" Good	Below 4.5'		
	2 S	3.5'	10:46	10:50	10:50	10:56	6 min
	2 M	7.0'	10:46	10:48	10:48	10:52	4 min
	2 V	11.5'	UNIFORM	Below 3.5'			
	3 S	3.5'	11:00	UNIFORM soil below 3.5'			
	3 V	11.5'	10:55	10:57	10:57	11:00	3 min
	4 S	12.5'	UNIFORM below 5.5'				
5/1/82	4 REDIG	11"	see profile.				
			perc by		(MRE)		
1/11/88	A	ROCK AT 8.0-8.5' WATER AT 10 FE					

1-16-87
REMARKS LOT NOT TO BE TESTED AS SHOWN PER REQUEST OF DWYER SA

TYPE OF SOIL MANOR
TESTED BY S. Abel
ALSO PRESENT WRTTIE JACK, Ed, SKIP,

EH-12-1079

APPLICATION

PERCOLATION TESTING

A 38/38

P _____

HOWARD COUNTY HEALTH DEPARTMENT
BUREAU OF ENVIRONMENTAL HEALTH
P.O. BOX 476 ELLICOTT CITY, MARYLAND 21043
TELEPHONE: 461-9933

DISTRICT _____

DATE 11/28/84

TO: THE COUNTY HEALTH OFFICER
ELLICOTT CITY, MARYLAND

I, HEREBY, APPLY FOR THE NECESSARY TEST IN ORDER TO CONSTRUCT (OR RECONSTRUCT) A SEWAGE DISPOSAL SYSTEM.

PROPERTY OWNER Springhill Associates - c/o D.S. Thaler & Associates, Inc.

ADDRESS 11 Warren Road, Baltimore, MD 21208 PHONE (301) 484-4100

PROSPECTIVE BUYER N/A

ADDRESS _____ PHONE _____

PROPERTY LOCATION:

SUBDIVISION Meadowood LOT NO. 31

ROAD AND DESCRIPTION Henryton Road - approximately 4000' north of Tunnel Road

Howard County, Maryland

TAX MAP 10 PARCEL # 139

SIZE OF LOT 3⁺ Acres TYPE BLDG. Single Family

(SINGLE FAMILY DWELLING OR COMMERCIAL)

THE SYSTEM INSTALLED UNDER THIS APPLICATION IS ACCEPTABLE ONLY UNTIL PUBLIC FACILITIES BECOME AVAILABLE. I FULLY UNDERSTAND THE

FEE CONNECTED WITH THE FILING OF THIS PERC TEST APPLICATION IS NON-REFUNDABLE UNDER ANY CIRCUMSTANCES. I ALSO AGREE TO COMPLY

WITH ALL M.O.S.H.A. REQUIREMENTS IN TESTING THIS LOT.

Mike Sogel
(SIGNATURE OF APPLICANT)

APPROVED BY _____ FOR _____ DATE _____

REJECTED BY _____ FOR _____ DATE _____

HOLD PENDING FURTHER TESTS _____ DATE _____

REASONS FOR REJECTION OR HOLDING _____

THIS IS NOT A PERMIT

SOIL PROFILE

0'

INDICATE NORTH - NAME ADJOINING ROADWAY AS BASE LINE.

DATE	TEST NO.	DEPTH	PRE-WET		TEST - 1" DROP		TIME
			START	STOP	START	STOP	

REMARKS _____

TYPE OF SOIL _____

TESTED BY _____ ALSO PRESENT _____

EH-12-1079

VICINITY MAP

SCALE: 1" = 2000'


(E1)


N 06°41'54" W 343.32' L= 26.18'
 N 06°41'54" W 380.75' L= 26.18'
 N 06°41'54" W 342.51'

SEE SHEET 2 OF 3

MATCH LINE

GENERAL NOTES

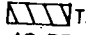1. SUBJECT PROPERTY ZONED R PER 8-2-85 COMPREHENSIVE ZONING PLAN.
2.  THIS AREA DESIGNATES A PRIVATE SEWAGE EASEMENT AS REQUIRED THE MARYLAND STATE DEPARTMENT OF HEALTH AND MENTAL HYGIENE FOR INDIVIDUAL SEWAGE DISPOSAL. IMPROVEMENTS OF ANY ANY NATURE IN THIS AREA ARE RESTRICTED UNTIL PUBLIC SEWAGE IS AVAILABLE. THESE EASEMENTS SHALL BECOME NULL AND VOID UPON CONNECTION TO PUBLIC SEWAGE SYSTEM. THE COUNTY HEALTH OFFICER SHALL HAVE THE AUTHORITY TO GRANT VARIANCES FOR ENCROACHMENTS INTO THE PRIVATE SEWAGE EASEMENT. RECORDATION OF A MODIFIED SEWAGE EASEMENT SHALL NOT BE NECESSARY.
3. THE LOTS SHOWN HEREON COMPLY WITH THE MINIMUM OWNERSHIP WIDTH AND LOT AREAS AS REQUIRED BY THE MARYLAND...

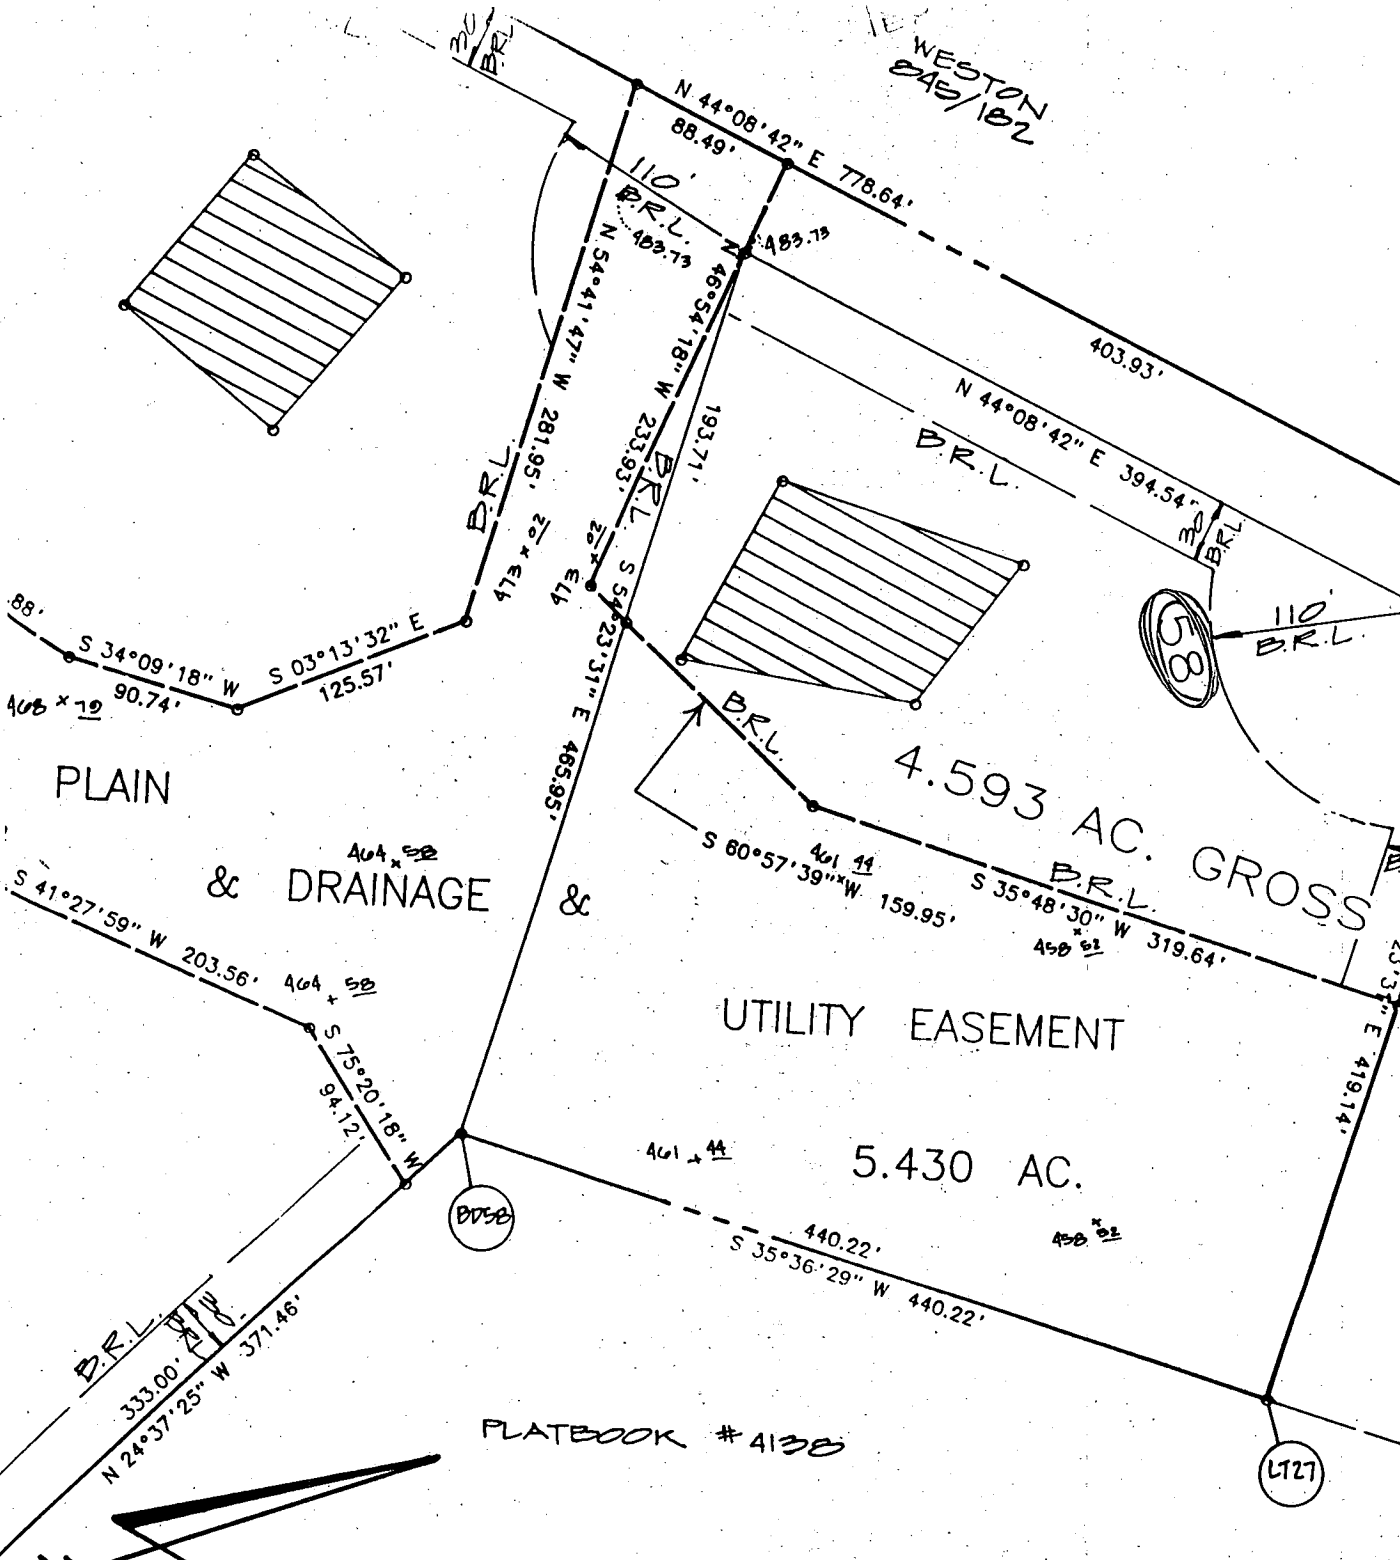

FLATBOOK # 4138

PLAIN

& DRAINAGE

UTILITY EASEMENT

4.593 AC. GROSS

5.430 AC.

WESTON
245/182

LOT 22

LOT 20

LOT 21

LOT 23

S 34°09'18" W 90.74'
 S 03°13'32" E 125.57'
 406 x 19

S 41°27'59" W 203.56'
 S 75°20'18" W 94.12'
 404 x 50

N 44°08'42" E 778.64'
 88.49'
 110 B.R.L.
 N 54°41'47" W 281.95'
 20 x 614

N 46°54'18" W 193.71'
 403.93'
 110 B.R.L.
 N 44°08'42" E 394.54'
 20 x 614

S 60°57'39" W 159.95'
 401 x 44
 S 35°48'30" W 319.64'
 400 x 52

S 35°36'29" W 440.22'
 440.22'
 401 x 44

B.R.L.
 333.00'
 N 24°37'25" W 371.46'

20
 S 54°23'33" E 419.14'
 205.15'

