


⊙ = WATER WELL

⊠ = OLD SEPTIC TANK

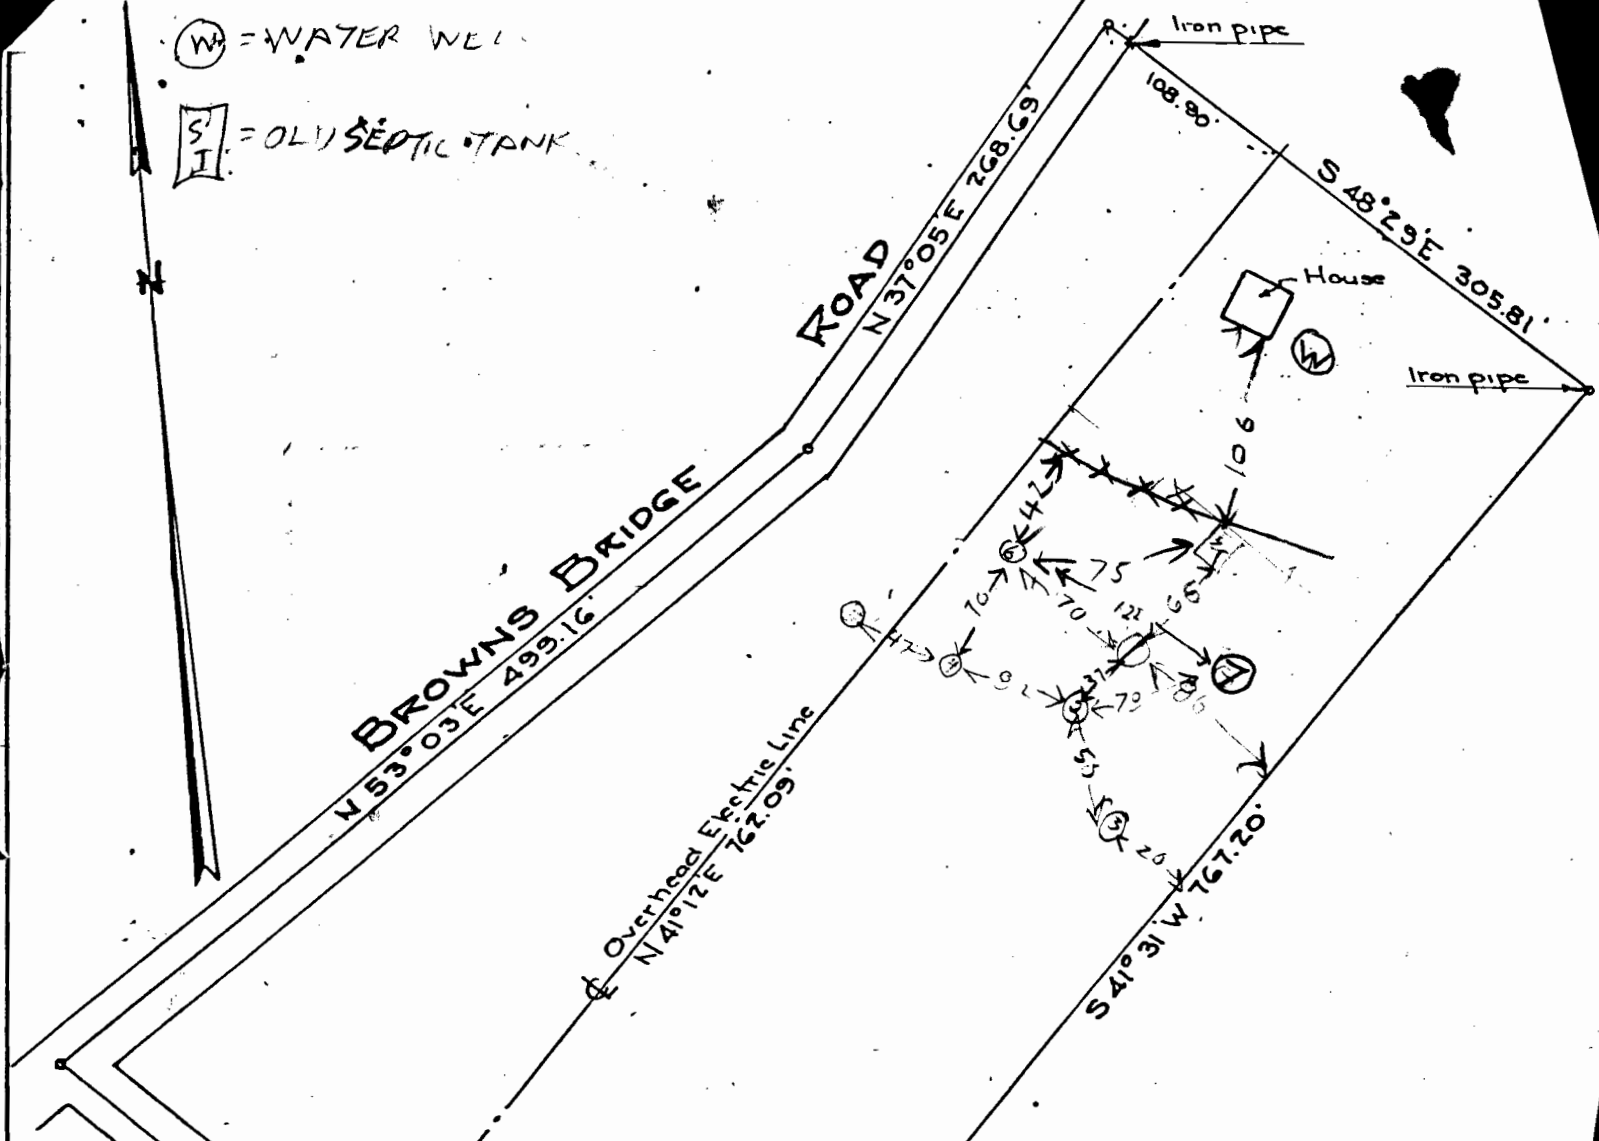

5.65 ACRES

PLAT OF SURVEY
OF
LOT No. 1
FOR
ROBIN UPJOHN LE
FIFTH ELECTION DIST. HOWARD. C
FULTON, MARYLAND.
SCALE: 1 IN. = 100 FT. Nov. 7, 1978

HOLE
ELEVATIONS

⊙ = HIGH


⊙ = LOW

⊙ = LOWEST


Robert E. Rose

LEY PROPERTY

FULTON, MD
 TAX MAP PARCEL ELECTION DISTRICT 5
 NOVEMBER 8, 1973

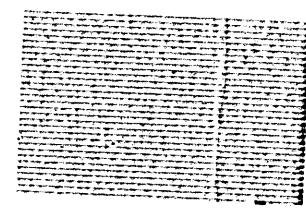

SUGGESTED HOMESITE LOCATION (± 100' x 150')

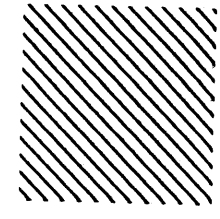


APPROXIMATE LOCATION OF PRIVATE SEWAGE EASEMENT (± 10,000 G.P.). LOCATION TO BE FIELD VERIFIED.



SUGGESTED WELL LOCATION

PREPARED BY: SECURITY DEVELOPMENT CORP.
 BOX 417, ELLICOTT CITY, MD, 201/465-4244

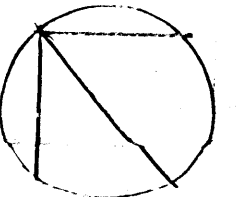

1" = 100'

