

APPLICATION

A 14206

P _____

SEWAGE DISPOSAL TESTING

MARYLAND STATE DEPARTMENT OF HEALTH

HOWARD COUNTY

ELLICOTT CITY

DISTRICT 5

DATE 1/14/69

2/1/69
9:30
3/18/69
9:30

TO: THE COUNTY HEALTH OFFICER
ELLICOTT CITY, MARYLAND

I, HEREBY, APPLY FOR THE NECESSARY TESTS IN ORDER TO CONSTRUCT (OR RECONSTRUCT) A SEWAGE DISPOSAL SYSTEM.

PROPERTY OWNER Paul L. Thompson

ADDRESS Highland, Maryland PHONE AT 6-2279

PROPERTY LOCATION:

SUBDIVISION _____ LOT NO. 1

ROAD AND DESCRIPTION Brown Bridge Road - approx. 1/4 mile from intersection of Rt. 216 & Brown Bridge Road

OCCUPANT _____ PHONE _____

PERSON TO CONSTRUCT SYSTEM _____

ADDRESS _____ PHONE _____

SIZE OF LOT 45,196 sq. ft. TYPE BLDG. 3 or 4

NUMBER OF BEDROOMS
(Single Family)

IF NOT SINGLE RESIDENCE DESCRIBE _____

SIGNATURE OF APPLICANT Paul C. Thompson


APPROVED BY _____ FOR _____ DATE _____

REJECTED BY Dw. Monaghan FOR Septic System DATE 3-18-69

HOLD PENDING FURTHER TESTS James T. Wright DATE 2/6/1969

REASONS FOR REJECTION OR HOLDING 3-18-69 - inadequate percolation - poor soil - high water table. DWM

THIS IS NOT A PERMIT

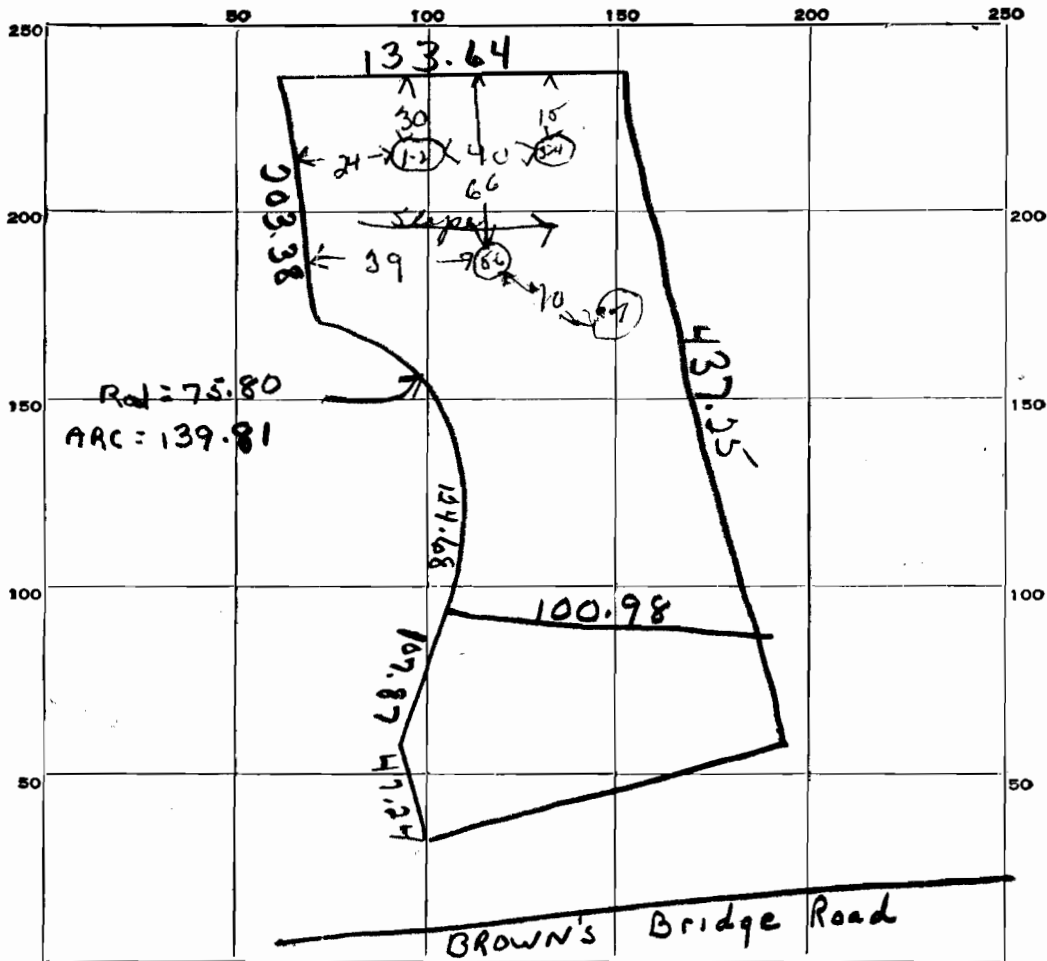

INDICATE NORTH. - NAME ADJOINING ROADWAY AS BASE LINE.

DATE	TEST NO.	DEPTH	PRE-WET		TEST - 1" DROP		TIME	
			START	STOP	START	STOP		
2/15/69	1	9 ft	10 08	10 10	10 10	10 14	4 min	
	2	4 ft	10 15	overtime				
	3	9 ft	10 17	stop test - no perc				
	4	4 ft	10 17	stop test - no perc				
	5	8 3/4 ft	10 33	10 35	10 35	10 47	12 min 9 ft hit water	
	6	3 1/2 ft	10 34					
	7	water hit at 7 top previous test in February						


SOIL AUGER FINDING _____

TESTED BY SRM

REMARKS _____

ALSO PRESENT _____

LOT NO. _____

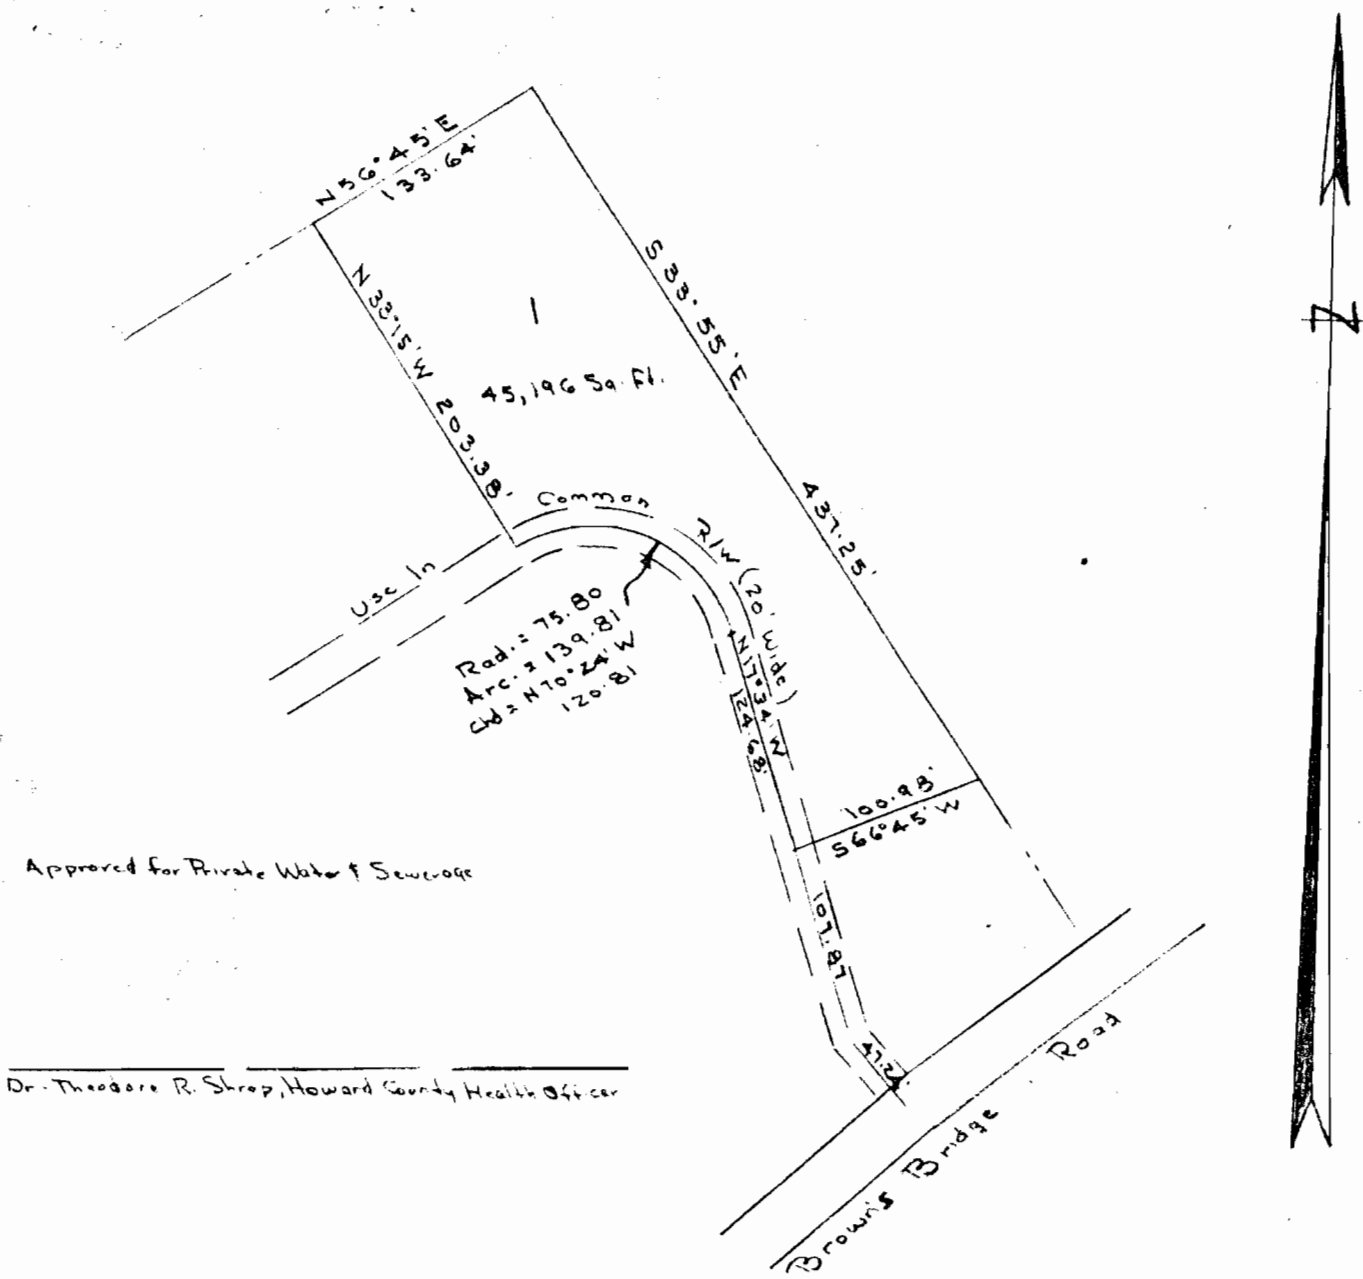

Approved for Private Water & Sewerage

Dr. Theodore R. Shrop, Howard County Health Officer

**PLAT OF SURVEY
FOR
PAUL C. THOMPSON
FIFTH ELECTION DISTRICT OF HOWARD COUNTY
HIGHLAND, MARYLAND
SCALE: 1 IN. = 100 FT. JULY 9, 1968**

Claude M. Skinner Jr.
 Claude M. Skinner Jr. Reg. Eng. & Land Surveyor No. 2237



4-2795