

Fill out in triplicate.
All but check blanks only.
Make fee of \$15.00 payable to:

APPLICATION

A 05611

P _____

HOWARD COUNTY HEALTH DEPT - SANITATION SEWAGE DISPOSAL TESTING

MARYLAND STATE DEPARTMENT OF HEALTH

HOWARD COUNTY

ELLICOTT CITY

DISTRICT 6th

DATE 8/13/62

*one dry well 12 ft in diameter by 14 ft deep below the inlet located 5 ft. off the front property line and 44 ft. off the right hand property line as determined with survey lot from Bryant Ave. E just 2 ft. off original ground not to be included in well area.
75 gal septic Tank.*

Note: Transfer of property to Floyd E. Lilly contingent on passing percolation test. Please notify Floyd E. Lilly, 502 Main St., Laurel, Md., by mail, date and time property is to be tested.

TO: THE COUNTY HEALTH OFFICER
ELLICOTT CITY, MARYLAND

I, HEREBY, APPLY FOR THE NECESSARY TESTS IN ORDER TO CONSTRUCT (OR RECONSTRUCT) A SEWAGE DISPOSAL SYSTEM.

✓ PROPERTY OWNER William R. H. Rice and Lillian M. Rice

✓ ADDRESS 1203 Scaggsville Rd., Laurel, Md. PHONE PA 5-2094

PROPERTY LOCATION:

✓ SUBDIVISION High Ridge Park, Near Laurel, Md. ✓ LOT NO. Lots 4 and 5

✓ ROAD AND DESCRIPTION Bryant Ave.

OCCUPANT _____ PHONE _____

PERSON TO CONSTRUCT SYSTEM _____

ADDRESS _____ PHONE _____

✓ SIZE OF LOT 50' x 150' each ✓ TYPE BLDG. House - 2 3 bedrooms
NUMBER OF BEDROOMS

IF NOT SINGLE RESIDENCE DESCRIBE _____

✓ SIGNATURE OF APPLICANT William R.H. and Lillian M. Rice


APPROVED BY J. Hennigan FOR Dry Well DATE 9-14-62
(KIND OF SYSTEM)

REJECTED BY _____ FOR _____ DATE _____
(KIND OF SYSTEM)

HOLD PENDING FURTHER TESTS _____ DATE _____

REASONS FOR REJECTION OR HOLDING 8-14-62 by T. L. L. change

THIS IS NOT A PERMIT

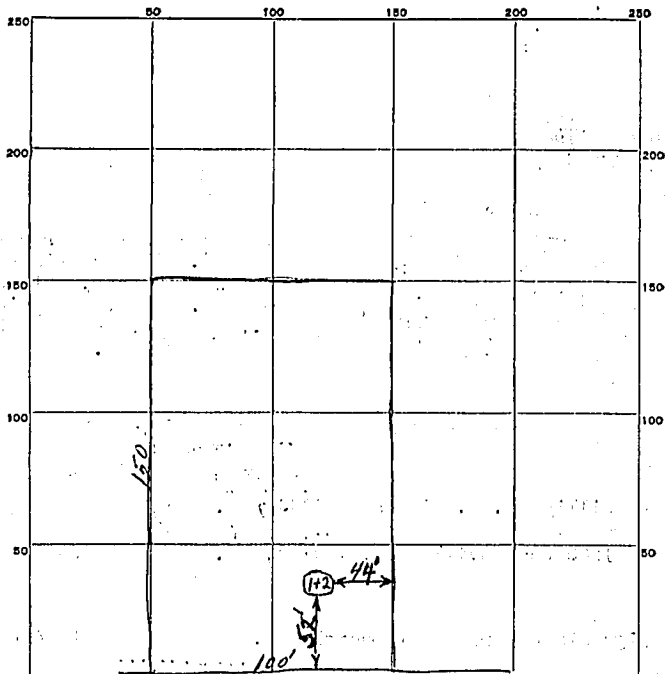

INDICATE NORTH - NAME ADJOINING ROADWAY AS BASE LINE.

BRYANT AVE.

DATE	TEST NO.	DEPTH	PRE-WET		TEST - 1" DROP		TIME
			START	STOP	START	STOP	
8-14-62	1	9 1/2'	10:54	11:22	11:22	12:05	43 min 15"
	2	4 1/2'	10:59	11:22	overtime		
9-4-62	3	16 1/2'	1:06	1:10	1:10	1:14	4 min

Present
9-4-62
E. Lilly

SOIL AUGER FINDING _____

TESTED BY EH

REMARKS

Test hole 3 in same pit as test hole #1 - last 7 ft sandy.

8-14-62

ALSO PRESENT

Clayd E. Lilly

LOT NO. 445