

9-3-63  
9/10/63 (A.M.)  
A.M.

# PERMIT

P. 07377  
A. 05611

SEWAGE DISPOSAL SYSTEM

MARYLAND STATE DEPARTMENT OF HEALTH

HOWARD COUNTY

ELLICOTT CITY

DISTRICT 6

DATE 9-3-63

INDEXED

INDEXED ✓

Floyd Lilly IS PERMITTED TO INSTALL \_\_\_\_\_ ALTER \_\_\_\_\_  
ADDRESS \_\_\_\_\_ PHONE \_\_\_\_\_

A SEWAGE DISPOSAL SYSTEM LOCATED AT \_\_\_\_\_

SUBDIVISION High Ridge Park ROAD Byrant Ave LOT 4 and 5

PROPERTY OWNER Floyd Lilly

ADDRESS 502 Main St Laurel

SPECIFICATIONS

DRAIN FIELD \_\_\_\_\_ DEPTH \_\_\_\_\_ FEET, BOTTOM AREA 10' x 10' 90 SQ. FT.

SEEPAGE PITS 1 ABSORBENT SIDE-WALL AREA 20 SQ. FT.

SEPTIC TANK CAPACITY 750 GALLONS in a di-wall area.

FOR GARBAGE GRINDER, INCREASE DISPOSAL AREA 22% & TANK CAPACITY 50%.

OTHER Locate dry well 52 off front lot line and 44 ft.


off right lot line redetermined when facing lot from

Byrant Ave.  
PLANS APPROVED BY J. C. Hennigan DATE 9-14-62

FILL SEPTIC TANK AND DISTRIBUTION BOX WITH WATER BEFORE CALLING FOR AN INSPECTION. COVER NO WORK UNTIL INSPECTED AND APPROVED.

NEITHER THE HOWARD COUNTY COMMISSIONERS NOR THE HEALTH DEPARTMENT IS RESPONSIBLE FOR THE SUCCESSFUL OPERATION OF ANY SYSTEM.

A 05611

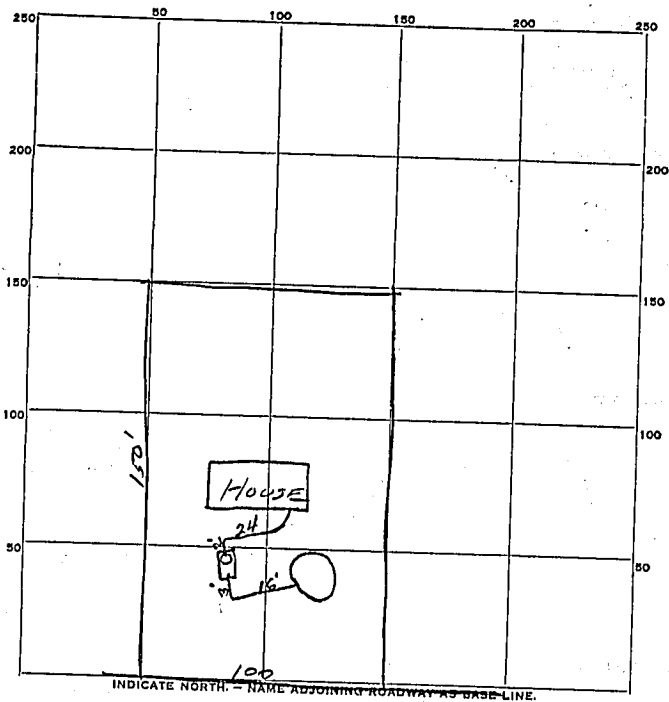

PERMIT CARD yes

SEPTIC TANK, LEVEL 1600 gal concrete

CLEANOUTS 10" stand pipe

DISTRIBUTION BOX, LEVEL same

TILE FIELD, DEPTH \_\_\_\_\_ FT. TRENCH WIDTH \_\_\_\_\_ FT.

GRAVEL DEPTH \_\_\_\_\_ IN. TOTAL LENGTH \_\_\_\_\_ FT.

NUMBER OF TRENCHES \_\_\_\_\_ TOTAL BOTTOM AREA \_\_\_\_\_

SEEPAGE PITS, INSIDE DIAMETER 10 1/2 FT. DEPTH BELOW INLET 9 1/2 FT.

ABSORBENT AREA ✓ SQ. FT.

REMARKS \_\_\_\_\_  
 \_\_\_\_\_  
 \_\_\_\_\_  
 \_\_\_\_\_  
 \_\_\_\_\_

DATE SYSTEM APPROVED 9-10-63

INSPECTOR J. Henning