

APPLICATION

SEWAGE DISPOSAL TESTING

STATE OF MARYLAND - DEPARTMENT OF HEALTH AND MENTAL HYGIENE

A 35533

P _____

HOWARD COUNTY HEALTH DEPARTMENT
ENVIRONMENTAL HEALTH SERVICES

P. O. BOX 476 ELLICOTT CITY, MARYLAND 21043
TELEPHONE: 992-2330

DISTRICT 5

DATE MAY 6 1985

TO: THE COUNTY HEALTH OFFICER
ELLICOTT CITY, MARYLAND

I, HEREBY, APPLY FOR THE NECESSARY TEST IN ORDER TO CONSTRUCT (OR RECONSTRUCT) A SEWAGE DISPOSAL SYSTEM.

John Schulze

PROPERTY OWNER ~~DALE Z. MAISEL~~ c/o HOWARD COUNTY LAND SERVICES

ADDRESS 10176 BALTO NAT'L PIKE 21043 PHONE 465-4920

PROPERTY LOCATION: FOLLY QUARTER

SUBDIVISION BUCKSKIN WOODS LOT NO. NEW LOT 9

ROAD AND DESCRIPTION FOLLY QUARTER RD 1/4 MILE WEST OF GLENBROG

COUNTRY SCHOOL 4230 Buckskin Lake Dr.

SIZE OF LOT 3 ACRES TYPE BLDG. 4
(NUMBER OF BEDROOMS)

THE SYSTEM INSTALLED UNDER THIS APPLICATION IS ACCEPTABLE ONLY UNTIL PUBLIC FACILITIES BECOME AVAILABLE. I FULLY UNDERSTAND THE

FEE CONNECTED WITH THE FILING OF THIS PERC TEST APPLICATION IS NON-REFUNDABLE UNDER ANY CIRCUMSTANCES. I ALSO AGREE TO COMPLY

WITH ALL M.O.S.H.A. REQUIREMENTS IN TESTING THIS LOT. DALE Z. MAISEL
(SIGNATURE OF APPLICANT)

APPROVED BY Sidney Abel FOR Deep Trunches DATE 2-11-86

REJECTED BY _____ FOR _____ DATE _____

HOLD PENDING FURTHER TESTS _____ DATE _____

REASONS FOR REJECTION OR HOLDING 5-29-85 Perc SATISFACTORY; hold for (rectified) Subdivision Plat. S. Abel

B.L. 70931
BLDG. PERMIT SIGNED
AND RETURNED
6-11-86

THIS IS NOT A PERMIT

PROPOSED RD.

ALL HOLES



LOT 6

TREE

LINE

LOT 30

SOIL PROFILE

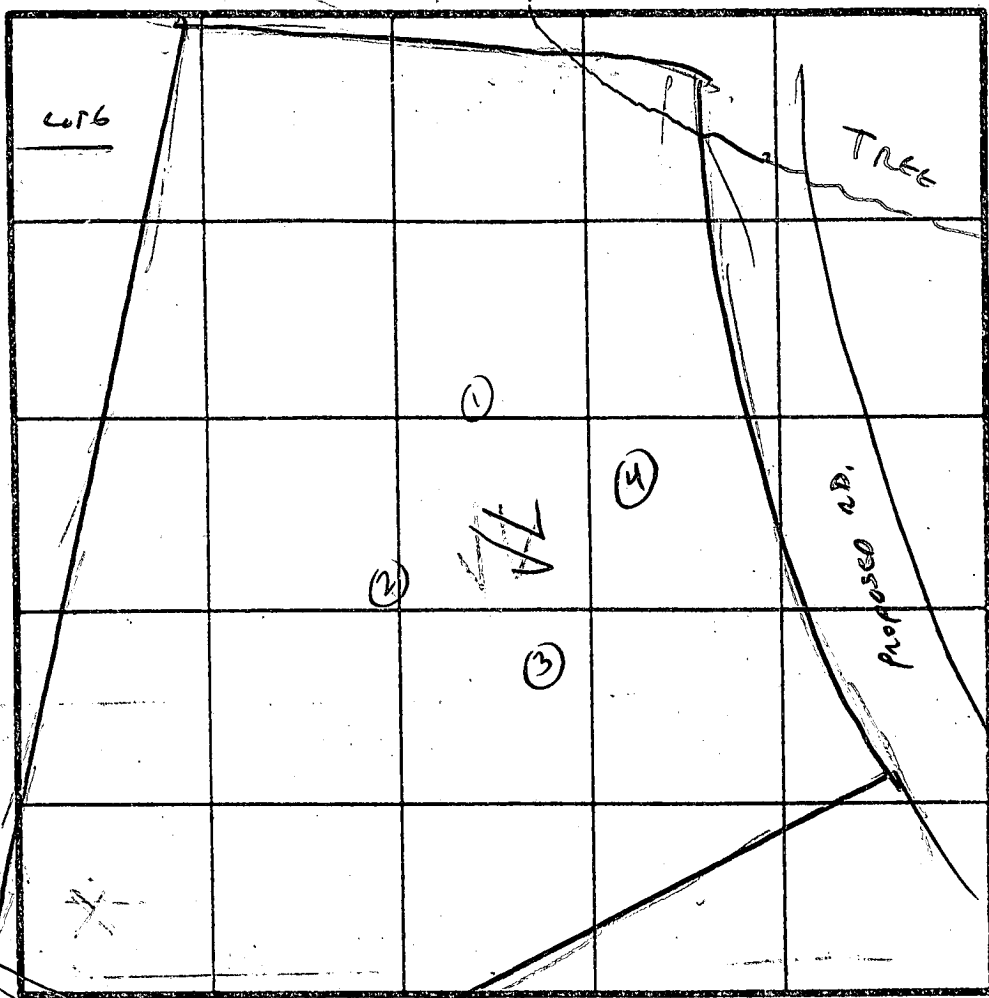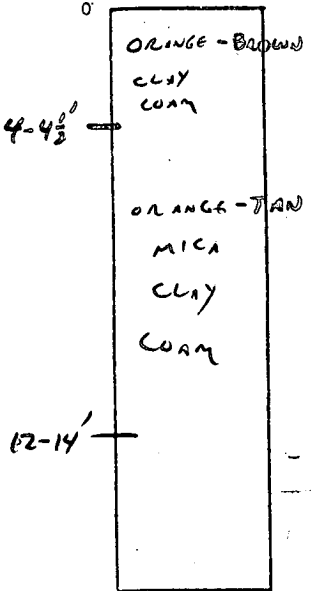

INDICATE NORTH - NAME ADJOINING ROADWAY AS BASE LINE.

̄ Perc - 6
INLET - 4
BOTTOM MAX - 9

DATE	TEST NO.	DEPTH	PRE-WET		TEST - 1" DROP		TIME
			START	STOP	START	STOP	
5-28-85	1 HIGGS	4	1:58	2:00	2:00	2:03	3 MIN OK
		8		VIS SAND			
5-28-85	2 HIGGS	12	1:56	MICA SAND	2:00	2:05	5 MIN OK
		4 1/2		LOAM			
5-28-85	3	9	1:53	VIS SAND	1:57	2:02	6 MIN OK
		13		MICA SAND			
5-28-85	4	4 1/2	1:52	MICA SAND	2:00	2:09	9 MIN OK
		9		LOAM			
		13		MICA SAND			
				LOAM			

158 #/BR

REMARKS LOCATIONS PER SURVEYORS PLAT.

TYPE OF SOIL MICA SAND LOAM

TESTED BY C. WILSON

ALSO PRESENT O'NETTERMAN, RUDGINS

E1112-1079