

3/30/87
ABM

02-248727

PERMIT

P 38982

A REPAIR

SEWAGE DISPOSAL SYSTEM
MARYLAND STATE DEPARTMENT OF HEALTH DISTRICT _____

HOWARD COUNTY
BUREAU OF ENVIRONMENTAL HEALTH
461-9933

DATE 3/27/87

DATE SYSTEM APPROVED 3/30/87

INSPECTOR C. Williams

INDEXED

John E. Ruth Company, Inc. IS PERMITTED TO INSTALL _____ ALTER X

ADDRESS 124 Malbrook Road, Baltimore, Maryland 21229 PHONE _____

SUBDIVISION _____ ROAD 2287 Daniels Road LOT _____

PROPERTY OWNER Gus Tribbett Phone 465-2325

ADDRESS _____

IF GARBAGE GRINDER IS USED INCREASE SEPTIC TANK CAPACITY BY 50% AND ABSORPTION AREA BY 22%.

GARBAGE GRINDER? YES _____ NO _____

SEPTIC TANK CAPACITY _____ GALLONS NUMBER OF BEDROOMS _____

REPAIR - REPLACEMENT OF METAL SEPTIC TANK WITH CONCRETE TANK.

PLANS APPROVED BY C. Williams DATE 3/27/87

COVER NO WORK UNTIL INSPECTED AND APPROVED.

NEITHER THE HOWARD COUNTY COUNCIL NOR THE HEALTH DEPARTMENT IS RESPONSIBLE FOR THE SUCCESSFUL OPERATION OF ANY SYSTEM.

NOTE: CLEANOUT REQUIRED EVERY 70 FEET OF SEWER LINE AND/OR AT 90° SWEEPS IN LINES FROM HOUSE TO DRAIN FIELDS.

NOTE: ALL PARTS OF SEPTIC SYSTEMS (I.E., TANK, DISTRIBUTION BOX, TRENCHES) TO BE 100 FEET FROM WELL. (UNLESS OTHERWISE SPECIFICALLY AUTHORIZED)

NOTE: IF DEEP TRENCHES ARE USED CALL FOR INSPECTION BEFORE AND AFTER PLACING GRAVEL IN TRENCH(ES).

NOTE: NO DRY WELL SHALL EXCEED 15 FOOT IN DIAMETER. NO ABSORPTION TRENCH TO EXCEED 100 FEET IN LENGTH.

NOTE: ALL PIPE FROM HOUSE TO SEPTIC TANK MUST BE CAST IRON OR SCHEDULE 40 PVC OR ABS.

PERMIT VOID AFTER TWO YEARS.

NOTE: INSTALL STAND PIPE ON SEPTIC TANK AND DRY WELL. STAND PIPES MUST BE 6 INCHES IN DIAMETER. CAST IRON, CONCRETE OR TERRA COTTA OR PVC OR ABS ACCEPTED. IF TOP OF SEPTIC TANK IS DEEPER THAN 3 FEET, MANHOLE TO GRADE REQUIRED.

NOTE: DISTRIBUTION BOXES MUST HAVE BAFFLES.

***INSTALLER IS RESPONSIBLE FOR OBTAINING FINAL APPROVAL ON THIS PERMIT**

*CALL 461-9933 FOR INSPECTION OF SEPTIC SYSTEMS.

EH - 2-1186

7
38982

8/25/60 - sk out

PERMIT

SEWAGE DISPOSAL SYSTEM

P. 02529

A. 82061

MARYLAND STATE DEPARTMENT OF HEALTH

HOWARD COUNTY

ELLICOTT CITY

DISTRICT 8

DATE 3/27/60

INDEXED

John E. Ruth Co. IS PERMITTED TO INSTALL ALTER
ADDRESS 600 Overbrook Rd., Catonsville 28 PHONE RI. 7-0579

A SEWAGE DISPOSAL SYSTEM LOCATED AT _____

SUBDIVISION Kuhn ROAD Daniels Rd. LOT 5

PROPERTY OWNER Tribbe, Edmund A.

ADDRESS 4411 Hilled Ave., Baltc. Co.
Arbiters

SPECIFICATIONS

DRAIN FIELD 2 DEPTH _____ FEET. BOTTOM AREA 300 SQ. FT.

CESSAGE PITS _____ ABSORBENT SIDEWALL AREA _____ SQ. FT.

SEPTIC TANK CAPACITY 750 GALLONS

FOR GARBAGE GRINDER, INCREASE DISPOSAL AREA 25% & TANK CAPACITY 50%


OTHER Place the tile field about 20 - 60 ft. behind the house in the area that passed the percolation test.

PLANS APPROVED BY Raymond Hodges DATE 1/27/60

FILL SEPTIC TANK AND DISTRIBUTION BOX WITH WATER BEFORE CALLING FOR AN INSPECTION. COVER NO WORK UNTIL INSPECTED AND APPROVED.

NEITHER THE HOWARD COUNTY COMMISSIONERS NOR THE HEALTH DEPARTMENT IS RESPONSIBLE FOR THE SUCCESSFUL OPERATION OF ANY SYSTEM.

1952061

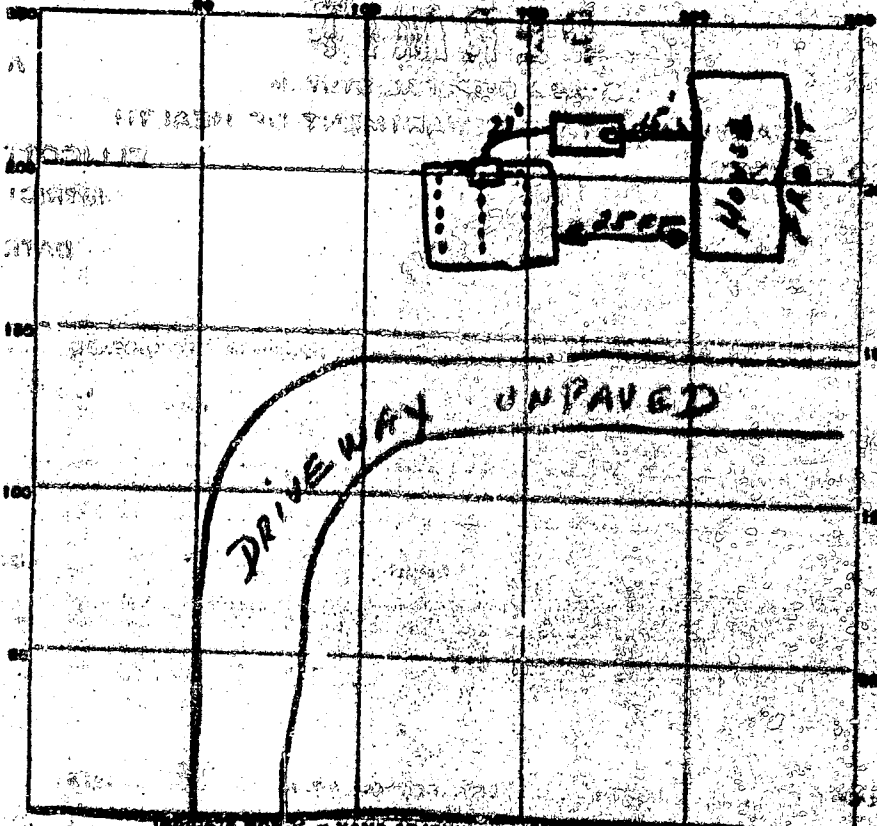


INDICATE NAME OF ADJOINING ROADWAY ON BASE LINE
DANIELS ROAD

PERMIT CARD 700
 SEPTIC TANK, LEVEL OK 750 CLEARANCE stand pipe
 DISTRIBUTION BOX, LEVEL OK
 TILE FIELD, DEPTH 4-5 FT. TRENCH WIDTH _____ FT.
 GRAVEL DEPTH _____ IN. TOTAL LENGTH _____ FT.
 NUMBER OF TRENCHES _____ TOTAL BOTTOM AREA _____
 SEEPAGE PITS, INSIDE DIAMETER _____ FT. DEPTH BELOW INLET _____ FT.
 ABSORBENT AREA 400 SQ. FT.

REMARKS Working bed 20 ft x 20 ft.

DATE SYSTEM APPROVED 8-25-60 INSPECTOR J. Henning

A# 02061

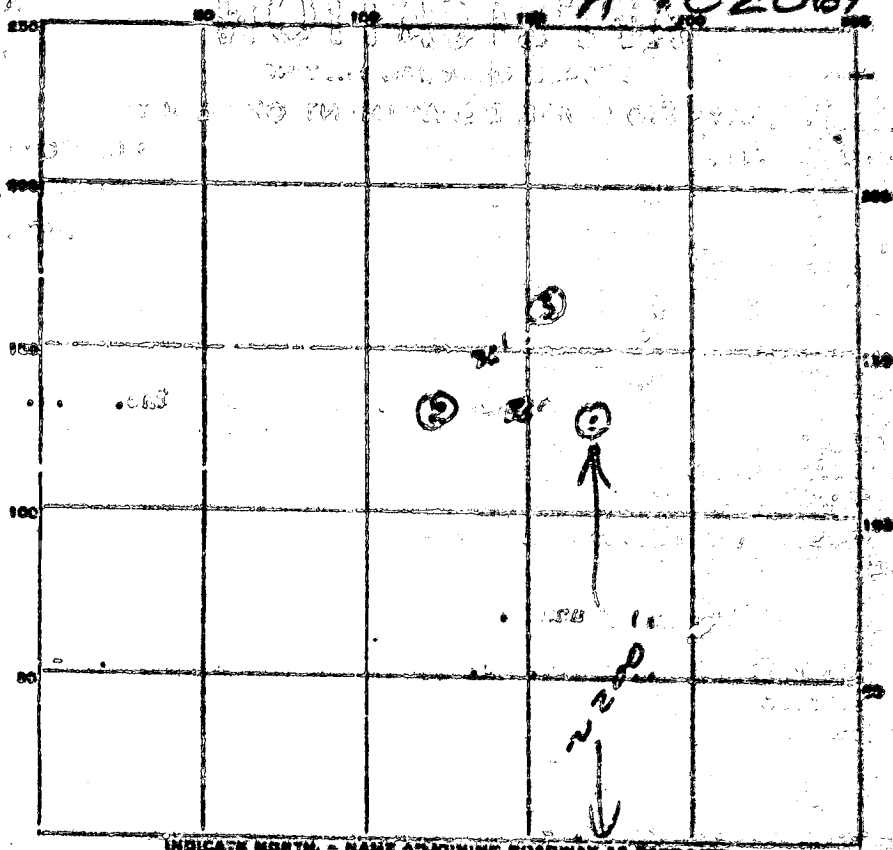

INDICATE NORTH - NAME ADJOINING ROADWAY AS EAST OR W.

DATE	TEST NO.	DEPTH	PRE-WET		TEST - 1 st RESP		TIME
			START	STOP	START	STOP	
1/27/60	1	3	108	119	119	139	20 min
	2	3	116	134	134	153	19 min
	3	3	121	124	124	136	12 min

SOIL AUGER FINDING _____
 TESTED BY Raymond Hodges
 REMARKS Holes taken at House Sample for location
 ALSO PRESENT Joseph M. Hodges LOT NO. 5