

6/18 6/19
7/24/92 13pm
7/24/92

Tax ID - 03-315029

PERMIT

SEWAGE DISPOSAL SYSTEM

DEPARTMENT OF HEALTH AND MENTAL HYGIENE

HOWARD COUNTY HEALTH DEPARTMENT
BUREAU OF ENVIRONMENTAL HEALTH

461-9933 313-2640

INDEXED

P 48250

A 39058

DISTRICT 3rd

DATE 4/10/92

DATE SYSTEM APPROVED 7/22/92

INSPECTOR CW

South Carroll Backhoe, Inc. IS PERMITTED TO INSTALL ALTER

ADDRESS 4410 Salem Bottom Road, Westminster, Maryland 21157 PHONE 875-4197

SUBDIVISION Amberwoods LOT 30, Sec. 1 ROAD 12820 Forest Creek Court

PROPERTY OWNER Grayson Homes Harold DIVEAS

ADDRESS _____

SEPTIC TANK CAPACITY 1500 GALLONS TOP SEAMED TANK

NUMBER OF BEDROOMS 4

210 SQUARE FEET PER BEDROOM

LINEAR FEET OF TRENCH REQUIRED 280

TRENCHES - Trench to be 3 feet wide. Inlet 2½ feet below original grade. Bottom maximum depth 4½ feet below original grade. Effective area begins at 2½ feet below original grade. 2 feet of stone below distribution pipe.

LOCATION - Start the first trench 300 feet down the right lot line and 150 feet off that lot line. Run trenches along contour toward right side of lot.

**** HOLD FOR FIELD LOCATION OF SEPTIC EASEMENT, ADJUSTMENT MAY BE REQUIRED.

NOTES - No trench to exceed 100 feet in length. Provide 6" - 8" diameter cleanout and cap to grade or above on septic tank. ok/cw

PLANS APPROVED BY C. Williams REVISED DATE: 9/15/89
DATE 7/16/89

COVER NO WORK UNTIL INSPECTED AND APPROVED

NEITHER THE HOWARD COUNTY COUNCIL NOR THE HEALTH DEPARTMENT IS RESPONSIBLE FOR THE SUCCESSFUL OPERATION OF ANY SYSTEM

NOTE: CLEANOUT REQUIRED EVERY 70 FEET OF SEWER LINE AND/OR AT 90° SWEEPS IN LINES FROM HOUSE TO DRAIN FIELDS, 90° ELBOWS NOT ACCEPTABLE.

NOTE: ALL PARTS OF SEPTIC SYSTEMS (I.E. TANK, DISTRIBUTION BOX TRENCHES) TO BE 100 FEET FROM WELL (UNLESS OTHERWISE SPECIFICALLY AUTHORIZED)

NOTE: IF DEEP TRENCH(ES) ARE USED CALL FOR INSPECTION BEFORE AND AFTER PLACING GRAVEL IN TRENCH(ES)

NOTE: NO DRY WELL SHALL EXCEED 15 FOOT IN DIAMETER NO ABSORPTION TRENCH TO EXCEED 100 FEET IN LENGTH

NOTE: ALL PIPE FROM HOUSE TO SEPTIC TANK MUST BE CAST IRON OR SCHEDULE 35/40 PVC OR ABS

PERMIT VOID AFTER TWO YEARS


NOTE: INSTALL STAND PIPE ON SEPTIC TANK AND DRY WELL STAND PIPES MUST BE 6 INCHES IN DIAMETER CAST IRON. CONCRETE OR TERRA COTTA OR PVA OR ABS ACCEPTED. IF TOP OF SEPTIC TANK IS DEEPER THAN 3 FEET. MANHOLE TO GRADE REQUIRED.

NOTE: DISTRIBUTION BOXES MUST HAVE BAFFLES

***INSTALLER IS RESPONSIBLE FOR OBTAINING FINAL APPROVAL ON THIS PERMIT**

BLDG. PERMIT SIGNED
AND RETURNED 7/24/92
Serial # 64792
clch

A 39058

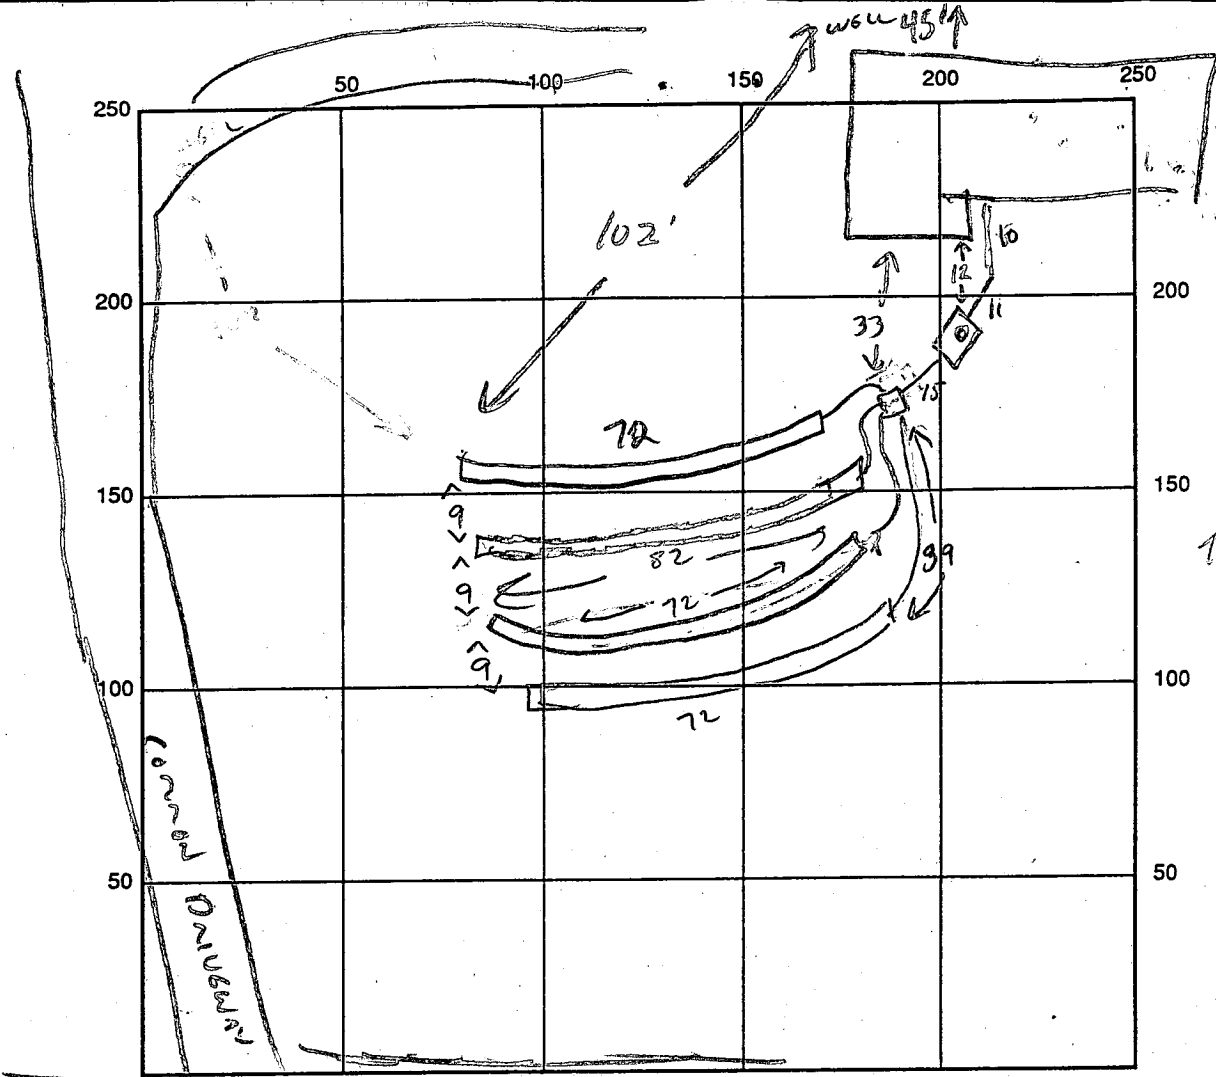

TOTAL IN
16.5 ft
70
82
80
232

INDICATE NORTH - NAME ADJOINING ROADWAY AS BASE LINE
FOREST CREEK CT

MANHOLE CLEANOUT NOT TO BE USED
ST - STRONG CLEANOUT NOT TO BE USED

SEPTIC TANK LEVEL 1500 ✓ CLEANOUTS ST - STRONG CLEANOUT NOT TO BE USED

DISTRIBUTION BOX LEVEL ✓

DRAIN FIELD/TITLE DEPTH 4 1/2 FT. TRENCH WIDTH 3 FT. INLET DEPTH 2 1/2 FT.

EFFECTIVE GRAVEL DEPTH 2 FT. TOTAL LENGTH 298 FT. (3 @ 72 + 1 @ 82)

NUMBER OF TRENCHES 4 ONE SIDEWALL/BOTTOM AREA 894 SQ. FT. $\frac{298 \times 3}{894}$

DRYWALL INSIDE DIAMETER — FT. EFFECTIVE DEPTH BELOW INLET — FT.

ABSORBENT AREA — SQ. FT.

REMARKS: 6/19/92 First two trenches OK to stone & cover. CW.

6/19/92 Third trench OK to stone. CW.

7/22/92 Tank & house sewer line OK - NOT YET CONNECTED TO DB

ST CLEANOUT TO BE CHANGED TO MANHOLE ACCESS.

7/22/92 CONTRACTOR PROVIDED IDENTIFICATION OF FINAL Hook-up - NOT INSPECTED, CW

DATE SYSTEM APPROVED 7/22/92 INSPECTOR Cwellen

4/21/87

APPLICATION

PERCOLATION TESTING

A 39058

P _____

HOWARD COUNTY HEALTH DEPARTMENT
BUREAU OF ENVIRONMENTAL HEALTH
P.O. BOX 476 ELLICOTT CITY, MARYLAND 21043
TELEPHONE: 461-9933

DISTRICT 3

DATE 3/4/87

TO: THE COUNTY HEALTH OFFICER
ELLICOTT CITY, MARYLAND

I, HEREBY, APPLY FOR THE NECESSARY TEST IN ORDER TO CONSTRUCT (OR RECONSTRUCT) A SEWAGE DISPOSAL SYSTEM.

PROPERTY OWNER Richard Arrington Grayson Homes

ADDRESS 1050 Sykesville Rd. West Friendship MD PHONE 301-776-7454
461-5900

PROSPECTIVE BUYER Amberwoods Limited Partnership

ADDRESS 1420 Fenwick Lane Silver Spring MD PHONE 301-587-5455

PROPERTY LOCATION:

SUBDIVISION Amberwoods (S-87-42) LOT NO. 2/6 30

ROAD AND DESCRIPTION ~~Rt 32 north of Rt 99~~
12820 Forest Creek Court - 21784

TAX MAP 9 PARCEL # 4

SIZE OF LOT 3.03 Ac TYPE BLDG. Single Family
(SINGLE FAMILY DWELLING OR COMMERCIAL)

PERMIT SIGNED
AND RETURNED 6-2-97
Serial # 42984-43pm

THE SYSTEM INSTALLED UNDER THIS APPLICATION IS ACCEPTABLE ONLY UNTIL PUBLIC FACILITIES BECOME AVAILABLE. I FULLY UNDERSTAND THE FEE CONNECTED WITH THE FILING OF THIS PERC TEST APPLICATION IS NON-REFUNDABLE UNDER ANY CIRCUMSTANCES. I ALSO AGREE TO COMPLY WITH ALL M.O.S.H.A. REQUIREMENTS IN TESTING THIS LOT.

Sam Negalle
(SIGNATURE OF APPLICANT)

APPROVED BY _____ FOR _____ DATE _____

REJECTED BY _____ FOR _____ DATE _____





HOLD PENDING FURTHER TESTS _____ DATE _____

REASONS FOR REJECTION OR HOLDING _____

THIS IS NOT A PERMIT

LA 26
NEW 30

(RE-DRAWN FROM OLD NOTES
RELATIVE TO NEW LOT BOUNDARIES)

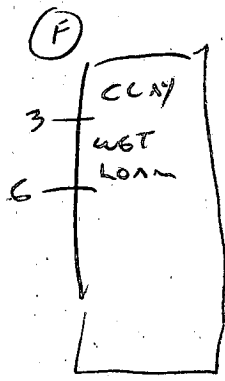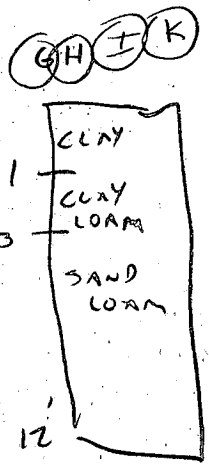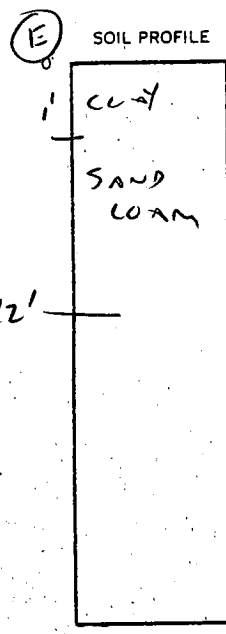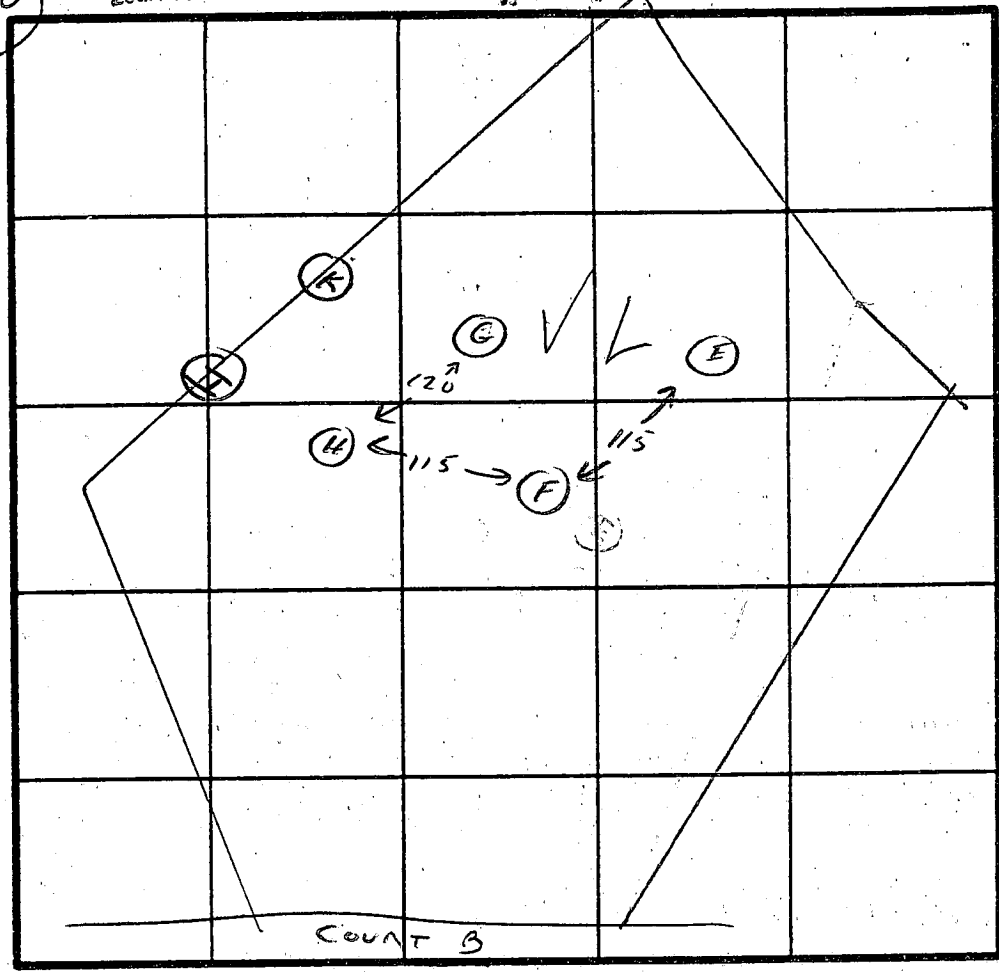

DATE	TEST NO.	DEPTH	PRE-WET		TEST - 1" DROP		TIME
			START	STOP	START	STOP	
	HOLES	A B C D	NOT TESTED	TOO LOW			
4/21/87	E	3 7 12	3:21	3:22 VIS OK	3:22	3:24 LOAM	2 MIN OK
	F	3 6	NO TEST	WET SOIL	INFLUENCED BY SWALE		X
	G	3 7 12		EXCAVATION CEASED AT 6'	WET LOOKING SOIL		OK
	H	3 7 12	3:24	3:26 VIS OK	3:26	3:29 LOAM	3 MIN OK

I, K VIS OK 3-12' TO ALLOW SHIFT AWAY FROM SWALE

REMARKS _____

TYPE OF SOIL SAND LOAM

TESTED BY C. Waller ALSO PRESENT NEGABAN


EH-12-1079

4/20/87


LOT 26

N6W 30



26

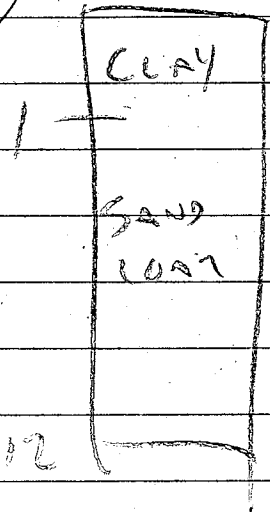


similar TO OTHERS

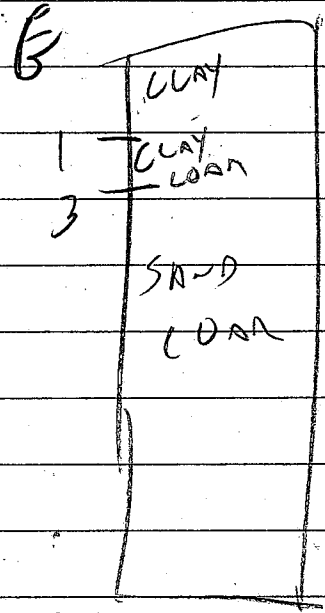

QUESTIONABLE LOCATION
 - MAY BE IN DRAINAGE
 EASEMENT

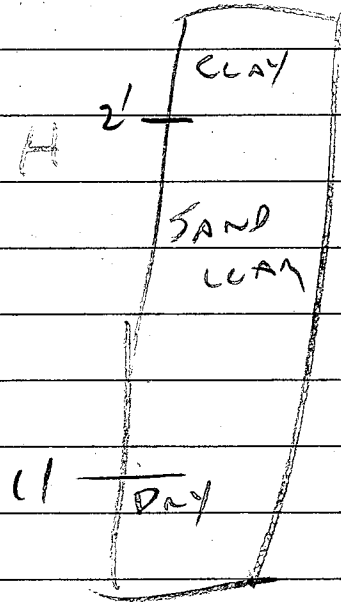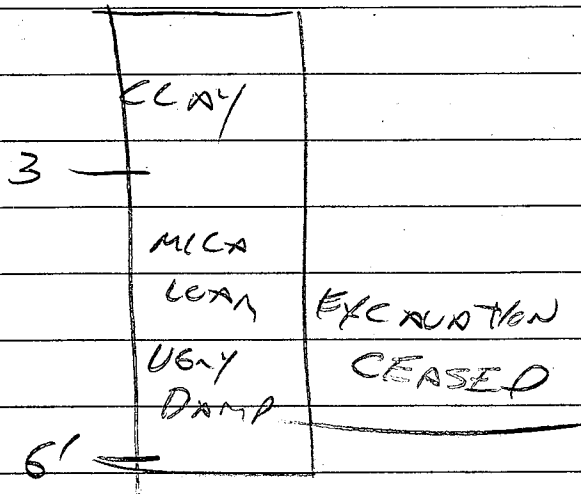

LOT 29
4.3685 AC.

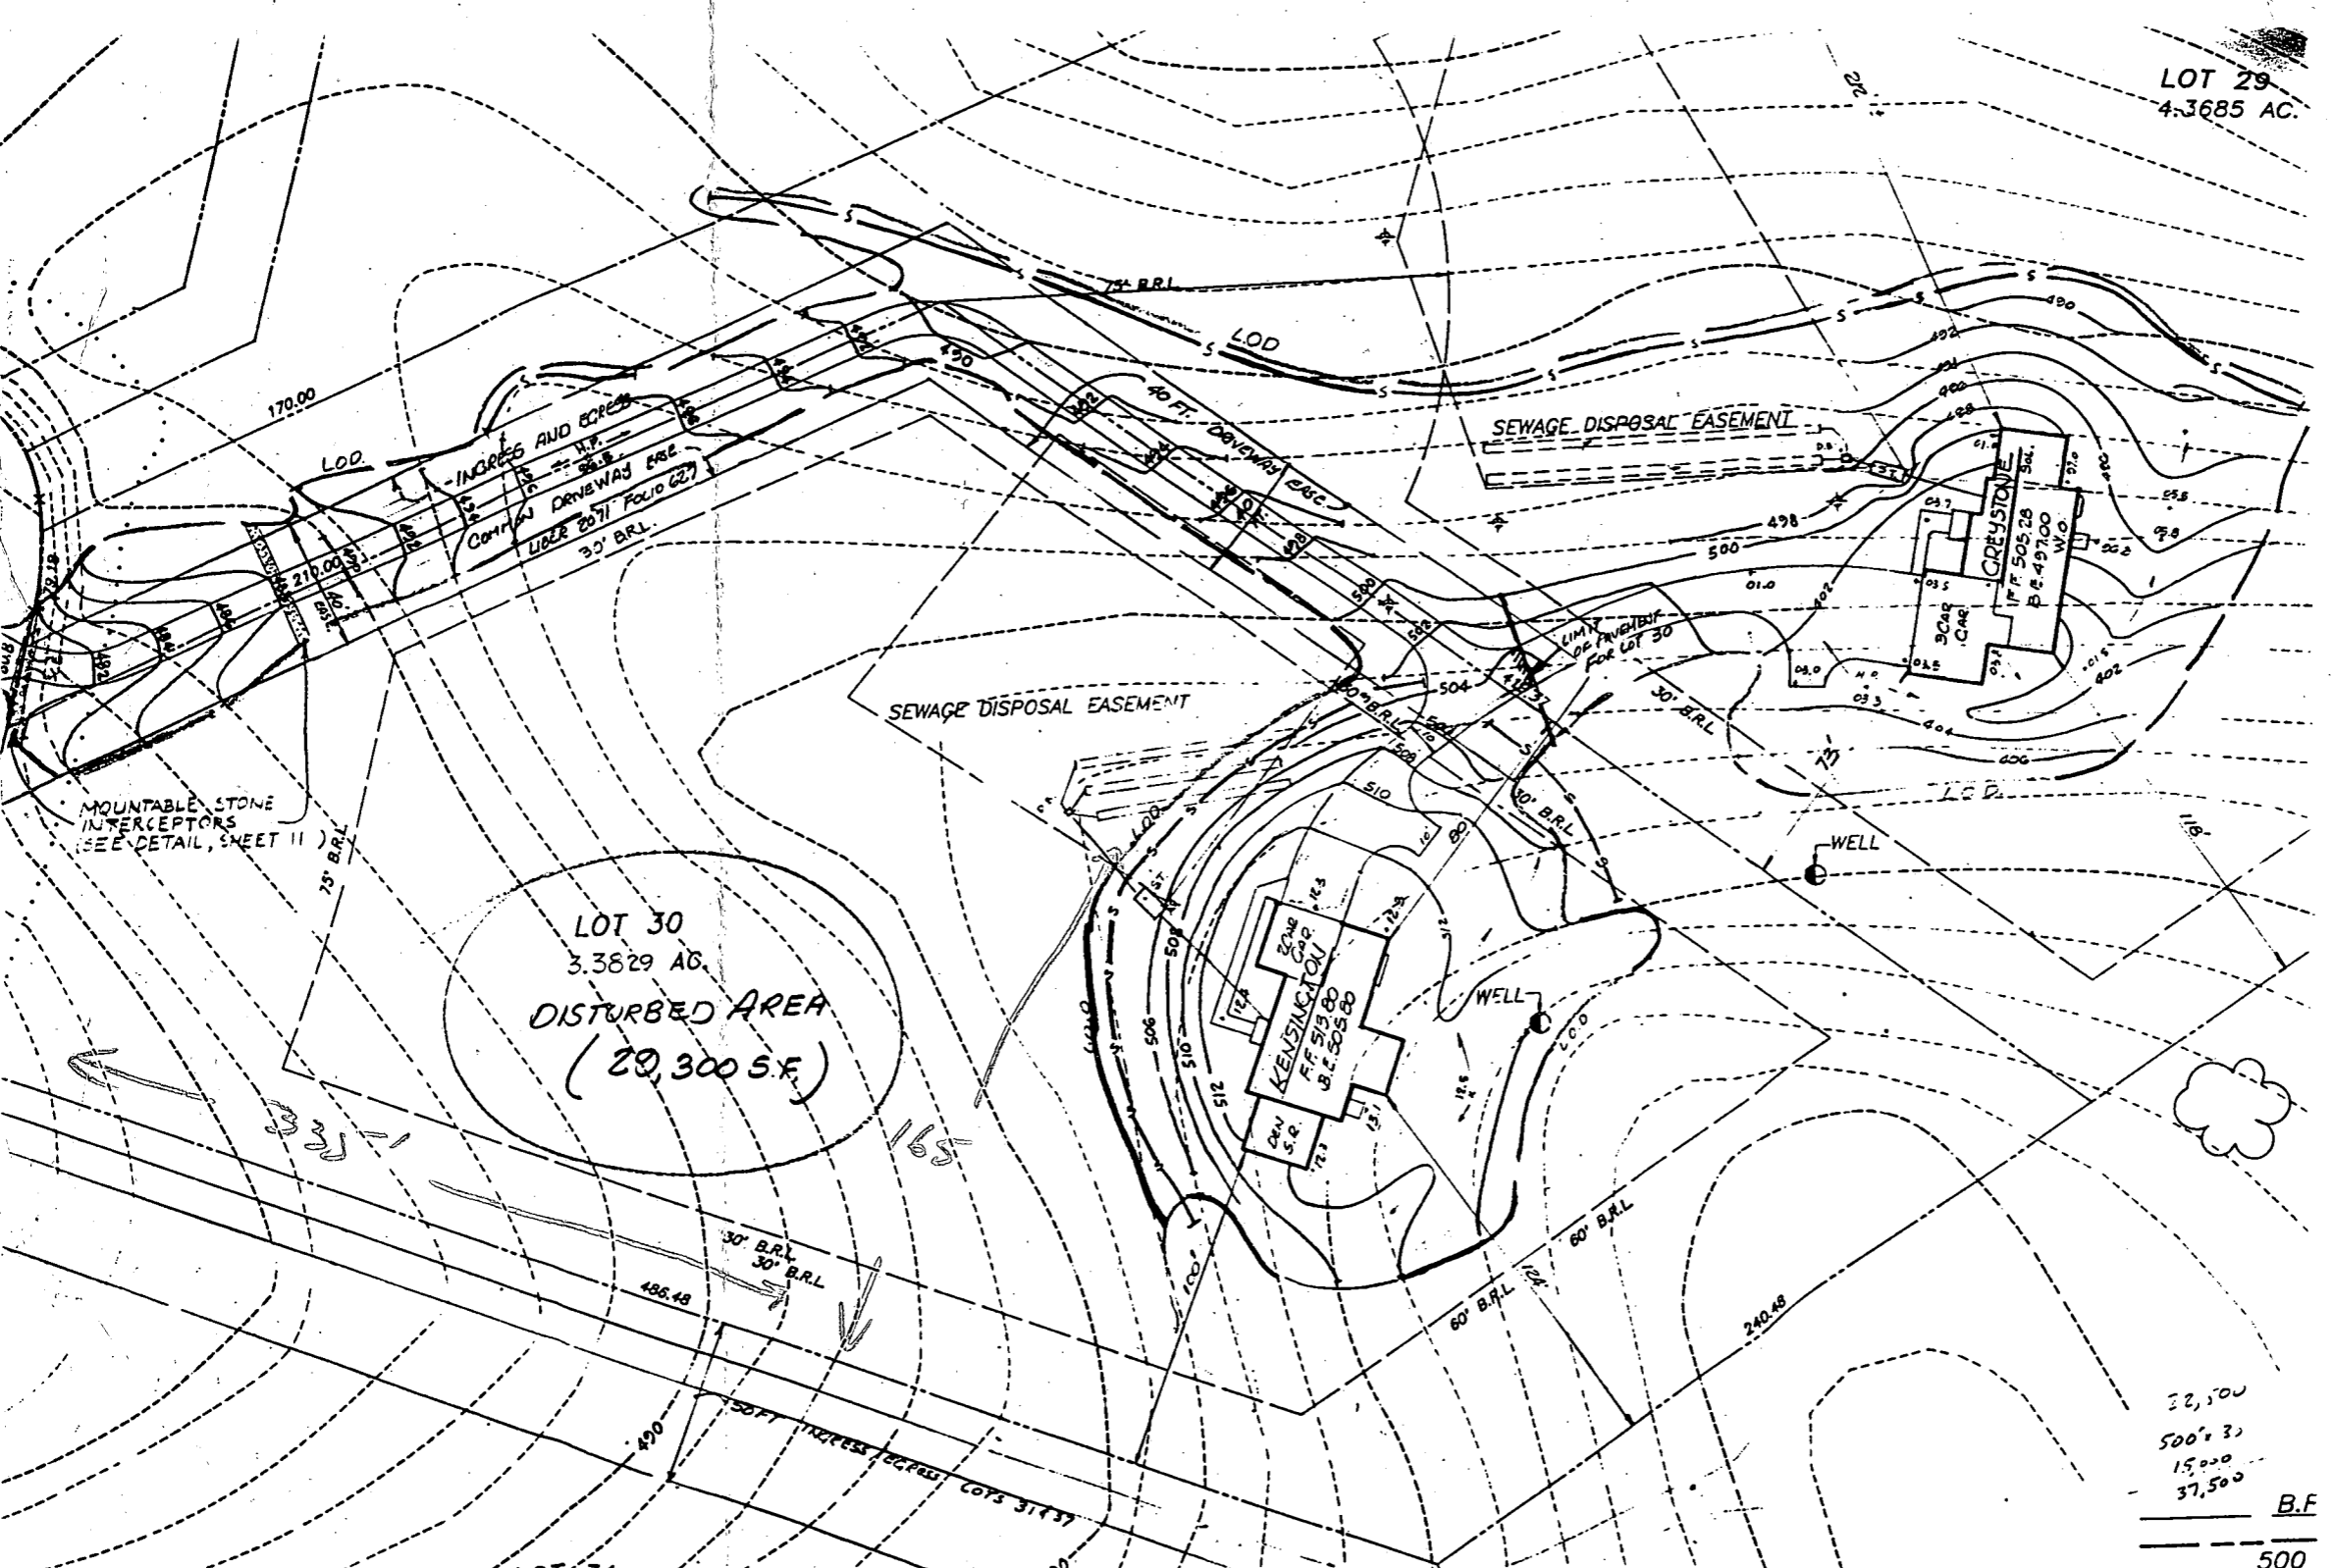

MOUNTABLE STONE INTERCEPTORS (SEE DETAIL, SHEET II)

LOT 30
3.3829 AC.
DISTURBED AREA
(29,300 S.F.)

KENSINGTON
FF 313 80
B.F. 305 80

GREYSTONE
FF 505 28
B.F. 497 00

32,500
500' 30
15,000
37,500

B.F.
500

C1 0020 SEQUENCE NO. (DENV USE ONLY)

STATE OF MARYLAND WELL COMPLETION REPORT

THIS REPORT MUST BE SUBMITTED WITHIN 45 DAYS AFTER WELL IS COMPLETED.

(THIS NUMBER IS TO BE PUNCHED IN COLS. 3-6 ON ALL CARDS)

COUNTY NUMBER A 39058

ST/CO USE ONLY DATE Received

DATE WELL COMPLETED

Depth of Well

PERMIT NO. FROM "PERMIT TO DRILL WELL"

8 13

15 20

22 26 (TO NEAREST FOOT)

28 37

OWNER: Korman Development last name, first name, TOWN: Spokerville, STREET OR RFD: Rochester Ct., SUBDIVISION: Inghamade, SECTION, LOT: 30

WELL LOG Not required for driven wells. STATE THE KIND OF FORMATIONS PENETRATED, THEIR COLOR, DEPTH, THICKNESS AND IF WATER BEARING

Table with columns: DESCRIPTION (Use additional sheets if needed), FEET (FROM, TO), Check if water bearing. Rows include Topsoil, Clay, Sand Brown Mica, Brown Mica, Grey M. Ca., Brown Mica, Grey Mica, Brown Mica, Grey Mica.

GROUTING RECORD. WELL HAS BEEN GROUTED (Circle Appropriate Box) TYPE OF GROUTING MATERIAL CEMENT (CM) BENTONITE CLAY (BC)

NO. OF BAGS, NO. OF POUNDS, GALLONS OF WATER, DEPTH OF GROUT SEAL (to nearest foot)

CASING RECORD. casing types insert appropriate code below. ST CO STEEL CONCRETE, PL OT PLASTIC OTHER

MAIN CASING TYPE, Nominal diameter top (main) casing (nearest inch), Total depth of main casing (nearest foot)

OTHER CASING (if used) diameter inch, depth (feet) from to

SCREEN RECORD. screen type or open hole. insert appropriate code below. ST BR HO STEEL BRASS OPEN HOLE, PL OT PLASTIC OTHER

DEPTH (nearest ft.) table with rows for EACH CASING and SCREEN

CIRCLE APPROPRIATE LETTER. A A WELL WAS ABANDONED AND SEALED WHEN THIS WELL WAS COMPLETED. E ELECTRIC LOG OBTAINED. P TEST WELL CONVERTED TO PRODUCTION WELL

I HEREBY CERTIFY THAT THIS WELL HAS BEEN CONSTRUCTED IN ACCORDANCE WITH COMAR 26.04.04 "WELL CONSTRUCTION" AND IN CONFORMANCE WITH ALL CONDITIONS STATED IN THE ABOVE CAPTIONED PERMIT...

DRILLERS IDENT. NO. 41, DRILLERS SIGNATURE, SITE SUPERVISOR (sign of driller or journeyman responsible for sitework if different from permittee)

SLOT SIZE 1 2 3, DIAMETER OF SCREEN (NEAREST INCH)

GRAVEL PACK IF WELL DRILLED WAS FLOWING WELL INSERT F IN BOX 68

OEP USE ONLY (NOT TO BE FILLED IN BY DRILLER) T (E.R.O.S.), W Q, TELESCOPE CASING, LOG INDICATOR, OTHER DATA

PUMPING TEST. HOURS PUMPED (nearest hour) 3, PUMPING RATE (gal. per min. to nearest gal.) 12, METHOD USED TO MEASURE PUMPING RATE, WATER LEVEL (distance from land surface) BEFORE PUMPING, WHEN PUMPING, TYPE OF PUMP USED (for test) S submersible

PUMP INSTALLED. DRILLER WILL INSTALL PUMP. YES NO (CIRCLE) (YES or NO) IF DRILLER INSTALLS PUMP, THIS SECTION MUST BE COMPLETED FOR ALL WELLS EXCEPT HOME USE. TYPE OF PUMP INSTALLED PLACE (A,C,J,P,R,S,T,O) IN BOX - SEE ABOVE. CAPACITY: GALLONS PER MINUTE (to nearest gallon), PUMP HORSE POWER, PUMP COLUMN LENGTH (nearest ft.), CASING HEIGHT (circle appropriate box and enter casing height) above, below LAND SURFACE (nearest foot)

