

2/6/92 am/pm
1/7/92

Tax ID - 03-314944

PERMIT

SEWAGE DISPOSAL SYSTEM

DEPARTMENT OF HEALTH AND MENTAL HYGIENE

P 47697

A 39060

DISTRICT 3rd

DATE 12/29/91

INDEXED

HOWARD COUNTY HEALTH DEPARTMENT
BUREAU OF ENVIRONMENTAL HEALTH
461-9933

DATE SYSTEM APPROVED 4/7/92

INSPECTOR CW

South Carroll Backhoe, Inc. IS PERMITTED TO INSTALL ALTER

ADDRESS 4410 Salem Bottom Road, Westminster, Maryland 21157 PHONE 875-4197

SUBDIVISION Amberwoods LOT 22, Sec. 1 ROAD 12809 Forest Creek Court

PROPERTY OWNER Grayson Homes, Inc. H. P. Hailing

ADDRESS _____

SEPTIC TANK CAPACITY 1250 GALLONS

NUMBER OF BEDROOMS 4

210 SQUARE FEET PER BEDROOM

LINEAR FEET OF TRENCH REQUIRED 140

BLDG. PERMIT SIGNED
AND RETURNED 4/18/95
Serial # 54084 -
Storage Barn

TRENCHES - Trench to be 2 feet wide. Inlet 3 feet below original grade. Bottom maximum depth 9 feet below original grade. Effective area begins at 3 feet below original grade. 6 feet of stone below distribution pipe.

LOCATION - Start the first trench 240 feet from the front lot line and 165 feet from the right lot line. Run trenches on contour toward back property line.

NOTE - No trench to exceed 100 feet in length. Provide 6" - 8" diameter cleanout and cap to grade or above on septic tank.

OK/CW

PLANS APPROVED BY C. Williams REVISED DATE 12/23/91

COVER NO WORK UNTIL INSPECTED AND APPROVED

NEITHER THE HOWARD COUNTY COUNCIL NOR THE HEALTH DEPARTMENT IS RESPONSIBLE FOR THE SUCCESSFUL OPERATION OF ANY SYSTEM

NOTE: CLEANOUT REQUIRED EVERY 70 FEET OF SEWER LINE AND/OR AT 90° SWEEPS IN LINES FROM HOUSE TO DRAIN FIELDS, 90° ELBOWS NOT ACCEPTABLE.

NOTE: ALL PARTS OF SEPTIC SYSTEMS (I.E. TANK, DISTRIBUTION BOX TRENCHES) TO BE 100 FEET FROM WELL (UNLESS OTHERWISE SPECIFICALLY AUTHORIZED)

NOTE: IF DEEP TRENCH(ES) ARE USED CALL FOR INSPECTION BEFORE AND AFTER PLACING GRAVEL IN TRENCH(ES)

NOTE: NO DRY WELL SHALL EXCEED 15 FOOT IN DIAMETER NO ABSORPTION TRENCH TO EXCEED 100 FEET IN LENGTH

NOTE: ALL PIPE FROM HOUSE TO SEPTIC TANK MUST BE CAST IRON OR SCHEDULE 35/40 PVC OR ABS


PERMIT VOID AFTER TWO YEARS

BLDG. PERMIT SIGNED
AND RETURNED 7/4/92
Serial # 44497 - elect

NOTE: INSTALL STAND PIPE ON SEPTIC TANK AND DRY WELL STAND PIPES MUST BE 6 INCHES IN DIAMETER CAST IRON. CONCRETE OR TERRA COTTA OR PVA OR ABS ACCEPTED. IF TOP OF SEPTIC TANK IS DEEPER THAN 3 FEET. MANHOLE TO GRADE REQUIRED.

NOTE: DISTRIBUTION BOXES MUST HAVE BAFFLES

***INSTALLER IS RESPONSIBLE FOR OBTAINING FINAL APPROVAL ON THIS PERMIT**

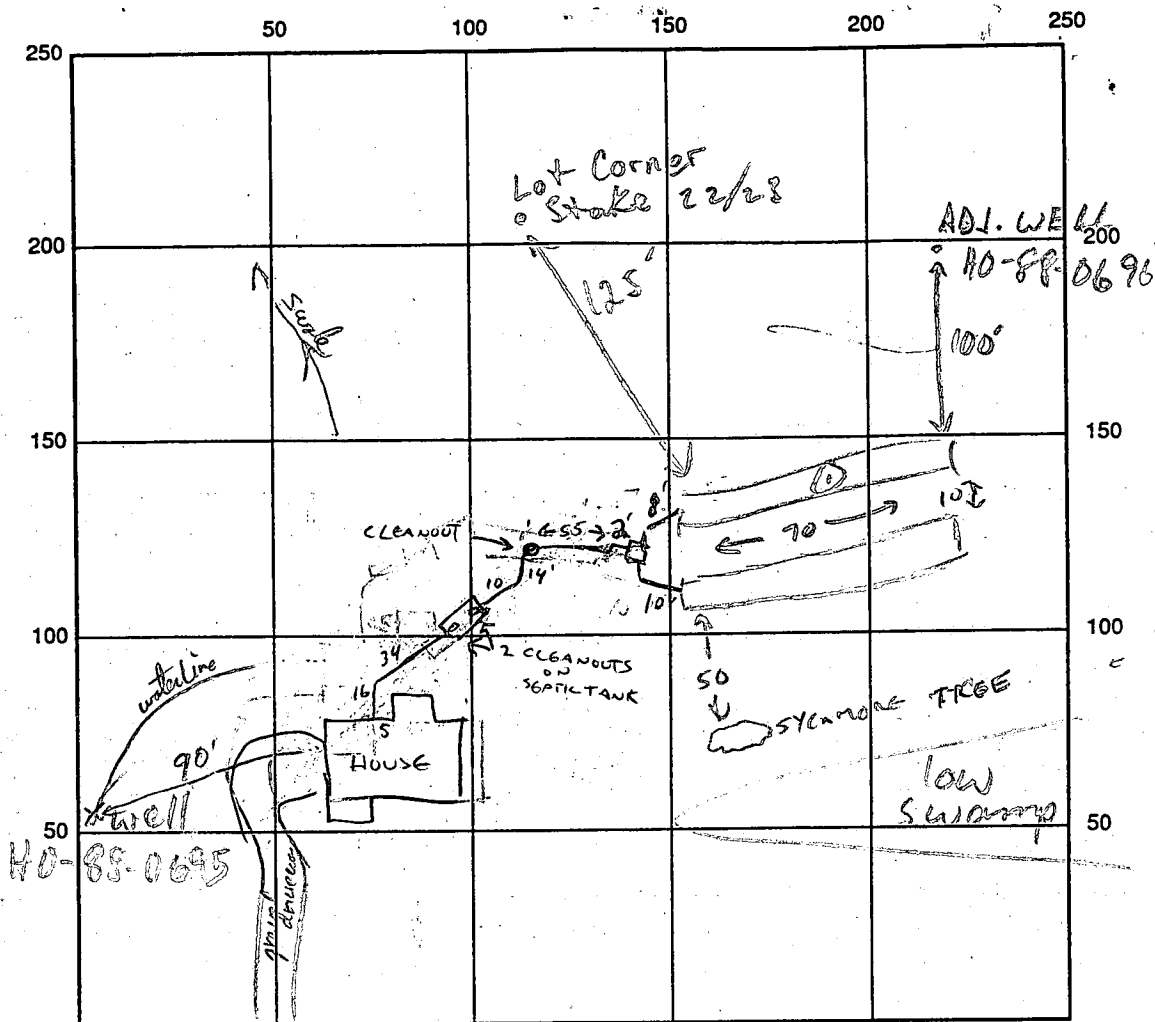

FOREST CREEK CT

INDICATE NORTH - NAME ADJOINING ROADWAY AS BASE LINE

SEPTIC TANK LEVEL _____ CLEANOUTS ^② ST-Front & Back; ^① IN-LINE

DISTRIBUTION BOX LEVEL

DRAIN FIELD/TITLE DEPTH $\frac{112}{9 \frac{1}{2}}$ FT. TRENCH WIDTH 2 FT. INLET DEPTH $\frac{112}{3 \frac{1}{2}}$ FT.

EFFECTIVE GRAVEL DEPTH $\frac{112}{6 \frac{1}{2}}$ FT. TOTAL LENGTH ① 70 ② 70 FT.

NUMBER OF TRENCHES 2 ONE SIDEWALL/BOTTOM AREA $\frac{① 420}{② 420}$ SQ. FT.

DRYWALL INSIDE DIAMETER _____ FT. EFFECTIVE DEPTH BELOW INLET _____ FT.

ABSORBENT AREA 840 SQ. FT.

REMARKS: 1/6/92 #1 OK TO COVER TRENCH ①, DIG ② MR

1/6/92 OK TO STAKE & CONGR 2ND TRENCH CW. DISTRIBUTION BOX TO BE STAKED FOR FUTURE LOCATION.

2/20/92 (AS PER LETTER OF 2/10/92) BUILDER NOTIFIED 2ND TANK TO SEAVE AS FUTURE PUMP PIT WOULD BE REQUIRED.

RESOLVED SOILS COLLECTED FROM INSTALLED SEPTIC SYSTEM DETERMINED TO BE SATURATED w/ INSUFF PERC RATE,

4/7/92 SYSTEM COMPLETED. PLAN OF REVISED SEWAGE DISPOSAL EMERGENCY TO BE SUBMITTED, C.W.

DATE SYSTEM APPROVED 4/7/92 INSPECTOR C. Wilton

APPLICATION

PERCOLATION TESTING

A 39060

P _____

HOWARD COUNTY HEALTH DEPARTMENT
BUREAU OF ENVIRONMENTAL HEALTH
P.O. BOX 476 ELLICOTT CITY, MARYLAND 21043
TELEPHONE: 461-9933

DISTRICT 3

DATE 3/4/87

TO: THE COUNTY HEALTH OFFICER
ELLICOTT CITY, MARYLAND

I, HEREBY, APPLY FOR THE NECESSARY TEST IN ORDER TO CONSTRUCT (OR RECONSTRUCT) A SEWAGE DISPOSAL SYSTEM.

PROPERTY OWNER Richard Arrington Grayson Homes Inc

ADDRESS 1050 Sykesville Rd. West Friendship MD PHONE 461-5900
301-776-7454

PROSPECTIVE BUYER Amberwoods Limited Partnership

ADDRESS 420 Fenwick Lane Silver Spring MD PHONE 301-587-5455

PROPERTY LOCATION:

SUBDIVISION Amberwoods (S-87-42) LOT NO. 2822

ROAD AND DESCRIPTION Rt 32 north of Rt 99
(12809 Forest Creek Ct)

TAX MAP 9 PARCEL # 4

SIZE OF LOT 3.28 AC TYPE BLDG. Single Family
(SINGLE FAMILY DWELLING OR COMMERCIAL)

THE SYSTEM INSTALLED UNDER THIS APPLICATION IS ACCEPTABLE ONLY UNTIL PUBLIC FACILITIES BECOME AVAILABLE. I FULLY UNDERSTAND THE FEE CONNECTED WITH THE FILING OF THIS PERC TEST APPLICATION IS NON-REFUNDABLE UNDER ANY CIRCUMSTANCES. I ALSO AGREE TO COMPLY WITH ALL M.O.S.H.A. REQUIREMENTS IN TESTING THIS LOT.

Sam Negalla
(SIGNATURE OF APPLICANT)

APPROVED BY _____ FOR _____ DATE _____



REJECTED BY _____ FOR _____ DATE _____

HOLD PENDING FURTHER TESTS _____ DATE _____


REASONS FOR REJECTION OR HOLDING _____

BLDG. PERMIT SIGNED
AND RETURNED 12/19/86
Serial # 40604
SFO-4 Decker

THIS IS NOT A PERMIT

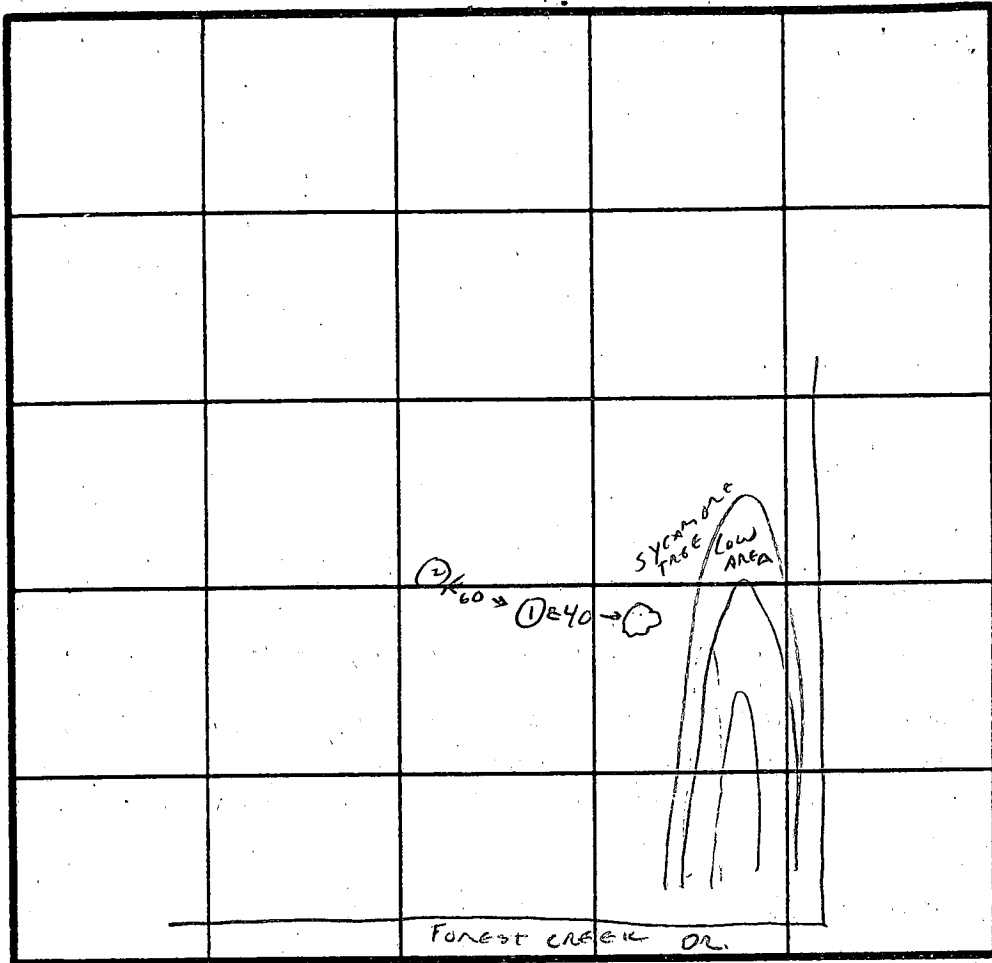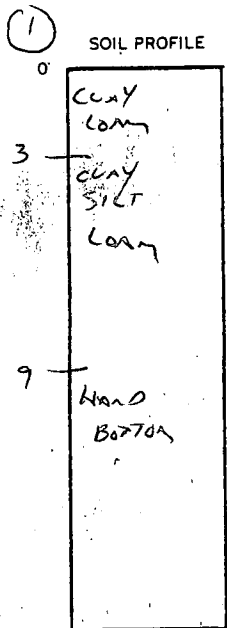

INDICATE NORTH - NAME ADJOINING ROADWAY AS BASE LINE.

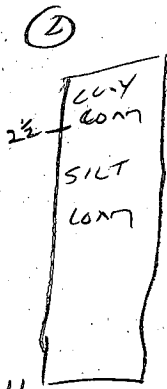

DATE	TEST NO.	DEPTH	PRE-WET		TEST - 1" DROP		TIME
			START	STOP	START	STOP	
12/20/91	1	4' 9' HAND BOTTOM	9:36	10:02	10:02	10:30	28 MIN
	2	3' 9'	VIS OK	3-11'			
		11'	PONDON SILT LOAM				28 MIN PER IF TESTED
			TEST HOLE 2 IS AT FAR END OF PLANNED				
			UPPER TRENCH				
			- LOT LINE STAKE-OUT REQUIRED SO SYSTEM MAY BE				
			INSTALLED AS CLOSE TO LOT LINE AS POSSIBLE.				

REMARKS LOWER HALF OF PLATTED SEPTIC AREA UNACCEPTABLE,
TOO CLOSE TO DRAINAGE AREA. SLOW PENCES
TYPE OF SOIL & PROBABLE WATER TABLE!


TESTED BY CW [Signature] ALSO PRESENT KEN SCHISSLER

5/25/87



NEW 22 / OLD 29-27

1 TEST PROPOSAL NOT TESTED - UNACCEPTABLE
IN WET LAND LOCATION



2 NO TEST UNACCEPTABLE
CROSSING R1066 / SWALE

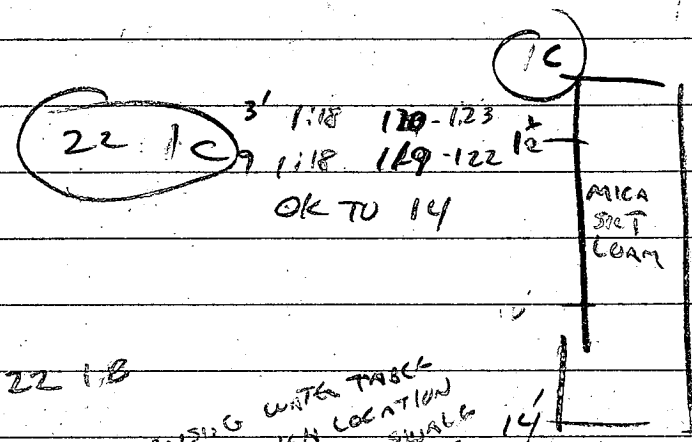


22 1B
SURFACING WATER TABLE
VERY HIGH LOCATION
AT HEAD OF SWALE

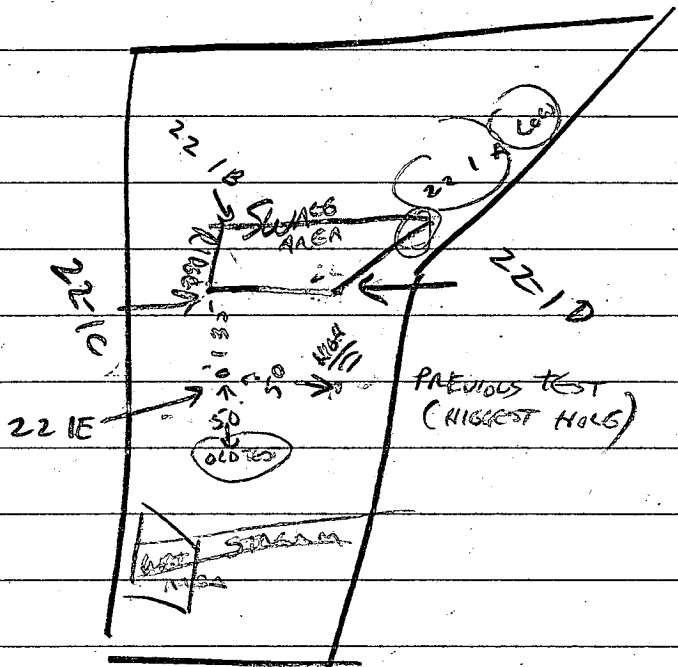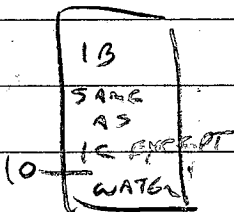

22 1D
VIS OK
1-12'

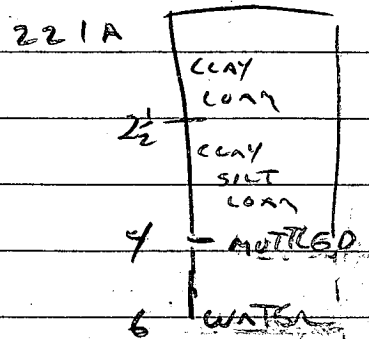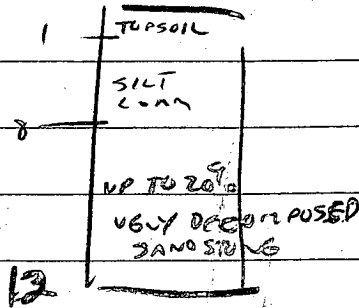

22 1E
3' 124 125 127
OK 3-9 1/2 HARD BOTTOMS

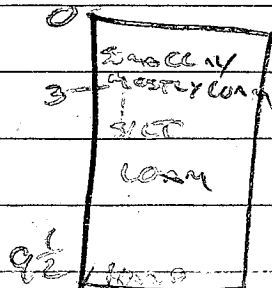


RESOLVED

ADJUSTMENT TO
ON OPPOSITE

PLANT ANTICIPATED 5/1/92

SEWAGE DISPOSAL EASEMENT
SIDE OF "SADDLE"

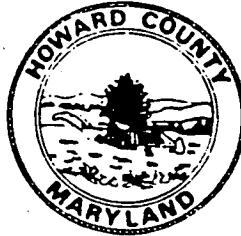

HOWARD COUNTY HEALTH DEPARTMENT

Joyce M. Boyd, M.D., County Health Officer

February 24, 1992

Reply to:

Grayson Homes, Inc.
9025 Chevrolet Drive
Ellicott City, Maryland 21042
Attention: Peggy Faith,
Production Coordinator

RE: Septic System Installation
Amberwoods Subdivision - Lot 22
12809 Forest Creek Court

Dear Ms. Faith:

Installation inspection of the above referenced septic system revealed satisfactory soil conditions in the higher portion of the platted septic easement where the system was installed, but not in lower portions of the easement. Limiting factors were slow percolation rates and seasonally high water table. Follow-up percolation testing was conducted elsewhere on the property on February 20, 1992 in an attempt to establish an option for gravity repair.

That testing was not successful, leading to the conclusion that future repair to the septic system can be accomplished only by pumping to higher ground. To facilitate this adjustment, two adjustments are requested:

1. - Install two septic tanks in series. The second tank would be expected to lengthen the life of the initial septic system by improving the quality of the effluent, as well as allowing convenient conversion to a pump pit at such time in the future as one may be needed.
2. - Submit a "modified sewage easement" plan for Health Officer's signature. A suggested modification is shown on the attached enclosure.

If you have any questions relative to this matter, please call me at 461-9933.

Very truly yours,

Craig Williams, Program Director
Water and Sewerage Program

CW:jr
Enclosure
cc: Paul Schissler

EASEMENT

2/24/92


TO: GRAYSON HOMES
FROM: CARL WILLIAMS
HOW: COUNTY HEALTH DEPT.
SUGGESTED CONFIGURATION FOR
"REVISED SEWAGE DISPOSAL EASEMENT"

LQT 22
3.8563 AC.


ANY LOCAL ENGINEERING FIRM
(BOENDER) ~~LAND~~ DESKJ (E) SHOULD BE ABLE TO COMPLETE.

SEWAGE DISPOSAL EASEMENT

~~DELETE~~

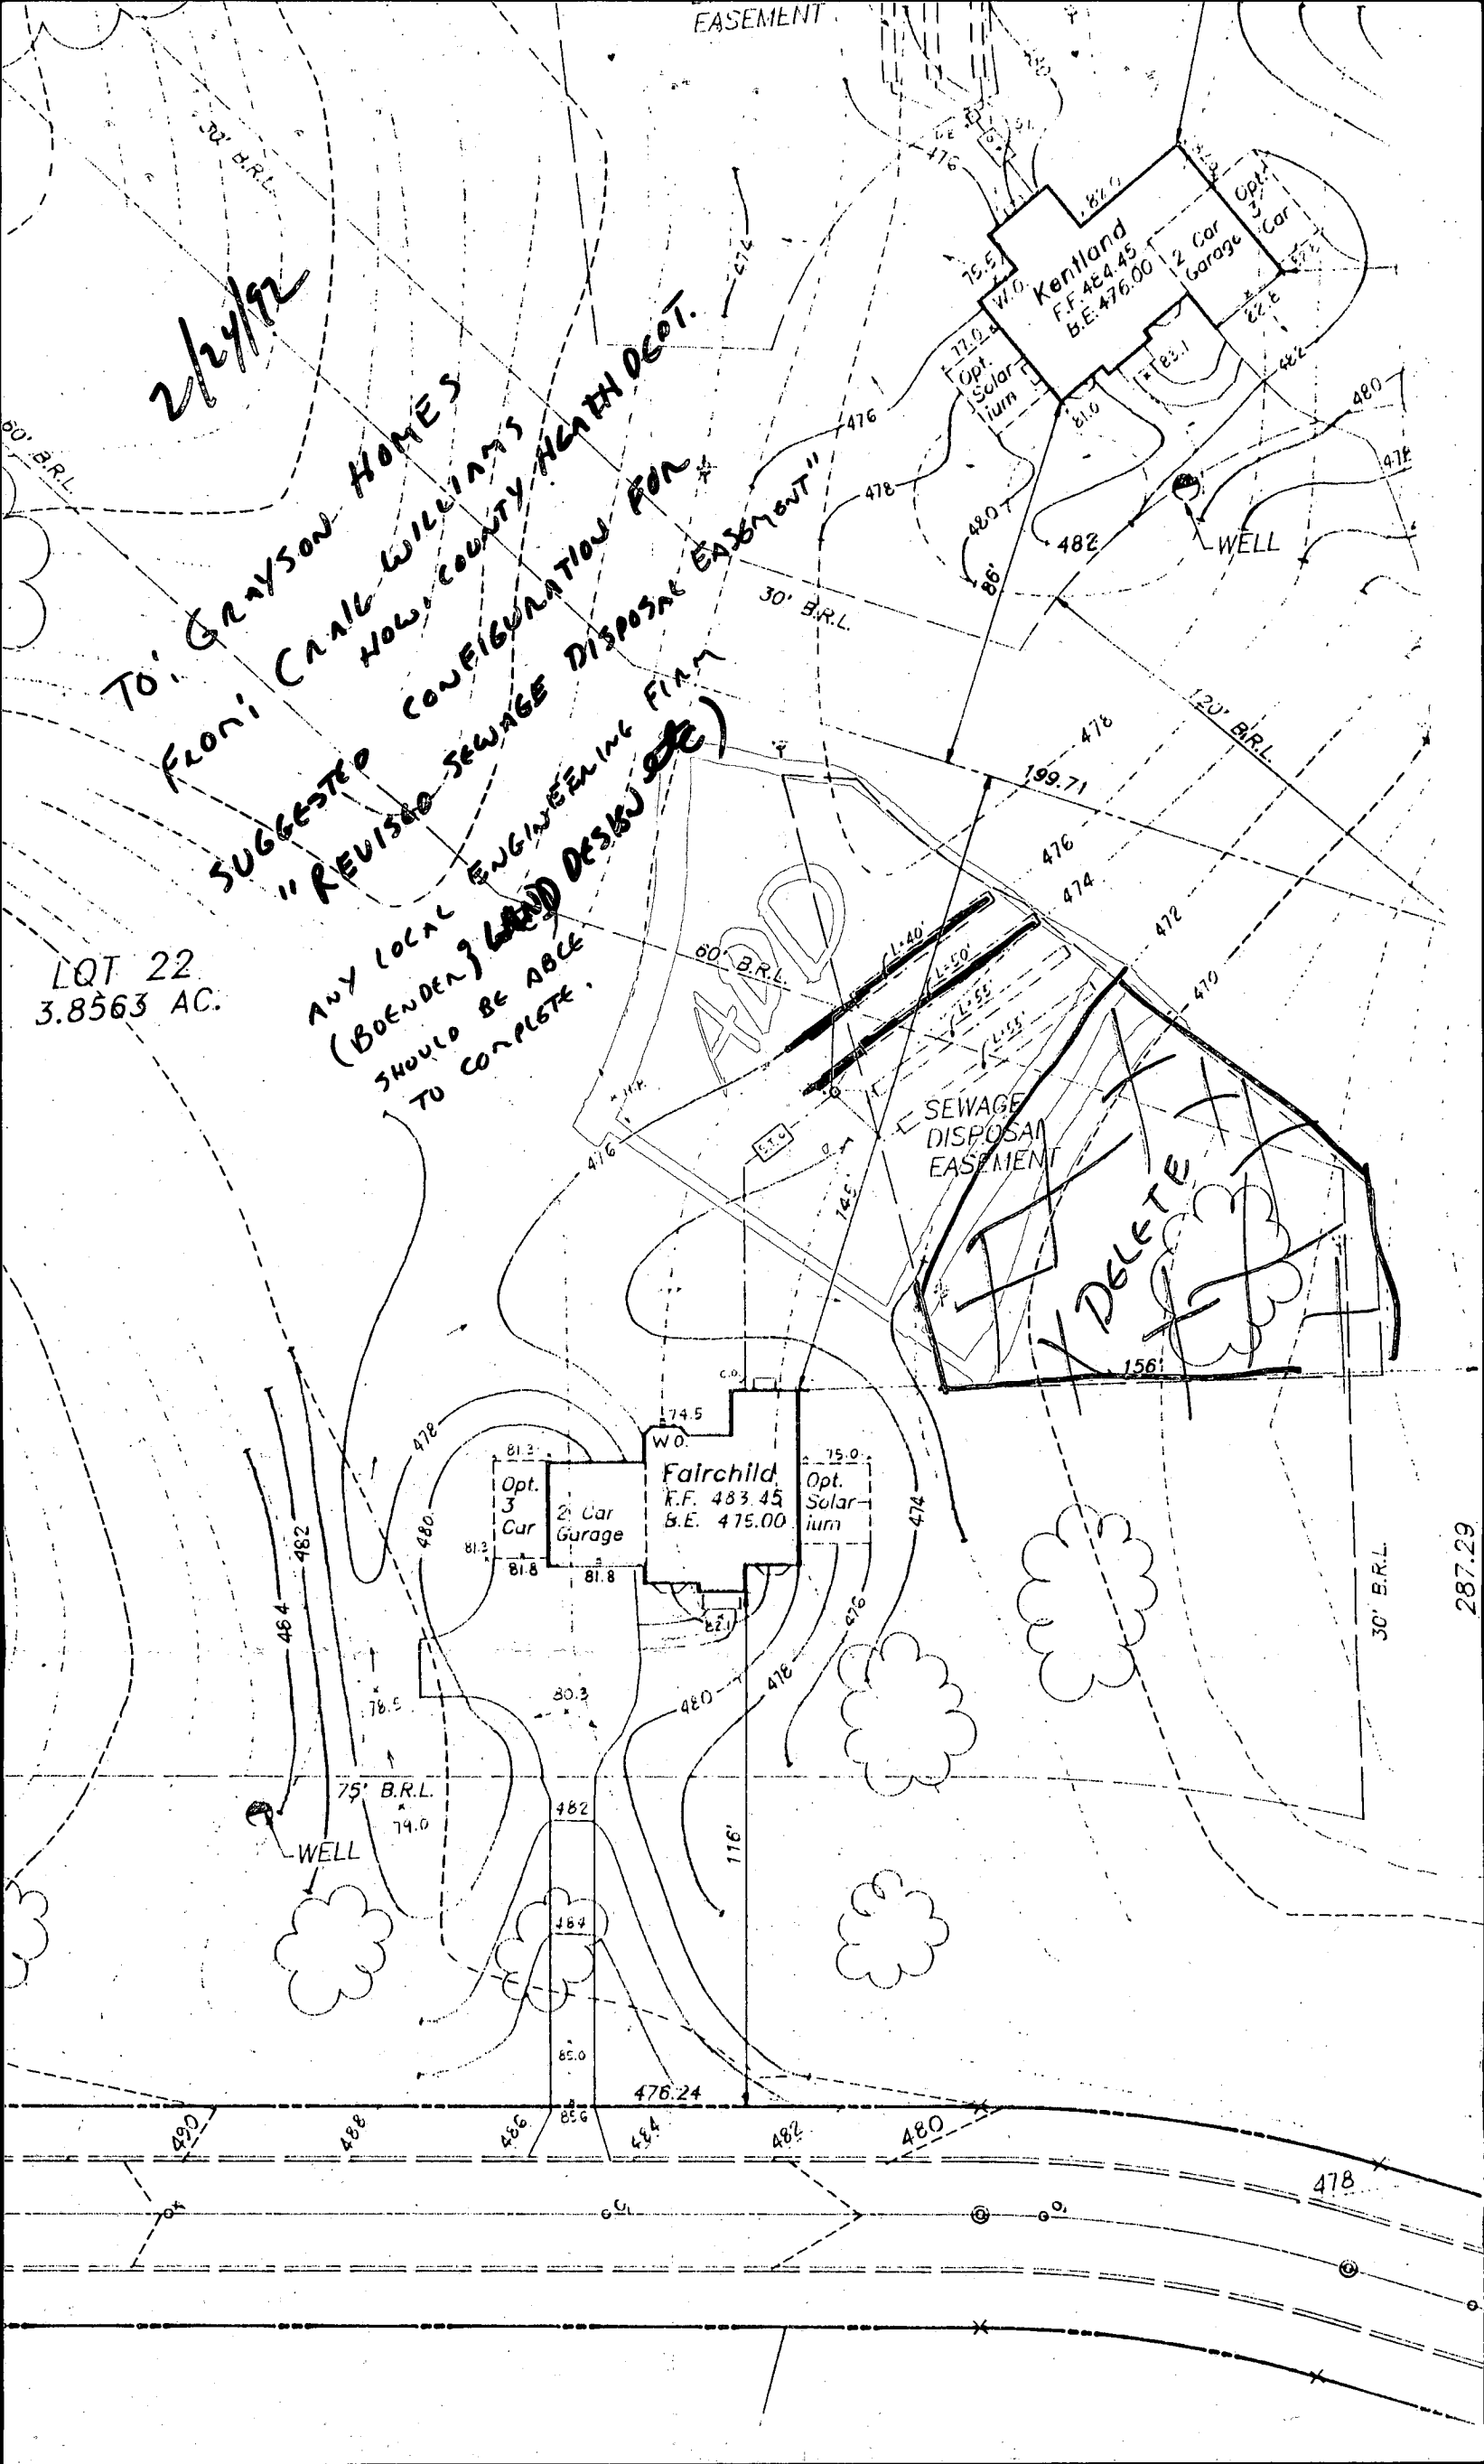

287.29

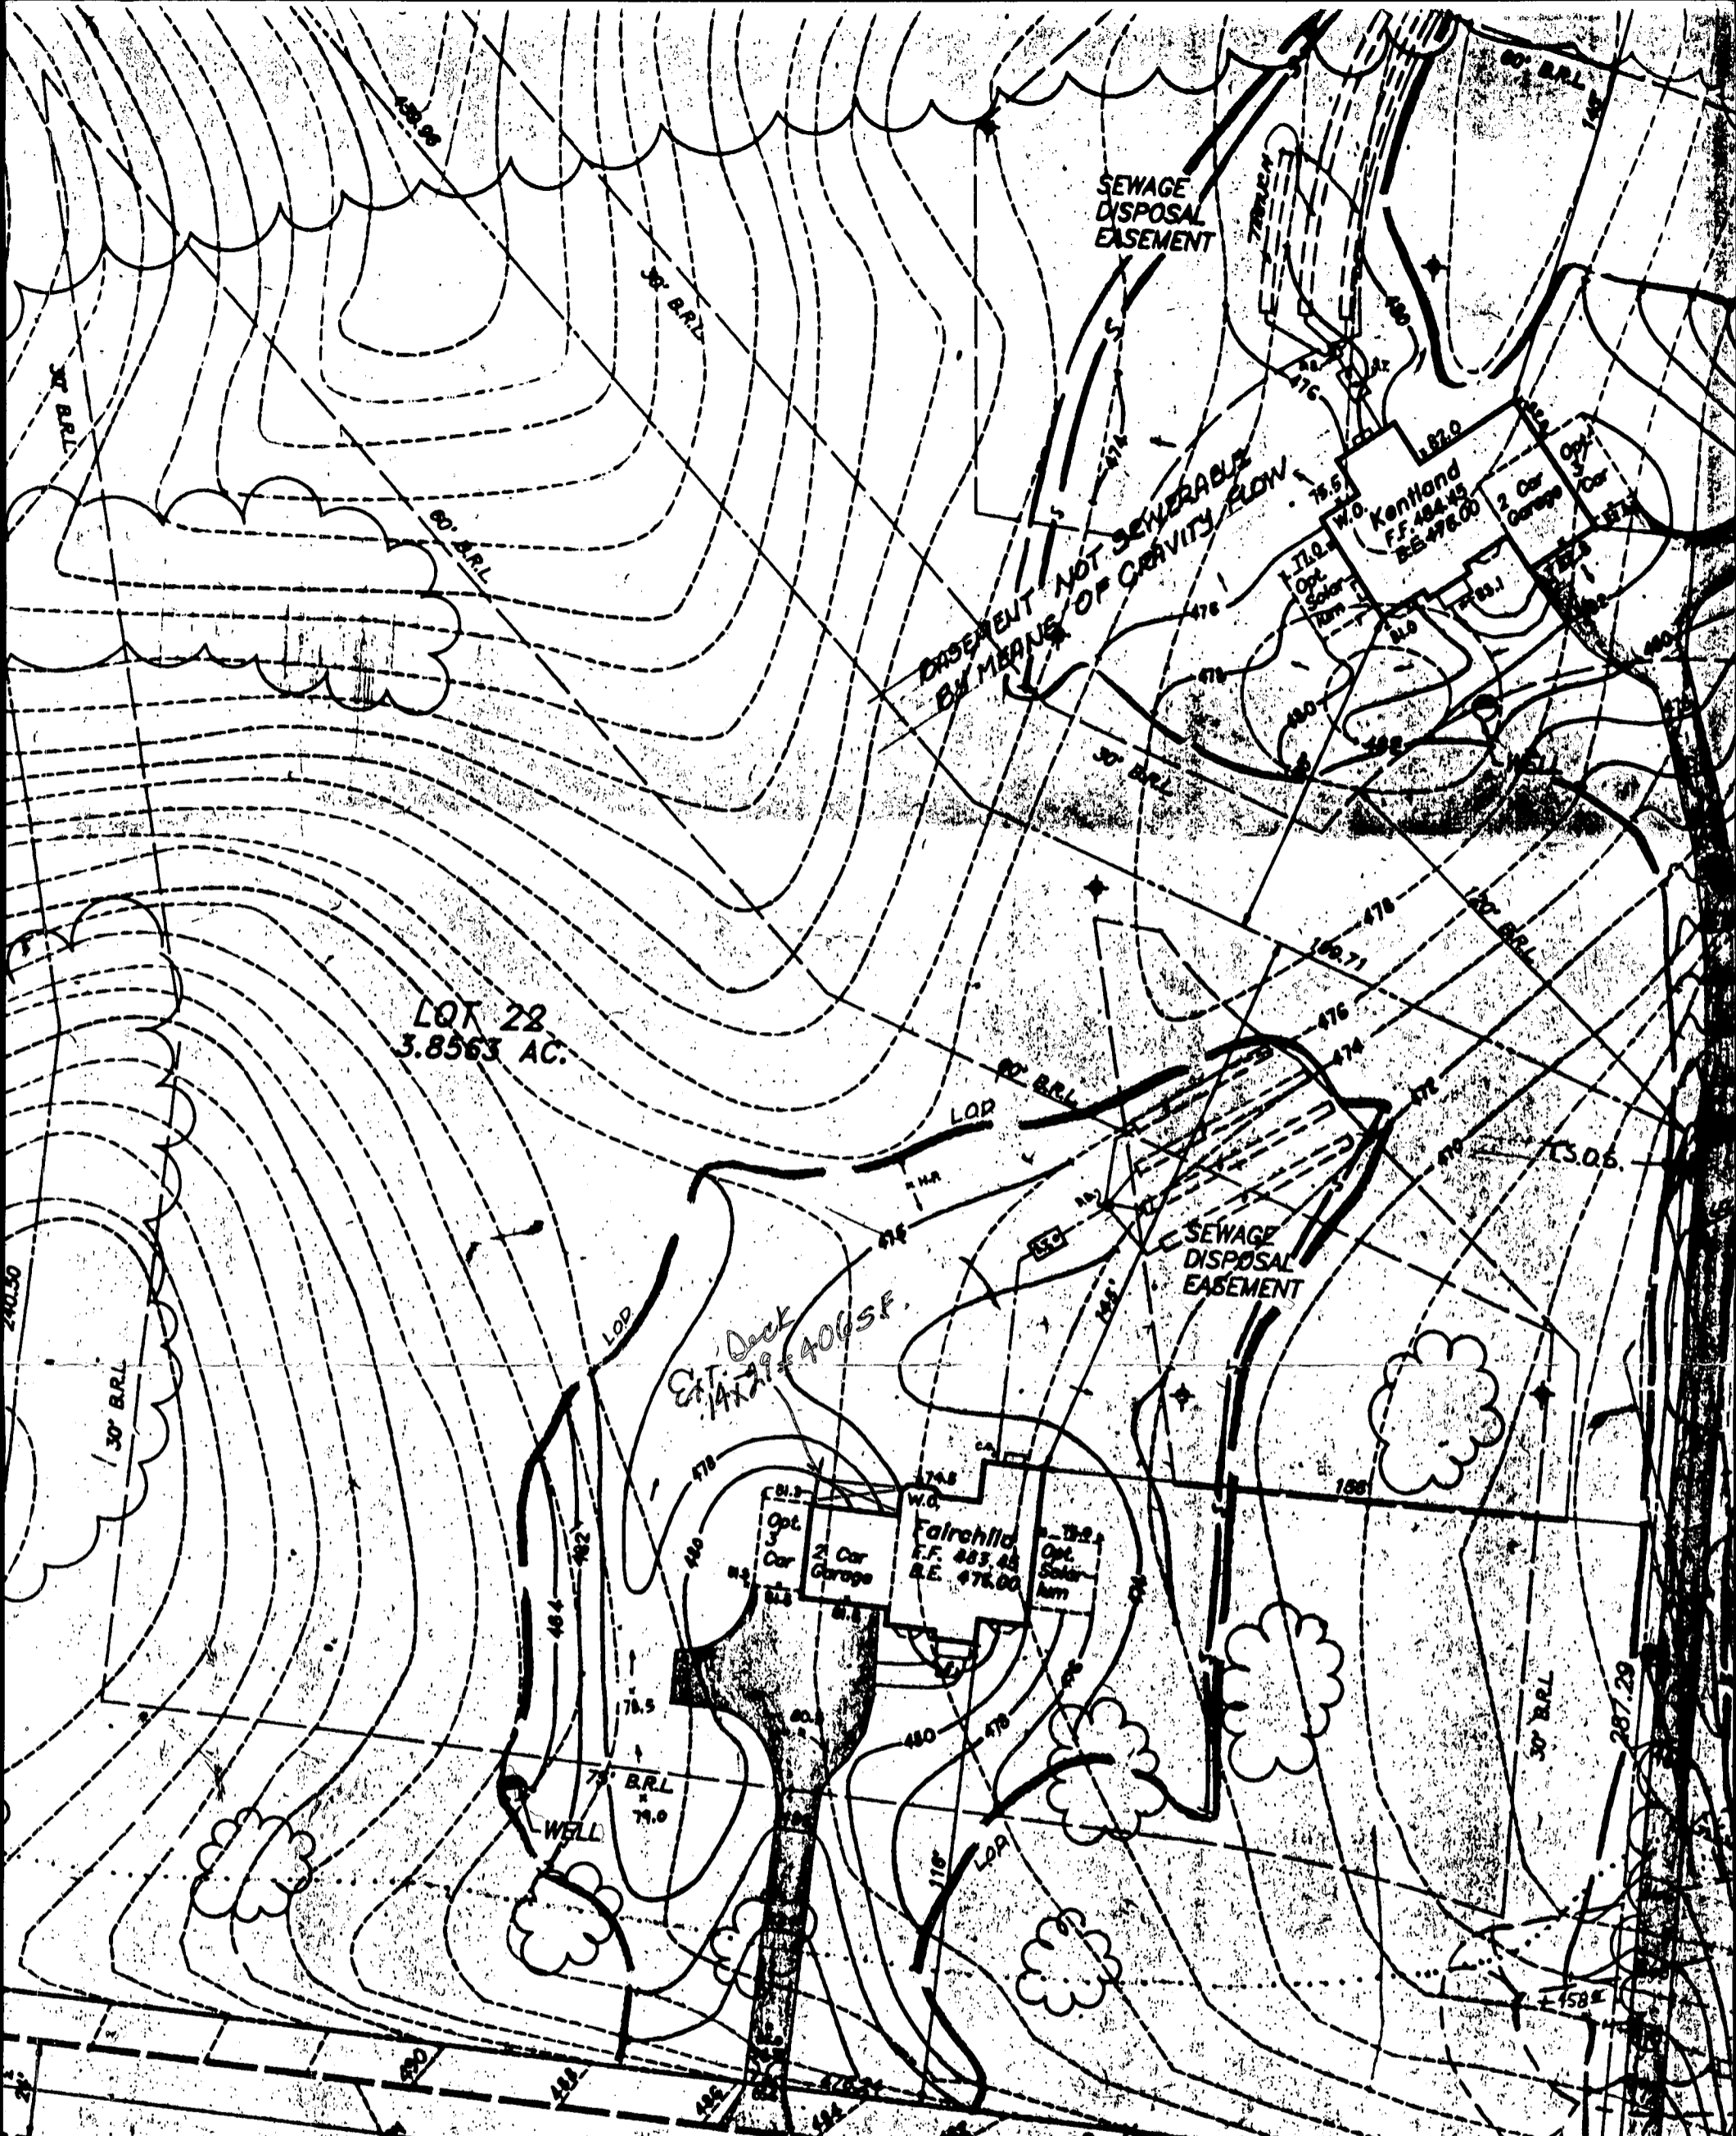

LOT 22
3.8563 AC.

SEWAGE DISPOSAL EASEMENT

DISEASEMENT NOT SEWERABLE BY MEANS OF GRAVITY FLOW

SEWAGE DISPOSAL EASEMENT

Fairhill
F.F. 483.45
B.E. 476.00

Kentland
F.F. 484.45
B.E. 476.00

WELL

FOREST CREEK COURT


FOREST CREEK COURT

AMBERWOODS 7/14/11
Set 1 Phase 1
LOT 31 (SEE SHEET #6)

NOTES:

- MAXIMUM SLOPE OF SEWER PIPES: 1/4" / 1'
- MINIMUM SLOPE OF SEWER PIPES: 1/8" / 1'
- NO CONSTRUCTION TO IMPACT SEWAGE EASEMENT, INCLUDING DRIVEWAYS
- TRENCH LENGTH TO BE DETERMINED AS REQUIRED
- HEALTH DEPT. AT LATER DATE


0819 0914

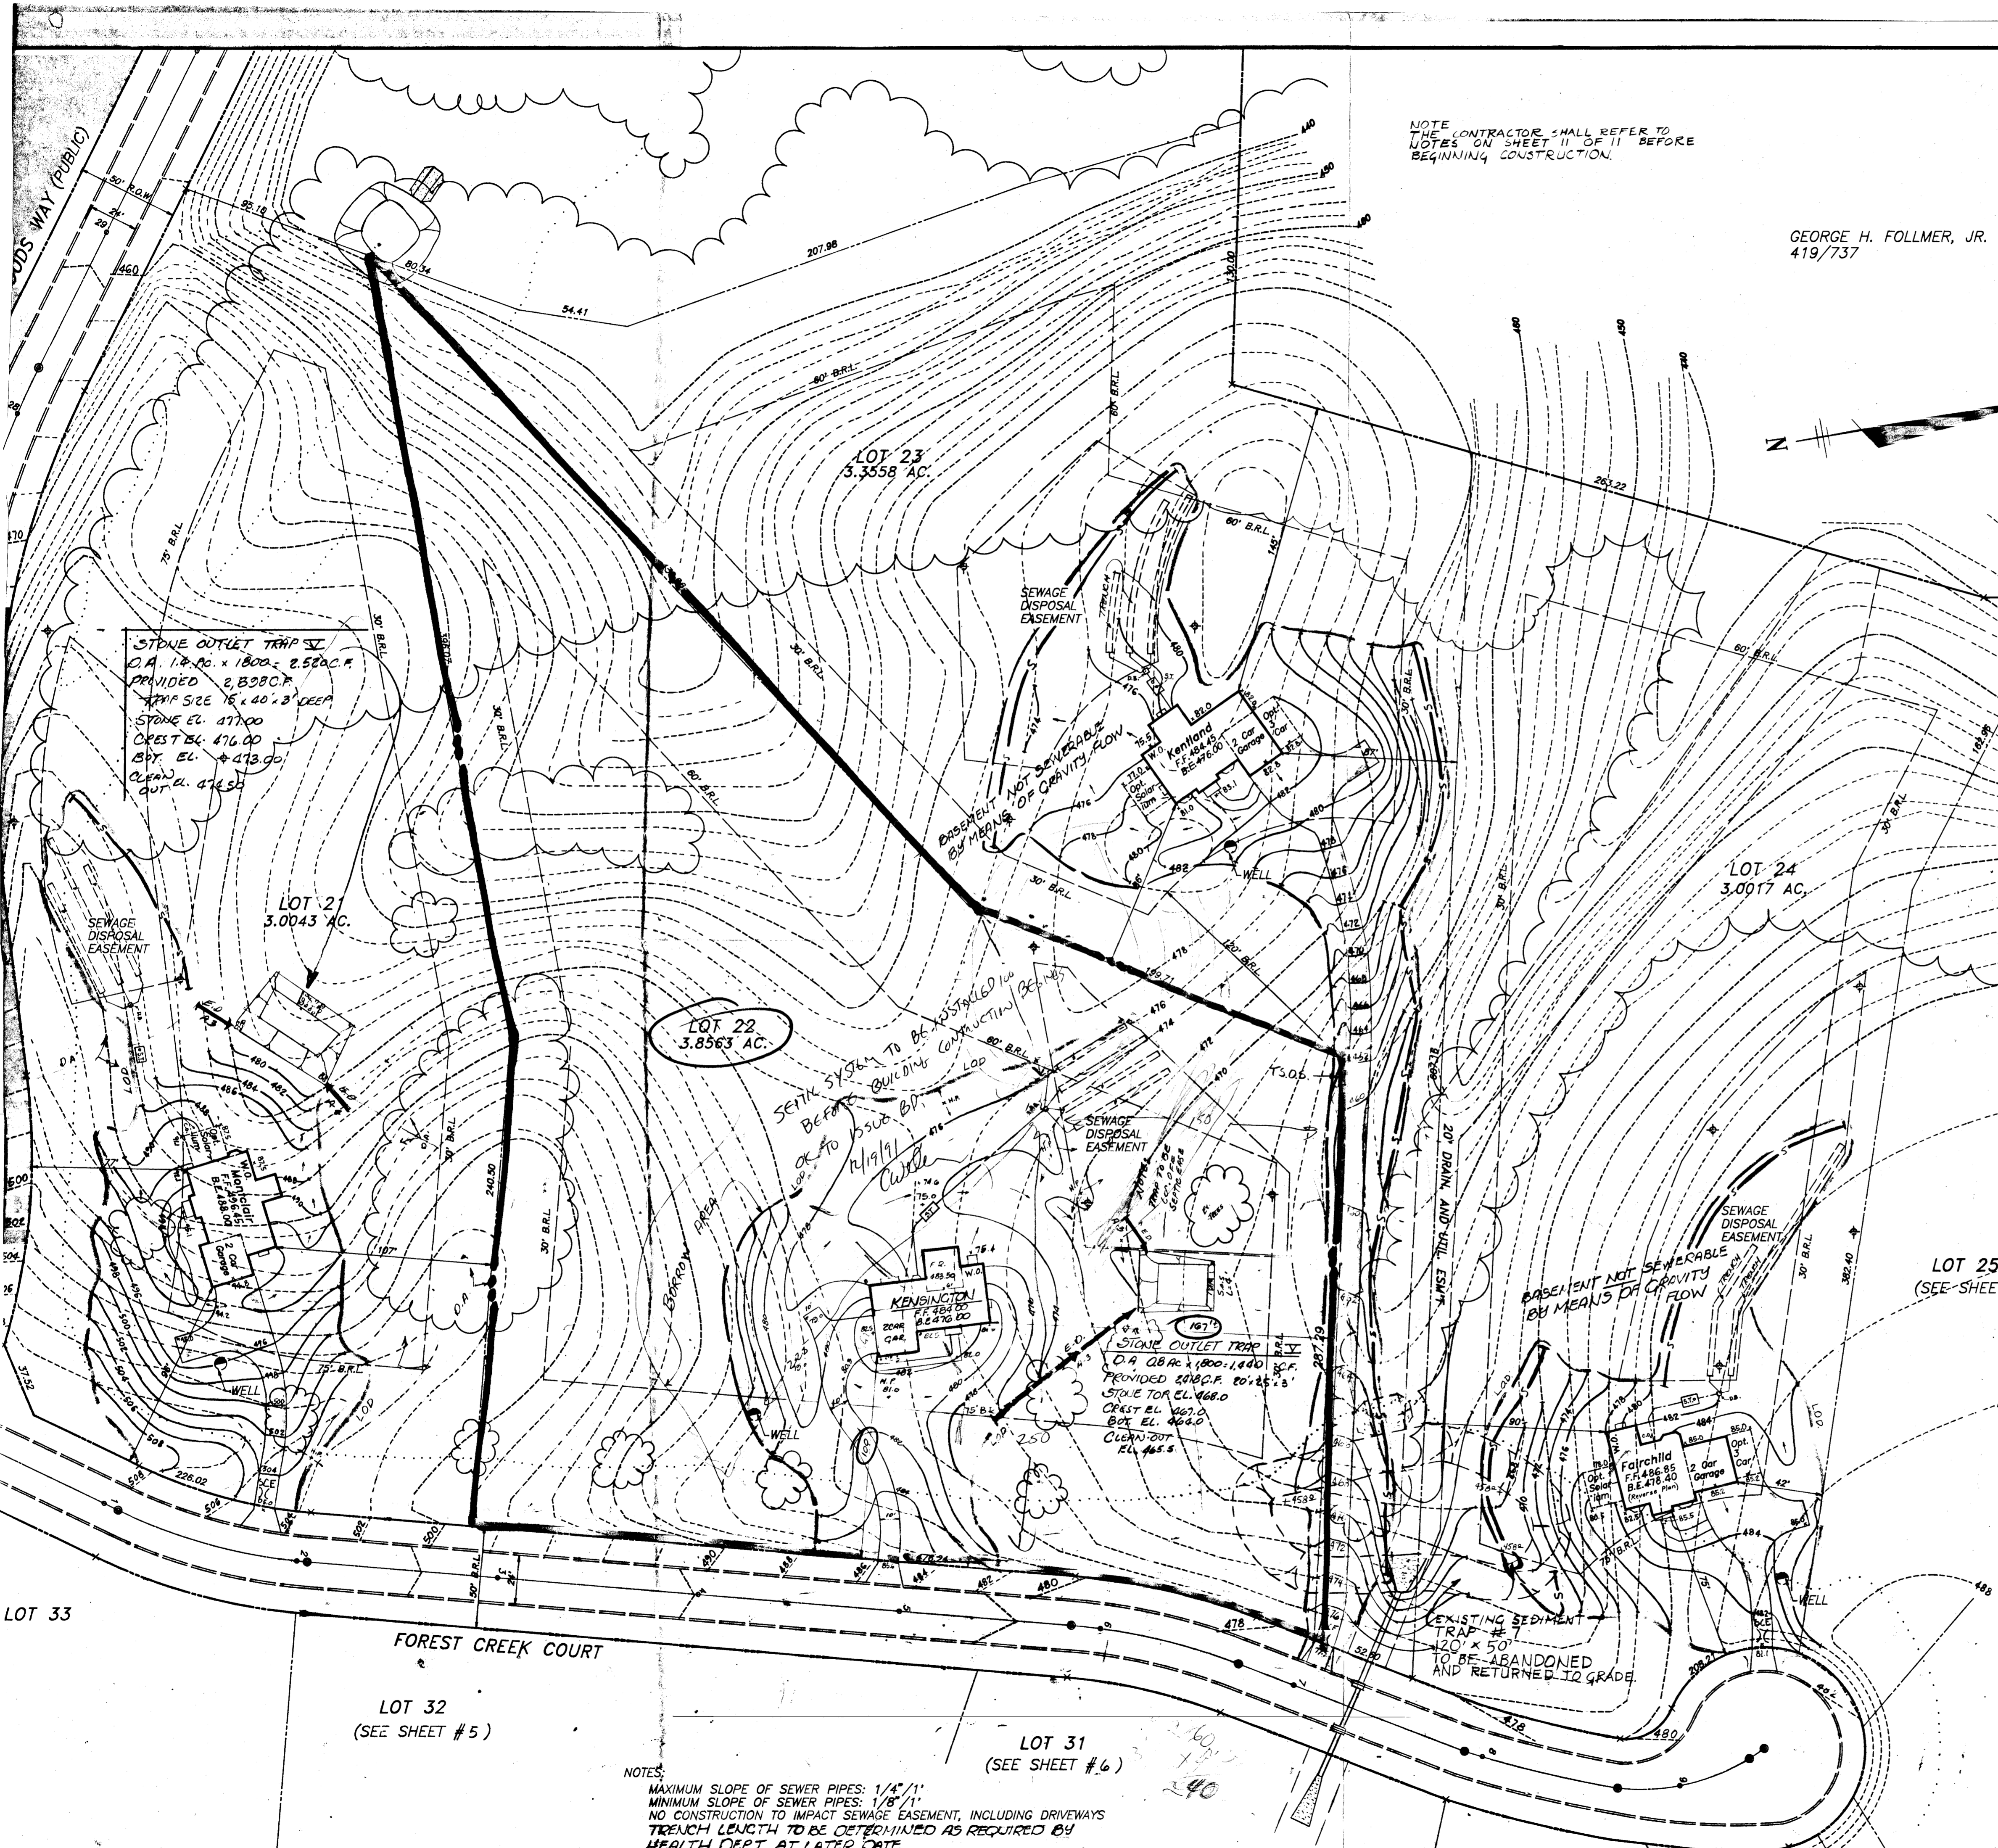

NOTE CONTRACTOR SHALL REFER TO LOTS ON SHEET 11 OF 11 BEFORE BEGINNING CONSTRUCTION.

GEORGE H. FOLLMER, JR.
419/737

DEVELOPER'S/BUILDER'S CERTIFICATE
I WE CERTIFY THAT ALL DEVELOPMENT AND CONSTRUCTION WILL BE DONE ACCORDING TO THESE PLANS, AND THAT ALL RESPONSIBLE PERSONS INVOLVED IN THE CONSTRUCTION PROJECT WILL HAVE A CERTIFICATE OF ATTENDANCE AT A DEPT. OF NATURAL RESOURCES APPROVED TRAINING PROGRAM FOR THE CONTROL OF SEDIMENT AND EROSION CONTROL BEFORE BEGINNING THE PROJECT. I ALSO AUTHORIZE PERIODIC ON-SITE INSPECTION BY THE HOWARD SOIL CONSERVATION DISTRICT OR THEIR AUTHORIZED AGENTS AS DEEMED NECESSARY.

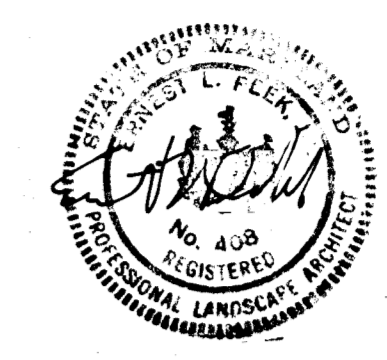

Floyd Grason for Grason Homes, Inc. DATE
 ENGINEERS CERTIFICATE
 I CERTIFY THAT THIS PLAN FOR EROSION AND SEDIMENT CONTROL REPRESENTS A PRACTICAL AND WORKABLE PLAN BASED ON MY PERSONAL KNOWLEDGE OF THE SITE CONDITIONS. THIS WAS PREPARED IN ACCORDANCE WITH THE REQUIREMENTS OF THE HOWARD SOIL CONSERVATION DISTRICT.
 Ernest L. Peck, ASLA 10/10/89 DATE
 LANDSCAPE ARCHITECT
 REVIEWED FOR HOWARD S.C.D. AND MEETS TECHNICAL REQUIREMENTS
 U.S. SOIL CONSERVATION SERVICE DATE
 THIS DEVELOPMENT PLAN IS APPROVED FOR SOIL EROSION AND SEDIMENT CONTROL BY THE HOWARD SOIL CONSERVATION DISTRICT
 HOWARD S.C.D. DATE

LEGEND

- B.R.L. BUILDING RESTRICTION LINE
- B.L. BOUNDARY LINE
- 500 EXISTING CONTOUR
- 500 PROPOSED CONTOUR
- EXISTING TREES
- S.C.E. STABILIZED CONSTRUCTION
- S-S ENTRANCE
- SILT FENCE

Environ Health

MINIMUM DISTANCES REQUIRED

- HOUSE TO WELL: 30'
- HOUSE TO SEWAGE EASEMENT: 20'
- HOUSE TO SEPTIC TANK: 10'
- WELL TO SEPTIC TANK OR SEWAGE EASEMENT: 100' (OR AS APPROVED BY HEALTH DEPARTMENT)
- WELL TO LOT LINES: 10'
- WELL TO ROADS: 15'
- SEWAGE EASEMENT TO LOT LINES: 10'

LOT 22 ONLY

# 21	# 22	# 23	# 24	LOT NUMBER
488.00	476.00	476.00	478.40	BASEMENT ELEVATION (if applicable)
486.48	484.00	484.45	486.85	FIRST FLOOR ELEVATION
486.00	474.00	480.00	483.85	INVERT OUT OF HOUSE
485.20	473.40	479.00	480.85	INVERT INTO SEPTIC TANK
484.90	473.75	478.75	480.40	INVERT OUT OF SEPTIC TANK
484.70	472.50	478.50	479.80	INVERT INTO DISTRIBUTION BOX (if applicable)
484.50	472.00	477.50	479.00	INVERT INTO TRENCH(S)
487.50	477.00	480.20	481.20	EXISTING GRADE AT SEPTIC TANK
487.30	474.80	479.50	482.00	EXISTING GRADE AT DISTRIBUTION BOX (if applicable)
487.10	475.50	479.50	482.00	EXISTING GRADE AT TRENCH(S)
504.00	485.00	480.50	486.30	ELEVATION OF WELL AT GRADE

LAND DESIGN ASSOCIATES 718 HIGHWOOD DRIVE BALTIMORE, MD. 21212 301-323-6344
 OFFICE OF PLANNING & ZONING P-87-59 S-87-42 VP-87-65 WP-89-107 WP-88-112

AMBERWOODS
 SECTION ONE PHASE ONE LOTS 21, 22, 23 & 24
 SITE DEVELOPMENT & SEDIMENT CONTROL
 SECOND ELECTION DISTRICT
 HOWARD COUNTY, MARYLAND

FOR: GRAYSON HOMES INC. 9025 CHEVROLET DRIVE ELLICOTT CITY MD. 21043
 DESIGNED: C.D.A.
 CHECKED: C.D.A.
 SCALE: 1"=40'
 SHEET 9 OF 11
 DATE: 12/3/89

NOTES:
 MAXIMUM SLOPE OF SEWER PIPES: 1/4" / 1'
 MINIMUM SLOPE OF SEWER PIPES: 1/8" / 1'
 NO CONSTRUCTION TO IMPACT SEWAGE EASEMENT, INCLUDING DRIVEWAYS
 TRENCH LENGTH TO BE DETERMINED AS REQUIRED BY HEALTH DEPT. AT LATER DATE

B 1 **1226** SEQUENCE NO. (DP. USE ONLY)
 (THIS NUMBER IS TO BE PUNCHED IN COLS. 3-6 ON ALL CARDS)


STATE OF MARYLAND
 PERMIT TO DRILL WELL
 please print or type

STATE PERMIT NUMBER
40-88-0695
 fill in this form completely

Date Received (APA) **042489**
 OWNER INFORMATION
KODEN DEVELOPMENT
1 CENTRE PARK DR
COLUMBIA MD 21045

B 3 LOCATION OF WELL R-44060
HOWARD COUNTY
AMERWOODS SUBDIVISION
 SECTION **22** LOT **22**
SYKESVILLE NEAREST TOWN
 MILES FROM TOWN (enter 0 if in town) **2 MI**

DRILLER INFORMATION
 George F. Easterday
 Driller's Name
L. Franklin Easterday, Inc.
 Firm Name
9265 Brown Church Rd., MT. Airy, MD. 21771
 Address
George F. Easterday Signature
3-31-89 Date

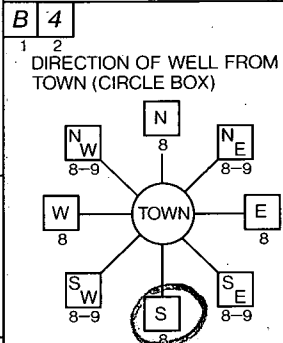

(RT 32) **ROCHESTER CT.**
 NEAR WHAT ROAD
FOREST CREEK CT
 ON WHICH SIDE OF ROAD (CIRCLE APPROPRIATE BOX)

 DISTANCE FROM ROAD **80** FT

B 2 WELL INFORMATION
 APPROX. PUMPING RATE (GAL. PER MIN.) **5**
 AVERAGE DAILY QUANTITY NEEDED (GAL. PER DAY) **500**

USE FOR WATER (CIRCLE APPROPRIATE BOX)
 HOME (SINGLE OR DOUBLE HOUSEHOLD UNIT ONLY)
 FARMING (LIVESTOCK WATERING & AGRICULTURAL IRRIGATION)
 INDUSTRIAL, COMMERCIAL, STATE AND FEDERAL GOV. OTHER (REQUIRES APPROPRIATION PERMIT)
 PUBLIC OR PRIVATE WATER COMPANY (REQUIRES APPROPRIATION PERMIT AND STATE HEALTH DEPARTMENT APPROVAL)
 TEST, OBSERVATION, MONITORING (MAY REQUIRE APPROPRIATION PERMIT)

NOT TO BE FILLED IN BY DRILLER HEALTH DEPARTMENT APPROVAL
HOWARD COUNTY NAME
A39060 COUNTY NO.
 STATE SIGNATURE _____ DATE ISSUED _____
060889 CO SIGNATURE **Craig Williams** EXP. DATE **12/2/89**
 NORTH GRID **548000** EAST GRID **0071000**


APPROXIMATE DEPTH OF WELL **200** FEET

APPROXIMATE DIAMETER OF WELL **6** INCH

METHOD OF DRILLING (circle one)
 BORED (or Augered) JETTED Jetted & DRIVEN
 AIR-ROTARY AIR-PERCussion ROTARY (Hydraulic Rotary)
 CABLE REVerse-ROTary Drive-POINT
 other _____

SHOW MAJOR FEATURES OF BOX & LOCATE WELL WITH AN X
 SOURCES OF DRILLING WATER
 1. WELL
 2.
 3.
 WRITE THE BOX NUMBER FROM THE MAP HERE
810
548

REPLACEMENT OR DEEPEMED WELLS (CIRCLE APPROPRIATE BOX)
 THIS WELL WILL NOT REPLACE AN EXISTING WELL.
 THIS WELL WILL REPLACE A WELL THAT WILL BE ABANDONED AND SEALED
 THIS WELL WILL REPLACE A WELL THAT WILL BE USED AS A STANDBY
 THIS WELL WILL DEEPEM AN EXISTING WELL
 PERMIT NUMBER OF WELL TO BE REPLACED OR DEEPEMED (IF AVAILABLE) _____

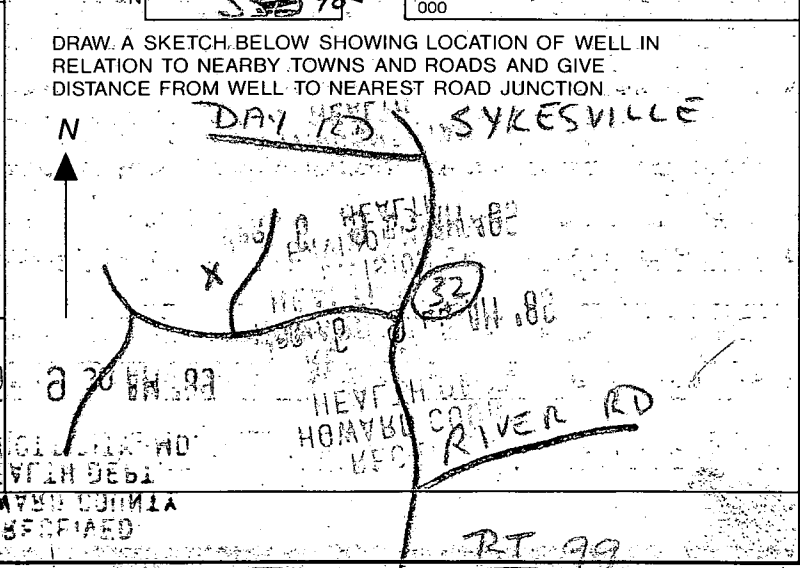

Not to be filled in by driller. (OEP. USE ONLY)
 APPROP. PERMIT NUMBER _____ GAP _____
 FORCE **CLW** WRITE INITIALS IN BOX PERMIT No. **40-88-0695**

SPECIAL CONDITIONS

C1 9904 SEQUENCE NO. (DENV USE ONLY)

STATE OF MARYLAND WELL COMPLETION REPORT

THIS REPORT MUST BE SUBMITTED WITHIN 45 DAYS AFTER WELL IS COMPLETED.

(THIS NUMBER IS TO BE PUNCHED IN COLS. 3-6 ON ALL CARDS)

FILL IN THIS-FORM COMPLETELY PLEASE PRINT OR TYPE

COUNTY NUMBER A 39060

ST/CO USE ONLY DATE Received

DATE WELL COMPLETED

Depth of Well

PERMIT NO. FROM "PERMIT TO DRILL WELL"

Grid for ST/CO USE ONLY DATE Received

Grid for DATE WELL COMPLETED

Grid for Depth of Well

Grid for PERMIT NO.

OWNER: Karen Development last name, first name, TOWN: Sykesville, SUBDIVISION: Annapolis, SECTION: , LOT: 22

WELL LOG Not required for driven wells STATE THE KIND OF FORMATIONS PENETRATED, THEIR COLOR, DEPTH, THICKNESS AND IF WATER BEARING

Table with columns: DESCRIPTION (Use additional sheets if needed), FEET (FROM, TO), Check if water bearing. Includes entries for Top Soil, Shale, Brown Mica, Tan mica.

GROUTING RECORD WELL HAS BEEN GROUTED (Circle Appropriate Box) TYPE OF GROUTING MATERIAL CEMENT [CM] BENTONITE CLAY [BC] NO. OF BAGS 10 NO. OF POUNDS 1200 GALLONS OF WATER 65 DEPTH OF GROUT SEAL (to nearest foot) from 0 to 27 ft.

CASING RECORD casing types insert appropriate code below [ST] [CO] [PL] [OT] MAIN CASING TYPE [S+] Nominal diameter top (main) casing (nearest inch) [06] Total depth of main casing (nearest foot) [37]

OTHER CASING (if used) diameter inch depth (feet) from to

SCREEN RECORD screen type or open hole insert appropriate code below [ST] [BR] [HO] [PL] [OT] STEEL BRASS BRONZE PLASTIC OPEN HOLE OTHER

DEPTH (nearest ft.) grid for screen depth. SLOT SIZE 1 2 3 DIAMETER OF SCREEN (NEAREST INCH) from to

CIRCLE APPROPRIATE LETTER A A WELL WAS ABANDONED AND SEALED WHEN THIS WELL WAS COMPLETED E ELECTRIC LOG OBTAINED P TEST WELL CONVERTED TO PRODUCTION WELL

I HEREBY CERTIFY THAT THIS WELL HAS BEEN CONSTRUCTED IN ACCORDANCE WITH COMAR 26.04.04 "WELL CONSTRUCTION" AND IN CONFORMANCE WITH ALL CONDITIONS STATED IN THE ABOVE CAPTIONED PERMIT, AND THAT THE INFORMATION PRESENTED HEREIN IS ACCURATE AND COMPLETE TO THE BEST OF MY KNOWLEDGE.

DRILLERS IDENT. NO. 40

DRILLERS SIGNATURE (MUST MATCH SIGNATURE ON APPLICATION)

SITE SUPERVISOR (sign. of driller or journeyman responsible for sitework if different from permittee)

GRAVEL PACK IF WELL DRILLED WAS FLOWING WELL INSERT F IN BOX 68


OEP USE ONLY (NOT TO BE FILLED IN BY DRILLER) T (E.R.O.S.) W Q 74 75 76 TELESCOPE CASING LOG INDICATOR OTHER DATA

PUMPING TEST HOURS PUMPED (nearest hour) 33 PUMPING RATE (gal. per min. to nearest gal.) 10 METHOD USED TO MEASURE PUMPING RATE Bucket WATER LEVEL (distance from land surface) BEFORE PUMPING 17 WHEN PUMPING 25 TYPE OF PUMP USED (for test) [A] air [P] piston [T] turbine [C] centrifugal [R] rotary [O] other [J] jet [S] submersible

PUMP INSTALLED DRILLER WILL INSTALL PUMP YES NO (CIRCLE) (YES or NO) IF DRILLER INSTALLS PUMP, THIS SECTION MUST BE COMPLETED FOR ALL WELLS EXCEPT HOME USE TYPE OF PUMP INSTALLED PLACE (A,C,J,P,R,S,T,O) IN BOX - SEE ABOVE: CAPACITY: GALLONS PER MINUTE (to nearest gallon) PUMP HORSE POWER PUMP COLUMN LENGTH (nearest ft.) CASING HEIGHT (circle appropriate box and enter casing height) [+ above] [- below] LAND SURFACE (nearest foot)

LOCATION OF WELL ON LOT SHOW PERMANENT STRUCTURE SUCH AS BUILDING, SEPTIC TANKS, AND/OR LANDMARKS AND INDICATE NOT LESS THAN TWO DISTANCES (MEASUREMENTS TO WELL)

The Lot shown hereon does not lie within the limits of a recorded Floodplain Easement

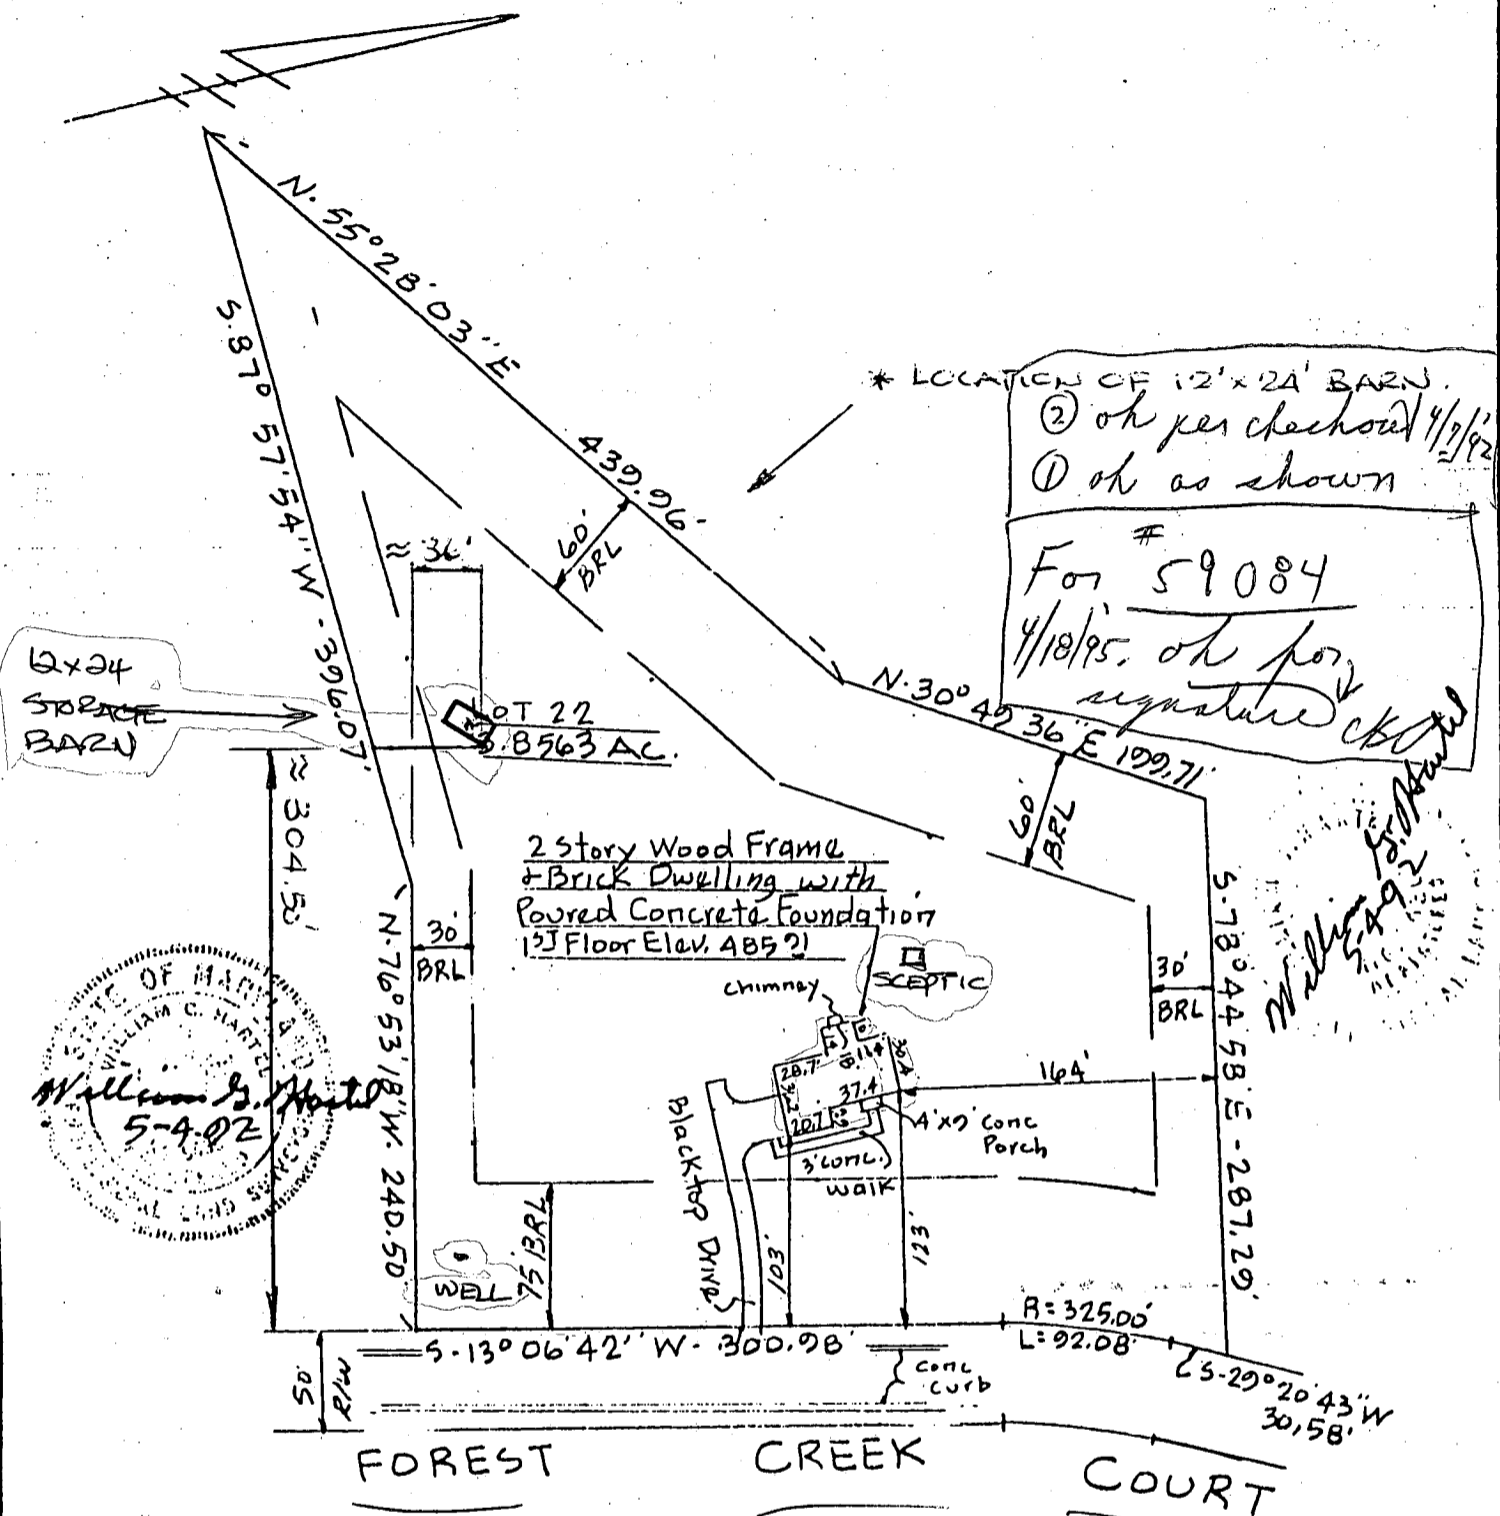

Plat Reference - Amberwoods - Plat of Correction Section One Lots 1 through 42, recorded in Platbook 9702

TITLE LOCATION SURVEY					THIS IS TO CERTIFY THAT WE HAVE CONDUCTED A LOCATION SURVEY OF THE IMPROVEMENTS AND THAT THEY ARE LOCATED AS SHOWN HEREON. <i>William S. Hasted</i> SIGNATURE
PROJECT LOT 22 - AMBERWOODS SECTION ONE					
LOCATION 3RD ELECTION DISTRICT, HOWARD CO., MD.					
FIELD BOOK 130	PAGE NO. 38	DRAWN BY: BH	CHECKED BY: WGH	DATE: 5-4-92	REG. NO. 9436 DATE 5-4-92
SCALE 1" = 100'			JOB NO.: 01003		Boender Associates <small>ENGINEERS - PLANNERS - SURVEYORS</small> 3230 BETHANY LANE ELLICOTT CITY, MD. 21043 (301) 465-7777 FAX: (301) 465-7966
THE INFORMATION ON THIS PLAT SHOWS ONLY THAT THE IMPROVEMENTS INDICATED HEREON ARE CONTAINED WITHIN THE CONFINES OF THE LOT UPON WHICH THEY ARE ERECTED. THIS PLAT IS NOT TO BE CONSTRUED AS, OR USED FOR THE ESTABLISHMENT OF PROPERTY LINES.					