

APPLICATION

PRELIMINARY

SEWAGE DISPOSAL TESTING

A 33665

STATE OF MARYLAND - DEPARTMENT OF HEALTH AND MENTAL HYGIENE

P _____

HOWARD COUNTY HEALTH DEPARTMENT
ENVIRONMENTAL HEALTH SERVICES

DISTRICT 5th

P. O. BOX 476 ELLICOTT CITY, MARYLAND 21043
TELEPHONE: 992-2330

DATE 3/14/84

TO: THE COUNTY HEALTH OFFICER
ELLICOTT CITY, MARYLAND

I, HEREBY, APPLY FOR THE NECESSARY TEST IN ORDER TO CONSTRUCT (OR RECONSTRUCT) A SEWAGE DISPOSAL SYSTEM.
Glenelg Manor Associates

PROPERTY OWNER _____

ADDRESS 12789 Folly Quarter Road, Ellicott City, Md 21043 531-5252
PHONE _____

PROPERTY LOCATION:

~~Buckskin Farms~~ Buckskin Farms LOT NO. 25

ROAD AND DESCRIPTION Folly Quarter Road - use entrance to Glenelg Dehydrators and lots are
located behind the old sawmill.

SIZE OF LOT (?) TYPE BLDG. 3 or 4 bedrooms
(NUMBER OF BEDROOMS)

THE SYSTEM INSTALLED UNDER THIS APPLICATION IS ACCEPTABLE ONLY UNTIL PUBLIC FACILITIES BECOME AVAILABLE. I FULLY UNDERSTAND THE FEE CONNECTED WITH THE FILING OF THIS PERC TEST APPLICATION IS NON-REFUNDABLE UNDER ANY CIRCUMSTANCES. I ALSO AGREE TO COMPLY

WITH ALL M.O.S.H.A. REQUIREMENTS IN TESTING THIS LOT. /s/ Olen Ketterman for Lois M. Maisel
(SIGNATURE OF APPLICANT)


APPROVED BY _____ FOR _____ DATE _____

REJECTED BY _____ FOR _____ DATE _____

HOLD PENDING FURTHER TESTS _____ DATE _____

REASONS FOR REJECTION OR HOLDING _____

THIS IS NOT A PERMIT

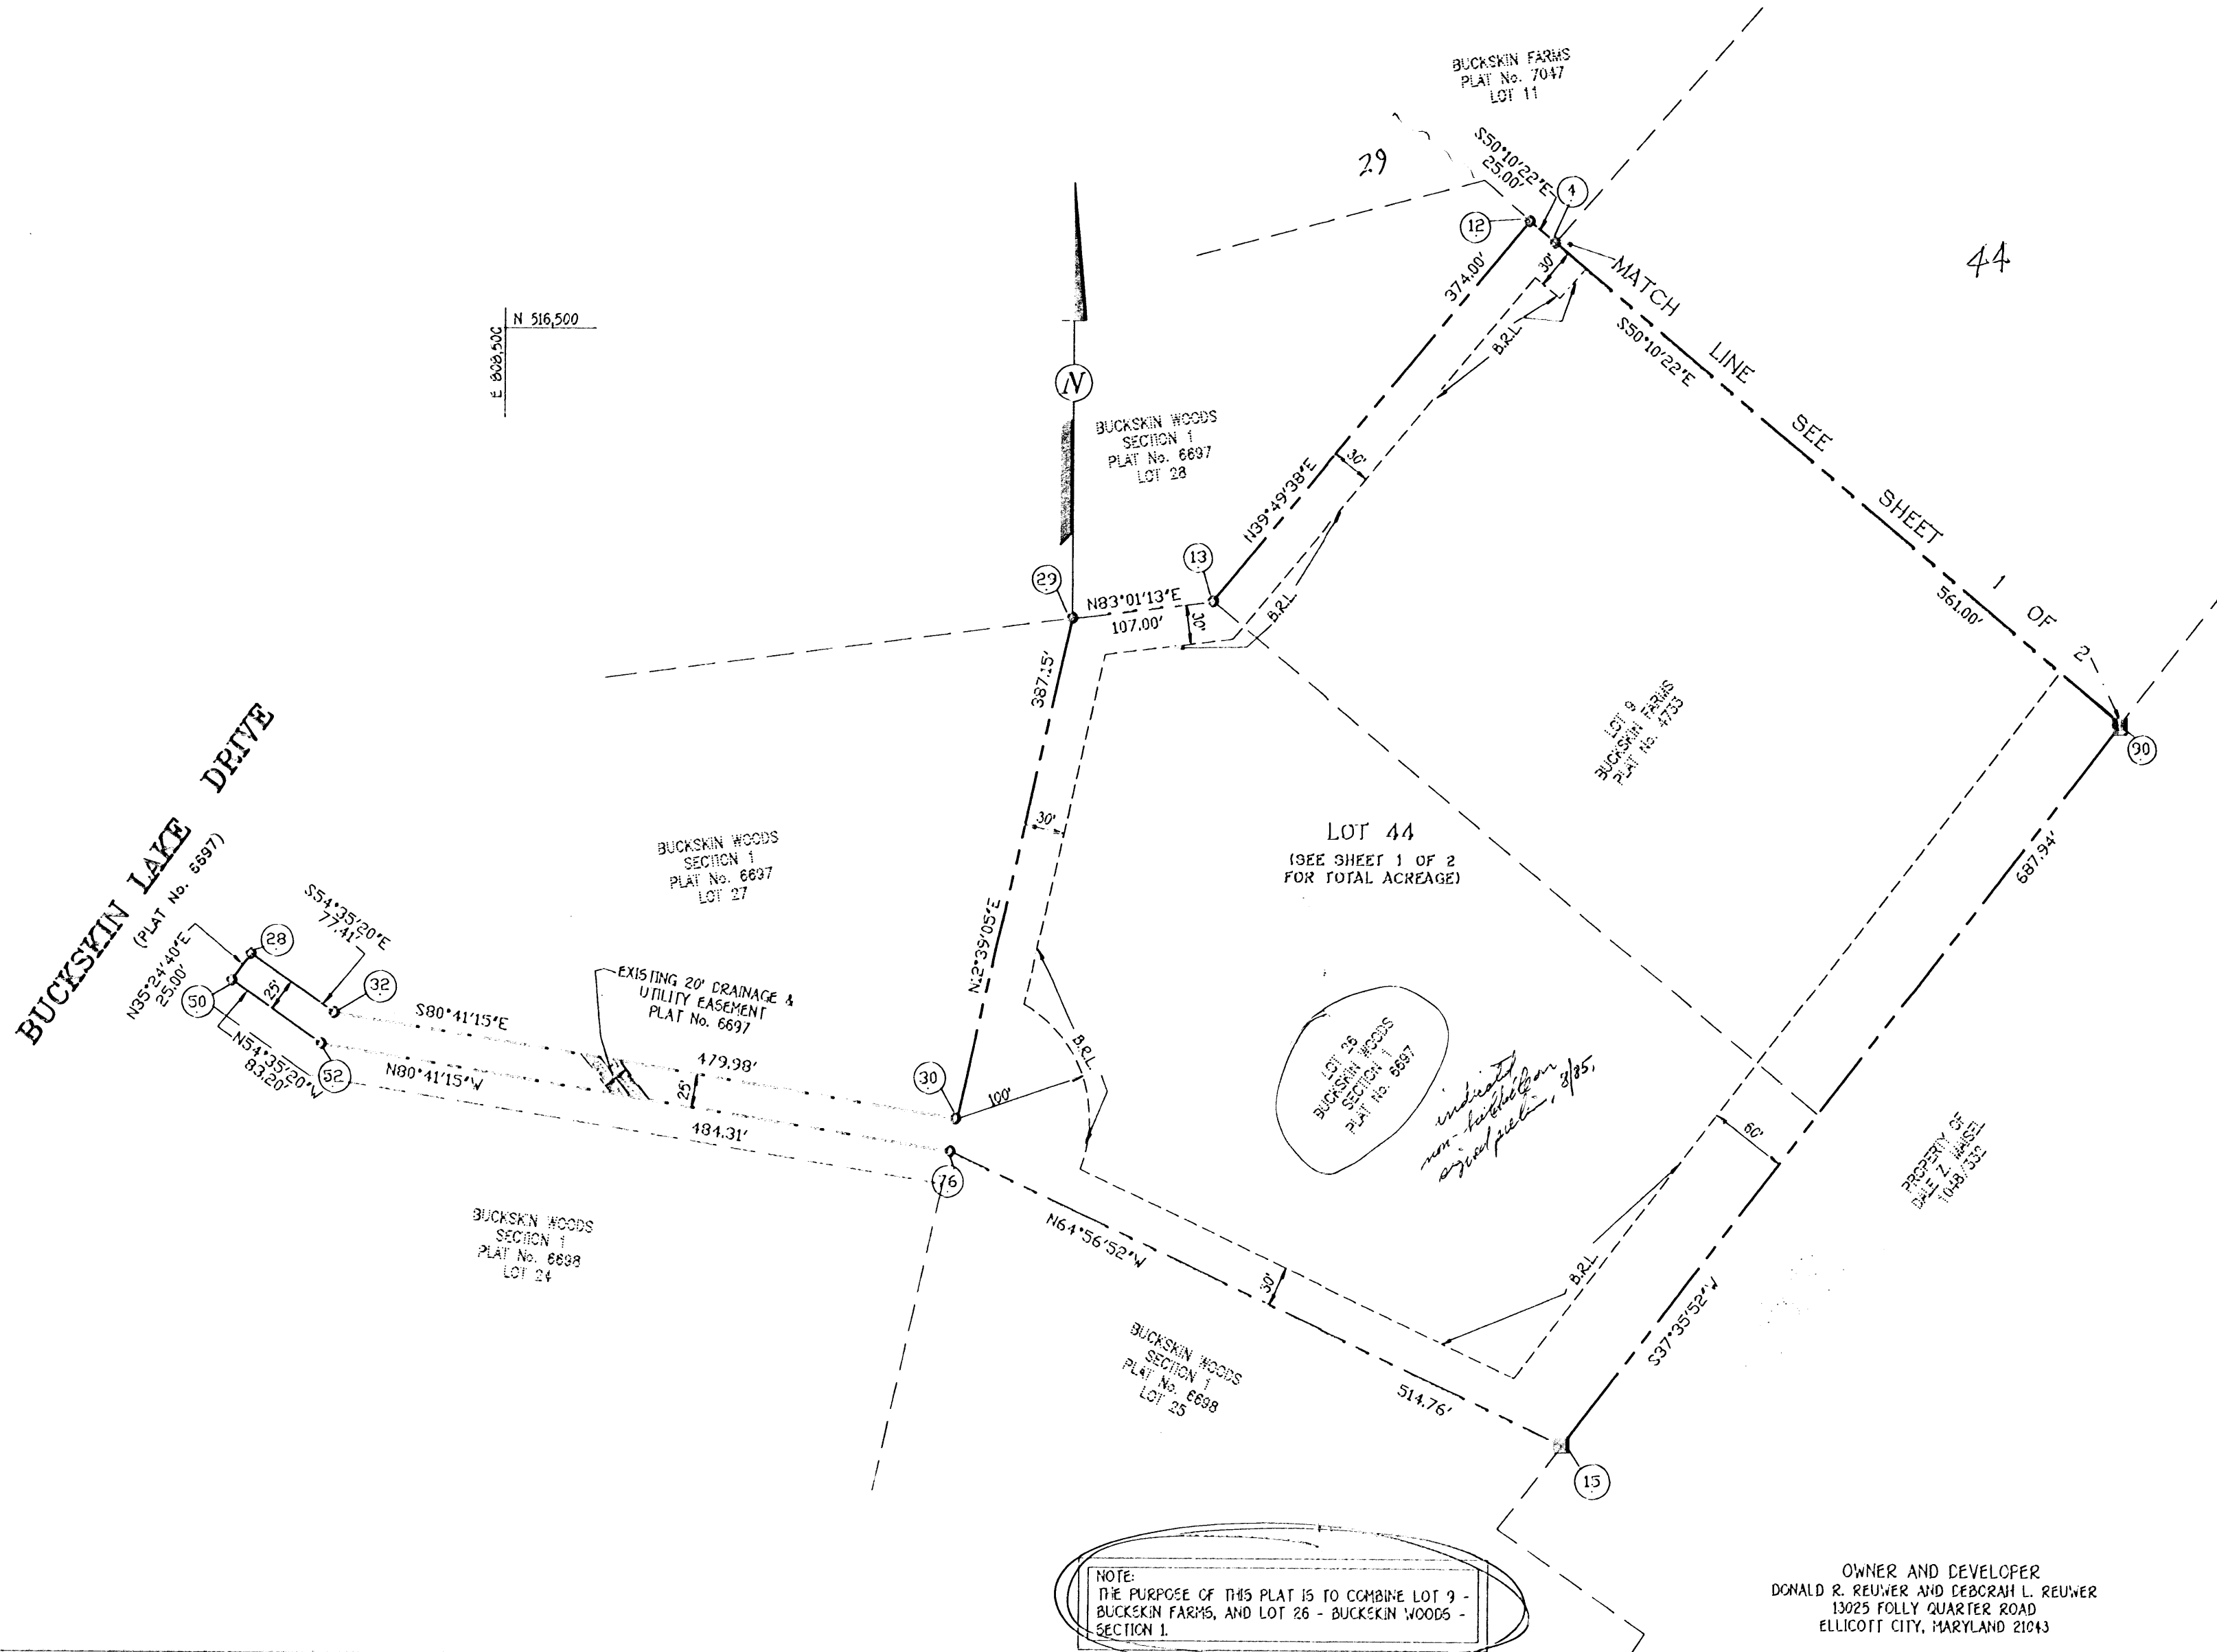

N 516,500
E 910,000

N 516,000
E 910,000

4273 & 4275
Buckskin Lake Dr.
Now lots 61 & 62
CA 8/25/08

FISHER, COLLINS & CARTER, INC.
CIVIL ENGINEERING CONSULTANTS &
LAND SURVEYORS
SUITE 100, 3171 BALTIMORE NATIONAL PIKE
ELLCOTT CITY, MARYLAND 21043
(301) 461 - 2855

APPROVED: FOR PRIVATE WATER AND PRIVATE SEWERAGE SYSTEMS, HOWARD COUNTY HEALTH DEPARTMENT.
HOWARD COUNTY HEALTH OFFICER _____ DATE _____

APPROVED: HOWARD COUNTY DEPARTMENT OF PLANNING AND ZONING.
DIRECTOR _____ DATE _____

APPROVED: FOR STORM DRAINAGE SYSTEMS AND PUBLIC ROADS, HOWARD COUNTY DEPARTMENT OF PUBLIC WORKS.
DIRECTOR _____ DATE _____

OWNER'S CERTIFICATE

WE DONALD R. REUWER, JR. AND DEBORAH L. REUWER, HIS WIFE, OWNERS OF THE PROPERTY SHOWN AND DESCRIBED HEREON, HEREBY ADOPT THIS PLAN OF SUBDIVISION, AND IN CONSIDERATION OF THE APPROVAL OF THIS FINAL PLAT BY THE DEPARTMENT OF PLANNING AND ZONING ESTABLISH THE MINIMUM BUILDING RESTRICTION LINES. ALL EASEMENTS OR RIGHTS-OF-WAY AFFECTING THE PROPERTY ARE INCLUDED IN THIS PLAN OF SUBDIVISION. WITNESS OUR HANDS THIS 3RD DAY OF DECEMBER, 1910.

Donald R. Reuwer, Jr.
DONALD R. REUWER, JR.

Deborah L. Reuwer
DEBORAH L. REUWER

Terrell A. Fisher
WITNESS

Terrell A. Fisher
WITNESS

SURVEYOR'S CERTIFICATE

I, HEREBY CERTIFY THAT THE FINAL PLAT SHOWN HEREON IS CORRECT; THAT IT IS A SUBDIVISION OF THE FOLLOWING: (1) ALL OF THAT LAND CONVEYED BY DALE Z. MAISEL TO DONALD R. REUWER, JR. BY DEED DATED NOVEMBER 7, 1988 AND RECORDED AMONG THE LAND RECORDS OF HOWARD COUNTY IN LIBER No. 1924 AT FOLIO 475, AND (2) ALL OF THE LAND CONVEYED BY DALE Z. MAISEL TO DONALD R. REUWER, JR. AND DEBORAH REUWER, HIS WIFE BY DEED DATED APRIL 5, 1988 AND RECORDED AMONG THE LAND RECORDS OF HOWARD COUNTY IN LIBER No. 1924, FOLIO 379, AND THAT ALL MONUMENTS ARE IN PLACE OR WILL BE IN PLACE PRIOR TO THE ACCEPTANCE OF THE STREETS IN THE SUBDIVISION BY HOWARD COUNTY, AS SHOWN, IN ACCORDANCE WITH THE ANNOTATED CODE OF MARYLAND, AS AMENDED.

Terrell A. Fisher
TERRELL A. FISHER, L.S. #10692

12/5/10
DATE

RECORDED AS PLAT No. _____ ON _____, 19____
IN THE LAND RECORDS OF HOWARD COUNTY, MARYLAND.

BUCKSKIN WOODS
LOT 44
(A RESUBDIVISION OF LOT 9 - BUCKSKIN FARMS AND LOT 25 - BUCKSKIN WOODS, SECTION 1)

TAX MAP #22 PARCELS #528, 535
FIFTH ELECTION DISTRICT
HOWARD COUNTY, MARYLAND

0' 100' 150' 200'
Scale in Feet
DATE: DECEMBER 3, 1990
F-89-109
SHEET 2 OF 2