

# PERMIT

SEWAGE DISPOSAL SYSTEM

MARYLAND STATE DEPARTMENT OF HEALTH

HOWARD COUNTY  
BUREAU OF ENVIRONMENTAL HEALTH  
461-9933

## INDEXED

A 10681

2nd

DATE: 4/28/86

DATE SYSTEM APPROVED 3/11/87

INSPECTOR RH

{ I.C.O.P. received only  
Times signed }

Jack Fyock

IS PERMITTED TO INSTALL  ALTER

ADDRESS \_\_\_\_\_ PHONE 988-9270

SUBDIVISION Kuhn Property ROAD 336 Daniels Road LOT 2

PROPERTY OWNER Romer 2347

ADDRESS \_\_\_\_\_

IF GARBAGE GRINDER IS USED INCREASE SEPTIC TANK CAPACITY BY 50% AND ABSORPTION AREA BY 25%.

GARBAGE GRINDER? YES \_\_\_\_\_ NO

SEPTIC TANK CAPACITY 1000 GALLONS NUMBER OF BEDROOMS 3

TRENCHES - 160 sq. ft. per bedroom. Trench to be 2 feet wide. Inlet 3 feet below original grade. Bottom maximum depth 8 feet below original grade. Effective area begins at 3 feet below original grade. 5 feet of stone below distribution pipe.

LOCATION - Place the distribution box or start the trench 140 feet from the front (109.37') lot line and 60 feet from the right (291.01') lot line as seen when facing the lot from Daniels Road. Run trench(es) on contour toward the left lot line, maintain 100 feet from well with both septic tank and distribution box or trenches.

NOTE - No trench to exceed 100 feet in length. Provide 6" - 8" diameter cleanout and cap to grade or above on septic tank.

PLANS APPROVED BY S. Abel DATE 4/28/86

COVER NO WORK UNTIL INSPECTED AND APPROVED

NEITHER THE HOWARD COUNTY COUNCIL NOR THE HEALTH DEPARTMENT IS RESPONSIBLE FOR THE SUCCESSFUL OPERATION OF ANY SYSTEM

NOTE CLEANOUT REQUIRED EVERY 70 FEET OF SEWER LINE AND/OR AT 90° SWEEPS IN LINES FROM HOUSE TO DRAIN FIELDS

NOTE ALL PARTS OF SEPTIC SYSTEMS (E. TANK DISTRIBUTION BOX TRENCHES) TO BE 100 FEET FROM WELL (UNLESS OTHERWISE SPECIFICALLY AUTHORIZED)

NOTE IF DEEP TRENCHES ARE USED CALL FOR INSPECTION BEFORE AND AFTER PLACING GRAVEL IN TRENCHES

NOTE NO DRY WELL SHALL EXCEED 19 FOOT IN DIAMETER NO ABSORPTION TRENCH TO EXCEED 100 FEET IN LENGTH

NOTE ALL PIPE FROM HOUSE TO SEPTIC TANK MUST BE CAST IRON OR SCHEDULE 40 PVC OR ABS

PERMIT VOID AFTER TWO YEARS

NOTE INSTALL STAND PIPE ON SEPTIC TANK AND DRY WELL. STAND PIPES MUST BE 6 INCHES IN DIAMETER. CAST IRON, CONCRETE OR TERRA COTTA OR PVC OR ABS ACCEPTED. IF TOP OF SEPTIC TANK IS DEEPER THAN 3 FEET, BIRTHHOLE TO GRADE REQUIRED

NOTE DISTRIBUTION BOXES MUST HAVE BIFFLES

100% PERMITS SIGNED AND RETURNED 3-25-86

S. Abel  
4/28/86  
proch


**\*INSTALLER IS RESPONSIBLE FOR OBTAINING FINAL APPROVAL ON THIS PERMIT**

CALL 461-9933 FOR INSPECTION OF SEPTIC SYSTEMS

EN-5-1106

10681

39283

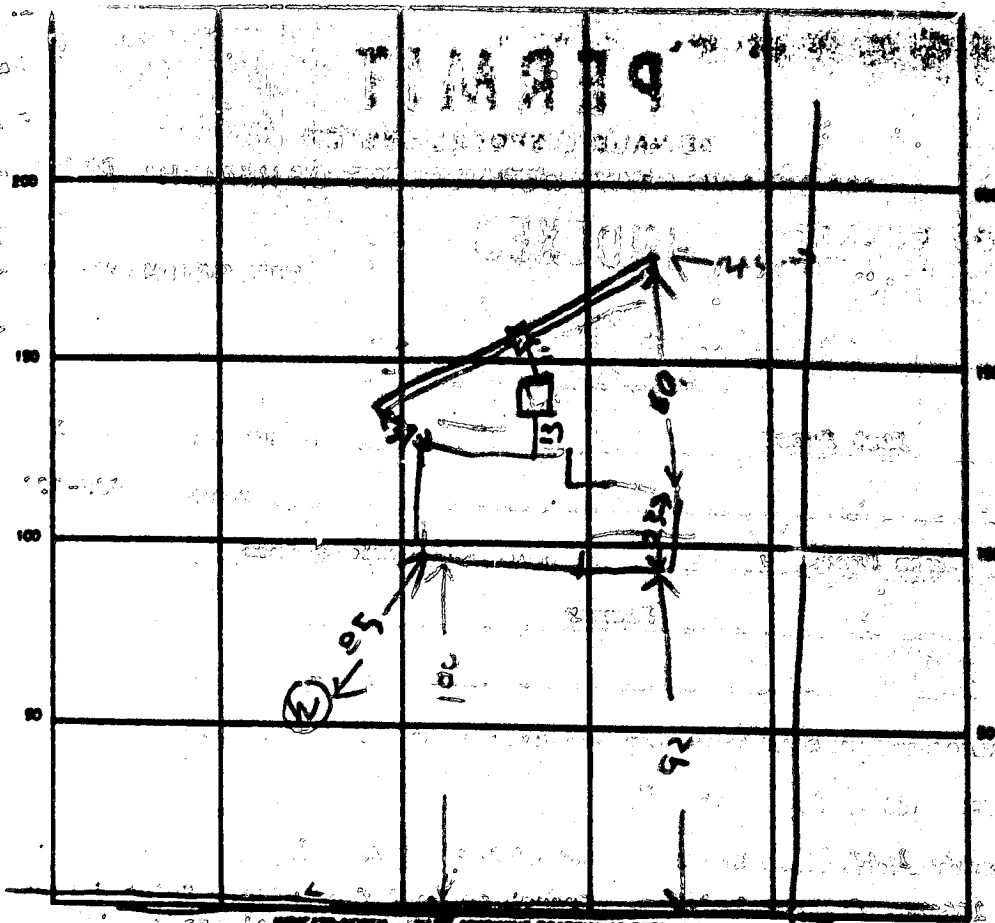

INDICATE THE SPACING ROADWAY AS ONE LINE

DANIELS RD

SEPTIC TANK LEVEL OK 1000 CLEANOUTS OK

DISTRIBUTION BOX LEVEL 5

DRAIN FIELD/TILE FIELD. DEPTH 8 1/2 - 9 FT. TRENCH WIDTH 12 FT. INLET DEPTH \_\_\_\_\_ FT.

EFFECTIVE GRAVEL DEPTH \_\_\_\_\_ FT. TOTAL LENGTH 92 FT.

NUMBER OF TRENCHES 1 ONE SIDEWALL/BOTTOM AREA \_\_\_\_\_ SQ. FT.

DRYWELL INSIDE DIAMETER \_\_\_\_\_ FT. EFFECTIVE DEPTH BELOW INLET \_\_\_\_\_ FT.

ABSORBENT AREA \_\_\_\_\_ SQ. FT.

REMARKS 3/10/87 - TRENCH DUG & SOME STONE ADDED FINISH  
ADDING STONE OK TO COVER TANK FINISH ADD BEST  
OF STONE & PIPE & PAPER & COVER

DATE SYSTEM APPROVED 3/10/87 INSPECTOR Terrence Hodge

# APPLICATION

## SEWAGE DISPOSAL TESTING

STATE OF MARYLAND - DEPARTMENT OF HEALTH AND MENTAL HYGIENE

HOWARD COUNTY HEALTH DEPARTMENT  
ENVIRONMENTAL HEALTH SERVICES

P. O. BOX 476, ELLICOTT CITY, MARYLAND 21043  
TELEPHONE: 465-2906 EXT. 211

DISTRICT 2

DATE 3/22/74

*Handwritten notes:*  
Dig well - 360 ft deep all over below  
the inlet with inlet no deeper than 34 FT 10 1/2  
and bottom of Dig well no deeper than 34 FT  
from the driveway 10 FT from the front lot line  
and 30 FT from the right side of the lot  
as seen when facing the lot

TO: THE COUNTY HEALTH OFFICER  
ELLICOTT CITY, MARYLAND

I, HEREBY, APPLY FOR THE NECESSARY TEST IN ORDER TO CONSTRUCT (OR RECONSTRUCT) A SEWAGE  
DISPOSAL SYSTEM.

*Handwritten notes:*  
Trench - 90' long 7' stone max. 10' start at D.W. site & run on  
a constant elev parallel with right side sewer line.

PROPERTY OWNER John P. Roemer

ADDRESS 2339 Daniels Road, Ellicott City, Md. PHONE 465-5312

PROPERTY LOCATION:

SUBDIVISION 234 Daniels Rd. LOT NO. 2

ROAD AND DESCRIPTION Daniels Road - approx. 525 ft. from Old Frederick Road

SIZE OF LOT 1.150 acres TYPE BLDG. 1

IF NOT SINGLE RESIDENCE DESCRIBE \_\_\_\_\_  
(NUMBER OF BEDROOMS (SINGLE FAMIL. DWELLG.))

THE SYSTEM INSTALLED UNDER THIS APPLICATION IS ACCEPTABLE ONLY UNTIL PUBLIC  
FACILITIES BECOME AVAILABLE.

SIGNATURE OF APPLICANT John C. Roemer, Jr. EDDG. PERMIT SIGNED AND RETURNED 3/21/74

APPROVED BY Raymond Holge FOR Dayrell DATE 3/22/74

REJECTED BY \_\_\_\_\_ FOR \_\_\_\_\_ DATE \_\_\_\_\_  
(KIND OF SYSTEM)

HOLD PENDING FURTHER TESTS \_\_\_\_\_ DATE \_\_\_\_\_  
(KIND OF SYSTEM)

REASONS FOR REJECTION OR HOLDING 3/15/74 - Per OK Holdin  
Final BH 3/22/74 Final BH OK

# THIS IS NOT A PERMIT

DATE				

INDICATE NORTH - MAKE ADJOINING ROADWAY AS BASE LINE.

DATE	TEST NO.	DEPTH	PRE-WET		TEST - 1" DROP		TIME
			START	STOP	START	STOP	
3/15/74	1	4	942	947	947	952	5
	2	12	941	947	947	952	3
	3	12	907	912	912	917	5
	4	3	959	1000	1000	1001	1
	5	12	1001	1001	1003	1006	3
3/15/74	6	11	1001	1001	1003	1006	3

X=30"

REMARKS

TYPE OF SOIL

TESTED BY

CLAY A TOH 21 21

ALSO PRESENT

# APPLICATION

A 2021

## SEWAGE DISPOSAL TESTING

P \_\_\_\_\_

STATE OF MARYLAND - DEPARTMENT OF HEALTH AND MENTAL HYGIENE

HOWARD COUNTY HEALTH DEPARTMENT  
ENVIRONMENTAL HEALTH SERVICES

DISTRICT 2

P. O. BOX 476, ELLICOTT CITY, MARYLAND 21043  
TELEPHONE: 410-5860, EXT. 536

DATE 1/13/76

TO: THE COUNTY HEALTH OFFICER  
ELLICOTT CITY, MARYLAND

I, HEREBY, APPLY FOR THE NECESSARY TEST IN ORDER TO CONSTRUCT (OR RECONSTRUCT) A SEWAGE DISPOSAL SYSTEM.

PROPERTY OWNER John C. Doo, Jr.

ADDRESS 2110 Daniels Road, Ellicott City, Md. PHONE 410-5212

PROPERTY LOCATION:

SUBDIVISION \_\_\_\_\_ LOT NO. 2

ROAD AND DESCRIPTION Daniels Road - approx. 535 ft. from Old Frederick Road

SIZE OF LOT 1.162 acres TYPE BLDG. 2

IF NOT SINGLE RESIDENCE DESCRIBE (SEE PAGE 2 OF 2)

THE SYSTEM INSTALLED UNDER THIS APPLICATION IS ACCEPTABLE ONLY UNTIL PUBLIC FACILITIES BECOME AVAILABLE.

SIGNATURE OF APPLICANT /s/ John C. Doo, Jr.

APPROVED BY \_\_\_\_\_ FOR \_\_\_\_\_ DATE \_\_\_\_\_  
(KIND OF SYSTEM)

REJECTED BY \_\_\_\_\_ FOR \_\_\_\_\_ DATE \_\_\_\_\_  
(KIND OF SYSTEM)

HOLD PENDING FURTHER TESTS \_\_\_\_\_ DATE \_\_\_\_\_

REASONS FOR REJECTION OR HOLDING \_\_\_\_\_

# THIS IS NOT A PERMIT







