

C1 6016 SEQUENCE NO. (OEP USE ONLY)

STATE OF MARYLAND WELL COMPLETION REPORT

THIS REPORT MUST BE SUBMITTED WITHIN 45 DAYS AFTER WELL IS COMPLETED.

(THIS NUMBER IS TO BE PUNCHED IN COLS. 3-6 ON ALL CARDS)

COUNTY NUMBER A 37687

DATE Received, DATE WELL COMPLETED, Depth of Well, PERMIT NO. FROM "PERMIT TO DRILL WELL"

OWNER, STREET OR RFD, SUBDIVISION, SECTION, LOT

WELL LOG table with columns: DESCRIPTION, FEET (FROM, TO), Check if water bearing. Includes entries for Top Soil, Sandstone, Micka, etc.

GROUTING RECORD: WELL HAS BEEN GROUTED, TYPE OF GROUTING MATERIAL, CEMENT, BENTONITE CLAY, NO. OF BAGS, NO. OF POUNDS, GALLONS OF WATER, DEPTH OF GROUT SEAL.

CASING RECORD: casing types insert appropriate code below, MAIN CASING TYPE, Nominal diameter, Total depth.

OTHER CASING (if used) diameter, depth (feet) from to.

SCREEN RECORD: screen type or open hole, insert appropriate code below, STEEL, BRASS, BRONZE, PLASTIC, OPEN HOLE, OTHER.


DEPTH (nearest ft.), SLOT SIZE, DIAMETER OF SCREEN (NEAREST INCH).

GRAVEL PACK, IF WELL DRILLED WAS FLOWING WELL INSERT F IN BOX 68.

OEP USE ONLY (NOT TO BE FILLED IN BY DRILLER), TELESCOPE CASING, LOG INDICATOR, OTHER DATA.

PUMPING TEST: HOURS PUMPED, PUMPING RATE, METHOD USED TO MEASURE PUMPING RATE, WATER LEVEL, TYPE OF PUMP USED.


PUMP INSTALLED: DRILLER WILL INSTALL PUMP, TYPE OF PUMP INSTALLED PLACE, CAPACITY, GALLONS PER MINUTE, PUMP HORSE POWER, PUMP COLUMN LENGTH, CASING HEIGHT.

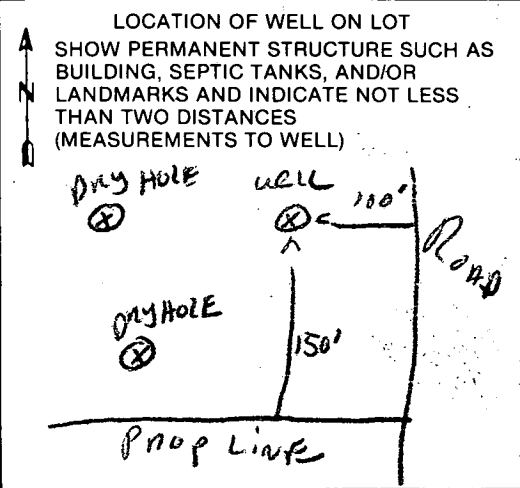

CIRCLE APPROPRIATE LETTER. A WELL WAS ABANDONED AND SEALED WHEN THIS WELL WAS COMPLETED. E ELECTRIC LOG OBTAINED. P TEST WELL CONVERTED TO PRODUCTION WELL.


I HEREBY CERTIFY THAT THIS WELL HAS BEEN CONSTRUCTED IN ACCORDANCE WITH COMAR 10.17.13 "WELL CONSTRUCTION" AND IN CONFORMANCE WITH ALL CONDITIONS STATED IN THE ABOVE CAPTIONED PERMIT, AND THAT THE INFORMATION PRESENTED HEREIN IS ACCURATE AND COMPLETE TO THE BEST OF MY KNOWLEDGE.

DRILLERS IDENT. NO., DRILLERS SIGNATURE, SITE SUPERVISOR (sign. of driller or journeyman responsible for sitework if different from permittee).

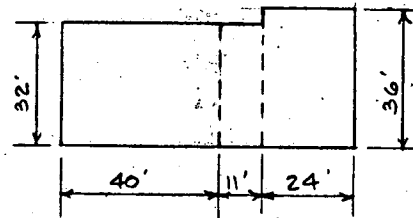

HOUSE DIMENSIONS

8/7/87
 conforms all
 approx. to
 plat

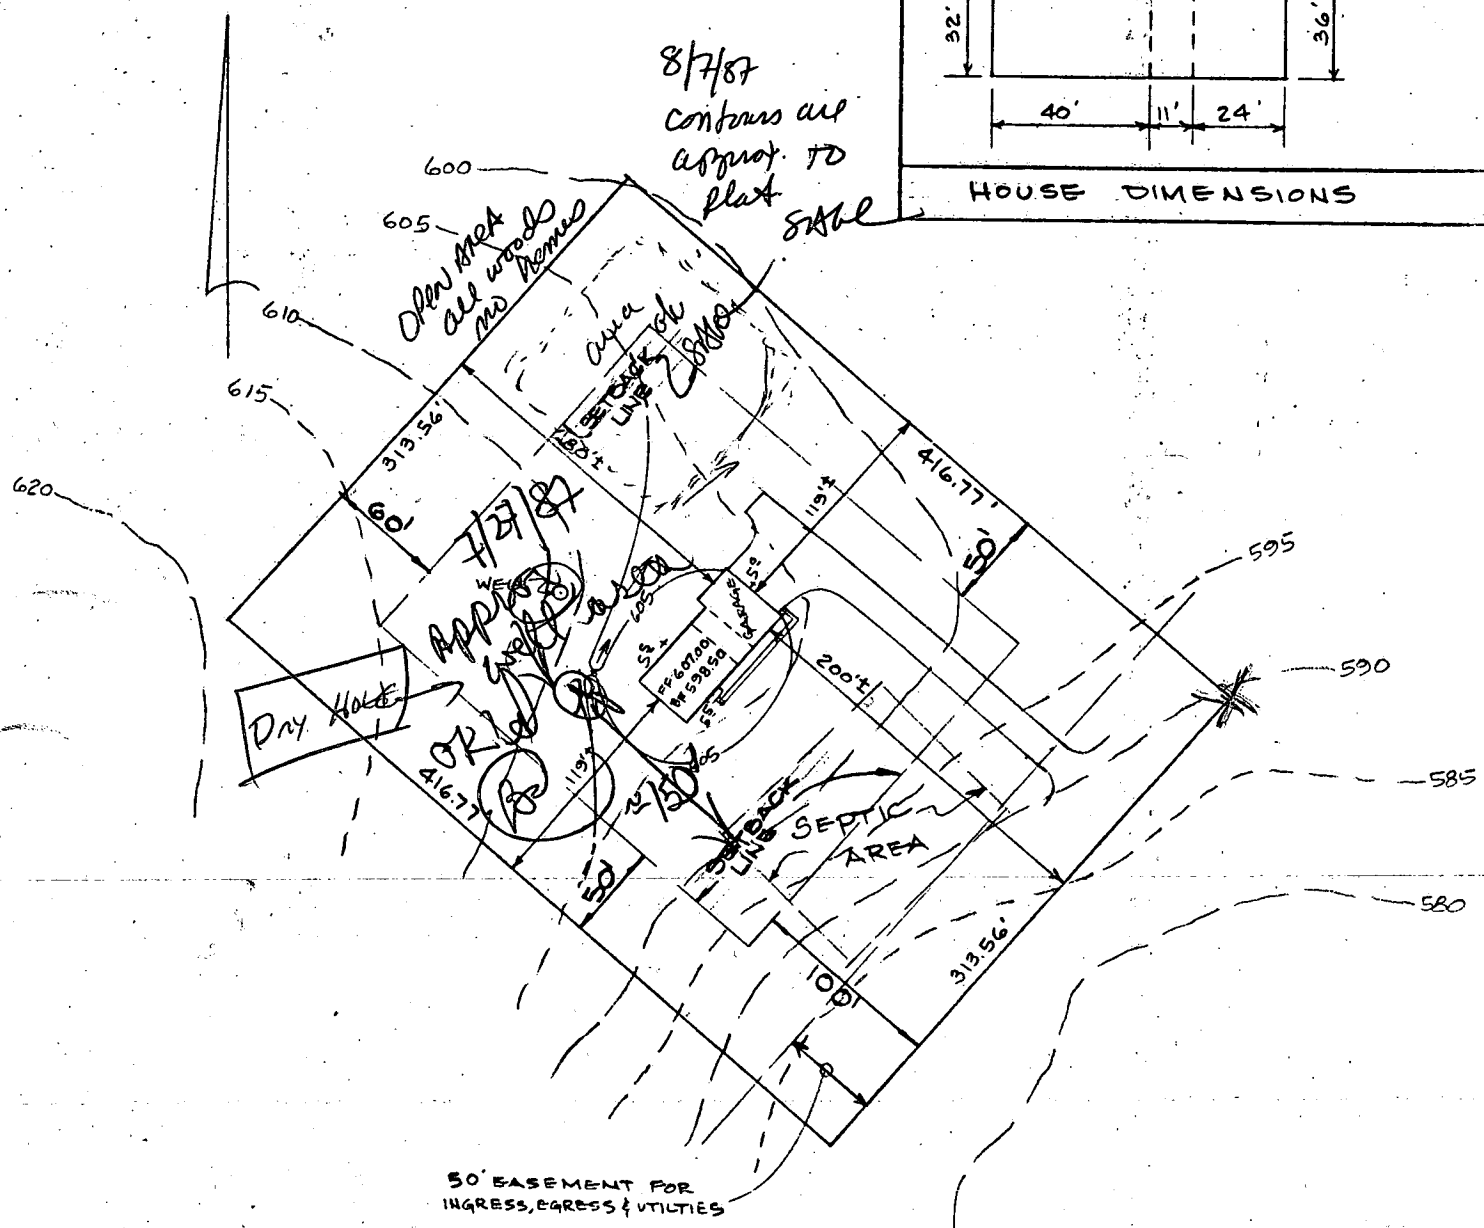

50' BASEMENT FOR
 INGRESS, EGRESS & UTILITIES

PLAT SHOWING GRADING FOR
 LOT 2

"BUCKSKIN LAKES" LIBER 1575 FOLIO 278
 5th ELECT. DIST. HOWARD COUNTY, MD.
 OERTEL-ENGLES PARTNERSHIP
 3146 ROGERS AVE
 ELLICOTT CITY, HOWARD CO. MD. 21044

SETBACKS:

- Front from P.L. 200'±
- Right Side 119'±
- Left Side 119'±
- Rear 180'±

HOUSE No.

LOT No.	HOUSE TYPE	STD. REV.	WALKOUT AREAWAY	HUNG SEWER Yes or No
2	2 STORY	STD.	AREAWAY	SEPTIC

DEVELOPMENT ENGINEERING CONSULTANTS, INC.
 SITE ENGINEERS & SURVEYORS
 6603 York Road
 Baltimore, Maryland 21212

Scale: 1" = 100'

Issued: 6-10-87