

5/2/87  
5/6/87  
NANN

ASAP  
5/5/87

18T

# PERMIT

P. 39313  
A. REPAIR

SEWAGE DISPOSAL SYSTEM  
MARYLAND STATE DEPARTMENT OF HEALTH DISTRICT \_\_\_\_\_

HOWARD COUNTY  
BUREAU OF ENVIRONMENTAL HEALTH  
461-9933

INDEXED

DATE 5/7/87  
DATE SYSTEM APPROVED \_\_\_\_\_  
INSPECTOR R/H  
461-2450

Charney Plumbing Company IS PERMITTED TO INSTALL \_\_\_\_\_ ALTER X

ADDRESS 3801 Offutt Road, Randallstown, MD 21133 PHONE 655-0930

SUBDIVISION \_\_\_\_\_ ROAD 10654 Breezewood Drive LOT 18

PROPERTY OWNER Sharp 461-2450

ADDRESS \_\_\_\_\_

IF GARBAGE GRINDER IS USED INCREASE SEPTIC TANK CAPACITY BY 50% AND ABSORPTION AREA BY 22%.

GARBAGE GRINDER? YES \_\_\_\_\_ NO /

125 15  
5 5  
625 790

SEPTIC TANK CAPACITY 1500 GALLONS NUMBER OF BEDROOMS 5

6) 825

REPAIR - CALL FOR INSPECTION WHEN GROUND IS OPENED UP SO SANITARIAN CAN RECOMMEND

5 MAY 27 REPAIR. FILE FILED 3 FT WIDE

3-5 FT DEEP 1 1/2 FT STONE 625 SQ FT BOTTOM AREA  
USE DISTRIBUTION BOX & INCLUDE OLD DRY WELL  
PLACE TILE FIELD IN FRONT YARD R/H  
OIL TO HAVE SOME WIDTH LESS BOTTOM  
AREA IF OVER 1 1/2 FT OF STONE USED

PLANS APPROVED BY C. Williams DATE 5/04/87

COVER NO WORK UNTIL INSPECTED AND APPROVED.

NEITHER THE HOWARD COUNTY COUNCIL NOR THE HEALTH DEPARTMENT IS RESPONSIBLE FOR THE SUCCESSFUL OPERATION OF ANY SYSTEM.

NOTE: CLEANOUT REQUIRED EVERY 70 FEET OF SEWER LINE AND/OR AT 90° SWEEPS IN LINES FROM HOUSE TO DRAIN FIELDS.

NOTE: ALL PARTS OF SEPTIC SYSTEMS (I.E., TANK, DISTRIBUTION BOX, TRENCHES) TO BE 100 FEET FROM WELL. (UNLESS OTHERWISE SPECIFICALLY AUTHORIZED)

NOTE: IF DEEP TRENCHES ARE USED CALL FOR INSPECTION BEFORE AND AFTER PLACING GRAVEL IN TRENCHES).

NOTE: NO DRY WELL SHALL EXCEED 15 FOOT IN DIAMETER. NO ABSORPTION TRENCH TO EXCEED 100 FEET IN LENGTH.

NOTE: ALL PIPE FROM HOUSE TO SEPTIC TANK MUST BE CAST IRON OR SCHEDULE 40 PVC OR ABS.


PERMIT VOID AFTER TWO YEARS.

NOTE: INSTALL STAND PIPE ON SEPTIC TANK AND DRY WELL. STAND PIPES MUST BE 6 INCHES IN DIAMETER. CAST IRON, CONCRETE OR TERRA COTTA OR PVC OR ABS ACCEPTED. IF TOP OF SEPTIC TANK IS DEEPER THAN 3 FEET, MANHOLE TO GRADE REQUIRED.

NOTE: DISTRIBUTION BOXES MUST HAVE BAFFLES.

**\*INSTALLER IS RESPONSIBLE FOR OBTAINING FINAL APROVAL ON THIS PERMIT**

P.A. 39313

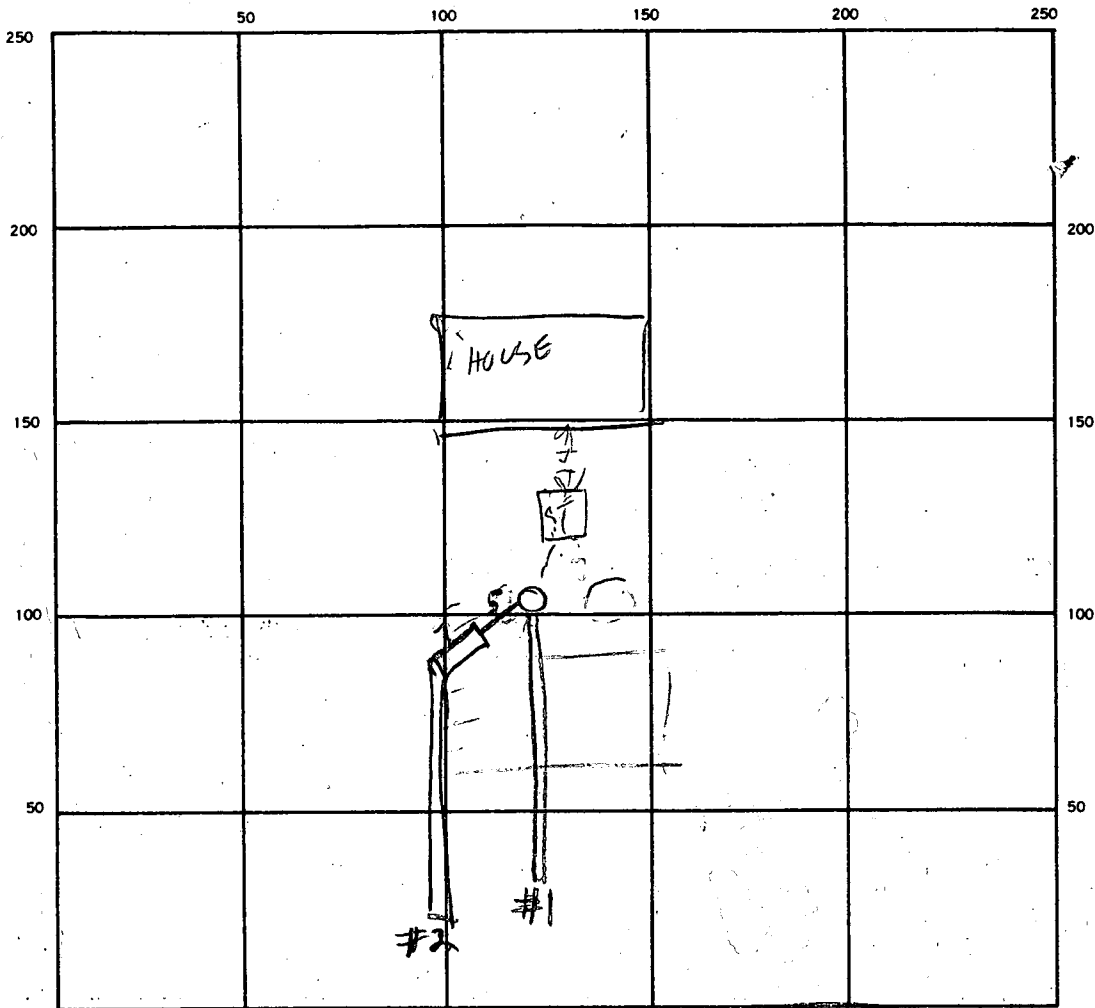

①  
ALL  
BROWN  
SAND  
LOAM  
ROCK

INDICATE NORTH - NAME ADJOINING ROADWAY AS BASE LINE.  
HOLLYWOOD DRIVE

SEPTIC TANK. LEVEL \_\_\_\_\_ CLEANOUTS \_\_\_\_\_

DISTRIBUTION BOX. LEVEL \_\_\_\_\_

DRAIN FIELD/TILE FIELD. DEPTH 3.5 3.5 FT. TRENCH WIDTH 2 FT. INLET DEPTH \_\_\_\_\_ FT.

EFFECTIVE GRAVEL DEPTH 24 24 FT. TOTAL LENGTH 70 73 FT. 151

NUMBER OF TRENCHES 2 ONE SIDEWALL/BOTTOM AREA 453 SQ. FT.

DRYWELL INSIDE DIAMETER \_\_\_\_\_ FT. EFFECTIVE DEPTH BELOW INLET 45 FT.

ABSORBENT AREA \_\_\_\_\_ SQ. FT.

73  
78  
151  
3  
453 68  
144 7  
66  
78  
144  
7  
121

REMARKS 5/5/87 - OBSERVED SOIL & SITUATION & DECIDED  
TILE FIELD SEE OTHER SIDE OF  
5/6/87 - OR FINISH HOOKING UP TRENCH

DATE SYSTEM APPROVED 5/6/87 INSPECTOR Raymond Hodges