

Tax ID - 03-300110

~~10/18/87~~  
~~6/3/87~~  
6/4/87  
AM CATE

~~6/8/87~~  
CATE  
6/9/87 noon

# PERMIT

P 39321  
A REPAIR

SEWAGE DISPOSAL SYSTEM  
MARYLAND STATE DEPARTMENT OF HEALTH DISTRICT \_\_\_\_\_

HOWARD COUNTY  
BUREAU OF ENVIRONMENTAL HEALTH  
461-9933

DATE 5/12/87

DATE SYSTEM APPROVED 6/9/87

INSPECTOR RH

INDEXED

Ashby Building Company, Inc. IS PERMITTED TO INSTALL \_\_\_\_\_ ALTER X

ADDRESS 5755 Oklahoma Road, Sykesville, MD 21784 PHONE 781-6075

SUBDIVISION \_\_\_\_\_ ROAD 3326 Rosemary Lane LOT 8-B

PROPERTY OWNER Gary S. Peklo  
3326 Rosemary Lane

ADDRESS West Friendship, Maryland 21794

IF GARBAGE GRINDER IS USED INCREASE SEPTIC TANK CAPACITY BY 50% AND ABSORPTION AREA BY 22%.

GARBAGE GRINDER? YES \_\_\_\_\_ NO

SEPTIC TANK CAPACITY \_\_\_\_\_ GALLONS NUMBER OF BEDROOMS 4

REPAIR - CALL FOR INSPECTION WHEN GROUND IS OPENED UP SO SANITARIAN CAN RECOMMEND REPAIR.

THE OLD SYSTEM WILL BE DISCONNECTED.

TO ACCOMMODATE HOUSE ADDITION.

NEED NEW SYST: 160  $\phi$  18K X 4 BK = 640  $\phi$  INLET 4 BOTTOM 10'

6 FE OF STONE, REQUIRE 107 LF OF TRENCH. S. Abel

PLANS APPROVED BY C. Williams DATE 5/12/87

COVER NO WORK UNTIL INSPECTED AND APPROVED.

NEITHER THE HOWARD COUNTY COUNCIL NOR THE HEALTH DEPARTMENT IS RESPONSIBLE FOR THE SUCCESSFUL OPERATION OF ANY SYSTEM.

NOTE: CLEANOUT REQUIRED EVERY 70 FEET OF SEWER LINE AND/OR AT 90° SWEEPS IN LINES FROM HOUSE TO DRAIN FIELDS.

NOTE: ALL PARTS OF SEPTIC SYSTEMS (I.E., TANK, DISTRIBUTION BOX, TRENCHES) TO BE 100 FEET FROM WELL. (UNLESS OTHERWISE SPECIFICALLY AUTHORIZED)

NOTE: IF DEEP TRENCH(ES) ARE USED CALL FOR INSPECTION BEFORE AND AFTER PLACING GRAVEL IN TRENCH(ES).

NOTE: NO DRY WELL SHALL EXCEED 15 FOOT IN DIAMETER. NO ABSORPTION TRENCH TO EXCEED 100 FEET IN LENGTH.

NOTE: ALL PIPE FROM HOUSE TO SEPTIC TANK MUST BE CAST IRON OR SCHEDULE 40 PVC OR ABS.

PERMIT VOID AFTER TWO YEARS.

NOTE: INSTALL STAND PIPE ON SEPTIC TANK AND DRY WELL. STAND PIPES MUST BE 6 INCHES IN DIAMETER. CAST IRON, CONCRETE OR TERRA COTTA OR PVC OR ABS ACCEPTED. IF TOP OF SEPTIC TANK IS DEEPER THAN 3 FEET, MANHOLE TO GRADE REQUIRED.


NOTE: DISTRIBUTION BOXES MUST HAVE BAFFLES.

\*INSTALLER IS RESPONSIBLE FOR OBTAINING FINAL APROVAL ON THIS PERMIT

\*CALL 461-9933 FOR INSPECTION OF SEPTIC SYSTEMS.

EH - 2-1186

P-39321

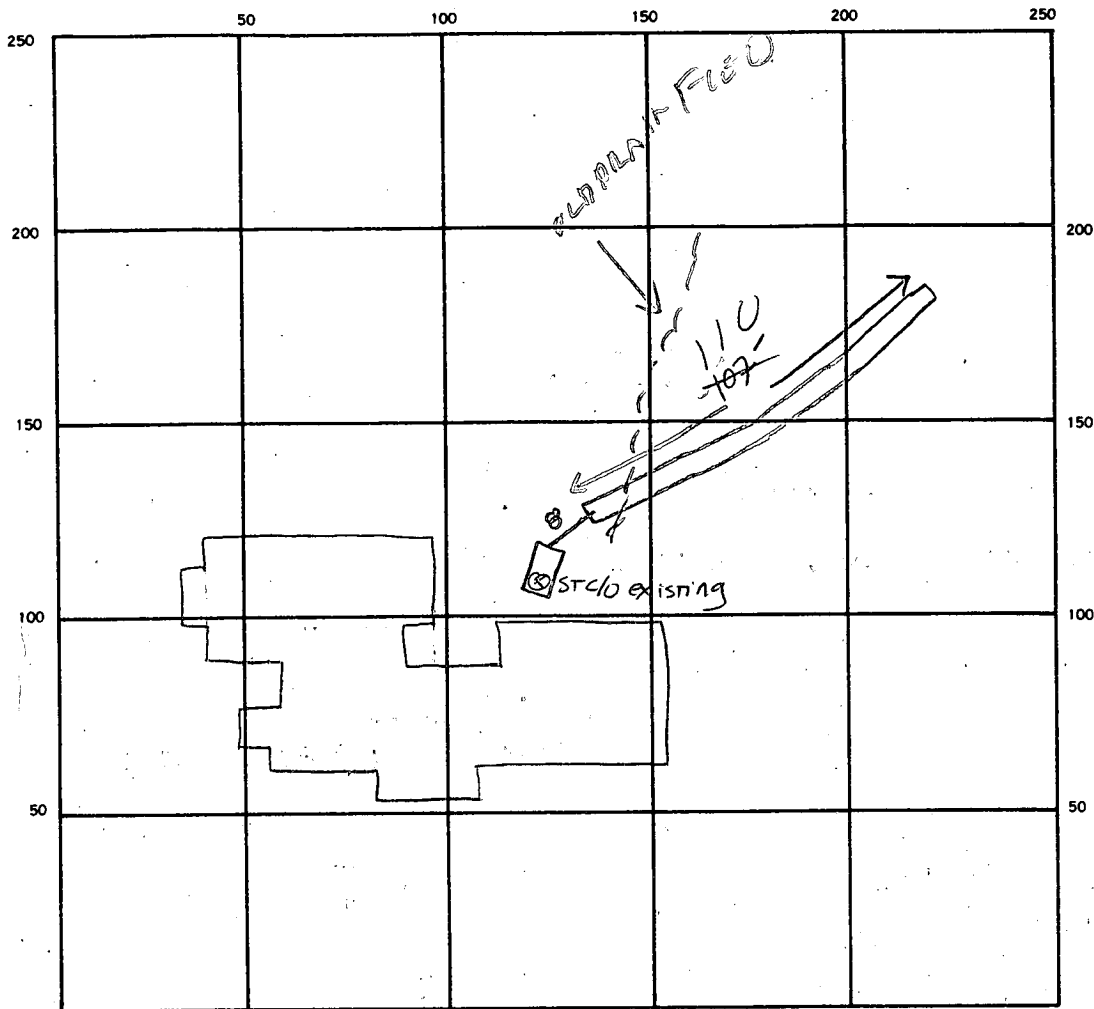

INDICATE NORTH. - NAME ADJOINING ROADWAY AS BASE LINE.

R.O.W

SEPTIC TANK. LEVEL EXISTING 1250<sup>±</sup> CLEANOUTS EXISTING ST

DISTRIBUTION BOX. LEVEL N/A

DRAIN FIELD TILE FIELD. DEPTH 10 FT. TRENCH WIDTH 2 FT. INLET DEPTH 4 FT.

EFFECTIVE GRAVEL DEPTH 6 FT. TOTAL LENGTH 107 110 FT. INSTALL REQUIRED  
 NUMBER OF TRENCHES 1 ONE SIDEWALL/BOTTOM AREA 660 SQ. FT. 640

DRYWELL INSIDE DIAMETER      FT. EFFECTIVE DEPTH BELOW INLET      FT.

ABSORBENT AREA      SQ. FT.

REMARKS 6-3-87 ONLY ~ 40' OF 107' DUG. - CONTINUE DIGGING. SA 6-4-87 APPROX 85-90' OF  
TRENCH DUG OK TO START ADDING STONE AFTER 107' DUG. SAME 6-8-87 OK TO ADD STONE TO  
TRENCH; SA 6/9/87 STONE ADDED & TRENCH WORKED UP  
OLD TRENCH NOT USED IT WAS OVERFLOWING RH

DATE SYSTEM APPROVED 6/9/87

INSPECTOR Raymond Reddy