

APPLICATION

SEWAGE DISPOSAL TESTING

MARYLAND STATE DEPARTMENT OF HEALTH

HOWARD COUNTY

PAID
03279400

ELLICOTT CITY

DISTRICT 3

DATE 7/16/68

INDEXED

TO: THE COUNTY HEALTH OFFICER
ELLICOTT CITY, MARYLAND

I, HEREBY, APPLY FOR THE NECESSARY TESTS IN ORDER TO CONSTRUCT (OR RECONSTRUCT) A SEWAGE DISPOSAL SYSTEM.

PROPERTY OWNER Elmer T. Conway & Wife JAMES BURCH

ADDRESS Box 105 - Rt. 2, Sykesville, Md. PHONE _____

PROPERTY LOCATION:

SUBDIVISION _____ LOT NO. Farthest lot from Gaither Rd.

ROAD AND DESCRIPTION 13452 Forsythe Road - just beyond Gaither Road going toward Rt. 32

OCCUPANT _____ PHONE _____

PERSON TO CONSTRUCT SYSTEM _____

ADDRESS _____ PHONE _____

SIZE OF LOT 1 ACRE TYPE BLDG. 3 or 4
NUMBER OF RESIDENCES

IF NOT SINGLE RESIDENCE DESCRIBE _____
(Single Fmly. Dwllg.)

BLDG. PERMIT, SIGNED AND RETURNED 8/1/68

SIGNATURE OF APPLICANT /s/ Lloyd Booth

APPROVED BY _____ FOR _____ DATE _____
(KIND OF SYSTEM)

REJECTED BY _____ FOR _____ DATE _____
(KIND OF SYSTEM)

HOLD PENDING FURTHER TESTS _____ DATE _____


REASONS FOR REJECTION OR HOLDING _____

also Present Paul D. Geyer

THIS IS NOT A PERMIT

40223

APPLICATION

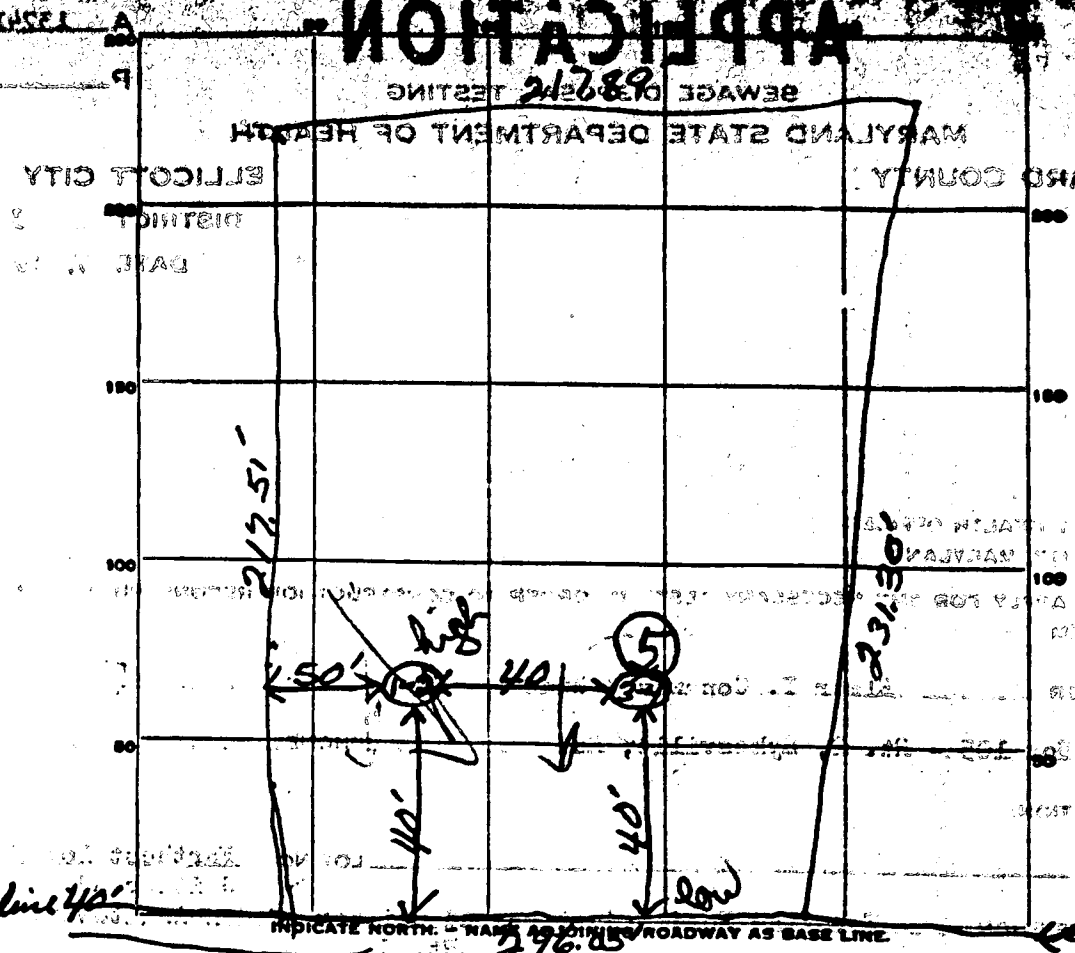

Set back line 40'

Set back line 40'

Forsythe Rd

DATE	TEST NO.	DEPTH	PRE-WET		TEST - 1" DROP		TIME	
			START	STOP	START	STOP		
2/17/68	1	5'	12:33	12:35	12:35	12:38	3	
	2	10'	12:52	12:55	12:55	12:59	4	
	3	4 1/2'	1:02	1:11	1:11	1:14	3	
	4	10'	1:32	1:34	1:34	1:45	9	
(5/11/79)	5	14	DRY ALL SAND					

77

SOIL AUGER FINDING

5 1/2" trial hole R/H

TESTED BY

John 2/17/68

also present Herbert Anderson
Pat Anderson

REMARKS

lot 1

HOWARD COUNTY HEALTH DEPARTMENT

JOYCE M. BOYD, M.D., M.P.H.
COUNTY HEALTH OFFICER



Bureau of Environmental Health
3625 Elliott Mills Drive
Elliott City, Maryland 21044

Director - 461-9933
Water & Sewerage, Permits - 461-9933
Community Environmental Health - 461-9944
Technical Services - 461-9955

August 6, 1987

Mr. James Burch
c/o Landscape Development Company
16304 Carrs Mill Road
Woodbine, Maryland 21797

RE: Parcel B Conway Property
13452 Forsythe Road
Sykesville, Maryland

Dear Mr. Burch:

A site inspection of the above referenced property on August 5, 1987 revealed significant alterations to the septic field area. These changes were neither agreed to nor approved at the time of building permit review. As a consequence, changes in the type and location of the septic system will be necessary.

It is recommended that any planned driveway installation be put on hold until the adjusted system is installed, since part of the system may end up underneath the driveway.


Finally, it is suggested that a further site inspection with the septic installer, owner/contractor and a health department inspector be held to clarify all relevant issues.

If you have any questions relative to this matter, please call me at 461-9933.

Very truly yours,

Bert Nixon, Sanitarian
Water and Sewerage Program

BN:JR

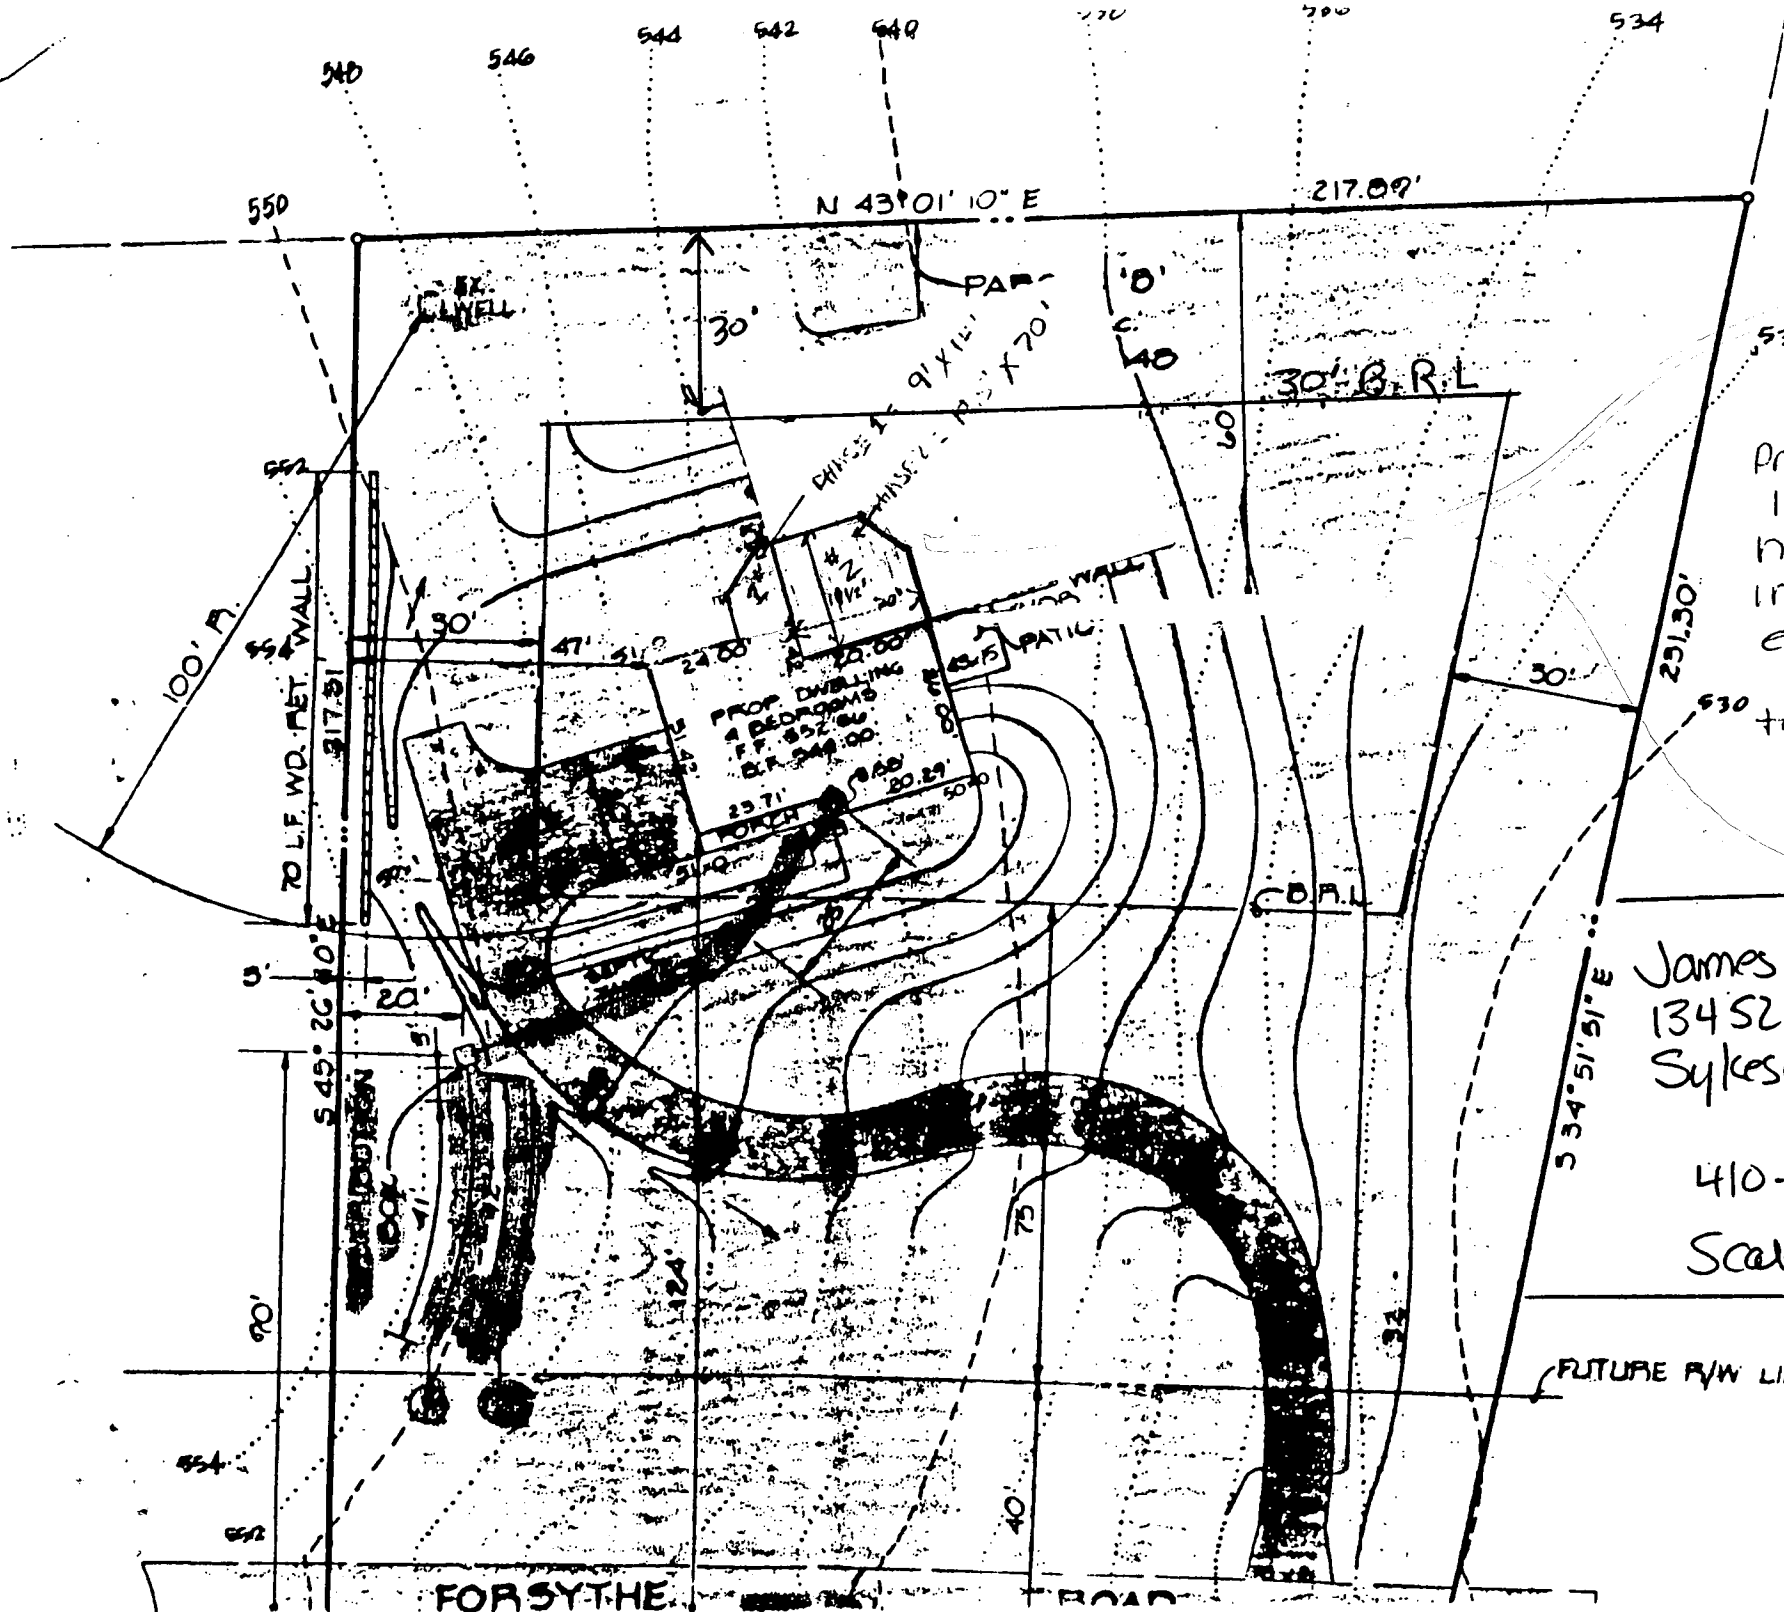

8/7/96
 Proposed deck location will have no impact to existing well or septic or to proceed
 ALL
 8/1/96

James P. Buech
 13452 FORSYTHE RD.
 Sykesville, Md.
 21784
 410-442-1453
 Scale 1" = 30'

FUTURE P/W LINE

FORSYTHE ROAD