


*Send to
lab*

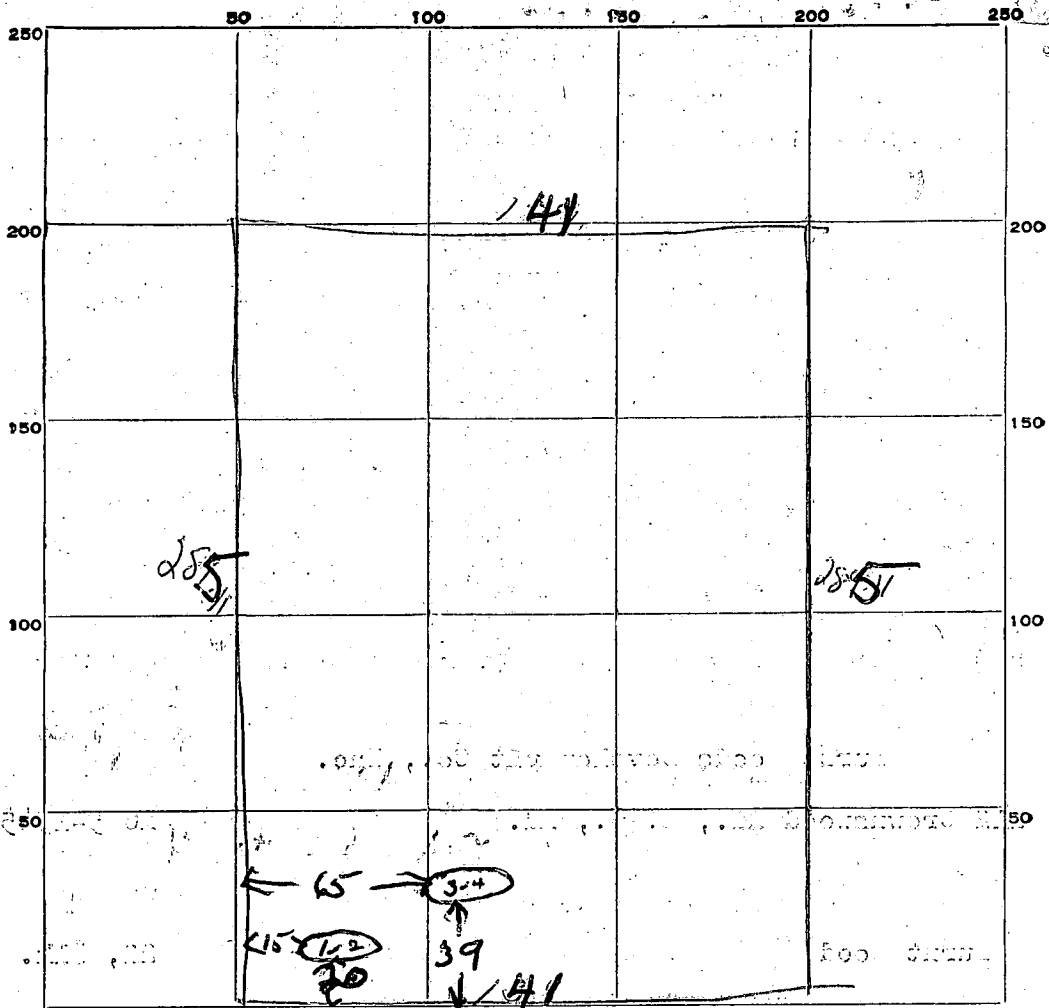

INDICATE NORTH. - NAME ADJOINING ROADWAY AS BASE LINE.

Overwoods Road

DATE	TEST NO.	DEPTH	PRE-WET		TEST - 1" DROP		TIME
			START	STOP	START	STOP	
9/9/64	1	10ft	3:30	340	340	352	12 min.
	2	6ft	3:31	341	341	401	20 min.
	3	14ft	3:33	343	343	404	21 min.
	4	6ft	3:34	350	350	422	32 min.

SOIL AUGER FINDING _____

TESTED BY 9/9/64 Sam RDF

REMARKS _____

ALSO PRESENT S. Booth LOT NO. 22 W/D Sec 2