

app 3-15-68  
DWM

# PERMIT

P 13450  
A 08278

SEWAGE DISPOSAL SYSTEM

MARYLAND STATE DEPARTMENT OF HEALTH

HOWARD COUNTY

ELLICOTT CITY  
DISTRICT 3

**INDEXED**

DATE 3/14/68

Robert Dubin Co. IS PERMITTED TO INSTALL X ALTER

ADDRESS Clarksville, Maryland PHONE 286-3432

A SEWAGE DISPOSAL SYSTEM LOCATED AT \_\_\_\_\_

SUBDIVISION Burntwood ROAD Burntwoods Rd. LOT 22, Blk. D,  
Sec. 2

PROPERTY OWNER Burnt Woods Development Co., Inc.

ADDRESS \_\_\_\_\_

SPECIFICATIONS - 3 bedrooms

DRAIN FIELD \_\_\_\_\_ DEPTH \_\_\_\_\_ FEET, BOTTOM AREA \_\_\_\_\_ SQ. FT.

SEEPAGE PITS \_\_\_\_\_ ABSORBENT SIDE-WALL AREA \_\_\_\_\_ SQ. FT.

SEPTIC TANK CAPACITY 750 GALLONS

FOR GARBAGE GRINDER, INCREASE DISPOSAL AREA 22% & TANK CAPACITY 50%.

OTHER Leaching bed - 200 sq. ft. bottom area per bedroom - installed no deeper than 8 ft. below original grade including gravel. Place leaching bed between 10 and 60 ft. from front lot line and between 15 and 80 ft. from left side line as seen when facing lot from Burntwoods Road.

NOTE: CALL FOR INSPECTION OF LEACHING BED WHEN EXCAVATION IS DUG.  
PERMIT VOID AFTER THREE YEARS.

PLANS APPROVED BY D. W. Monaghan & R. Fletcher DATE 9/28/64


FILL SEPTIC TANK AND DISTRIBUTION BOX WITH WATER BEFORE CALLING FOR AN INSPECTION. COVER NO WORK UNTIL INSPECTED AND APPROVED.

NEITHER THE HOWARD COUNTY COMMISSIONERS NOR THE HEALTH DEPARTMENT IS RESPONSIBLE FOR SUCCESSFUL OPERATION OF ANY SYSTEM.

**NOTIFY THE HEALTH DEPARTMENT 48 HOURS BEFORE EXCAVATIONS ARE TO BE BACK FILLED**

08278

42  
~~15~~  
 210  
 42

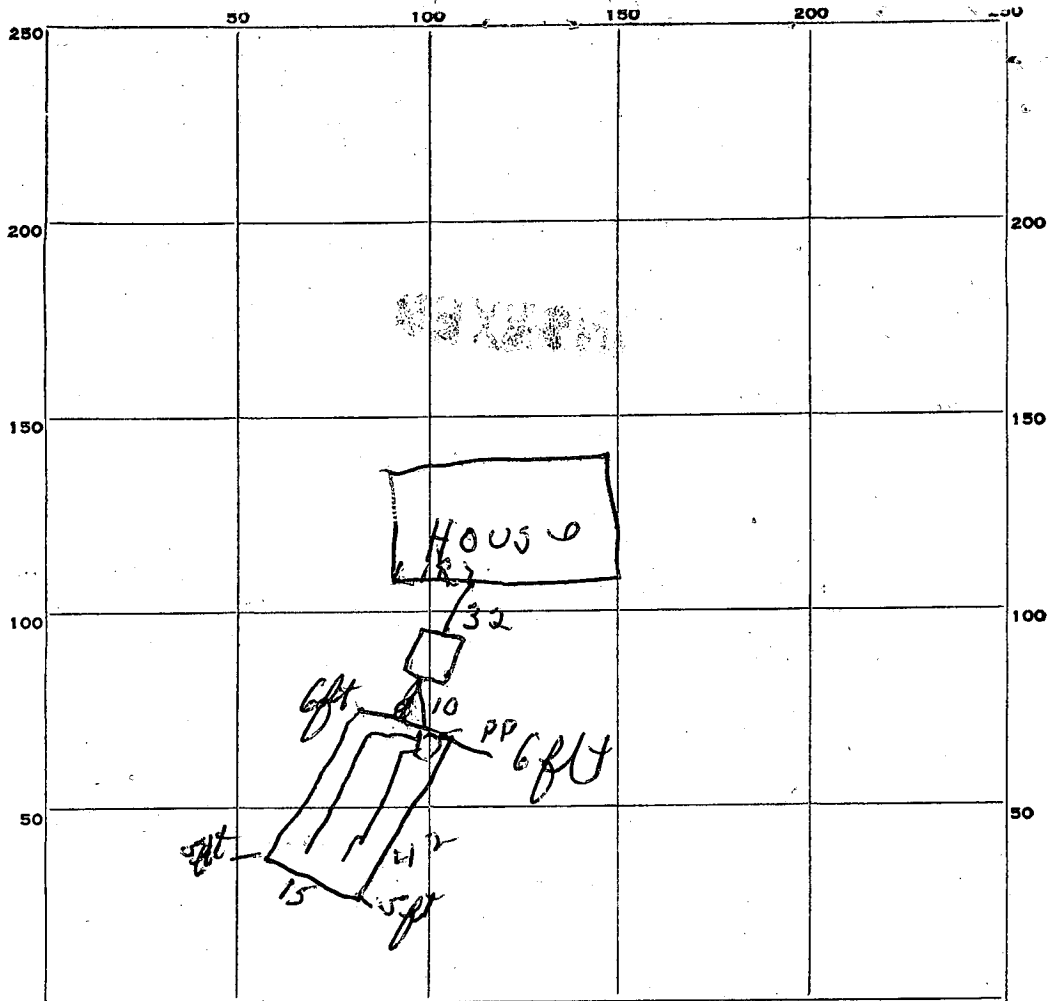

INDICATE NORTH. - NAME ADJOINING ROADWAY AS BASE LINE.

Burntwoods Road

PERMIT CARD OK

SEPTIC TANK, LEVEL OK

CLEANOUTS OK

DISTRIBUTION BOX, LEVEL OK

S Bed TILE FIELD, DEPTH 5 to 6 FT. S Bed TRENCH WIDTH 15 FT.

GRAVEL DEPTH 36 IN. S Bed TOTAL LENGTH 42 FT.

NUMBER OF TRENCHES \_\_\_\_\_ TOTAL BOTTOM AREA 630 sq ft

SEEPAGE PITS, INSIDE DIAMETER \_\_\_\_\_ FT. DEPTH BELOW INLET \_\_\_\_\_ FT.

ABSORBENT AREA \_\_\_\_\_ SQ. FT.

REMARKS \_\_\_\_\_  
 \_\_\_\_\_  
 \_\_\_\_\_  
 \_\_\_\_\_  
 \_\_\_\_\_

DATE SYSTEM APPROVED 3/15/68

INSPECTOR W. Managhan