

9/30/98
12:00
10:00

04-349350

PERMIT

SEWAGE DISPOSAL SYSTEM

DEPARTMENT OF HEALTH AND MENTAL HYGIENE

P510562

A 41123

DISTRICT _____

DATE 7/14/98

DATE SYSTEM APPROVED 10.5.98

INSPECTOR KM

HOWARD COUNTY HEALTH DEPARTMENT
BUREAU OF ENVIRONMENTAL HEALTH
~~XXXXXXX~~ 410-313-2640

INDEXED

Walter W. King P & H Contractors IS PERMITTED TO INSTALL ALTER

ADDRESS 5305 Kings Ct Fred, MD 21703 PHONE 1301 831 4070

SUBDIVISION Wellington LOT 12 ROAD 2831 Hunt Valley Drive

PROPERTY OWNER Michael Taylor

BUILDING PERMIT SIGNED

ADDRESS _____

AND RETURNED

SEPTIC TANK CAPACITY 1500 GALLONS 2/11/04 Screened Pouch

NUMBER OF BEDROOMS 5

300 SQUARE FEET PER BEDROOM

LINEAR FEET OF TRENCH REQUIRED 375

TRENCHES - Trench to be 2' wide. Inlet 4' below original grade. Bottom maximum depth 8' below original grade. Effective area begins at 4' below original grade. 4' of stone below distribution pipe.

LOCATION - Place the distrib. box 150' from the front property line (213.83') and 130' from the right property line (542.48') as viewed from Hunt Valley Drive. Install trenches on contour toward rear lot line.

NOTES - No trench to exceed 100' in length. Provide 6"-8" diameter cleanout and cap to grade or above on septic tank.

App 9/6/98

BLDG. PERMIT SIGNED

AND RETURNED 6/22/2000

PLANS APPROVED BY Ronald J. Pinkley B00125023 DATE 7/2/98

DECK W/STEPS

COVER NO WORK UNTIL INSPECTED AND APPROVED

NEITHER THE HOWARD COUNTY COUNCIL NOR THE HEALTH DEPARTMENT IS RESPONSIBLE FOR THE SUCCESSFUL OPERATION OF ANY SYSTEM

NOTE: CLEANOUT REQUIRED EVERY 70 FEET OF SEWER LINE AND/OR AT 90° SWEEPS IN LINES FROM HOUSE TO DRAIN FIELDS. 90° ELBOWS NOT ACCEPTABLE.

NOTE: ALL PARTS OF SEPTIC SYSTEMS (I.E. TANK, DISTRIBUTION BOX TRENCHES) TO BE 100 FEET FROM WELL (UNLESS OTHERWISE SPECIFICALLY AUTHORIZED)

NOTE: IF DEEP TRENCH(ES) ARE USED CALL FOR INSPECTION BEFORE AND AFTER PLACING GRAVEL IN TRENCH(ES)

NOTE: NO DRY WELL SHALL EXCEED 15 FOOT IN DIAMETER NO ABSORPTION TRENCH TO EXCEED 100 FEET IN LENGTH

NOTE: ALL PIPE FROM HOUSE TO SEPTIC TANK MUST BE CAST IRON OR SCHEDULE 35/40 PVC OR ABS

BLDG. PERMIT SIGNED

AND RETURNED 9-29-98

Serial # B0114233


PERMIT VOID AFTER TWO YEARS

NOTE: INSTALL STAND PIPE ON SEPTIC TANK AND DRY WELL STAND PIPES MUST BE 6 INCHES IN DIAMETER CAST IRON, CONCRETE OR TERRA COTTA OR PVA OR ABS ACCEPTED. IF TOP OF SEPTIC TANK IS DEEPER THAN 3 FEET. MANHOLE TO GRADE REQUIRED. *500 gallon purple tank*

NOTE: DISTRIBUTION BOXES MUST HAVE BAFFLES

***INSTALLER IS RESPONSIBLE FOR OBTAINING FINAL APPROVAL ON THIS PERMIT**

A 41123

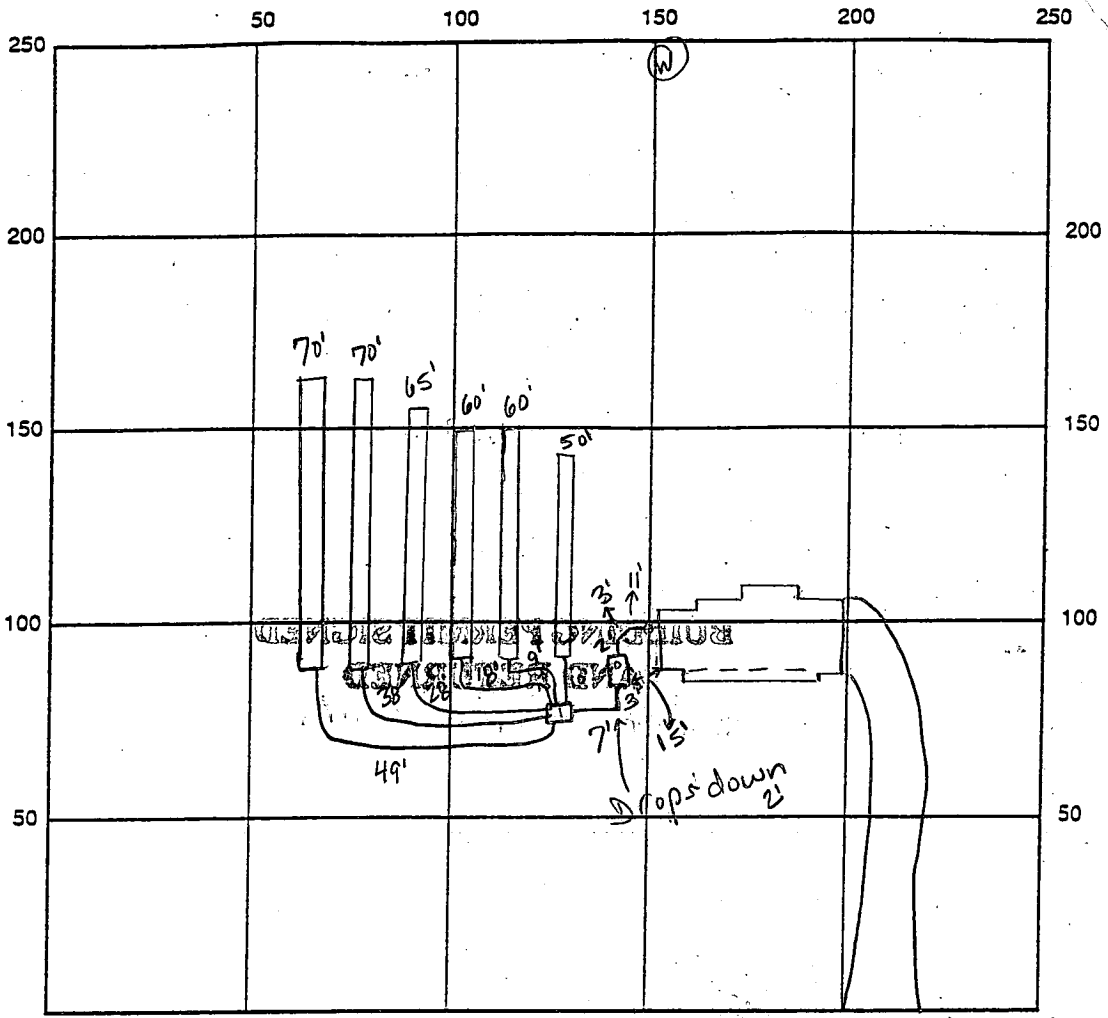


INDICATE NORTH - NAME ADJOINING ROADWAY AS BASE LINE Hunt Valley

SEPTIC TANK LEVEL OK CLEANOUTS 1 at house, 1 on tank
 DISTRIBUTION BOX LEVEL OK
 DRAIN FIELD/TITLE DEPTH 8 FT. TRENCH WIDTH 2 FT. INLET DEPTH 4 FT.
 EFFECTIVE GRAVEL DEPTH 4 FT. TOTAL LENGTH 375 FT.
 NUMBER OF TRENCHES 6 ONE SIDEWALL/BOTTOM AREA 1500 SQ. FT.
 DRYWALL INSIDE DIAMETER — FT. EFFECTIVE DEPTH BELOW INLET — FT.
 ABSORBENT AREA — SQ. FT.

REMARKS: 9.30.98 ok to stone trenches and continue (KM)
10.5.98 has house connection, ok to cover all work KM

DATE SYSTEM APPROVED 10.5.98 INSPECTOR Kim Maisto

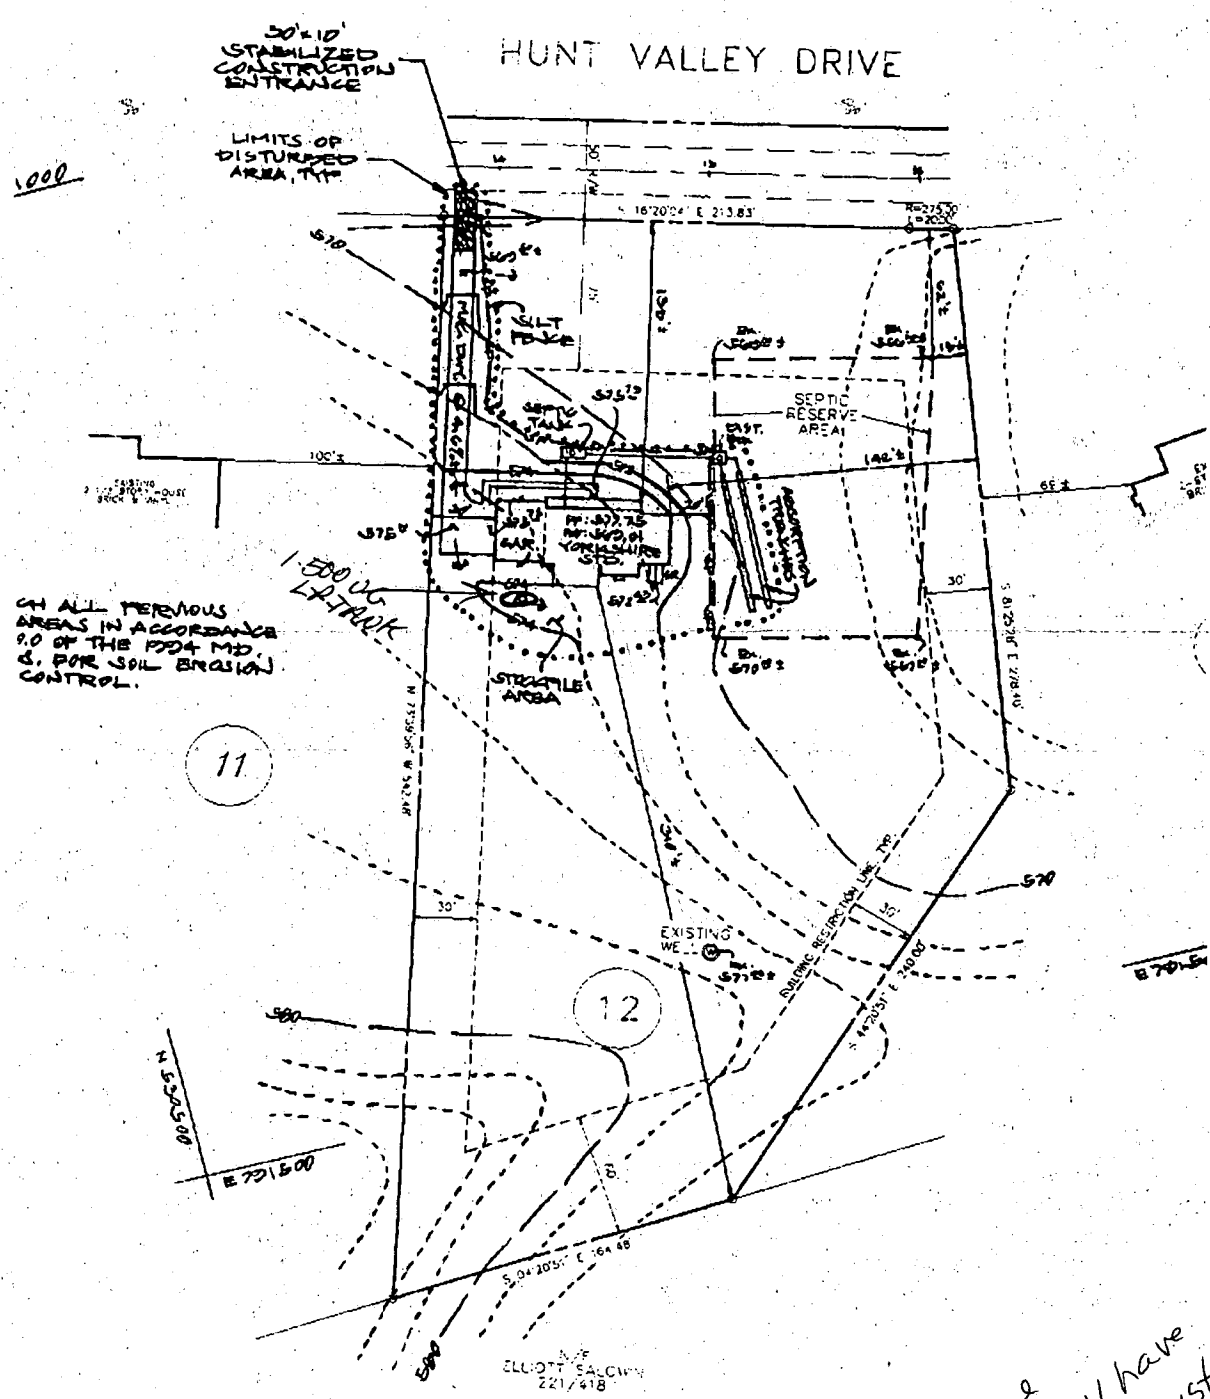

9-29-98
 Shown propane
 tank location will have
 no impact to the existing
 well or septic.
 A McMillan

APPLICATION

SEWAGE DISPOSAL TESTING

STATE OF MARYLAND - DEPARTMENT OF HEALTH AND MENTAL HYGIENE

HOWARD COUNTY HEALTH DEPARTMENT
ENVIRONMENTAL HEALTH SERVICES

P. O. BOX 476 ELLICOTT CITY, MARYLAND 21043
TELEPHONE 992-2330

A 41123

P _____

DISTRICT 47A

DATE ~~December 18, 1987~~

FEB 26 1988

*5/10/88
perc filed
pending
pld
approved*

TO: THE COUNTY HEALTH OFFICER
ELLICOTT CITY, MARYLAND

I, HEREBY, APPLY FOR THE NECESSARY TEST IN ORDER TO CONSTRUCT (OR RECONSTRUCT) A SEWAGE DISPOSAL SYSTEM

PROPERTY OWNER C. Oliver Goldsmith, et ux *MICHAEL TAYLOR*

ADDRESS Route 27, Longwood Farm, Glenwood, MD 21737 PHONE 301-442-2121

PROPERTY LOCATION: _____
SUBDIVISION Longwood Farm LOT NO. *9* *LOT 12 Preliminary Sec. 1*

ROAD AND DESCRIPTION Southwest Quadrant of intersection of Roxbury Mills Rd. (Rt. 97) and
Union Chapel Road *(2831 Hunt Valley Drive)*

SIZE OF LOT 3+ Acres TYPE BLDG. SFD Residential
(NUMBER OF BEDROOMS) *
* Undetermined at this time

THE SYSTEM INSTALLED UNDER THIS APPLICATION IS ACCEPTABLE ONLY UNTIL PUBLIC FACILITIES BECOME AVAILABLE. I FULLY UNDERSTAND THE

FEE CONNECTED WITH THE FILING OF THIS PERC TEST APPLICATION IS NON-REFUNDABLE UNDER ANY CIRCUMSTANCES. I ALSO AGREE TO COMPLY

WITH ALL MOSHA REQUIREMENTS IN TESTING THIS LOT. *Security Development Corp*
Attn: Bruce V.P.
(SIGNATURE OF APPLICANT)

APPROVED BY _____ FOR _____ DATE _____

REJECTED BY _____ FOR _____ DATE _____

HOLD PENDING FURTHER TESTS _____ DATE _____


REASONS FOR REJECTION OR HOLDING *for field located holes & lot lines, S/D pld*

BLDG. PERMIT SIGNED
 HAS RETURNED *4-24-88*
Health Div 112429
SFD-56m

THIS IS NOT A PERMIT

INLET 4 1/2
 MAX D 8 1/2
 X = 21 MIN
 230 1/8 D

HUNT VALLEY DRIVE

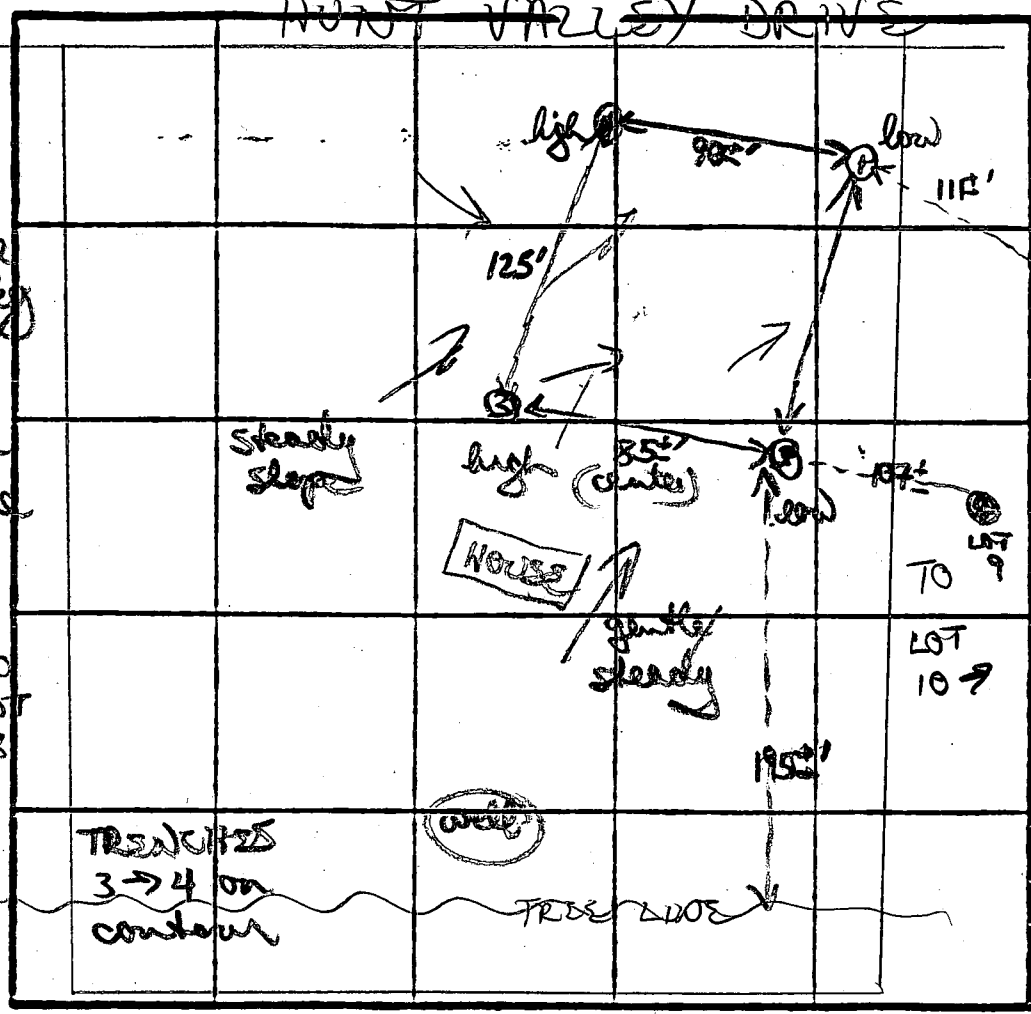

orange / purple
 chunky
 clay (heavy)
 to purple / tan
 clay / silt
 to powdery
 purple / tan
 silty
 with
 5-10%
 few scattered
 shell frags
 R/D

SOIL PROFILE
 Brown / orange
 yellow chunky
 clay mix
 4'
 to an orange
 orange purple
 clay silt
 mix 7'
 to mostly
 powdery
 light orange
 silty loam

orange / brown
 gummy clay
 sandy silt
 mix 4'

to mostly
 light tan
 powdery silty
 mica loam

with few small
 scattered shell
 frags
 13' D
 3

orange / brown
 gummy clay
 sandy loam
 3'

TRENCHES
 3 → 4 on
 contour

INDICATE NORTH - NAME ADJOINING ROADWAY AS BASE LINE.

DATE	TEST NO.	DEPTH	PRE-WET		TEST - 1' DROP		TIME	
			START	STOP	START	STOP		
5/10/88	①	4 1/2 S	1133	1148	1148	1217	29 MIN	
		8 1/2 M	1133	1141	1141	1158	17 MIN	
		13' D	Bottom (see profile)					
	②	4' S	1131	1142	1142	1203	23 MIN	
		13' D	Bottom (see profile)					
	③	3 1/2 S	1137	1141	1141	1151	10 MIN	
		12 1/2 D	Bottom (see profile)					
	④	3 1/2 S	1140	1155	1155	1218	23 MIN	
		12' D	Bottom (see profile)					

to purple / tan
 mostly light
 orange / tan
 powdery silty
 mica

Day started as staked, open field no corners

REMARKS
 orange / brown purple clays 4-5', clay silt loam 5-7', mostly
 silty below


TESTED BY B. Nufan

ALSO PRESENT Chip, Kern

HUNT VALLEY DRIVE

30'x10'
STABILIZED
CONSTRUCTION
ENTRANCE

LIMITS OF
DISTURBED
AREA, TYP.

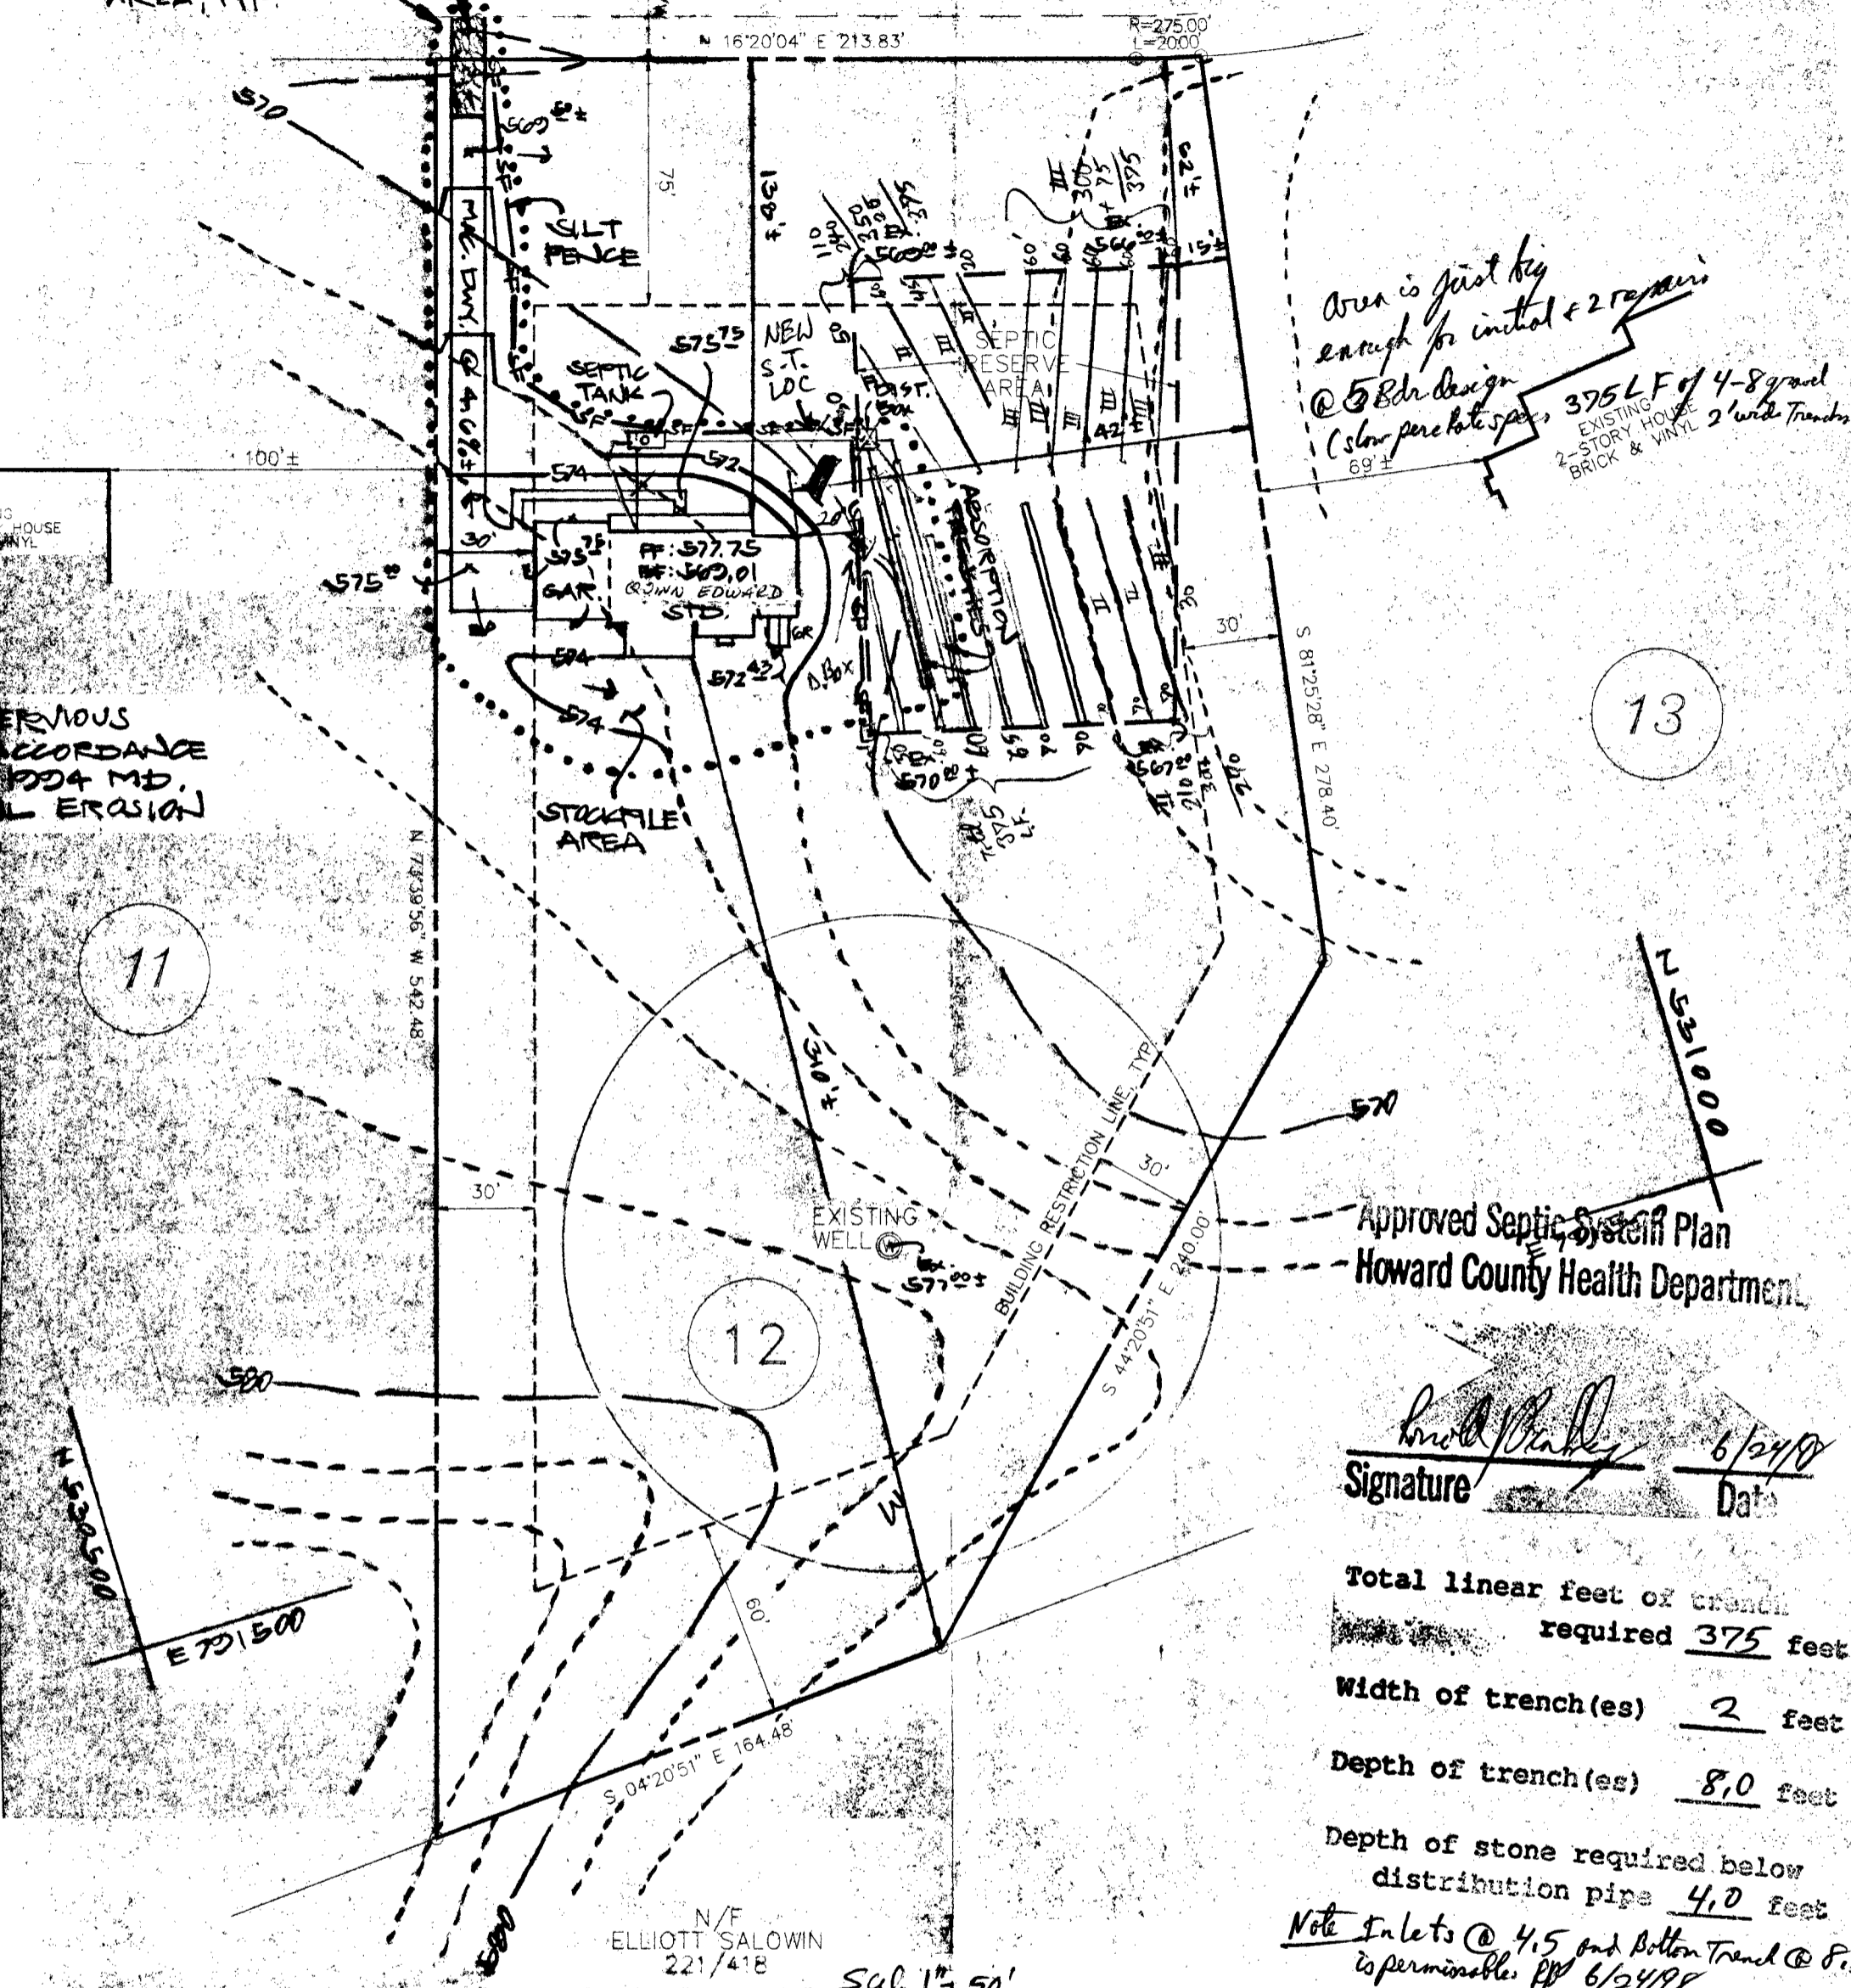

Area is just big
enough for initial + 2 repairs
@ 5 Bdr Design
(slow permeable spec)
375 LF of 4-8 gravel
EXISTING
2-STORY HOUSE
BRICK & VINYL 2' wide Trenches

13

11

12

Approved Septic System Plan
Howard County Health Department

Donald Bradley
Signature _____ Date 6/24/98

Total linear feet of trench
required 375 feet
Width of trench(es) 2 feet
Depth of trench(es) 8.0 feet
Depth of stone required below
distribution pipe 4.0 feet

Note Inlets @ 4.5 and Bottom Trench @ 8.5 ft
is permissible. RPP 6/24/98

5 Bdr Design Requires
375 Lin. Ft of Trench
Need to demonstrate from *look at (see above)*
initial + 2 repairs @ 5 Bdr Design
optimum trench placement
(concrete E 10' apart with spacing between trenches
C to C

N/F
ELLIOTT SALOWIN
221/418

Sub 1" 50'


REFER TO PERC. TEST APPLICATION NO. 1 A-4122.
PERC. TIME - 21.0 MIN. (+.5) / BOTTOM MAX. *8.0*

SEPTIC ELEVATIONS:

- BASEMENT ELEVATION - 569.01
- FIRST FLOOR ELEVATION - 577.75
- INVERT OUT OF HOUSE - 507.00 ✓
- INVERT INTO SEPTIC TANK - 500.70 ✓
- INVERT OUT OF SEPTIC TANK - 506.00 ✓
- INVERT INTO DISTRIBUTION BOX - 506.00 ✓
- INVERT INTO TRENCHES (506.00) OK
- EXISTING GRADE AT SEPTIC TANK - 571.50
- EXISTING GRADE AT DISTRIBUTION BOX - 509.00
- EXISTING GRADE AT TRENCHES - 562.00 ✓
- ELEVATION OF WELL AT GRADE - 577.00 ✓


*566.00 to db
561.00
570-61.52
and lower*

ERNOUS
ACCORDANCE
1994 MD.
L EROSION

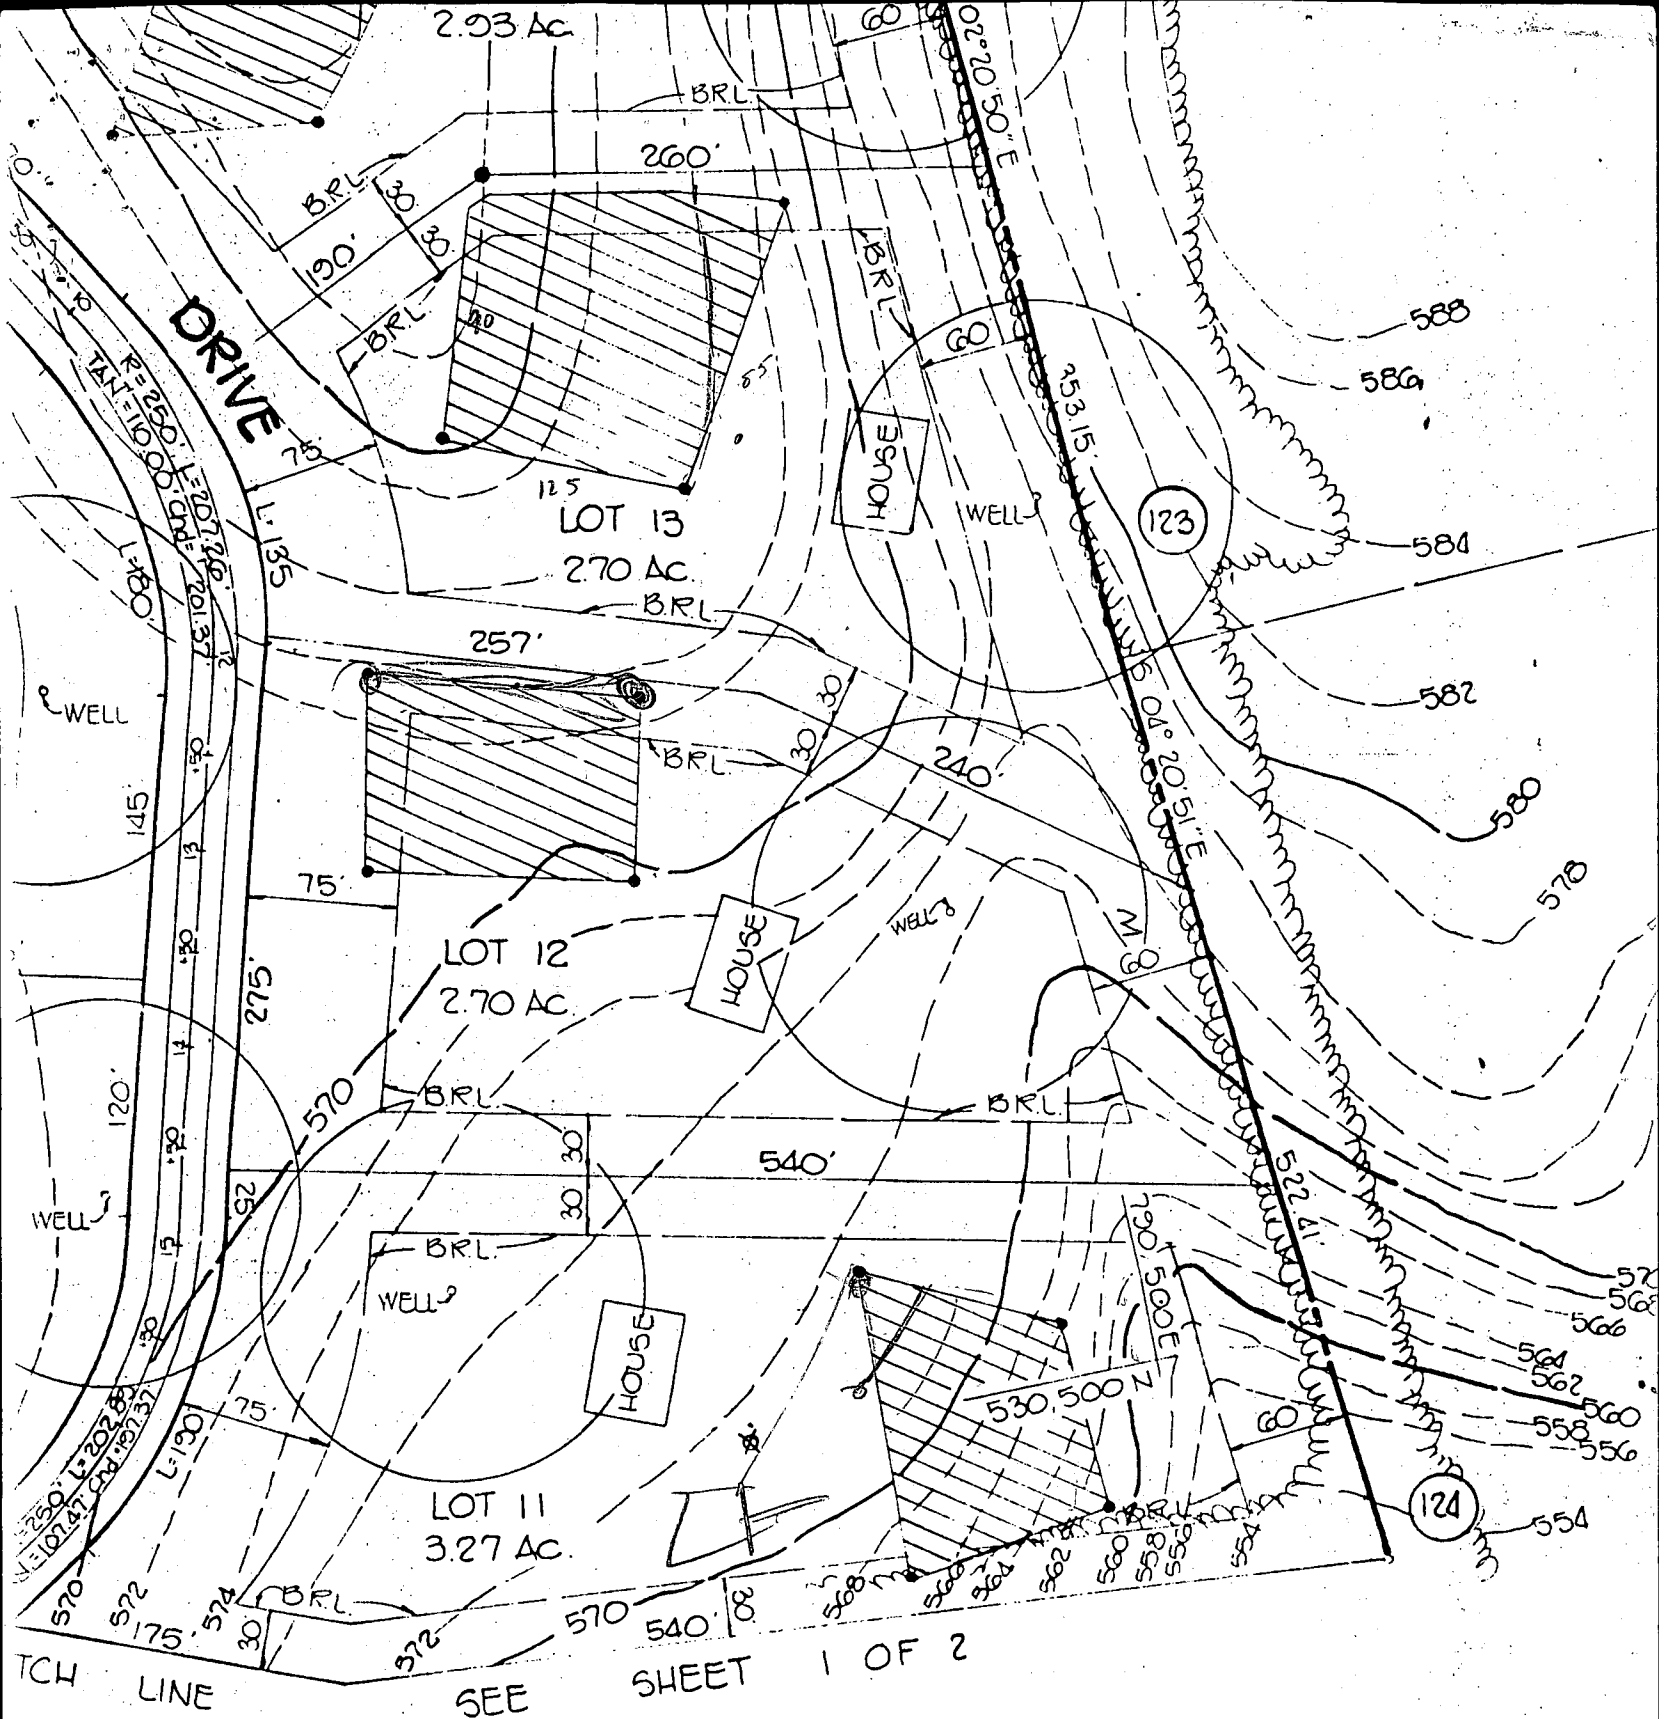

TRACY, SCHULTE & ASSOCIATES INC.
 planning • architecture • engineering

8480 Baltimore National Pike • Ellicott City, Maryland 21043 • (301) 465-6105

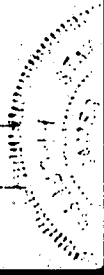


Mike Taylor

W-410-256-7510
H-581-3096

May-14-98 01:56P Colbert Matz Rosenfelt

410 653 7953

P.01

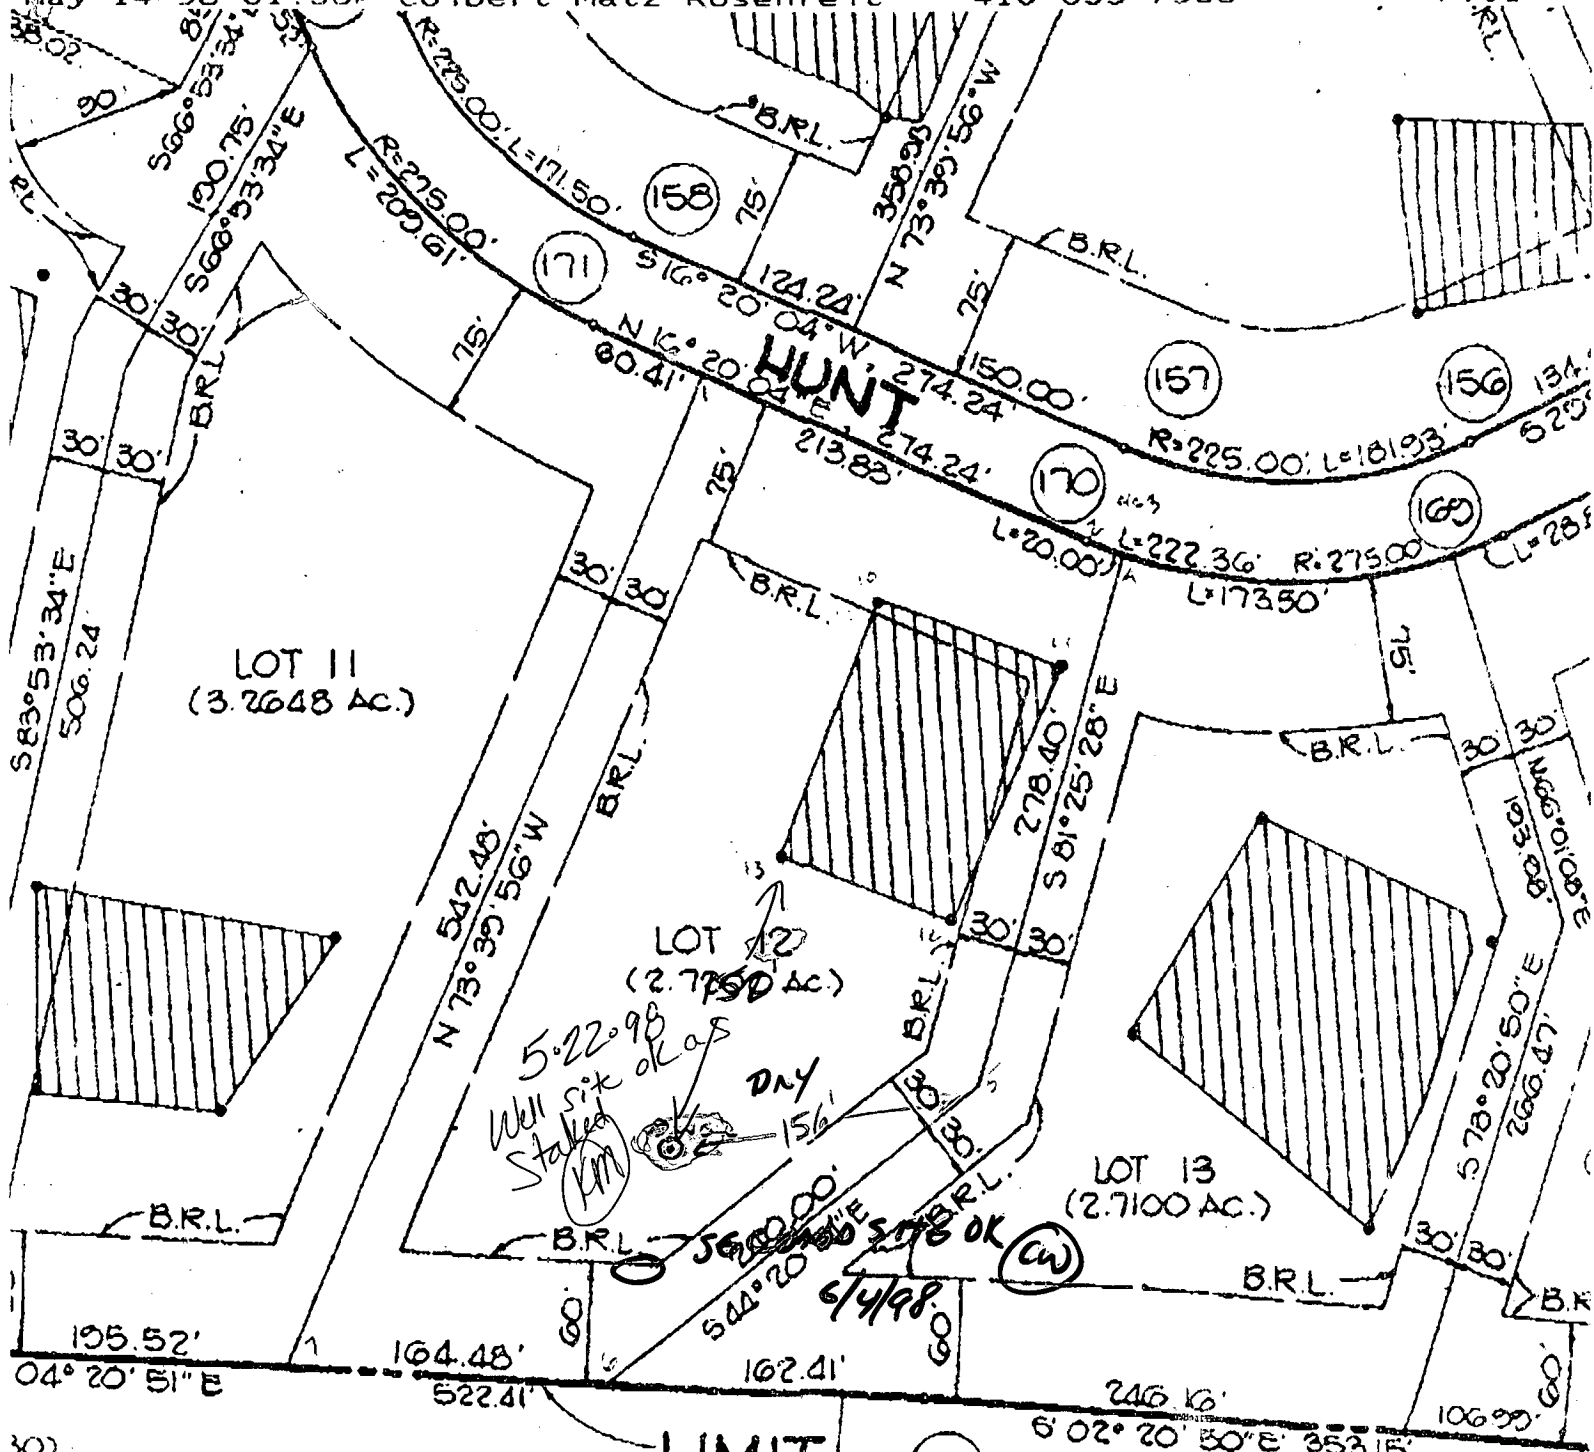

LOT 11
(3.2648 AC.)

LOT 12
(2.7750 AC.)

LOT 13
(2.7100 AC.)

5.22.98
Well Six
Staked
OK
DNY
156'

LIMIT

ELLIOT-SALOWIN
221/418

OF

10
31.0203 AC
3.2144
34.3047

WER

SURVEYOR'S CERTIFICATION

I HEREBY CERTIFY THAT THE FINAL PLAT IS CORRECT; THAT IT IS PART OF THE LAND OBTAINED BY SECURITY DEVELOPMENT CORP., FROM C. OUYER GOLDSMITH BY DEED DATED JANUARY 25, 1989 AND RECORDED IN LIBER 1548 AT FOLIO 116 IN THE LAND RECORDS OF HOWARD COUNTY, MARYLAND AND THAT ALL MONUMENTS ARE IN PLACE, OR WILL BE IN PLACE, PRIOR TO ACCEPTANCE OF THE STREETS IN THE SUBDIVISION OF HOWARD COUNTY, AS SHOWN IN ACCORDANCE WITH THE ANNOTATED CODES OF MARYLAND.

WE, SECURITY DEVELOPMENT CORP., C SUBDIVISION, AND IN CONSIDERATION ESTABLISH THE MINIMUM BUILDING ASSIGNS, (1) THE RIGHT TO UTILITIES AND SERVICES, IN AND SHOWN HEREON; (2) THE RIGHT AND FLOODPLAINS AND OPEN SPACE GRANT THE RIGHT AND OPTION AND/OR ROADS AND FLOODPLAIN REQUIRE DEDICATION OF WATERWAY REPAIR AND MAINTENANCE; AND OVER THE SAID EASEMENTS AND



James R. Moxley
JAMES R. MOXLEY, JR.

OWNING

15

PUBLIC OF

B 1 7905 SEQUENCE NO. (DP USE ONLY)
1 2 3 4 5 6
(THIS NUMBER IS TO BE PUNCHED IN COLS. 3-6 ON ALL CARDS)

STATE OF MARYLAND
APPLICATION FOR PERMIT TO DRILL WELL
please print or type

STATE PERMIT NUMBER
H0-92-0251
70 fill in this form completely 79

Date Received (APA) 110992
OWNER INFORMATION
CLARK ASSOCIATES
11356 HOWARD RD
ELLICOTT CITY MD 21043

B 3 LOCATION OF WELL
HOWARD
WELKINGTON
GREENWOOD
MILES FROM TOWN (enter 0 if in town) 1/2 MI

DRILLER INFORMATION
Joseph L. MAUNE
Joseph L. Maune Well Drill Inc
5512 RIDGE RD. MT. AIRY 21071
Joseph L. Maune 11/9/92

B 4 HUNT VALLEY DR.
DIRECTION OF WELL FROM TOWN (CIRCLE BOX) W
ON WHICH SIDE OF ROAD (CIRCLE APPROPRIATE BOX) W
DISTANCE FROM ROAD 355 FT
ENTER FT OR MI FF

B 2 WELL INFORMATION
APPROX. PUMPING RATE (GAL. PER MIN) 5
AVERAGE DAILY QUANTITY NEEDED (GAL. PER DAY) 500

NOT TO BE FILLED IN BY DRILLER HEALTH DEPARTMENT APPROVAL
HOWARD COUNTY NAME
A# 41123
DATE ISSUED 112392
CO SIGNATURE Charles B. ...
NORTH GRID 530000 EAST GRID 0791000


USE FOR WATER (CIRCLE APPROPRIATE BOX)
D HOME (SINGLE OR DOUBLE HOUSEHOLD UNIT ONLY)
F FARMING (LIVESTOCK WATERING & AGRICULTURAL IRRIGATION)
I INDUSTRIAL, COMMERCIAL, STATE AND FEDERAL GOV. OTHER (REQUIRES APPROPRIATION PERMIT)
P PUBLIC OR PRIVATE WATER COMPANY (REQUIRES APPROPRIATION PERMIT AND STATE HEALTH DEPARTMENT APPROVAL)
T TEST, OBSERVATION, MONITORING (MAY REQUIRE APPROPRIATION PERMIT)

APPROXIMATE DEPTH OF WELL 200 FEET
APPROXIMATE DIAMETER OF WELL 6 INCH

SHOW MAJOR FEATURES OF BOX & LOCATE WELL WITH AN X
SOURCES OF DRILLING WATER 1. Well
WRITE THE BOX NUMBER FROM THE MAP HERE
E 798
N 538

METHOD OF DRILLING (circle one)
BORED (or Augered) JETTED Jetted & DRIVEN
AIR-ROTARY AIR-PERCussion ROTARY (Hydraulic Rotary)
CABLE REVerse-ROTary Drive-POINT

REPLACEMENT OR DEEPEMED WELLS (CIRCLE APPROPRIATE BOX)
N THIS WELL WILL NOT REPLACE AN EXISTING WELL
Y THIS WELL WILL REPLACE A WELL THAT WILL BE ABANDONED AND SEALED
S THIS WELL WILL REPLACE A WELL THAT WILL BE USED AS A STANDBY
D THIS WELL WILL DEEPEM AN EXISTING WELL
PERMIT NUMBER OF WELL TO BE REPLACED OR DEEPEMED (IF AVAILABLE) 41

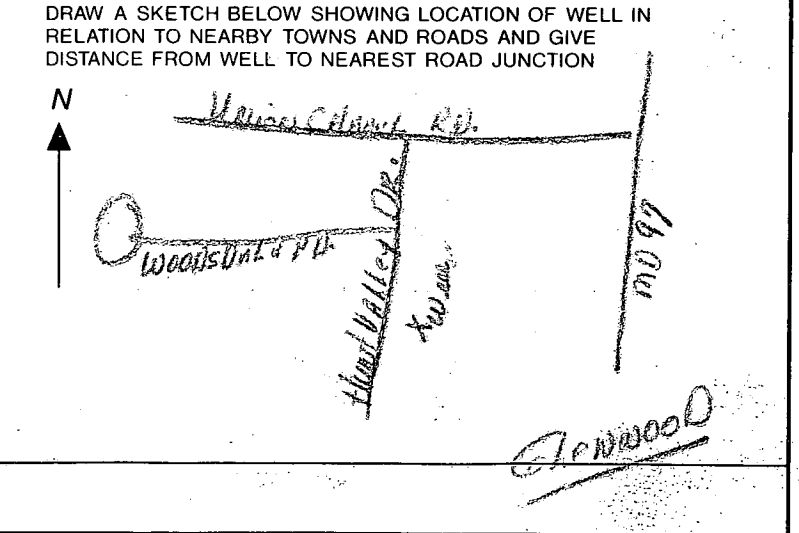

Not to be filled in by driller (OEP USE ONLY)
APPROX. PERMIT NUMBER GAP
FORCE CM PERMIT No. H0-92-0251

SPECIAL CONDITIONS

C1 05007 SEQUENCE NO. (MDE USE ONLY)

STATE OF MARYLAND WELL COMPLETION REPORT

THIS REPORT MUST BE SUBMITTED WITHIN 45 DAYS AFTER WELL IS COMPLETED.

(THIS NUMBER IS TO BE PUNCHED IN COLS. 3-6 ON ALL CARDS)

FILL IN THIS FORM COMPLETELY PLEASE PRINT OR TYPE

COUNTY NUMBER A41123

ST/CO USE ONLY DATE RECEIVED 10-15-98

DATE WELL COMPLETED 10-9-98 Depth of Well 400' (TO NEAREST FOOT)

PERMIT NO. FROM "PERMIT TO DRILL WELL" HO-94-1353

OWNER Taylor Hunt Valley Drive White TOWN Glenwood SUBDIVISION Wellington SECTION LOT 12

WELL LOG Not required for driven wells

Table with columns: DESCRIPTION (Use additional sheets if needed), FEET (FROM, TO), check if water bearing. Rows: Sand (0-38), Gray Granite (38-400). Includes handwritten note: 'Dry well 440' filled in with cement + drilling materials'

GROUTING RECORD

WELL HAS BEEN GROUTED (Circle Appropriate Box) YES [Y] NO [N] TYPE OF GROUTING MATERIAL (Circle one) CEMENT [CM] BENTONITE CLAY [BC] NO. OF BAGS 18 NO. OF POUNDS 1692 GALLONS OF WATER 108 DEPTH OF GROUT SEAL (to nearest foot) from 0 ft. to 38 ft.

CASING RECORD casing types insert appropriate code below [ST] STEEL [C/O] CONCRETE [PL] PLASTIC [O/T] OTHER

MAIN CASING TYPE [ST] Nominal diameter top (main) casing (nearest inch)! 6 Total depth of main casing (nearest foot) 41

OTHER CASING (if used) diameter inch depth (feet) from to

SCREEN RECORD screen type or open hole (insert appropriate code below) [ST] STEEL [BR] BRASS [HO] OPEN HOLE [PL] PLASTIC [O/T] OTHER

DEPTH (nearest ft.) table with columns 1-11, 15-17, 21-23, 26-30, 32-36, 38-41, 45-47, 51-53. Includes slot size and diameter of screen.

GRAVEL PACK IF WELL DRILLED WAS FLOWING WELL INSERT F IN BOX 68

MDE USE ONLY (NOT TO BE FILLED IN BY DRILLER) T (E.R.O.S.) W Q

PUMPING TEST

HOURS PUMPED (nearest hour) 6 PUMPING RATE (gal. per min.) 25 METHOD USED TO MEASURE PUMPING RATE Bucket WATER LEVEL (distance from land surface) BEFORE PUMPING 35 WHEN PUMPING 317 TYPE OF PUMP USED (for test) [S] submersible

PUMP INSTALLED

DRILLER WILL INSTALL PUMP YES [NO] IF DRILLER INSTALLS PUMP, THIS SECTION MUST BE COMPLETED FOR ALL WELLS. TYPE OF PUMP INSTALLED PLACE (A,C,J,P,R,S,T,O) IN BOX 29 CAPACITY: GALLONS PER MINUTE (to nearest gallon) 31-35 PUMP HORSE POWER 37-41 PUMP COLUMN LENGTH (nearest ft.) 43-47 CASING HEIGHT (circle appropriate box and enter casing height) [+] above LAND SURFACE [] below (nearest foot) 50-51

LOCATION OF WELL ON LOT SHOW PERMANENT STRUCTURE SUCH AS BUILDING, SEPTIC TANKS, AND /OR LANDMARKS AND INDICATE NOT LESS THAN TWO DISTANCES (MEASUREMENTS TO WELL)

NUMBER OF UNSUCCESSFUL WELLS: 1 WELL HYDROFRACTURED YES [Y] NO [N]

CIRCLE APPROPRIATE LETTER A A WELL WAS ABANDONED AND SEALED WHEN THIS WELL WAS COMPLETED E ELECTRIC LOG OBTAINED P TEST WELL CONVERTED TO PRODUCTION WELL

I HEREBY CERTIFY THAT THIS WELL HAS BEEN CONSTRUCTED IN ACCORDANCE WITH COMAR 26.04.04 "WELL CONSTRUCTION" AND IN CONFORMANCE WITH ALL CONDITIONS STATED IN THE ABOVE CAPTIONED PERMIT, AND THAT THE INFORMATION PRESENTED HEREIN IS ACCURATE AND COMPLETE TO THE BEST OF MY KNOWLEDGE.

DRILLERS LIC. NO. MS D 024 DRILLERS SIGNATURE (MUST MATCH SIGNATURE ON APPLICATION) LIC. NO. M D

SITE SUPERVISOR (sign. of driller or journeyman responsible for sitework if different from permittee)

See attached well location

B 1 6708

SEQUENCE NO. (MDE USE ONLY)

STATE OF MARYLAND PERMIT TO DRILL WELL please print or type

STATE PERMIT NUMBER

HO-94-1553 fill in this form completely

Date Received (APA) 5-18-98

OWNER INFORMATION

8 MM DD YY 13 Taylor Mike 15 Last Name Owner First Name 34 36 9973 Sherwood Farm Rd. Street or RFD 55 57 Owings Mill Md. 21117 Town State Zip 76

B 3

LOCATION OF WELL


8 COUNTY Howard 21 23 SUBDIVISION Wellington 42 44 SECTION 46 48 LOT 12 50 52 NEAREST TOWN Glenwood 71 73 MILES FROM TOWN (enter 0 if in town) 1/2 M 76 77 78

DRILLER INFORMATION

Driller's Name Joseph L. Mayne M S D 024 License No. 81 Firm Name Joseph L. Mayne Well Drilling Address 5512 Ridge Rd. Mt. Airy 21771 Address Signature Joseph Mayne Date 5/15/98

B 4

DIRECTION OF WELL FROM TOWN (CIRCLE BOX)

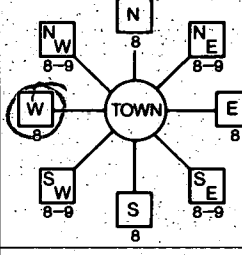

11 Hunt Valley Dr. NEAR WHAT ROAD 30

ON WHICH SIDE OF ROAD (CIRCLE APPROPRIATE BOX)

34 375 37 DISTANCE FROM ROAD FT 38: 39 ENTER FT OR MI

B 2

WELL INFORMATION

APPROX. PUMPING RATE (GAL. PER MIN.) 5 8 12 AVERAGE DAILY QUANTITY NEEDED (GAL. PER DAY) 500 14 20

USE FOR WATER (CIRCLE APPROPRIATE BOX)

- DOMESTIC POTABLE SUPPLY & RESIDENTIAL IRRIGATION FARMING (LIVESTOCK WATERING & AGRICULTURAL IRRIGATION) INDUSTRIAL, COMMERCIAL, DEWATERING PUBLIC WATER SUPPLY WELL TEST, OBSERVATION, MONITORING GEO-THERMAL

NOT TO BE FILLED IN BY DRILLER HEALTH DEPARTMENT APPROVAL

Howard A41123 COUNTY NAME COUNTY NO. STATE SIGNATURE INSERT S DATE ISSUED 5-22-98 Kim Minto 5-22-99 41 43 MM DD YY 48 CO SIGNATURE EXP. DATE NORTH GRID 532 000 EAST GRID 792 000 50 55 57 63

APPROXIMATE DEPTH OF WELL 300 FEET 24 28

APPROXIMATE DIAMETER OF WELL 6 INCH NEAREST INCH

METHOD OF DRILLING (circle one)

BORED (or Augered) JETTED Jetted & DRIVEN 30 AIR-ROTary AIR-PERCussion ROTARY (Hydraulic Rotary) 37 CABLE REVerse-ROTary Drive-POINT other

REPLACEMENT OR DEEPEMED WELLS (CIRCLE APPROPRIATE BOX)

- THIS WELL WILL NOT REPLACE AN EXISTING WELL THIS WELL WILL REPLACE A WELL THAT WILL BE ABANDONED AND SEALED THIS WELL WILL REPLACE A WELL THAT WILL BE USED AS A STANDBY-CONTACT LOCAL APPROVING AUTHORITY FOR POLICY ON STANDBY WELLS THIS WELL WILL DEEPEM AN EXISTING WELL

PERMIT NUMBER OF WELL TO BE REPLACED OR DEEPEMED (IF AVAILABLE) 41 52

Not to be filled in by driller (MDE OR COUNTY USE ONLY)

APPROX. PERMIT NUMBER 54 GAP 63 PERMIT No. HO-94-1553 70 71 72 73 74 75 76 77 78 79


SHOW MAJOR FEATURES OF BOX & LOCATE WELL WITH AN X

- SOURCES OF DRILLING WATER 1. well 2. 3.

WRITE THE BOX NUMBER FROM THE MAP HERE


E 792 N 532

DRAW A SKETCH BELOW SHOWING LOCATION OF WELL IN RELATION TO NEARBY TOWNS AND ROADS AND GIVE DISTANCE FROM WELL TO NEAREST ROAD JUNCTION

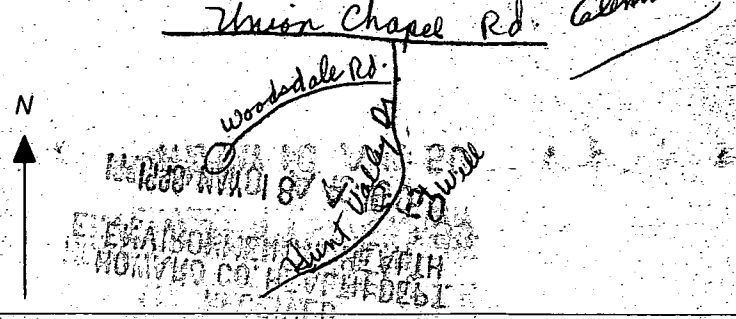

SPECIAL CONDITIONS

NOTE - APPROVING AUTHORITIES SHOULD USE SEPARATE SHEET IF NEEDED

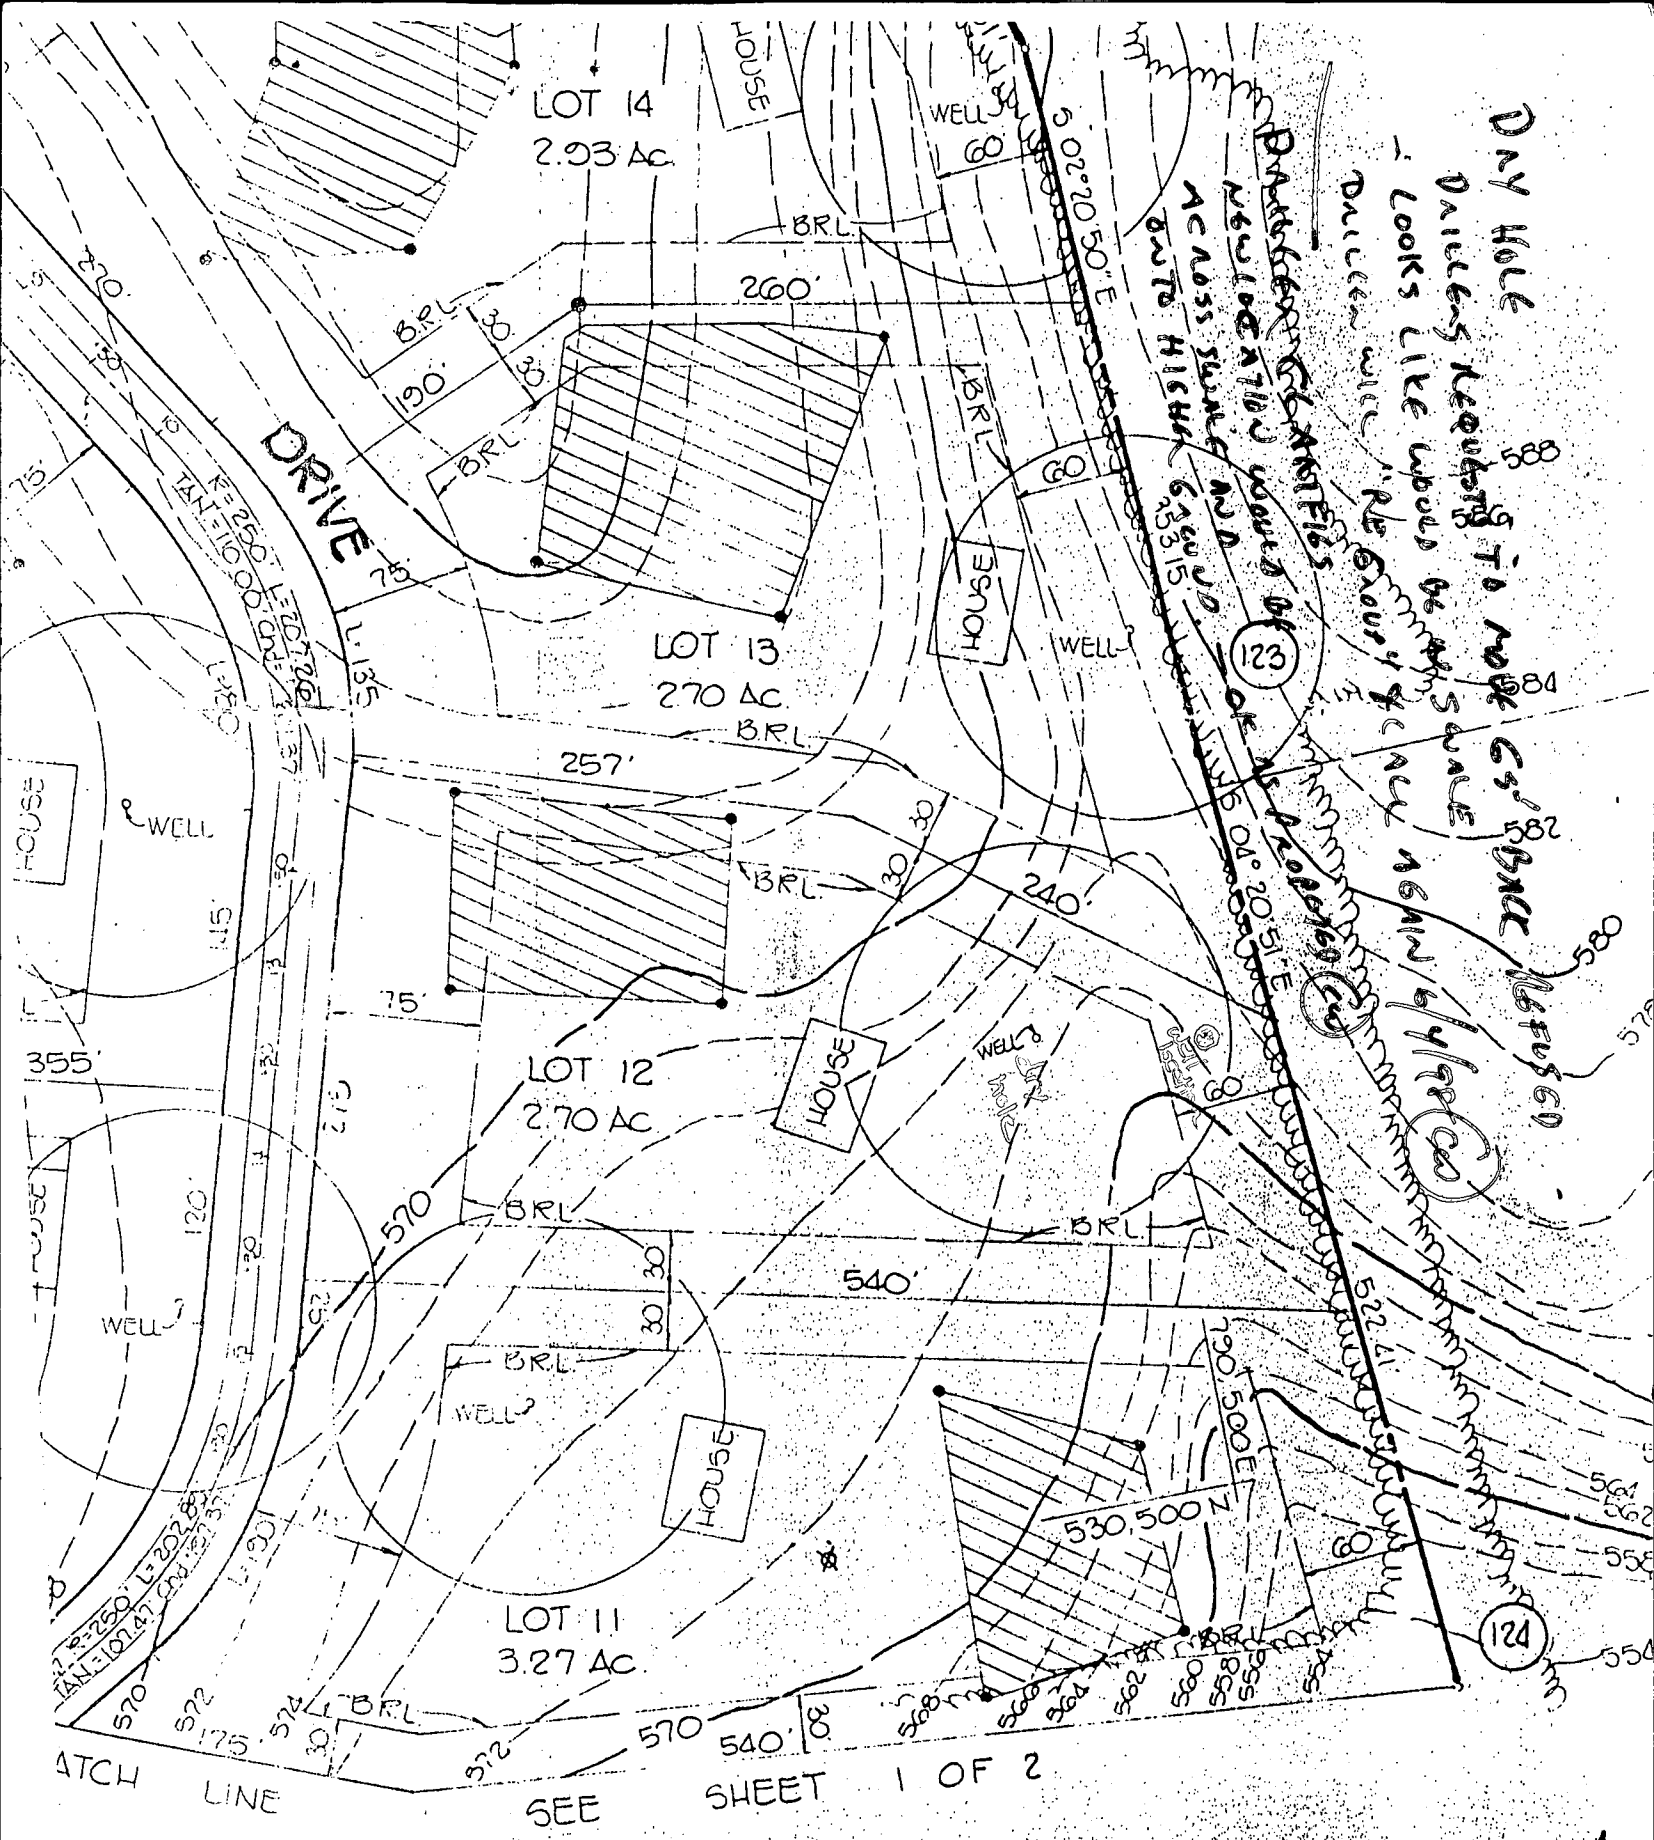

TRACY, SCHULTE & ASSOCIATES INC.
 planning • architecture • engineering

B00146164


2/11/04

Deck loc. ok

HUNT VALLEY DRIVE

30'x10'
STABILIZED
CONSTRUCTION
ENTRANCE

LIMITS OF
DISTURBED
AREA, TYP

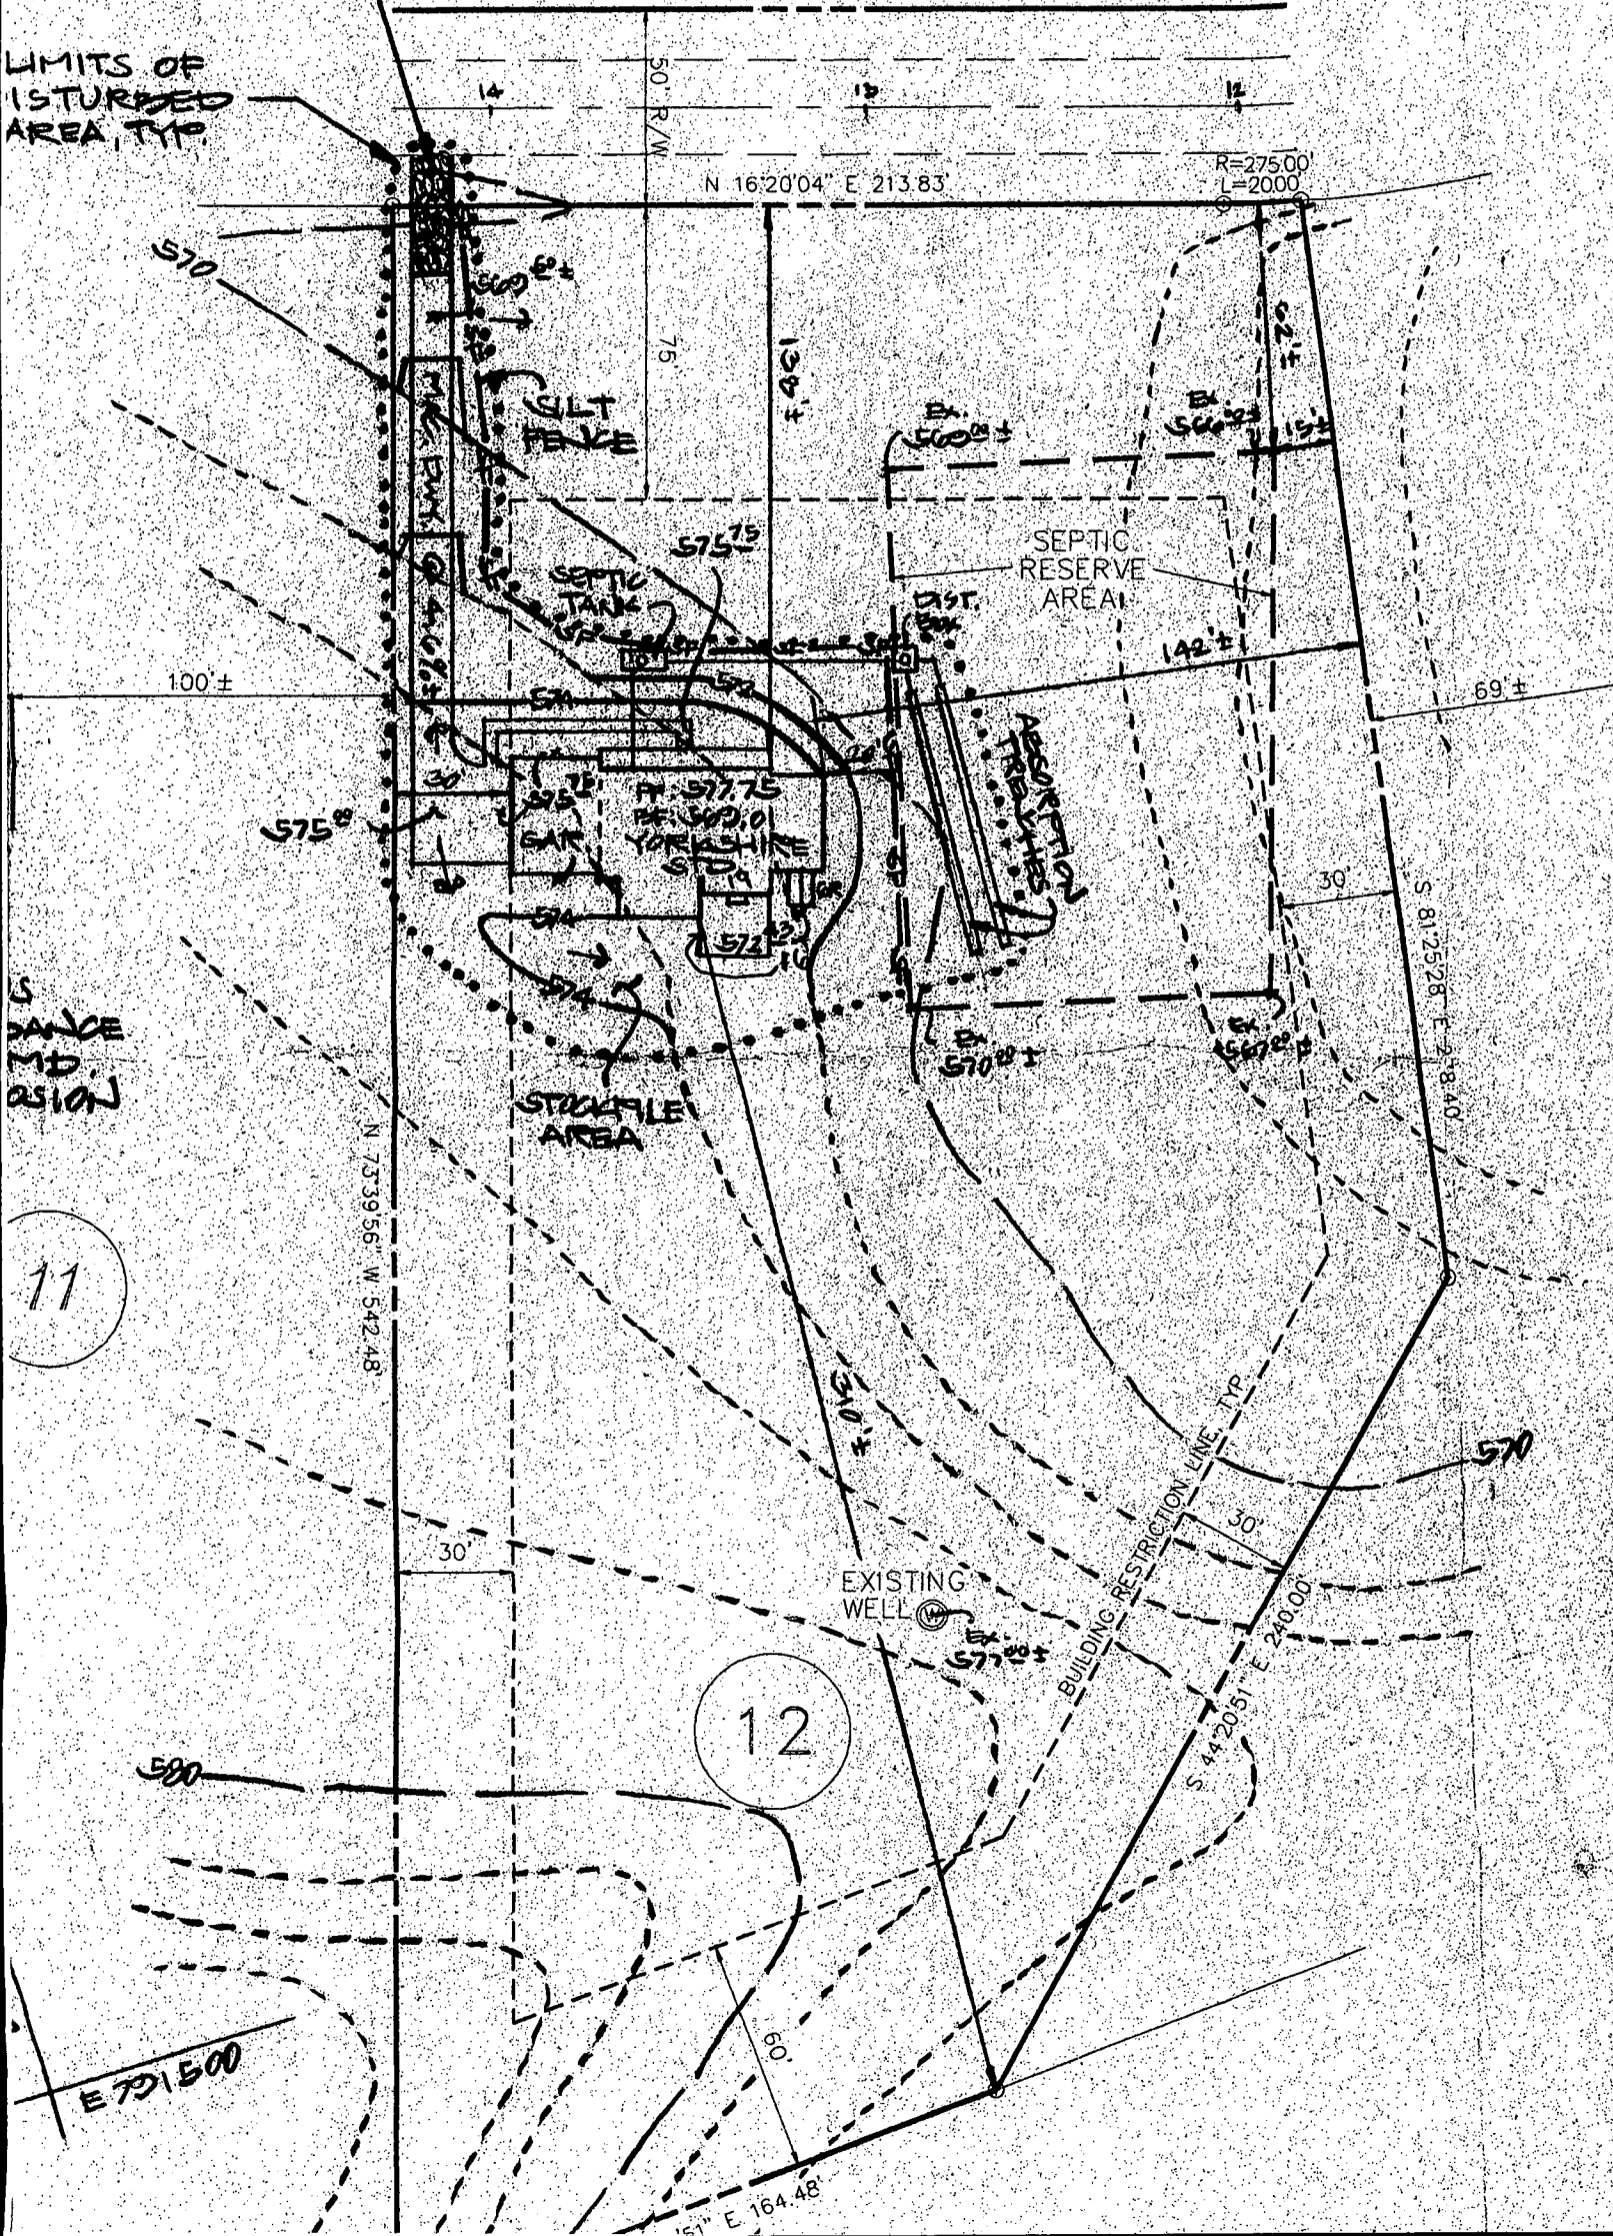

11

12

E 791.500