

3/26/93 3/29/93
3:00

Tax ID - 03-317420

PERMIT

SEWAGE DISPOSAL SYSTEM

DEPARTMENT OF HEALTH AND MENTAL HYGIENE

P 49085

A 42016

DISTRICT 3rd

DATE 3-25-93

HOWARD COUNTY HEALTH DEPARTMENT
BUREAU OF ENVIRONMENTAL HEALTH

~~XXXXXX~~ 313-2640

DATE SYSTEM APPROVED _____

INSPECTOR _____

INDEXED

Underground Construction IS PERMITTED TO INSTALL X ALTER _____

ADDRESS P. O. Box 1143, Sykesville, Maryland 21784 PHONE 410-775-0397

SUBDIVISION Coventry Meadows LOT 9 ROAD 1465 Coventry Meadows Drive

PROPERTY OWNER ~~Armour & Kathy Jenkins~~ KUFT HINDS

ADDRESS _____

SEPTIC TANK CAPACITY 1250 GALLONS

NUMBER OF BEDROOMS 4

210 SQUARE FEET PER BEDROOM

LINEAR FEET OF TRENCH REQUIRED 280

TRENCHES - Trench to be 3 feet wide. Inlet 3½ feet below original grade. Bottom maximum depth 5½ feet below original grade. Effective area begins at 3½ feet below original grade. 2 feet of stone below distribution pipe.

LOCATION - Place distribution box 200 feet from intersection of rear left (650.09') and front left (251.42') lot lines and 85 feet from rear left (650.09') lot line as viewed from Coventry Meadow Drive. Install trenches on contour toward right (653.78') lot line.

NOTES - No trench to exceed 100 feet in length. Provide 6" - 8" diameter cleanout and cap to grade or above on septic tank 4/6/93 RPI

PLANS APPROVED BY Ronald J. Pinkley DATE 11/25/92

COVER NO WORK UNTIL INSPECTED AND APPROVED

NEITHER THE HOWARD COUNTY COUNCIL NOR THE HEALTH DEPARTMENT IS RESPONSIBLE FOR THE SUCCESSFUL OPERATION OF ANY SYSTEM

NOTE: CLEANOUT REQUIRED EVERY 70 FEET OF SEWER LINE AND/OR AT 90° SWEEPS IN LINES FROM HOUSE TO DRAIN FIELDS, 90° ELBOWS NOT ACCEPTABLE.

NOTE: ALL PARTS OF SEPTIC SYSTEMS (I.E. TANK, DISTRIBUTION BOX TRENCHES) TO BE 100 FEET FROM WELL (UNLESS OTHERWISE SPECIFICALLY AUTHORIZED)

NOTE: IF DEEP TRENCH(ES) ARE USED CALL FOR INSPECTION BEFORE AND AFTER PLACING GRAVEL IN TRENCH(ES)

NOTE: NO DRY WELL SHALL EXCEED 15 FOOT IN DIAMETER NO ABSORPTION TRENCH TO EXCEED 100 FEET IN LENGTH

NOTE: ALL PIPE FROM HOUSE TO SEPTIC TANK MUST BE CAST IRON OR SCHEDULE 35/40 PVC OR ABS

PERMIT VOID AFTER TWO YEARS


NOTE: INSTALL STAND PIPE ON SEPTIC TANK AND DRY WELL STAND PIPES MUST BE 6 INCHES IN DIAMETER CAST IRON. CONCRETE OR TERRA COTTA OR PVA OR ABS ACCEPTED. IF TOP OF SEPTIC TANK IS DEEPER THAN 3 FEET. MANHOLE TO GRADE REQUIRED.

NOTE: DISTRIBUTION BOXES MUST HAVE BAFFLES

***INSTALLER IS RESPONSIBLE FOR OBTAINING FINAL APPROVAL ON THIS PERMIT**

PERMIT SIGNED
AND RETURNED 12/7/92

A
42016

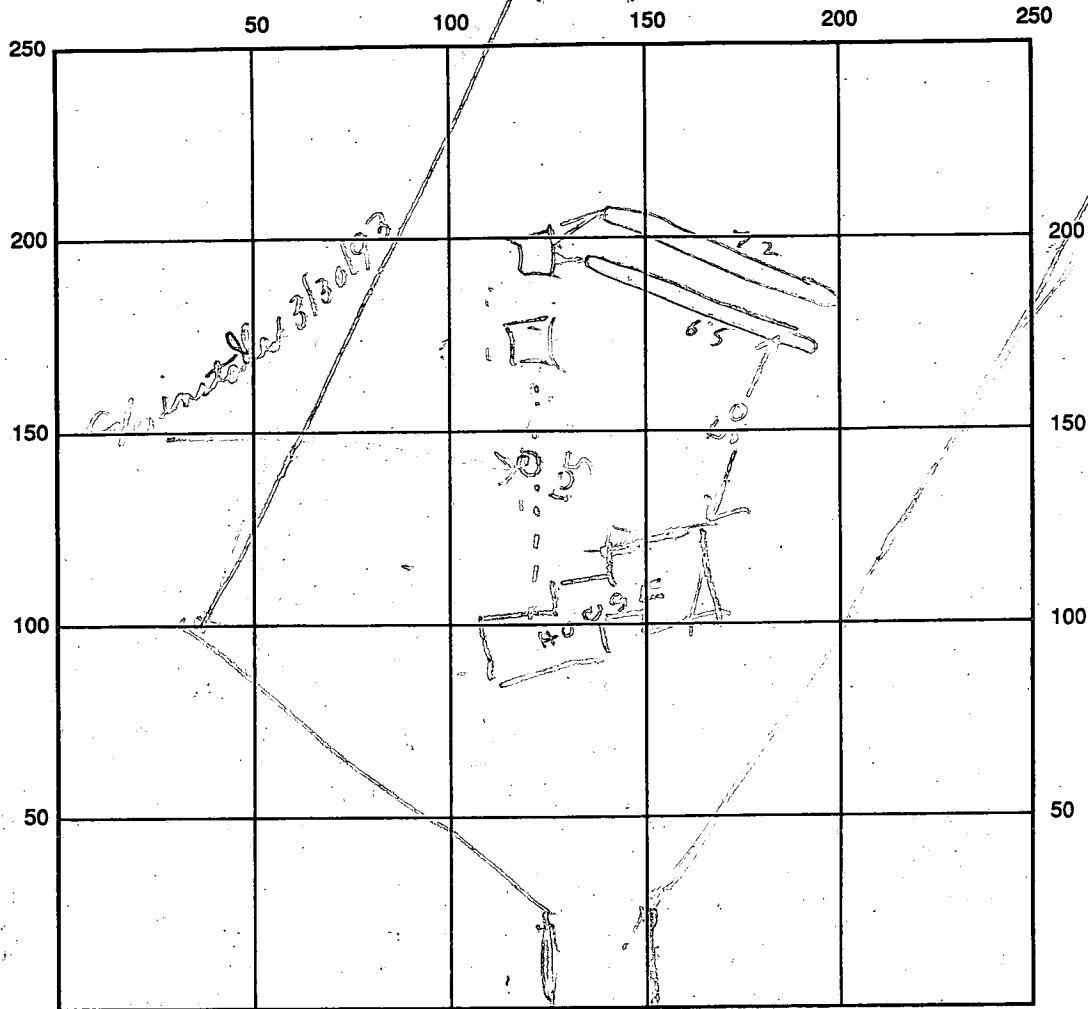


INDICATE NORTH - NAME ADJOINING ROADWAY AS BASE LINE

SEPTIC TANK LEVEL 2000 CLEANOUTS _____
 DISTRIBUTION BOX LEVEL 215
 DRAIN FIELD/TITLE DEPTH 5 FT. TRENCH WIDTH 3 FT. INLET DEPTH 3 FT.
 EFFECTIVE GRAVEL DEPTH _____ FT. TOTAL LENGTH 65/72 FT.
 NUMBER OF TRENCHES _____ ONE SIDEWALL/BOTTOM AREA _____ SQ. FT.
 DRYWALL INSIDE DIAMETER _____ FT. EFFECTIVE DEPTH BELOW INLET _____ FT.
 ABSORBENT AREA _____ SQ. FT.

REMARKS: 3/29/93 - TRENCH #1 & #2 DONE & MOST OF STONE ADDED
FINISH ALL 4 TRENCHES & COVER MIDDLES OF TRENCHES
HOOK UP TANK & BOXRN 3/30/93 - CLEANOUT INSTALLED
BETWEEN HOUSE & TANK EVERY THING COVERED EXCEPT TANK RN

DATE SYSTEM APPROVED _____ INSPECTOR _____

12/10/99 Final insp not made - file indexed - system not approved
SL

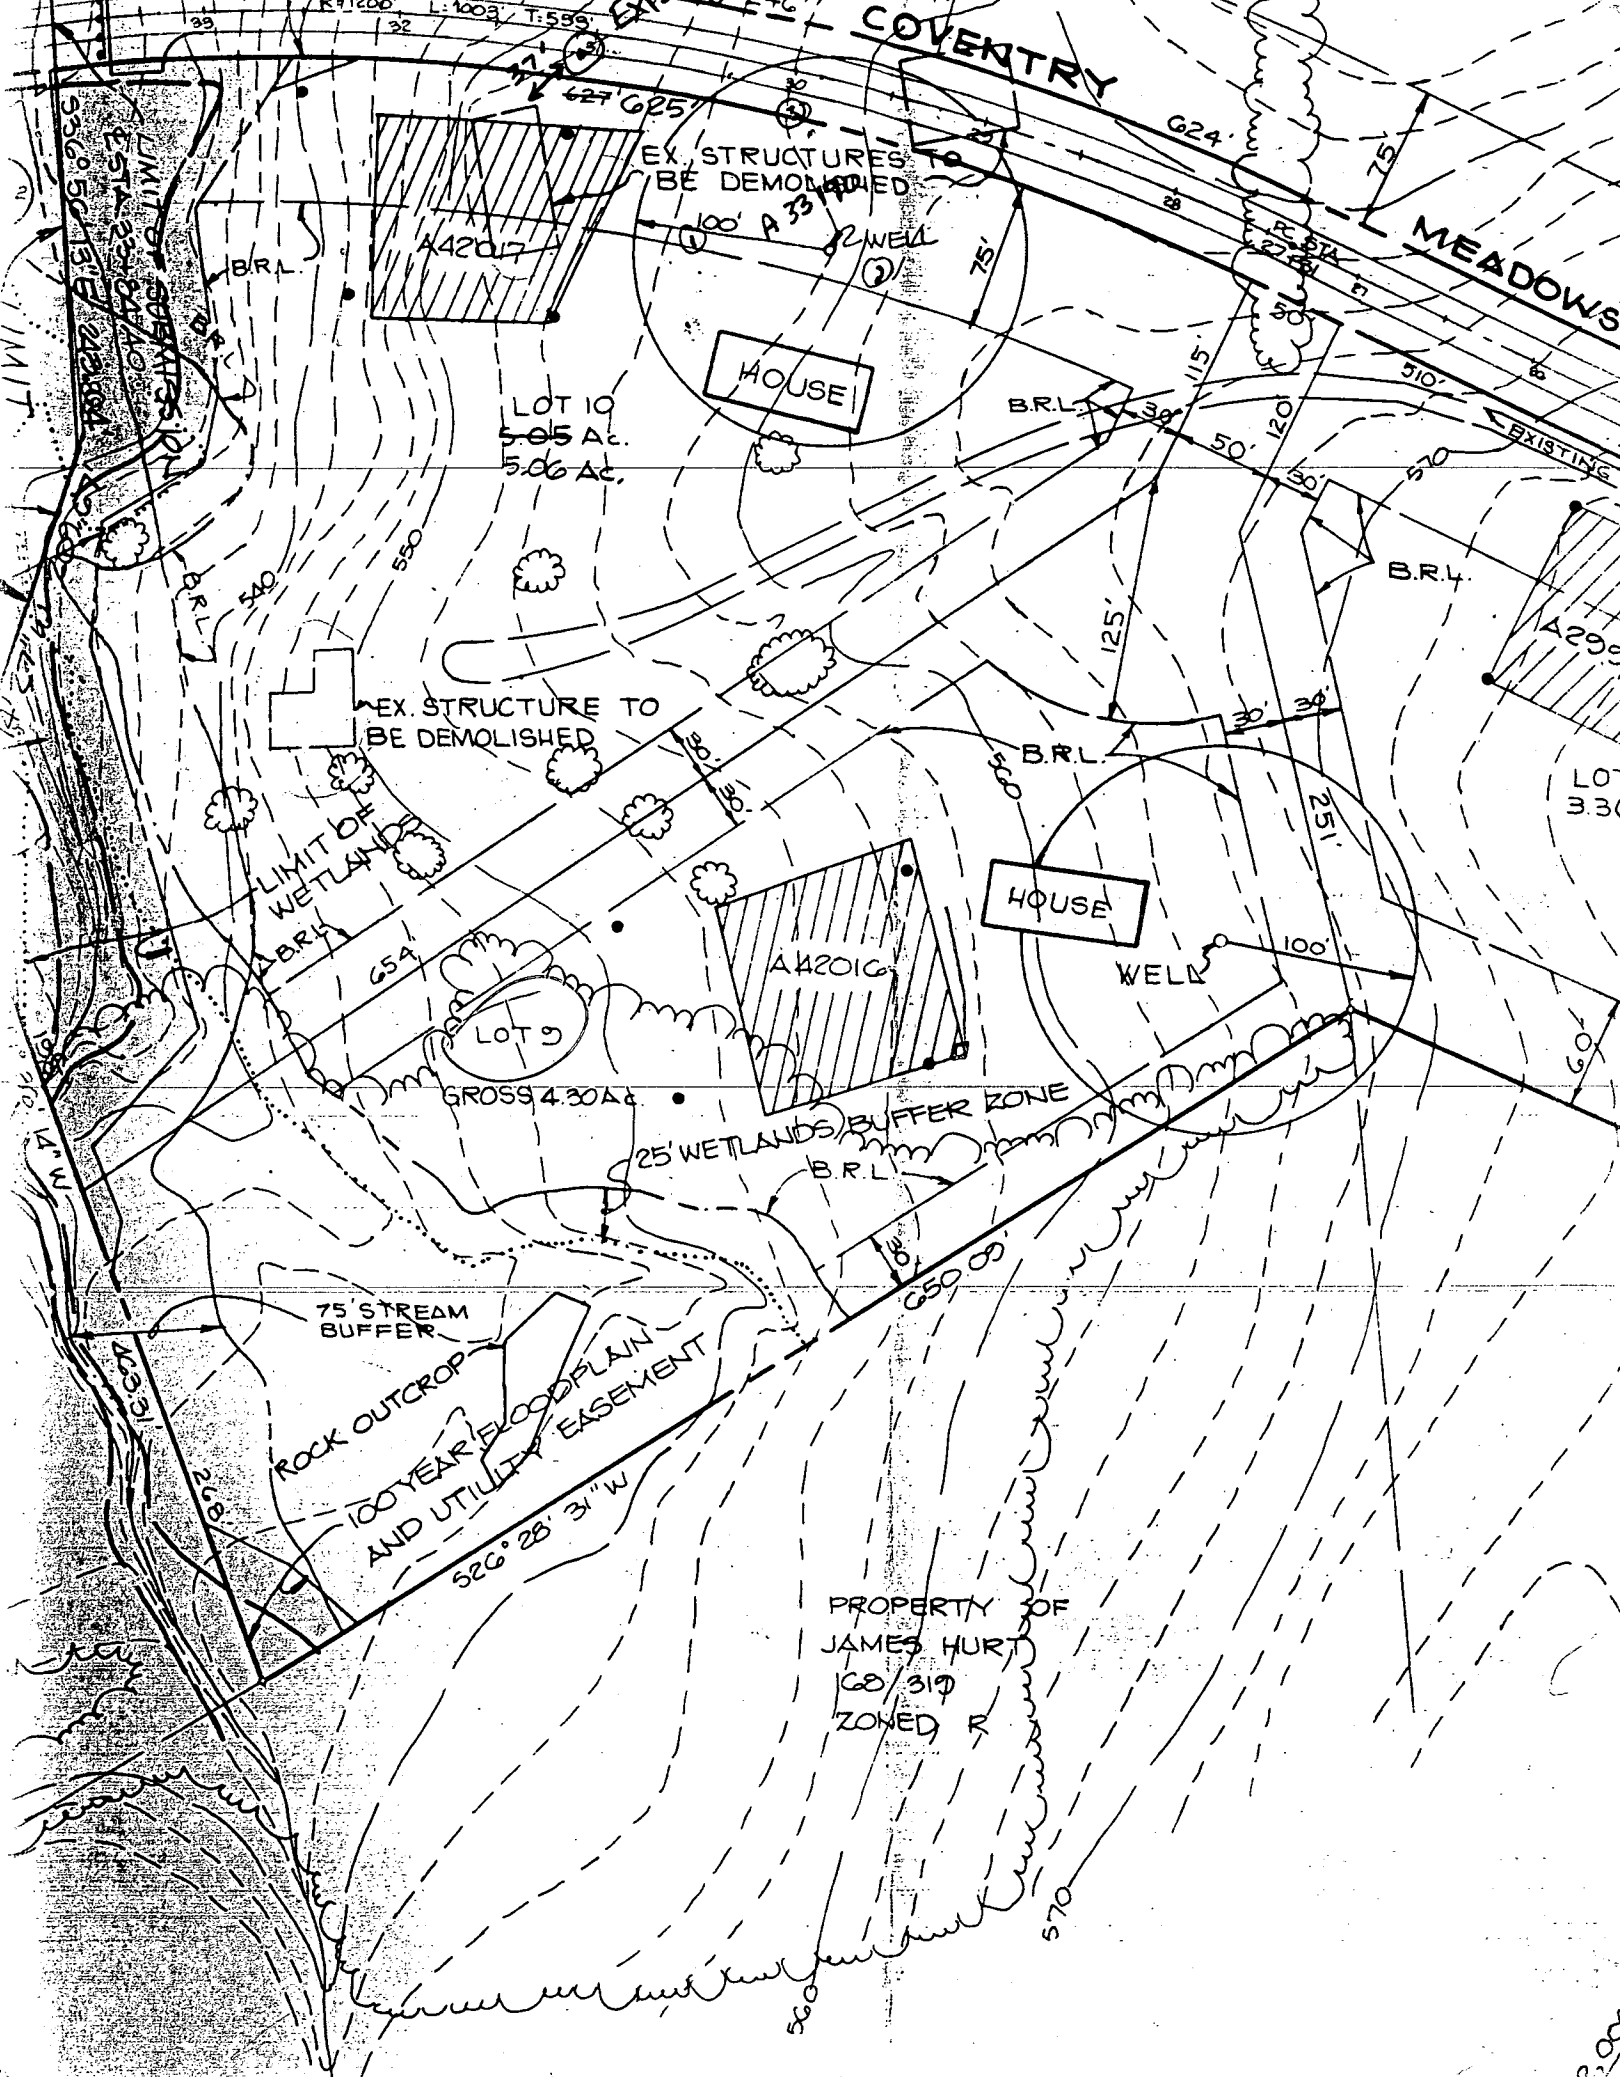

COVENTRY

MEADOWS

EX. STRUCTURES TO BE DEMOLISHED

HOUSE

EX. STRUCTURE TO BE DEMOLISHED

HOUSE

LOT 9

LOT 10
5.05 AC.
5.06 AC.

A42016


GROSS 4.30 AC.

PROPERTY OF
JAMES HURT
68/319
ZONED R

75' STREAM BUFFER

ROCK OUTCROP
100' YEAR FLOODPLAIN
AND UTILITY EASEMENT
526° 28' 31" W

25' WETLANDS BUFFER ZONE

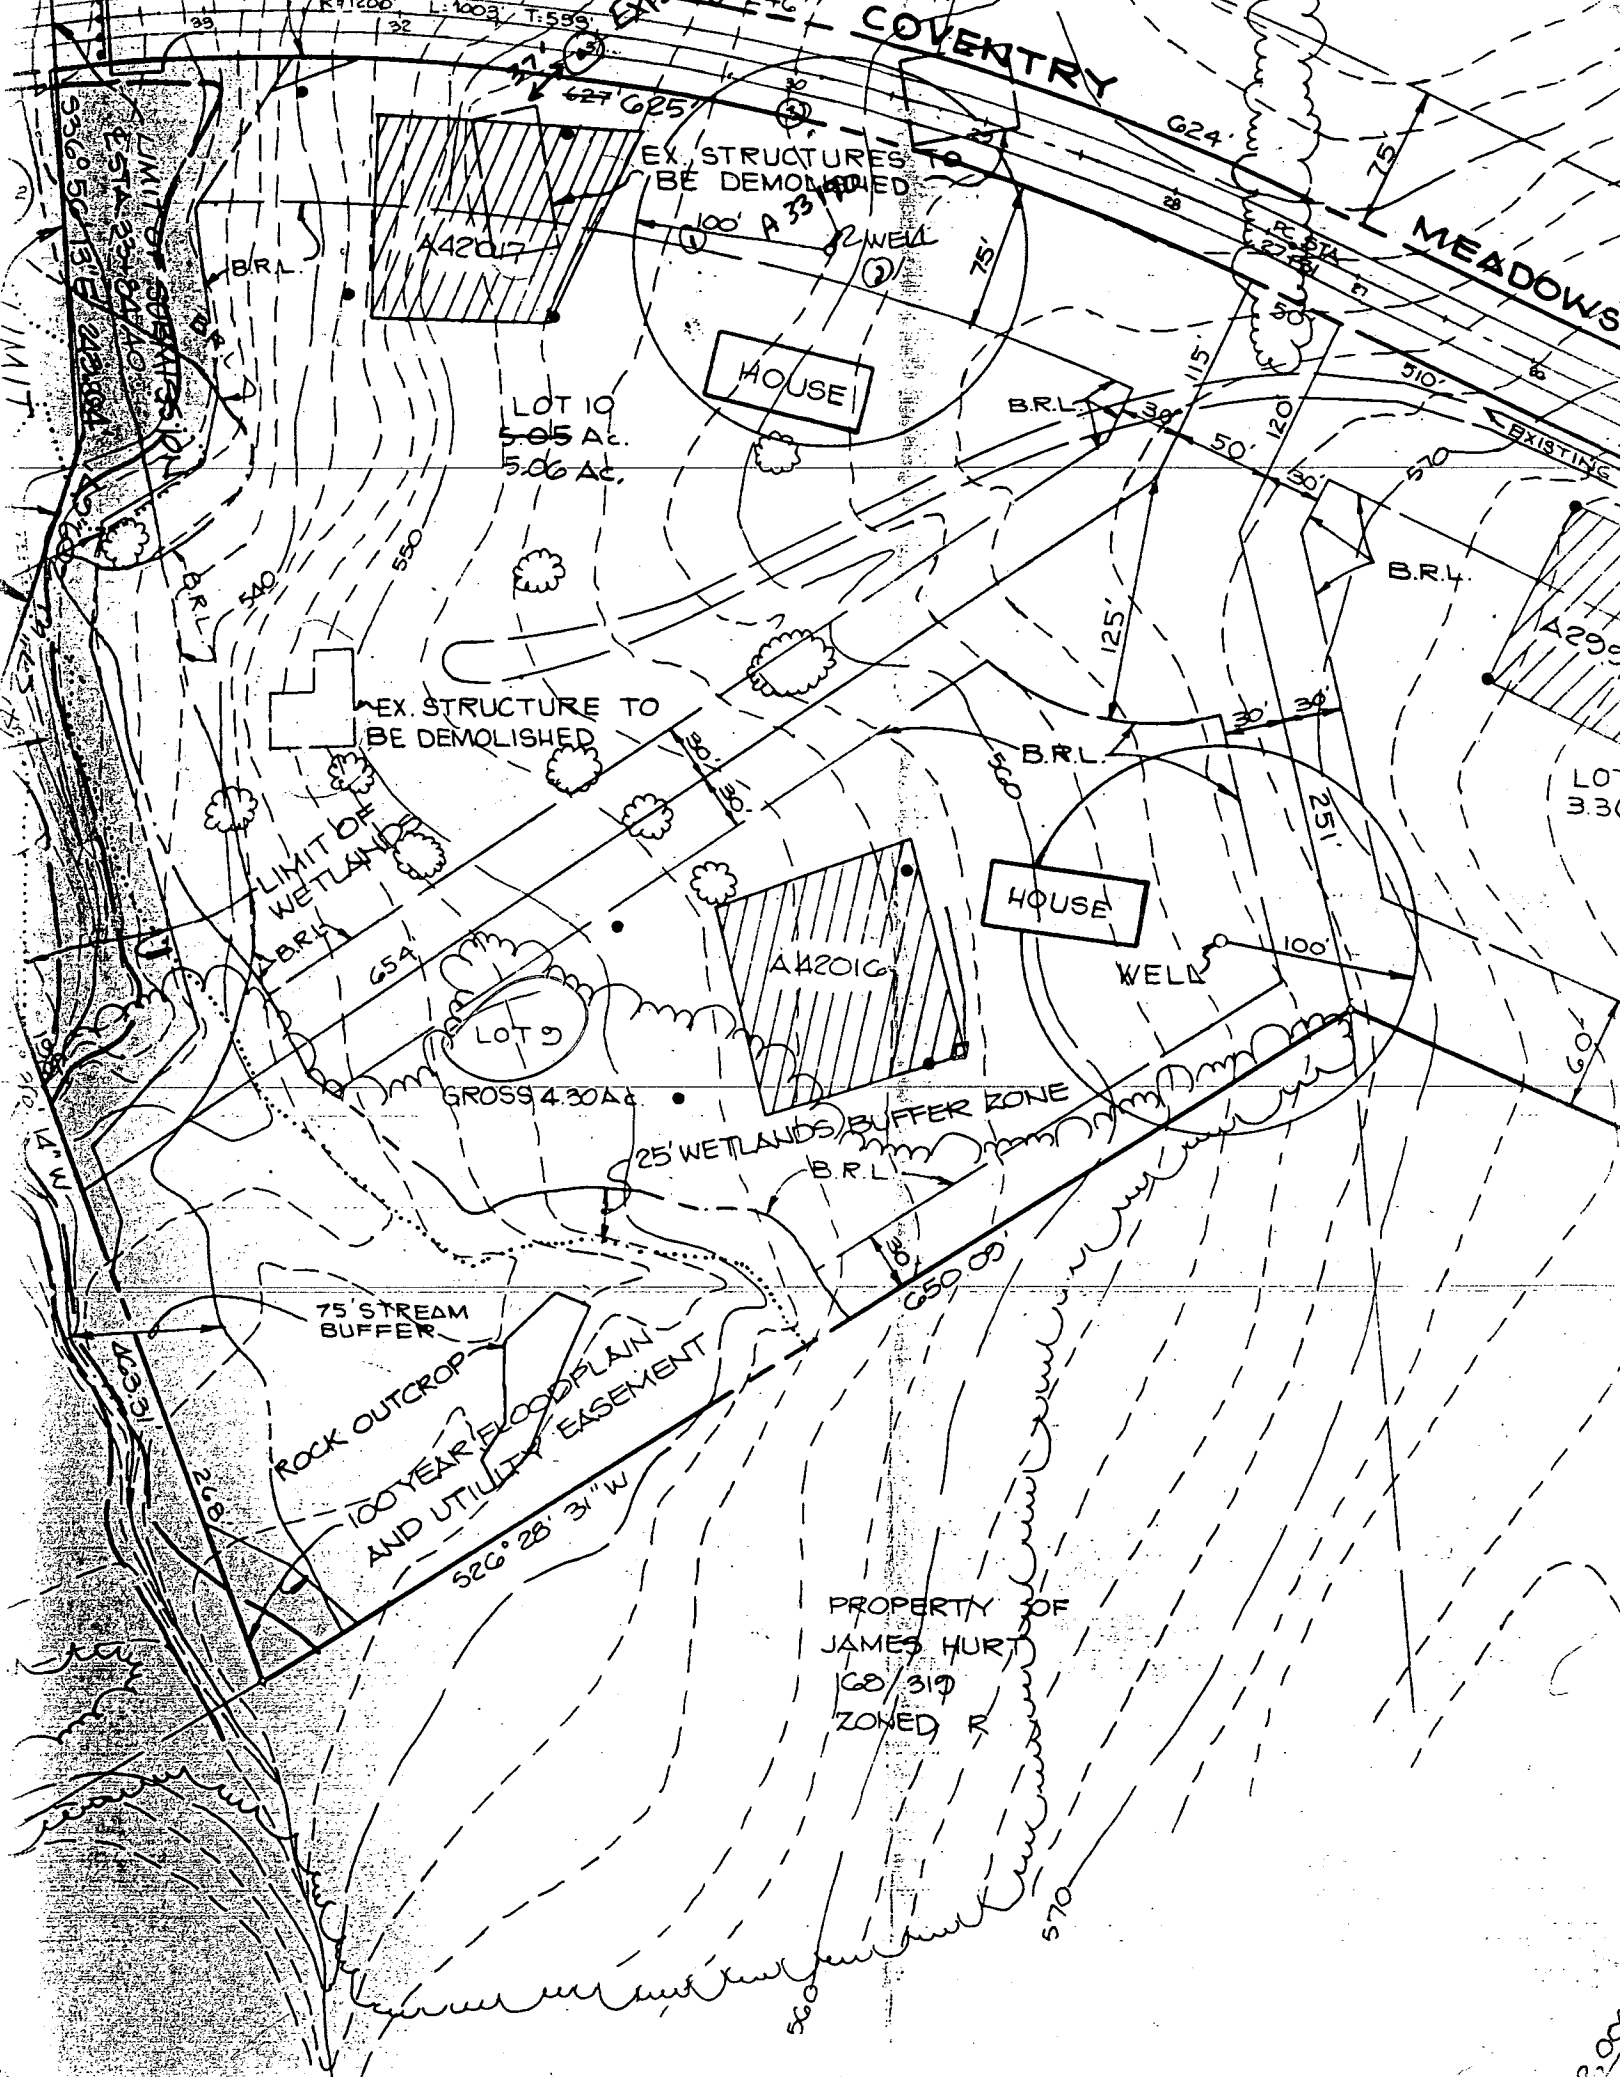

C1 6659 SEQUENCE NO. (DENV USE ONLY)

STATE OF MARYLAND WELL COMPLETION REPORT

THIS REPORT MUST BE SUBMITTED WITHIN 45 DAYS AFTER WELL IS COMPLETED.

(THIS NUMBER IS TO BE PUNCHED IN COLS. 3-6 ON ALL CARDS)

COUNTY NUMBER A42016

DATE RECEIVED

DATE WELL COMPLETED 112392

DEPTH OF WELL 400 (TO NEAREST FOOT)

PERMIT NO. FROM "PERMIT TO DRILL WELL" HD-92-0244

OWNER Jenkins last name, William first name, STREET OR RFD, SUBDIVISION COVENTRY MEADOWS SECTION, LOT 9

WELL LOG table with columns: DESCRIPTION, FEET (FROM, TO), Check if water bearing. Includes entries for Overburden, Mud & Boulders, and Gray Rock.

GROUTING RECORD: WELL HAS BEEN GROUTED (Y), TYPE OF GROUTING MATERIAL: CEMENT CM, BENTONITE CLAY BC, NO. OF BAGS 18, NO. OF POUNDS 1800.

CASING RECORD: casing types insert appropriate code below. Codes: ST (STEEL), CO (CONCRETE), PL (PLASTIC), OT (OTHER).

MAIN CASING TYPE: ST, Nominal diameter top (main) casing 6 inches, Total depth of main casing 100 feet.

OTHER CASING (if used) diameter inch, depth (feet) from to.

SCREEN RECORD: screen type or open hole insert appropriate code below. Codes: ST (STEEL), BR (BRASS), HO (OPEN HOLE), PL (PLASTIC), OT (OTHER).

DEPTH (nearest ft.) table with rows for each screen and columns for depth. Includes slot size and diameter of screen information.

CIRCLE APPROPRIATE LETTER: A (WELL ABANDONED AND SEALED), E (ELECTRIC LOG OBTAINED), P (TEST WELL CONVERTED TO PRODUCTION WELL).

I HEREBY CERTIFY THAT THIS WELL HAS BEEN CONSTRUCTED IN ACCORDANCE WITH COMAR 26.04.04 "WELL CONSTRUCTION" AND IN CONFORMANCE WITH ALL CONDITIONS STATED IN THE ABOVE CAPTIONED PERMIT...

DRILLERS IDENT. NO. 309, DRILLERS SIGNATURE (Robert Price)

SITE SUPERVISOR (sign. of driller or journeyman responsible for sitework if different from permittee)

GRAVEL PACK IF WELL DRILLED WAS FLOWING WELL INSERT F IN BOX 68

OEP USE ONLY (NOT TO BE FILLED IN BY DRILLER): T (E.R.O.S.), W Q (74, 75, 76), TELESCOPE CASING, LOG INDICATOR, OTHER DATA.

PUMPING TEST: HOURS PUMPED 4, PUMPING RATE 3 gal. per min., METHOD USED TO MEASURE PUMPING RATE Submersible, WATER LEVEL BEFORE PUMPING 2.4, WHEN PUMPING 3.53, TYPE OF PUMP USED (for test) S (submersible).

PUMP INSTALLED: DRILLER WILL INSTALL PUMP YES (NO), TYPE OF PUMP INSTALLED S, CAPACITY: GALLONS PER MINUTE, PUMP HORSE POWER, PUMP COLUMN LENGTH, CASING HEIGHT (circle appropriate box and enter casing height).

LOCATION OF WELL ON LOT: SHOW PERMANENT STRUCTURE SUCH AS BUILDING, SEPTIC TANKS, AND/OR LANDMARKS AND INDICATE NOT LESS THAN TWO DISTANCES (MEASUREMENTS TO WELL). N/A

92 NOV 23 PM 12:42

B 1 **02232** SEQUENCE NO. (DP USE ONLY)
 (THIS NUMBER IS TO BE PUNCHED IN COLS. 3-6 ON ALL CARDS)


STATE OF MARYLAND
 APPLICATION FOR PERMIT TO DRILL WELL
 please print or type

STATE PERMIT NUMBER
HO-92-0244
 fill in this form completely

Date Received (APA) **102892**
102892 OWNER INFORMATION
Jenkins William A
 Last Name Owner First Name
13 Dutton Avenue
 Street or RFD
Baltimore MD 21228
 Town State Zip

B 3 LOCATION OF WELL
Howard COUNTY
Coventry Meadows SUBDIVISION
 SECTION **9** LOT **9**
West Friendship NEAREST TOWN
 MILES FROM TOWN (enter 0 if in town) **2 MI**

DRILLER INFORMATION
Paul M. Fabiszak Driller's Name License No. **399**
G. Edgar Harr Sons' corp. Firm Name
12047 Fall Rd Cockeysville 21030 Address
10-27-92 Date
 Signature

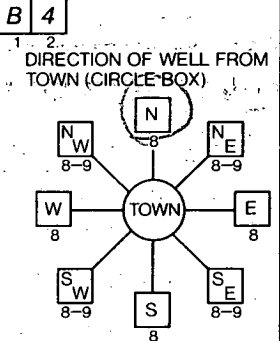

Coventry Meadows Dr NEAR WHAT ROAD
 ON WHICH SIDE OF ROAD (CIRCLE APPROPRIATE BOX)
 NORTH
 WEST EAST
 SOUTH
200 DISTANCE FROM ROAD
 ENTER FT or MI **FT**

B 2 WELL INFORMATION
 APPROX. PUMPING RATE (GAL. PER MIN.) **5**
 AVERAGE DAILY QUANTITY NEEDED (GAL. PER DAY) **750**

USE FOR WATER (CIRCLE APPROPRIATE BOX)
 HOME (SINGLE OR DOUBLE HOUSEHOLD UNIT ONLY)
 FARMING (LIVESTOCK WATERING & AGRICULTURAL IRRIGATION)
 INDUSTRIAL, COMMERCIAL, STATE AND FEDERAL GOV. OTHER (REQUIRES APPROPRIATION PERMIT)
 PUBLIC OR PRIVATE WATER COMPANY (REQUIRES APPROPRIATION PERMIT AND STATE HEALTH DEPARTMENT APPROVAL)
 TEST, OBSERVATION, MONITORING (MAY REQUIRE APPROPRIATION PERMIT)

NOT TO BE FILLED IN BY DRILLER HEALTH DEPARTMENT APPROVAL
Howard COUNTY NAME
A42016 COUNTY NO.
 STATE SIGNATURE _____ INSERT S
 DATE ISSUED **111692** Mark E. Reffin **5/16/93**
 NORTH GRID **546000** EAST GRID **0811000**


APPROXIMATE DEPTH OF WELL **200** FEET

APPROXIMATE DIAMETER OF WELL **6** INCH NEAREST

METHOD OF DRILLING (circle one)
 BORED (or Augered) JETTED Jetted & DRIVEN
 AIR-ROTary AIR-PERcussion ROTARY (Hydraulic Rotary)
 CABLE REVerse-ROTary Drive-POINT
 other _____

SHOW MAJOR FEATURES OF BOX & LOCATE WELL WITH AN X
 SOURCES OF DRILLING WATER
 1. _____
 2. _____
 3. _____
 WRITE THE BOX NUMBER FROM THE MAP HERE
 E **8181**
 N **5406** ← 000 (X)
 000

REPLACEMENT OR DEEPEMED WELLS (CIRCLE APPROPRIATE BOX)
 THIS WELL WILL NOT REPLACE AN EXISTING WELL
 THIS WELL WILL REPLACE A WELL THAT WILL BE ABANDONED AND SEALED
 THIS WELL WILL REPLACE A WELL THAT WILL BE USED AS A STANDBY
 THIS WELL WILL DEEPEM AN EXISTING WELL
 PERMIT NUMBER OF WELL TO BE REPLACED OR DEEPEMED (IF AVAILABLE) _____

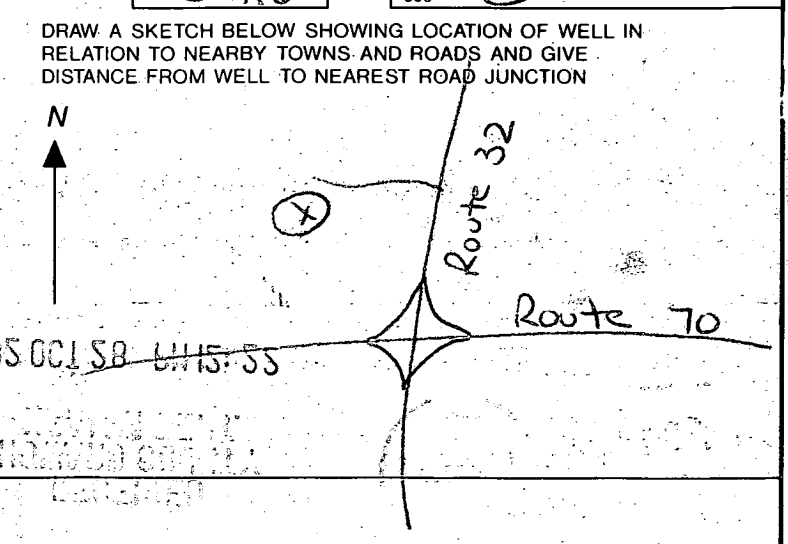

Not to be filled in by driller (OEP USE ONLY)
 APPROX. PERMIT NUMBER _____

FORCE **MR** WRITE INITIALS IN BOX PERMIT No. **HO-92-0244**

SPECIAL CONDITIONS **788-8899**

APPLICATION

42016
~~4888~~

PERCOLATION TESTING

A _____
P _____

HOWARD COUNTY HEALTH DEPARTMENT
BUREAU OF ENVIRONMENTAL HEALTH
P.O. BOX 476 ELLICOTT CITY, MARYLAND 21043
TELEPHONE: 461-9933

DISTRICT 3rd
DATE 6/20/88
3/10/88

*Check is in
CALL PAM Reimer Group
when sched. 461-2690*

TO: THE COUNTY HEALTH OFFICER
ELLICOTT CITY, MARYLAND

I, HEREBY, APPLY FOR THE NECESSARY TEST IN ORDER TO CONSTRUCT (OR RECONSTRUCT) A SEWAGE DISPOSAL SYSTEM.

PROPERTY OWNER ~~THE DICKEY FAMILY~~ Armour + Kathy JENKINS

c/o WALTER JOHNSON
ADDRESS PRUDENTIAL-BACHE SECURITIES PHONE c/o 788-8899
250 W. PRATT STREET BALTIMORE, MARYLAND 21201 301-465-5855

PROSPECTIVE BUYER _____

ADDRESS _____ PHONE _____

PROPERTY LOCATION:

SUBDIVISION COVENTRY MEADOWS LOT NO. # LOT 9 Preliminary

ROAD AND DESCRIPTION NORTH OF MD ROUTE 99, WEST OF MD. RTE. 32
(1465 Coventry Meadows Drive)

TAX MAP 9 PARCEL # 71

SIZE OF LOT 4.6 AC. TYPE BLDG. SFD
(SINGLE FAMILY DWELLING OR COMMERCIAL)

THE SYSTEM INSTALLED UNDER THIS APPLICATION IS ACCEPTABLE ONLY UNTIL PUBLIC FACILITIES BECOME AVAILABLE. I FULLY UNDERSTAND THE FEE CONNECTED WITH THE FILING OF THIS PERC TEST APPLICATION IS NON-REFUNDABLE UNDER ANY CIRCUMSTANCES. I ALSO AGREE TO COMPLY WITH ALL M.O.S.H.A. REQUIREMENTS IN TESTING THIS LOT. Christine A. Richards
(SIGNATURE OF APPLICANT)

APPROVED BY _____ FOR _____ DATE _____

REJECTED BY _____ FOR _____ DATE _____

HOLD PENDING FURTHER TESTS _____ DATE _____

REASONS FOR REJECTION OR HOLDING 9-20-88 Per Satisfactory - Hold for final sale

BLDG. PERMIT SIGNED
AND RETURNED 12/7/92
Serial # 46269-SFD

THIS IS NOT A PERMIT

A 42016

LOT 9


D C
SOIL PROFILE

0
4'
4'
12'

AP 1H
Yellow Br
Silt CLAY
LOAM
100% Fines

4E11. Br
Silt LOAM
<10%
Fines

Hole A+C
QUARTZITE
AT 3-5'

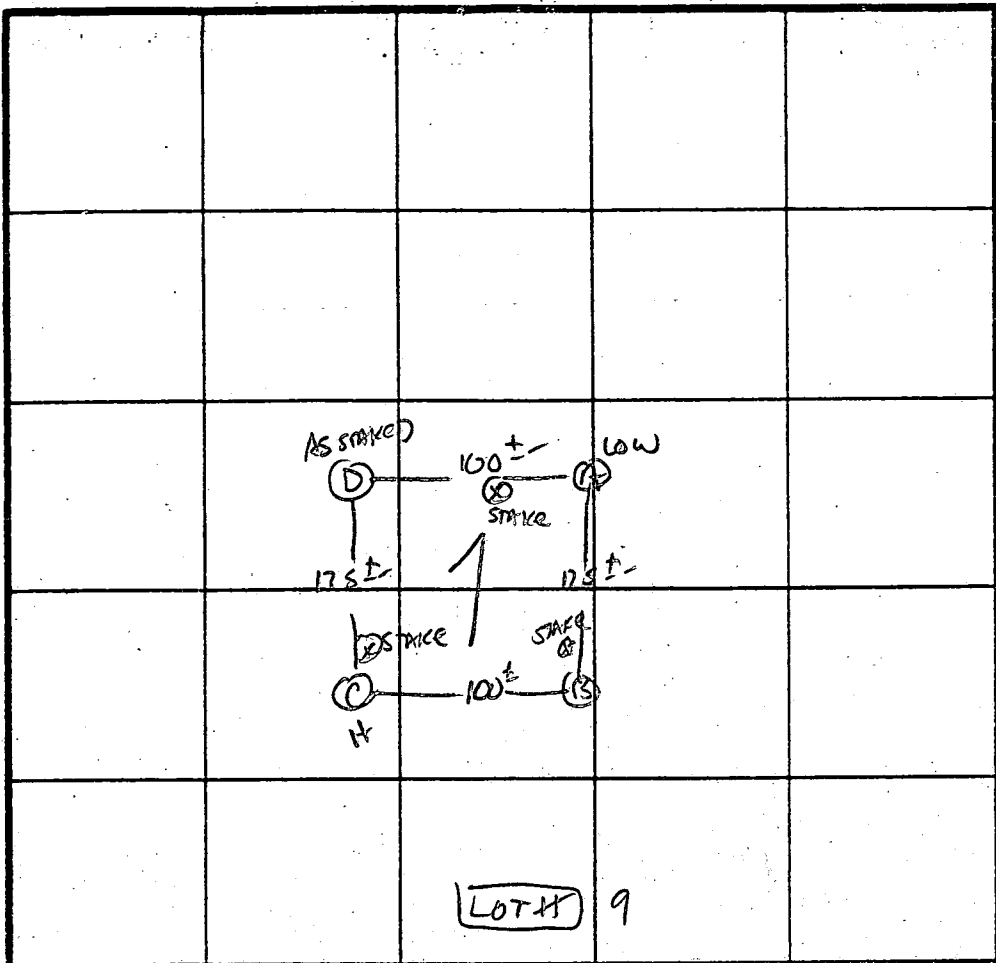

2 Perc min
2.10 φ/BA
Inlet 4
Bottom 8

INDICATE NORTH - NAME ADJOINING ROADWAY AS BASE LINE.
↓ TO Rt 32

DATE	TEST NO.	DEPTH	PRE-WET		TEST - 1" DROP		TIME
			START	STOP	START	STOP	
9/20/68	A S A V	5.0' 12'	12:37	12:41	12:41	12:51	10 MIN
	B S B M	4.5 8.0	12:57	1:00	1:00	1:09	9 MIN
			12:56	1:01	1:01	1:08	7 MIN
	B V	12'	UNIFORM below 3.5'		SIMILAR TO D		
	D S D V	5' 12'	12:34	12:35	12:35	12:38	3 MIN
	C V	12'	UNIFORM soil below 4.0'		SIMILAR TO A		

REMARKS Holes slightly DIFFERENT PLAT

TYPE OF SOIL Chesteric loam -> Gravelly loam

TESTED BY S. Abel ALSO PRESENT O.K.

EH-12-1079

LOT 13
3.012 acres

20' USE-IN-COMMON
ACCESS ESM'T FOR
LOTS 11 & 12
L. 7203, F. 164

SDA →

LOT 8

PROPERTY OF
MILLARD W. STEDDING
L. 238, F. 444

PROPERTY OF
JAMES HURT
L. 168, F. 319

PROPERTY OF
N. R. DICKEY
L. 1773, F. 47

PROPERTY OF

