

APPLICATION

A 21197

P _____

SEWAGE DISPOSAL TESTING

STATE OF MARYLAND - DEPARTMENT OF HEALTH AND MENTAL HYGIENE

HOWARD COUNTY HEALTH DEPARTMENT
ENVIRONMENTAL HEALTH SERVICES
P. O. BOX 476, ELLICOTT CITY, MARYLAND 21043
TELEPHONE: 465-5000, EXT. 356

DISTRICT 4

DATE 3/10/75

TO: THE COUNTY HEALTH OFFICER
ELLICOTT CITY, MARYLAND

I, HEREBY, APPLY FOR THE NECESSARY TEST IN ORDER TO CONSTRUCT (OR RECONSTRUCT) A SEWAGE DISPOSAL SYSTEM.

PROPERTY OWNER Estate of Georgia Ungar

ADDRESS _____ PHONE Any questions call:
Mr. Ed. Kasemeyer
442-2297

PROPERTY LOCATION:

SUBDIVISION _____ LOT NO. _____

ROAD AND DESCRIPTION Corner of Carr's Mill Road & Bushy Park Road

SIZE OF LOT 18,474 acres TYPE BLDG. 3 or 4

IF NOT SINGLE RESIDENCE DESCRIBE _____
NUMBER OF BEDROOMS
(Single Family Dwllg.)

THE SYSTEM INSTALLED UNDER THIS APPLICATION IS ACCEPTABLE ONLY UNTIL PUBLIC FACILITIES BECOME AVAILABLE.

SIGNATURE OF APPLICANT /s/ Ed. Kasemeyer

APPROVED BY _____ FOR _____ DATE _____
(KIND OF SYSTEM)



REJECTED BY _____ FOR _____ DATE _____
(KIND OF SYSTEM)

HOLD PENDING FURTHER TESTS _____ DATE _____

REASONS FOR REJECTION OR HOLDING _____

THIS IS NOT A PERMIT

A 21197

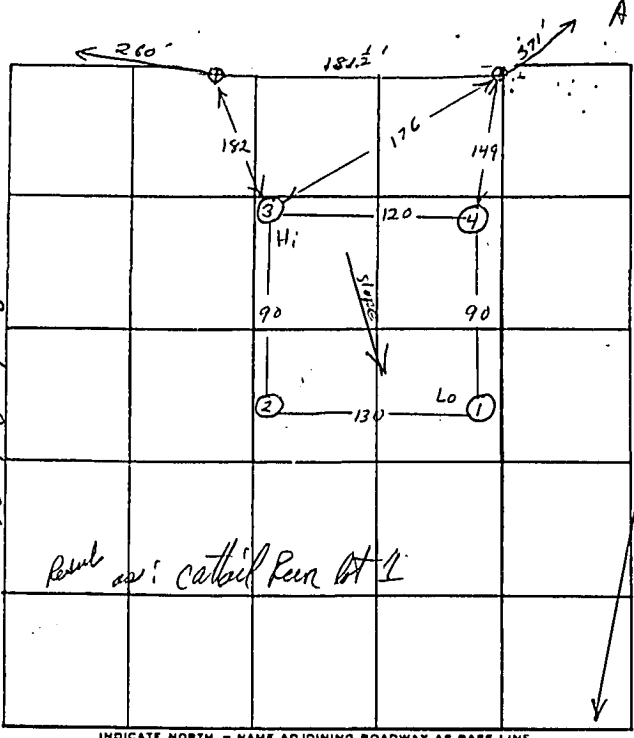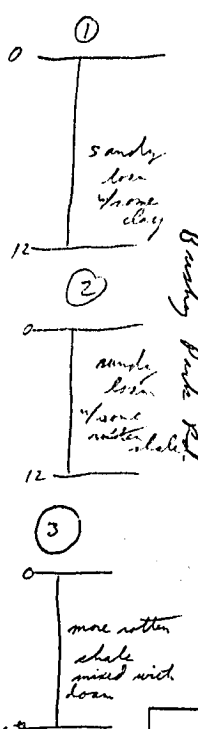

INDICATE NORTH. - NAME ADJOINING ROADWAY AS BASE LINE
Carris Mill Rd.

| DATE | TEST NO. | DEPTH | PRE-WET | | TEST - 1" DROP | | TIME |
|------|----------|-------|------------------|------------------|------------------|------------------|------|
| | | | START | STOP | START | STOP | |
| 3/18 | 1 | 5 | 10 ¹⁰ | 10 ¹⁴ | 10 ¹⁴ | 10 ²⁸ | 14 |
| | 1A | 12 | 10 ¹² | 10 ¹² | 10 ¹⁴ | 10 ²⁸ | 11 |
| | 2 | 4 | 10 ¹⁵ | 10 ¹⁷ | 10 ¹⁷ | 10 ²¹ | 4 |
| | 2A | 12 | 10 ¹⁸ | 10 ²¹ | 10 ²¹ | 10 ²⁵ | 4 |
| | 3 | 4 | 10 ²⁵ | 10 ³⁰ | 10 ³⁰ | 10 ³⁷ | 7 |
| | 3A | 12 | 10 ²⁴ | 10 ³¹ | 10 ³¹ | 10 ³⁵ | 4 |
| | 4 | 12 | vis | 501.C | no | no | 1 |
| | | | | | | | |
| | | | | | | | |
| | | | | | | | |

REMARKS _____
 TYPE OF SOIL _____
 TESTED BY R.M., H/2 ALSO PRESENT: Benth