

APPLICATION

PERCOLATION TESTING

HOWARD COUNTY HEALTH DEPARTMENT
BUREAU OF ENVIRONMENTAL HEALTH
P.O. BOX 476 ELLICOTT CITY, MARYLAND 21043
TELEPHONE: 461-9933

A 39214

P _____

DISTRICT 4th

DATE 4-2-87

TO: THE COUNTY HEALTH OFFICER
ELLICOTT CITY, MARYLAND

I, HEREBY, APPLY FOR THE NECESSARY TEST IN ORDER TO CONSTRUCT (OR RECONSTRUCT) A SEWAGE DISPOSAL SYSTEM.

PROPERTY OWNER DONALD RIPPEON Timothy & Lisa Smith

ADDRESS 15474 BUSHY PARK RD PHONE _____

PROSPECTIVE BUYER UNITED GENERAL CONTRACTORS

ADDRESS 8370 COURT AVE, ELLICOTT CITY PHONE 461-2227 ✓

PROPERTY LOCATION: Brant Group Fall Church Va

SUBDIVISION RIPPEON PROPERTY LOT NO. 703641 19400

ROAD AND DESCRIPTION CORNER OF CARR'S MILL & BUSHY PARK ROAD, WOODINE,

HOWARD COUNTY

TAX MAP 14 & 8 PARCEL # 9 & 12

SIZE OF LOT @ 3 acre lot TYPE BLDG. SFD
(SINGLE FAMILY DWELLING OR COMMERCIAL)

THE SYSTEM INSTALLED UNDER THIS APPLICATION IS ACCEPTABLE ONLY UNTIL PUBLIC FACILITIES BECOME AVAILABLE. I FULLY UNDERSTAND THE FEE CONNECTED WITH THE FILING OF THIS PERC TEST APPLICATION IS NON-REFUNDABLE UNDER ANY CIRCUMSTANCES. I ALSO AGREE TO COMPLY WITH ALL M.O.S.H.A. REQUIREMENTS IN TESTING THIS LOT.

David K. Finn SECRETARY
(SIGNATURE OF APPLICANT)

APPROVED BY [Signature] FOR DAVE FINNEGAN DATE 11/19/89

REJECTED BY _____ FOR _____ DATE _____

HOLD PENDING FURTHER TESTS _____ DATE _____


REASONS FOR REJECTION OR HOLDING 6/16/87 Perc OK Hold for Plat RH

BLDG. PERMIT SIGNED
AND RETURNED 12/24/90
Serial # 35840
SFD


THIS IS NOT A PERMIT

LOTT

BL ① ② ③ ④ ⑤ ⑥ ⑦ ⑧ ⑨ ⑩ ⑪ ⑫ ⑬ ⑭ ⑮ ⑯ ⑰ ⑱ ⑲ ⑳ ㉑ ㉒ ㉓ ㉔ ㉕ ㉖ ㉗ ㉘ ㉙ ㉚ ㉛ ㉜ ㉝ ㉞ ㉟ ㊱ ㊲ ㊳ ㊴ ㊵ ㊶ ㊷ ㊸ ㊹ ㊺
 HIGH = ① ④ ⑤
 LOW ② ③

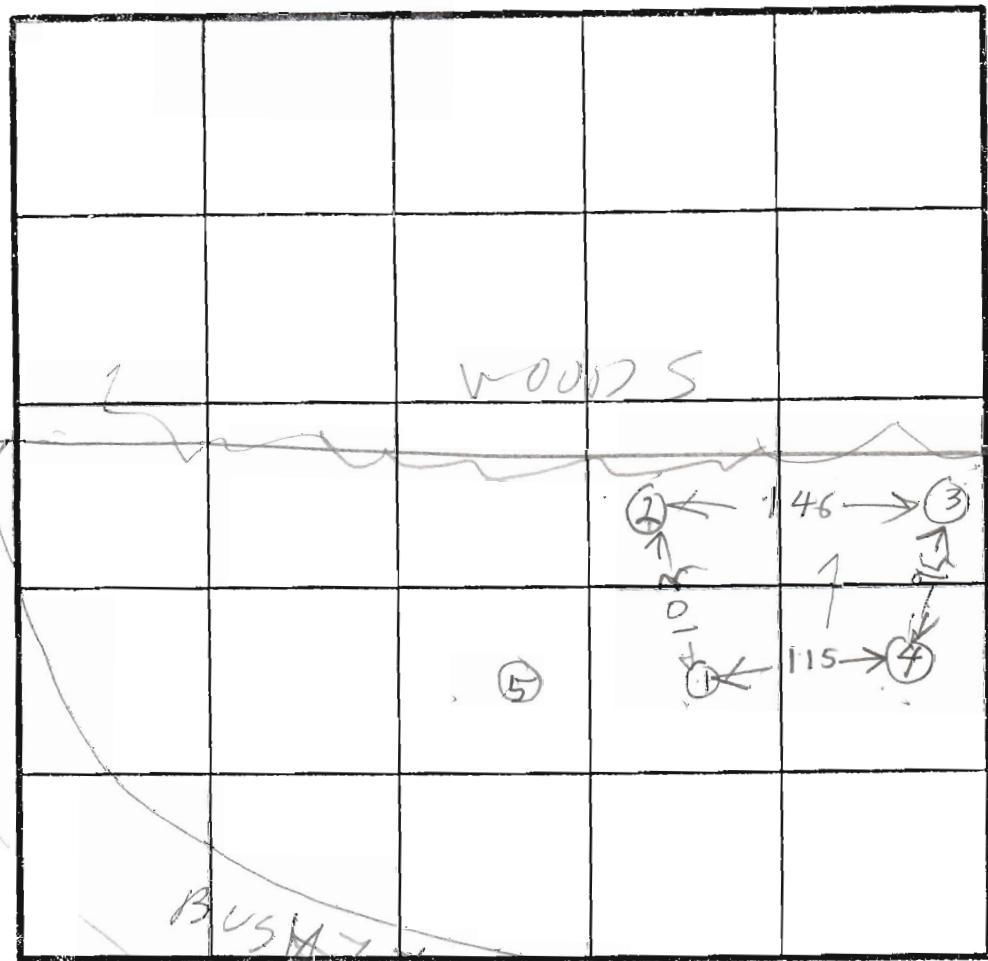

INDICATE NORTH - NAME ADJOINING ROADWAY AS BASE LINE

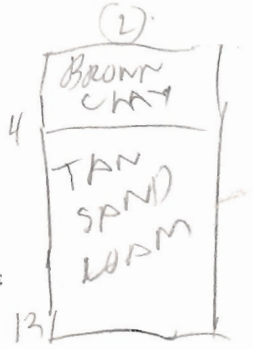

DATE	TEST NO	DEPTH	PRE-WET		TEST - 1" DROP		TIME
			START	STOP	START	STOP	
6/16/97	1V	7.5	1054	1055	1055	1057	2
	1S	4.5	1055	1100	1100	1105	5
	1V	14	OK				
	2S	5.5	1101	1102	1102	1103	1
	2V	13	OK				
6/16/97	3S	4.5	1109	1110	1110	1116	6
	3V	12	OK				
	4S	4	1120	1121	1121	1140	13
	4V	12	OK				
	5V		NOT TESTED	ROCK HOLE			

air time 5min
 max depth 3ft
 Hole Elevation
 ⑤ ① ④ = HIGH
 ② ③ = LOW

EH 12-1079

REMARKS: LATE START LEFT LATE 9 HAD TO FIND HOLES ① ② ⑤ DUG PER SURVEY OR PLAT #OLE ③ ④ DIFFERENT

TYPE OF SOIL _____
 TESTED BY: B. HODGES
 ALSO PRESENT: Backhoe DONNY BROWN, Jeff Allen

