


Scale
(1-100)

HOUSE DETAIL
NOT TO SCALE

LOT 6
BUTTERCUP ESTATES
PLAT NO. 4193

GRID NORTH
MAP 11A(1983)

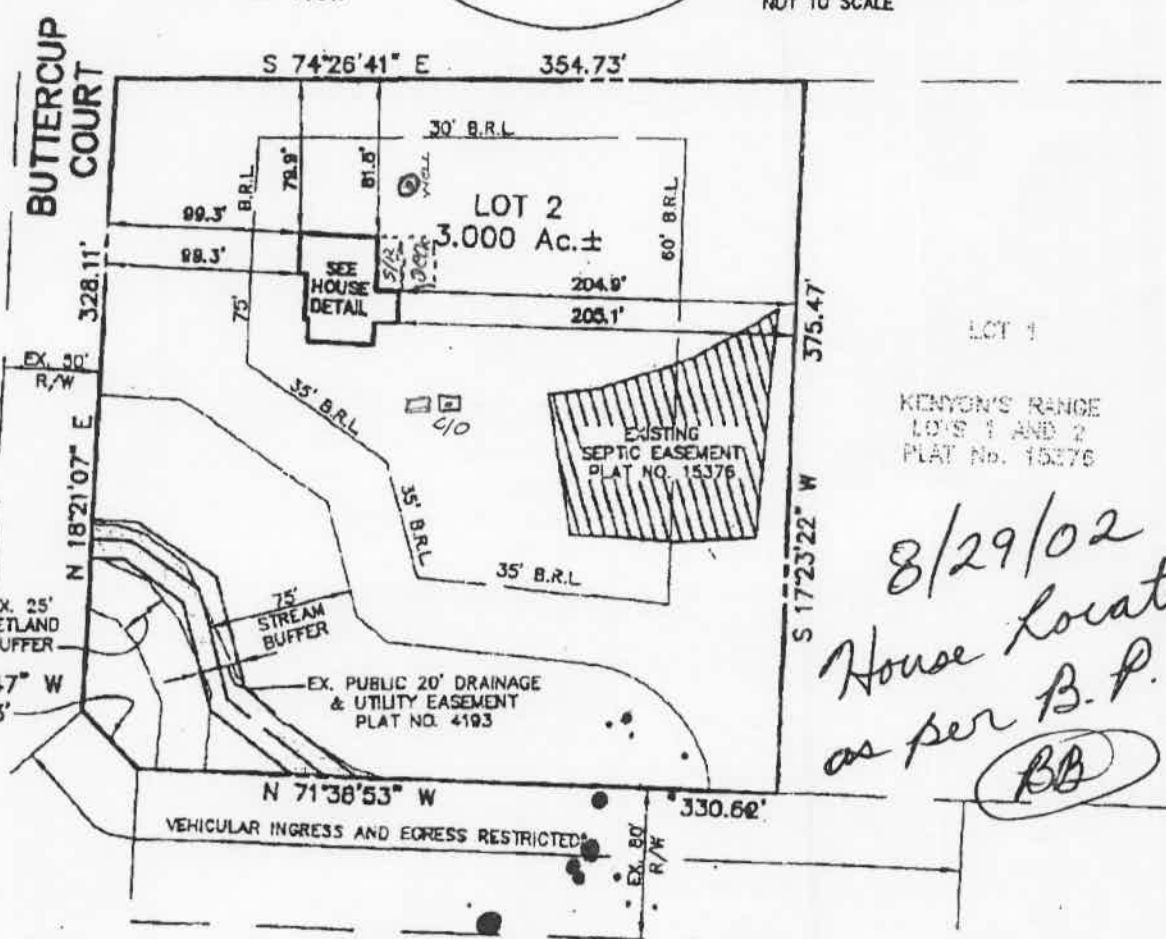

8/29/02
House Located
as per B.P. - 02
BB

APPROVED

WALK-THRU BUILDING PERMIT
BP# _____ A# _____
APP. SAN D. Bernard DATE: 8-5-09
DESC. OF WORK: * Approved as
Shown 12x27 Sunroom
22x28 Deck

B.R.L. = BUILDING RESTRICTION LINE
TOP FOUNDATION ELEVATION = 528.78

- NOTE:
- a. THIS PLAT IS OF BENEFIT TO A CONSUMER ONLY INsofar AS IT IS REQUIRED BY A LENDER OR A TITLE COMPANY OR ITS AGENT IN CONNECTION WITH CONTEMPLATED TRANSFER, FINANCING, OR RE-FINANCING;
 - b. THE PLAT IS NOT TO BE RELIED UPON FOR THE ESTABLISHMENT OR LOCATION OF FENCES, GARAGES, BUILDINGS, OR OTHER EXISTING OR FUTURE IMPROVEMENTS; AND
 - c. THE PLAT DOES NOT PROVIDE FOR THE ACCURATE IDENTIFICATION OF PROPERTY BOUNDARY LINES, BUT SUCH IDENTIFICATION MAY NOT BE REQUIRED FOR THE TRANSFER OF TITLE.
 - d. THE SUBJECT PROPERTY LIES IN ZONE "C" (AREA OF MINIMAL FLOODING) PER F.I.R.M. MAP No. 240044 0007B (PANEL NOT PRINTED) FOR HOWARD COUNTY, MARYLAND.

Patton Harris Rust & Associates, p.c
Engineers. Surveyors. Planners. Landscape Architects.