



SETBACKS:	
REAR PL.	10'
SIDE PL.	10'
HOUSE	0'
SEPTIC WELL	20'
WELL	10'

PRIVATE WELL
& SEPTIC

NOTE: A VACUUM BR
WILL BE INSTA
ON JOB AS PE
CODE.

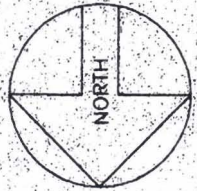

10/30/96
Pool location of
ad. shown. DKS

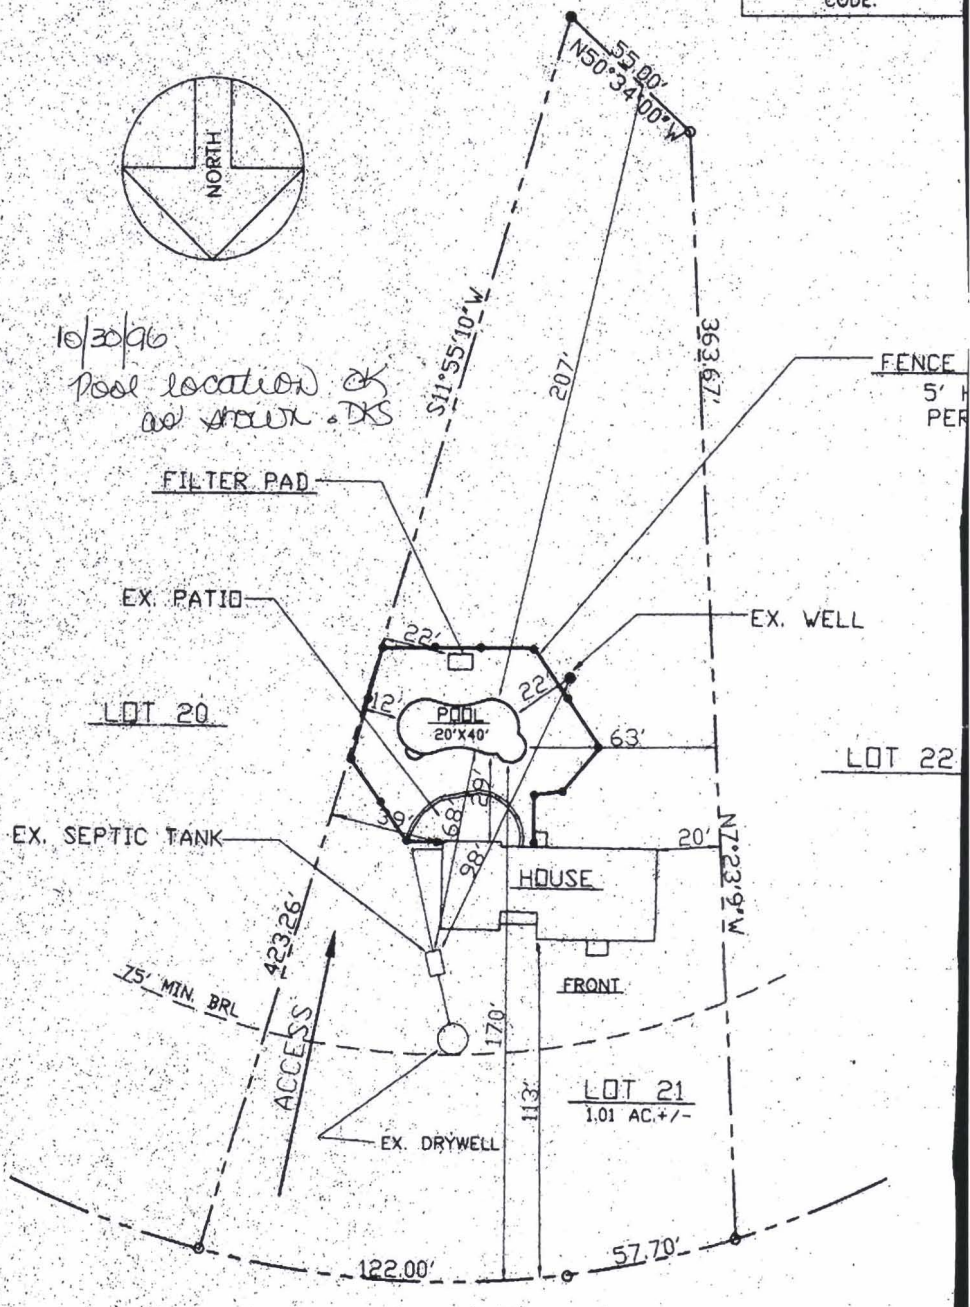

BYEFIELD ROAD
50' R/W

SITE PLAN
SCALE: 1" = 40'

12935 BYEFIELD ROAD
HOWARD COUNTY, MD. 21046

HEMLOCK HILL

LOT 21, LOT SIZE - 44,006 SQ.FT.
PLAT BOOK 17, FOLIO 28
5TH ELECTION DIST.