

# APPLICATION

A 1/309

SEWAGE DISPOSAL TESTING

P \_\_\_\_\_

MARYLAND STATE DEPARTMENT OF HEALTH

HOWARD COUNTY Septic Tank - 1250 gal.

ELLICOTT CITY

Dry Well - 400 sq ft absorbent subsoil area

DISTRICT 5

In basin below the first 4 1/2 sq ft porous  
sub. Maximum depth permitted for dry wells is  
11 ft below original grade. For this dry well 70 ft.  
from right side line and 60 ft from front property  
line as seen from Byefield Rd

DATE 2/29/69

TO: THE COUNTY HEALTH OFFICER  
ELLICOTT CITY, MARYLAND

I, HEREBY, APPLY FOR THE NECESSARY TESTS IN ORDER TO CONSTRUCT (OR RECONSTRUCT) A SEWAGE DISPOSAL SYSTEM.

PROPERTY OWNER Thomas G. and Dorothy D. Oyster

ADDRESS 2419 Reedie Drive, Wheaton, Maryland 20902 PHONE 949-2011

PROPERTY LOCATION:

SUBDIVISION Hemlock Hill LOT NO. 21

ROAD AND DESCRIPTION Byefield <sup>Road</sup> Drive + #108

OCCUPANT \_\_\_\_\_ PHONE \_\_\_\_\_

PERSON TO CONSTRUCT SYSTEM \_\_\_\_\_

ADDRESS \_\_\_\_\_ PHONE \_\_\_\_\_

SIZE OF LOT 50,000 sq. ft. TYPE BLDG. 4 bedrooms  
NUMBER OF BEDROOMS

IF NOT SINGLE RESIDENCE DESCRIBE \_\_\_\_\_

SIGNATURE OF APPLICANT Thomas G. Oyster


APPROVED BY Robert V. Tame FOR Dry Well DATE 2/2/71  
(KIND OF SYSTEM)

REJECTED BY \_\_\_\_\_ FOR \_\_\_\_\_ DATE \_\_\_\_\_  
(KIND OF SYSTEM)

HOLD PENDING FURTHER TESTS \_\_\_\_\_ DATE \_\_\_\_\_

REASONS FOR REJECTION OR HOLDING \_\_\_\_\_

## THIS IS NOT A PERMIT

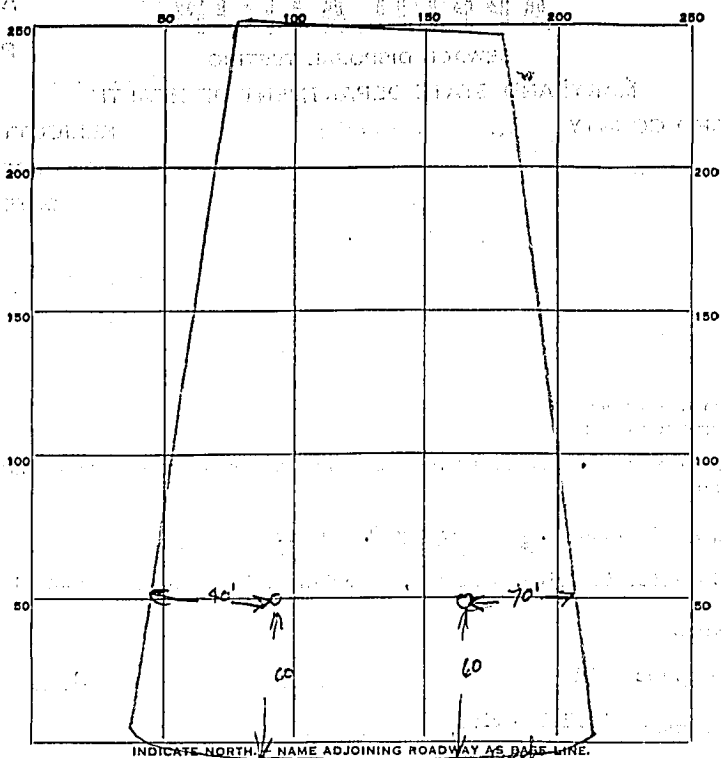

Byefield Rd

DATE	TEST NO.	DEPTH	PRE-WET		TEST - 1" DROP		TIME
			START	STOP	START	STOP	
3/5/69	1	9 1/2 ft	2 13	2 16	2 16	2 24	8 min
	2	4 ft	2 13	2 32	2 32	Overline	2 min
	3	11 ft	2 15	2 16	2 16	2 17	1 min
	4	4 ft	2 15	2 19	2 19	2 28	9 min

lot 21

SOIL AUGER FINDING \_\_\_\_\_

TESTED BY 8

REMARKS Hole no 1+2 - Start inlet 5 ft below original soil