

C 1 2799

SEQUENCE NO. (WRA USE ONLY)

1 2 3 (SEQ. NO.) 26

(THIS NUMBER IS TO BE PUNCHED IN COLS. 3-6 ON ALL CARDS)

STATE OF MARYLAND
WATER RESOURCES ADMINISTRATION
TAWES STATE OFFICE BLDG., ANNAPOLIS, MD. 21401
WELL COMPLETION REPORT

THIS REPORT MUST BE SUBMITTED WITHIN 30 DAYS AFTER WELL COMPLETION

FILL IN THIS FORM COMPLETELY

COUNTY NUMBER

DATE RECEIVED (WRA USE ONLY)

DATE WELL COMPLETED 4-26-74

8-13

DEPTH OF WELL 89

(TO NEAREST FOOT)

PERMIT NO. FROM "PERMIT TO DRILL WELL"

410273-0007

28 29 30 31 32 33 34 35 36 37

DRILLERS IDENTIFICATION NO. 273

OWNER LINKAW
LAST NAME

STREET OR RFD 12935 RYEFIELD RD.
POST OFFICE HIGHLAND, MD.

FIRST NAME WILLIAM

WELL LOG

STATE THE KIND OF FORMATIONS PENETRATED, THEIR COLOR, DEPTH, THICKNESS AND IF WATER BEARING

DESCRIPTION (USE ADDITIONAL SHEETS IF NECESSARY)	FEET		CHECK IF WATER BEARING
	FROM	TO	
Shale Rock	0	24	
Flint Rock	24	89	

GROUTING RECORD

WELL HAS BEEN GROUTED (CIRCLE APPROPRIATE BOX) YES NO

TYPE OF GROUTING MATERIAL (CIRCLE BOX) CEMENT BENTONITE CLAY

CEMENT (C M) BENTONITE CLAY (B C)

NO. OF BAGS 7 NO. OF POUNDS 658

GALLONS OF WATER 42

DEPTH OF GROUT SEAL (TO NEAREST FOOT) FROM 0 FT. TO 24 FT.

CASING RECORD

CASING TYPES (INSERT APPROPRIATE CODE BELOW)

STEEL CONCRETE

PLASTIC OTHER

MAIN CASING TYPE ST

NOMINAL DIAMETER TOP (MAIN) CASING (NEAREST INCH) 6

TOTAL DEPTH OF MAIN CASING (NEAREST FOOT) 26

OTHER CASING (IF USED)

DIAMETER (INCH) FROM TO

SCREEN TYPE (IF USED)

STEEL BRASS OPEN HOLE

PLASTIC OTHER

SCREEN RECORD

SCREEN TYPE (INSERT APPROPRIATE CODE BELOW)

STEEL BRASS OPEN HOLE

PLASTIC OTHER

DEPTH (NEAREST WHOLE FOOT)

FROM 0 TO 24

TO 24

DEPTH (NEAREST WHOLE FOOT) 89

FROM 0 TO 89

TO 89

SLOTSIZE 1, 2, 3

PUMPING TEST

HOURS PUMPED (TO NEAREST HOUR) 2

PUMPING RATE (GALLONS PER MINUTE TO NEAREST GALLON) 10

METHOD USED TO MEASURE PUMPING RATE Baler

WATER LEVEL (DISTANCE FROM LAND SURFACE) BEFORE PUMPING 25 (NEAREST FOOT)

WHEN PUMPING 0 (NEAREST FOOT)

TYPE OF PUMPED USED (CIRCLE APPROPRIATE BOX) (FOR PUMPING TEST)

AIR PISTON TURBINE

CENTRIFUGAL ROTARY OTHER (DESCRIBE BELOW)

JET SUBMERSIBLE

Baler

PUMP INSTALLED

TYPE OF PUMP (WRITE APPROPRIATE LETTER IN BOX - SEE ABOVE: A, C, J, P, R, S, T, O)

DRILLER WILL INSTALL PUMP (CIRCLE APPROPRIATE BOX) YES NO

CAPACITY: GALLONS PER MINUTE (TO NEAREST GALLON) 31

PUMP HORSE POWER 37

PUMP COLUMN LENGTH (NEAREST FOOT) 43

CASING HEIGHT (CIRCLE APPROPRIATE BOX AND ENTER CASING HEIGHT)

ABOVE LAND SURFACE 2 (NEAREST FOOT)

BELOW 49

LOCATION OF WELL ON LOT

SHOW PERMANENT STRUCTURE SUCH AS BUILDINGS, SEPTIC TANKS, AND/OR OTHER LAND MARKS AND INDICATE NOT LESS THAN TWO DISTANCES (MEASUREMENTS TO WELL).

well 65' Back House

CIRCLE APPROPRIATE BOXES

A WELL WAS ABANDONED AND SEALED WHEN THIS WELL WAS COMPLETED

E ELECTRIC LOG OBTAINED

P TEST WELL CONVERTED TO PRODUCTION WELL

I HEREBY CERTIFY THAT I HAVE COMPLIED WITH ALL CONDITIONS STATED ON THE ABOVE-CAPTIONED "PERMIT TO DRILL WELL", AND THAT INFORMATION CONTAINED IN THIS REPORT IS TRUE, ACCURATE, AND COMPLETE TO THE BEST OF MY KNOWLEDGE, INFORMATION AND BELIEF.

DRILLERS NAME RALPH MAYNE

(PLEASE PRINT) RALPH MAYNE

SIGNATURE Ralph Mayne

DIAMETER OF SCREEN 56 (NEAREST INCH)

GRAVEL PACK


IF WELL DRILLED WAS A FLOWING WELL CIRCLE BOX 68 F

WRA USE ONLY (NOT TO BE FILLED IN BY DRILLER) (I.R.O.S.)

TELESCOPE CASING 70

LOG INDICATOR 72

OTHER DATA AVAILABLE 74 75 76

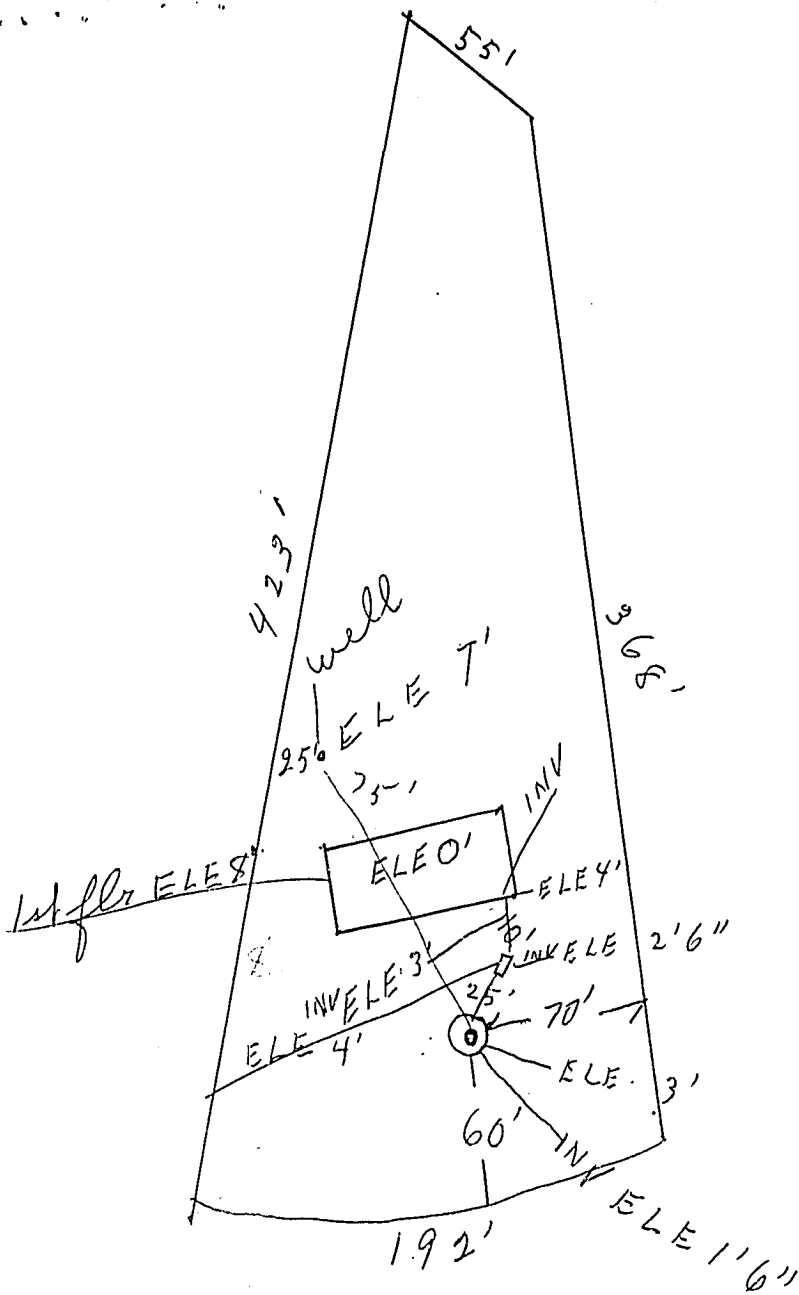

1" to pipe to be more than 3 1/2' in ground

9/5/73
 Plans approved.
 R. Torne