

PRELIMINARY

# APPLICATION

A 31546

SEWAGE DISPOSAL TESTING

STATE OF MARYLAND - DEPARTMENT OF HEALTH AND MENTAL HYGIENE

P \_\_\_\_\_

HOWARD COUNTY HEALTH DEPARTMENT  
ENVIRONMENTAL HEALTH SERVICES

P. O. BOX 473 ELLICOTT CITY, MARYLAND 21043  
TELEPHONE: 992-2330

DISTRICT 4th

DATE 8/4/81

TO: THE COUNTY HEALTH OFFICER  
ELLICOTT CITY, MARYLAND

I, HEREBY, APPLY FOR THE NECESSARY TEST IN ORDER TO CONSTRUCT (OR RECONSTRUCT) A SEWAGE DISPOSAL SYSTEM.

PROPERTY OWNER Hubert E. Snapp, Inc. William MOYER

ADDRESS 25641 Ridge Road, Damascus, Maryland 20750 PHONE \_\_\_\_\_

PROPERTY LOCATION:

SUBDIVISION Florence Estatic LOT NO. 19 20 17

ROAD AND DESCRIPTION Florence Road 2125 Cabin Branch

SIZE OF LOT 3 acres more or less TYPE BLDG. 3 or 4 bedrooms  
(NUMBER OF BEDROOMS)

THE SYSTEM INSTALLED UNDER THIS APPLICATION IS ACCEPTABLE ONLY UNTIL PUBLIC FACILITIES BECOME AVAILABLE. I FULLY UNDERSTAND THE FEE CONNECTED WITH THE FILING OF THIS PERC TEST APPLICATION IS NON-REFUNDABLE UNDER ANY CIRCUMSTANCES. I ALSO AGREE TO COMPLY WITH ALL M.O.S.H.A. REQUIREMENTS IN TESTING THIS LOT. /s/ Hubert E. Snapp

(SIGNATURE OF APPLICANT)

APPROVED BY \_\_\_\_\_ FOR \_\_\_\_\_ DATE \_\_\_\_\_

REJECTED BY \_\_\_\_\_ FOR \_\_\_\_\_ DATE \_\_\_\_\_

HOLD PENDING FURTHER TESTS \_\_\_\_\_ DATE \_\_\_\_\_

REASONS FOR REJECTION OR HOLDING \_\_\_\_\_


**BLDG. PERMIT SIGNED  
AND RETURNED**

# THIS IS NOT A PERMIT

#20

02319  
SOIL PROFILE

4' Clay  
Mostly loam  
w some  
w shale

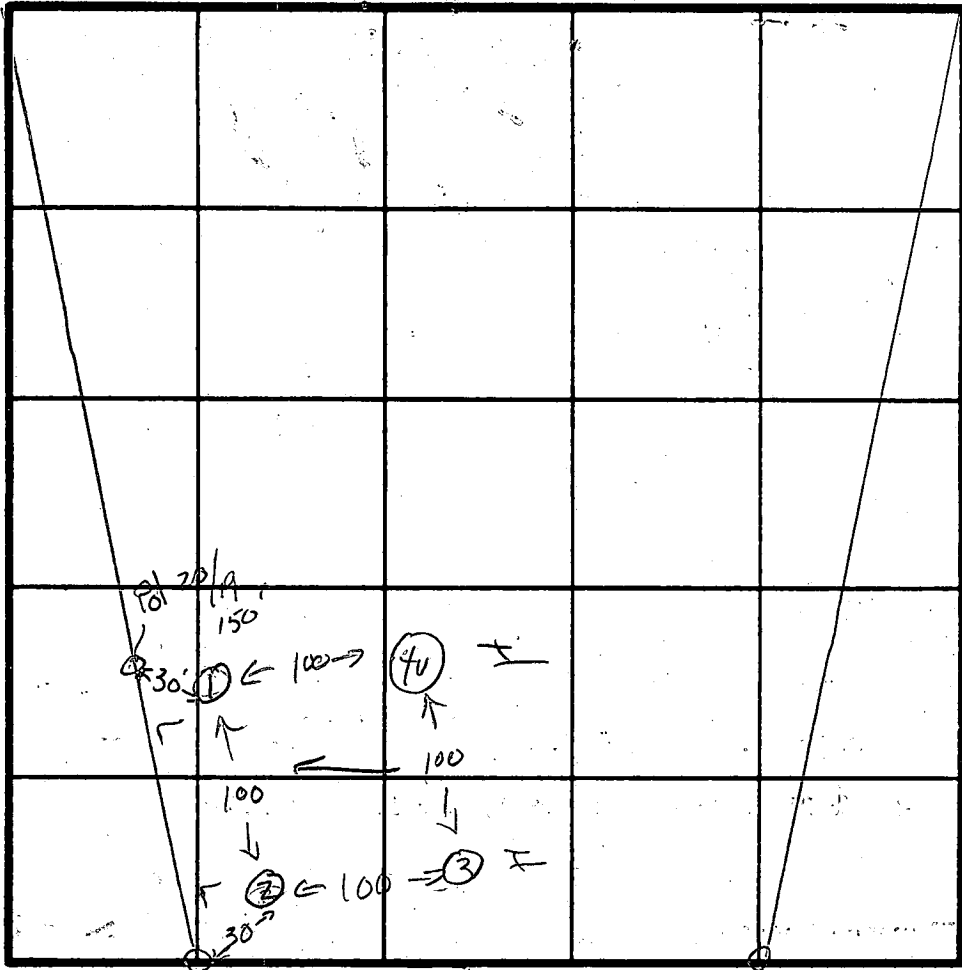

INDICATE NORTH - NAME ADJOINING ROADWAY AS BASE LINE.

BRANCH COURT

DATE	TEST NO.	DEPTH	PRE-WET		TEST - 1" DROP		TIME	
			START	STOP	START	STOP		
9/17/81	S	4'	10:05	10:14	10:14	10:40	24	
	M	8	10:05	10:08	10:08	10:18	10	
	D	13						
	S	4'	10:07	10:12	10:12	10:23	9	
	M	8	10:07	10:12	10:12	10:23	9	
	D	13						
	S	4'	10:24	10:31	10:31	10:48	17	
	M	8	10:25	10:28	10:28	10:35	7	
	D	13						
	4U	1-4 days 4-13	mostly loam w some shale					
		4	10:51	1:05				
		8	10:57					

13 min avg.  
inlet 4'

REMARKS \_\_\_\_\_

TYPE OF SOIL \_\_\_\_\_

TESTED BY SK 9/17/81 ALSO PRESENT SKK

EH-12-1079