

11/20

Am ASAP

BP
42827
5/13/54

House connection asq'd.

WPI + N

PERMIT

SEWAGE DISPOSAL SYSTEM

MARYLAND STATE DEPARTMENT OF HEALTH

HOWARD COUNTY
BUREAU OF ENVIRONMENTAL HEALTH
461-9933

INDEXED

04-343565

P 40469

A 31546

DISTRICT 4th

DATE 11/10/87

DATE SYSTEM APPROVED 12/31/87

INSPECTOR RH

Hy and Lowe

IS PERMITTED TO INSTALL ALTER

ADDRESS 7000 Warfield Road, Gaithersburg, Maryland PHONE 831-7880

SUBDIVISION Florence Estates ROAD 2125 Cabin Branch LOT 17, Section 2

PROPERTY OWNER JULIE + William ALFVER William Moyer (301) 881-2990

ADDRESS _____

IF GARBAGE GRINDER IS USED INCREASE SEPTIC TANK CAPACITY BY 50% AND ABSORPTION AREA BY 22%.

GARBAGE GRINDER? YES _____ NO

SEPTIC TANK CAPACITY 1250 GALLONS NUMBER OF BEDROOMS 4

TRENCHES - 180 sq. ft. per bedroom. Trench to be 2 feet wide. Inlet 3 feet below original grade. Bottom maximum depth 8 feet below original grade. Effective area begins at 3 feet below original grade. 5 feet of stone below distribution pipe.

LOCATION - Start the first trench 135 feet from the front lot line and 120 feet from the right lot line as seen when facing the property from Cabin Branch Court. Run trench(s) along contour toward Cabin Branch Court.

NOTE - No trench to exceed 100 feet in length. Provide 6" - 8" diameter cleanout and cap to grade or above on septic tank. *ok 11-9-87 JEN*

BLDG. PERMIT SIGNED AND RETURNED 3-3-99
Serial # 420 11477
Myrland prof.

PLANS APPROVED BY C. Williams DATE 4/07/87

COVER NO WORK UNTIL INSPECTED AND APPROVED.

NEITHER THE HOWARD COUNTY COUNCIL NOR THE HEALTH DEPARTMENT IS RESPONSIBLE FOR THE SUCCESSFUL OPERATION OF ANY SYSTEM.

NOTE: CLEANOUT REQUIRED EVERY 70 FEET OF SEWER LINE AND/OR AT 90° SWEEPS IN LINES FROM HOUSE TO DRAIN FIELDS.

NOTE: ALL PARTS OF SEPTIC SYSTEMS (I.E. TANK, DISTRIBUTION BOX, TRENCHES) TO BE 100 FEET FROM WELL. (UNLESS OTHERWISE SPECIFICALLY AUTHORIZED).

NOTE: IF DEEP TRENCHES ARE USED CALL FOR INSPECTION BEFORE AND AFTER PLACING GRAVEL IN TRENCHES).

NOTE: NO DRY WELL SHALL EXCEED 15 FOOT IN DIAMETER. NO ABSORPTION TRENCH TO EXCEED 100 FEET IN LENGTH.

NOTE: ALL PIPE FROM HOUSE TO SEPTIC TANK MUST BE CAST IRON OR SCHEDULE 40 PVC OR ABS.

PERMIT VOID AFTER TWO YEARS.

NOTE: INSTALL STAND PIPE ON SEPTIC TANK AND DRY WELL. STAND PIPES MUST BE 6 INCHES IN DIAMETER. CAST IRON, CONCRETE OR TERRA COTTA OR PVC OR ABS ACCEPTED. IF TOP OF SEPTIC TANK IS DEEPER THAN 3 FEET, MANHOLE TO GRADE REQUIRED.

NOTE: DISTRIBUTION BOXES MUST HAVE BAFFLES.


BLDG. PERMIT SIGNED AND RETURNED 5/27/92
Serial # 42827
3 car garage
3 stall horse barn

***INSTALLER IS RESPONSIBLE FOR OBTAINING FINAL APPROVAL ON THIS PERMIT**

*CALL 461-9933 FOR INSPECTION OF SEPTIC SYSTEMS.

EH - 2-1186

A 31546

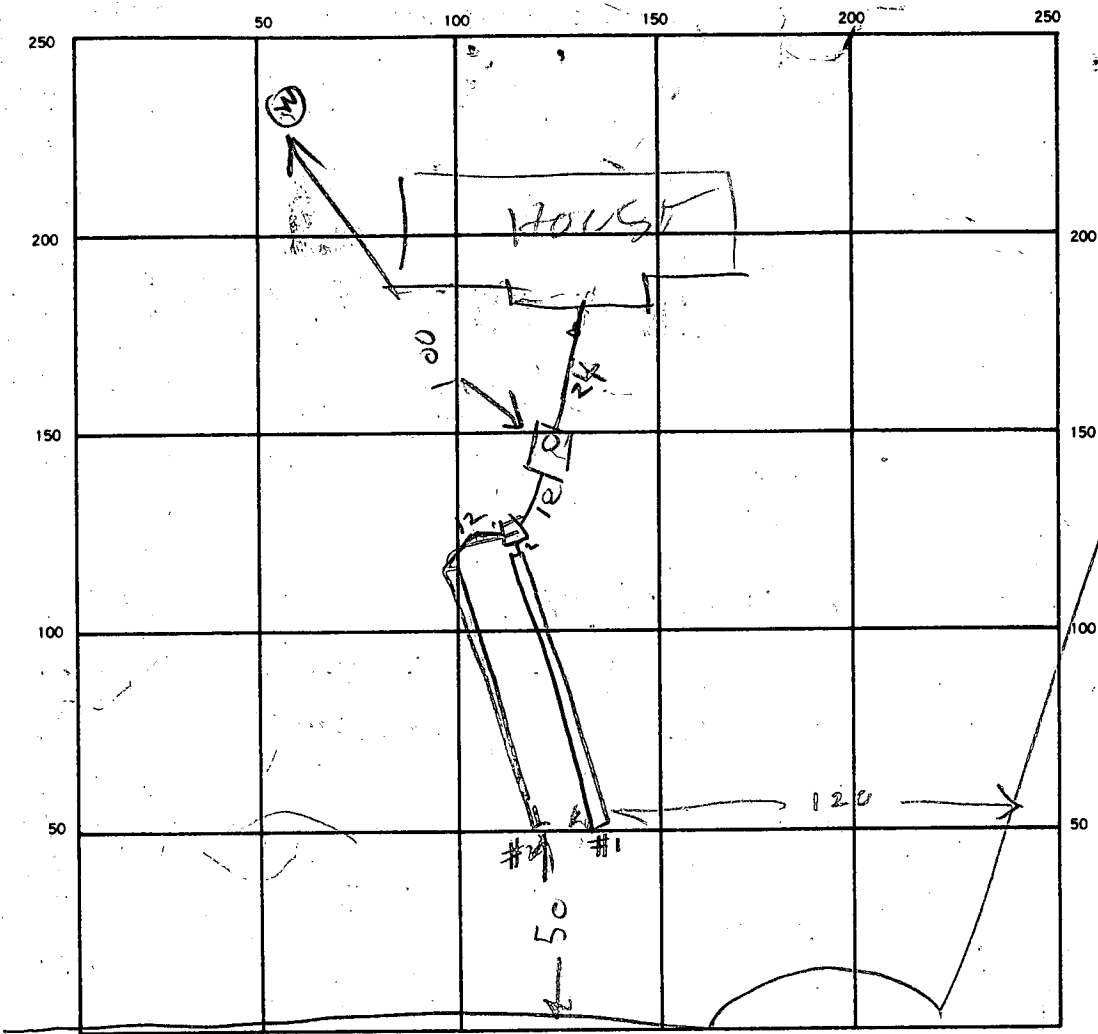

INDICATE NORTH. — NAME ADJOINING ROADWAY AS BASE LINE.

SEPTIC TANK LEVEL OK 1250 CLEANOUTS OK

DISTRIBUTION BOX LEVEL OK

DRAIN FIELD/TILE FIELD DEPTH 8 5/9 FT. TRENCH WIDTH 2 1/2 FT. INLET DEPTH 3 1/2 FT.

EFFECTIVE GRAVEL DEPTH 5.5/6 FT. TOTAL LENGTH 75/74 FT.

NUMBER OF TRENCHES 2 ONE SIDEWALL/BOTTOM AREA 412/440 ^{INSTALL 2 .B EQUIVE}

DRYWELL INSIDE DIAMETER _____ FT. EFFECTIVE DEPTH BELOW INLET _____ FT.

REMARKS 11/20/87 SNOW TURN LOCATION OK ADD STONE & PIPE TO TRENCHES RH

11/20/87 STONE ADDED BUT NOT HOOKED

TO HOUSE CALL FOR INSPECTION OF

HOUSE HOOK UP RH

12/31/87 HOUSE SEWER OK RH

DATE SYSTEM APPROVED 12/31/87 INSPECTOR Raymond Hodger