

CANE. RAIN
3/30/89
AM

4/10/89

no record
3/29/89

Tax ID

PERMIT

SEWAGE DISPOSAL SYSTEM

MARYLAND STATE DEPARTMENT OF HEALTH

HOWARD COUNTY
BUREAU OF ENVIRONMENTAL HEALTH
461-9933

P 43891

A REPAIR

DISTRICT _____
DATE 3/29/89

INDEXED

DATE SYSTEM APPROVED 4-10-89

INSPECTOR S. Abel

Jenkins Brothers

IS PERMITTED TO INSTALL _____ ALTER

ADDRESS 10439 Frederick Road, Ellicott City, Maryland PHONE 465-6646

SUBDIVISION _____ ROAD 14799 Old Frederick LOT _____

PROPERTY OWNER _____ Emerson Harless

ADDRESS _____ 14799 Old Frederick Road
Woodbine, Maryland 21797

IF GARBAGE GRINDER IS USED INCREASE SEPTIC TANK CAPACITY BY 50% AND ABSORPTION AREA BY 22%.

GARBAGE GRINDER? YES _____ NO _____

SEPTIC TANK CAPACITY _____ GALLONS NUMBER OF BEDROOMS 2

REPAIR - CALL FOR INSPECTION WHEN GROUND IS OPENED UP SO SANITARIAN CAN RECOMMEND REPAIR.

Inlet 4' Bottom 10' 6" STONE. Repair using all stone on
side 42 TONS. S. Abel

PLANS APPROVED BY _____ Craig Williams DATE 3/29/89

COVER NO WORK UNTIL INSPECTED AND APPROVED

NEITHER THE HOWARD COUNTY COUNCIL NOR THE HEALTH DEPARTMENT IS RESPONSIBLE FOR THE SUCCESSFUL OPERATION OF ANY SYSTEM

NOTE: CLEANOUT REQUIRED EVERY 70 FEET OF SEWER LINE AND/OR AT 90° SWEEPS IN LINES FROM HOUSE TO DRAIN FIELDS

NOTE: ALL PARTS OF SEPTIC SYSTEMS (I.E. TANK, DISTRIBUTION BOX, TRENCHES) TO BE 100 FEET FROM WELL (UNLESS OTHERWISE SPECIFICALLY AUTHORIZED)

NOTE: IF DEEP TRENCHES ARE USED CALL FOR INSPECTION BEFORE AND AFTER PLACING GRAVEL IN TRENCHES

NOTE: NO DRY WELL SHALL EXCEED 15 FOOT IN DIAMETER NO ABSORPTION TRENCH TO EXCEED 100 FEET IN LENGTH.

NOTE: ALL PIPE FROM HOUSE TO SEPTIC TANK MUST BE CAST IRON OR SCHEDULE 40 PVC OR ABS

PERMIT VOID AFTER TWO YEARS


NOTE: INSTALL STAND PIPE ON SEPTIC TANK AND DRY WELL. STAND PIPES MUST BE 6 INCHES IN DIAMETER. CAST IRON, CONCRETE OR TERRA COTTA OR PVC OR ABS ACCEPTED. IF TOP OF SEPTIC TANK IS DEEPER THAN 3 FEET, MANHOLE TO GRADE REQUIRED

NOTE: DISTRIBUTION BOXES MUST HAVE BAFFLES

***INSTALLER IS RESPONSIBLE FOR OBTAINING FINAL APROVAL ON THIS PERMIT**

*CALL 461-9933 FOR INSPECTION OF SEPTIC SYSTEMS.

43891

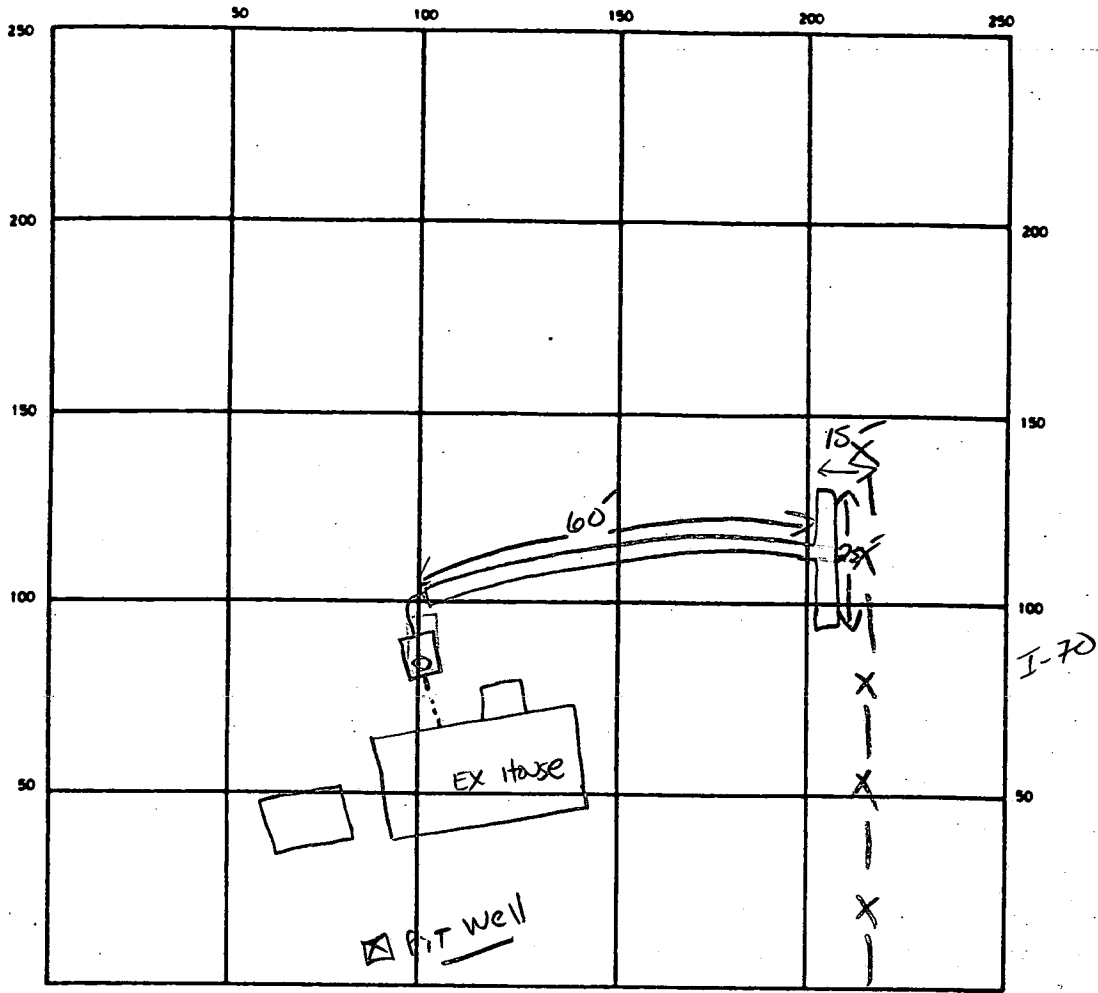

INDICATE NORTH - NAME ADJOINING ROADWAY AS BASE LINE
 OLD FREDERICK Rd.

180
 3
 540
 540

I-70

SEPTIC TANK LEVEL ✓ New 1000 GAL CLEANOUTS ✓ New

DISTRIBUTION BOX LEVEL N/A

DRAIN FIELD TILE FIELD DEPTH 10 FT. TRENCH WIDTH 2 FT. INLET DEPTH 4 FT.

EFFECTIVE GRAVEL DEPTH 6 FT. TOTAL LENGTH 85 FT.

NUMBER OF TRENCHES 1 ONE SIDEWALL BOTTOM AREA 510 SQ. FT.

DRYWELL INSIDE DIAMETER — FT. EFFECTIVE DEPTH BELOW INLET — FT.

ABSORBENT AREA 510 SQ. FT.

REMARKS 4-10-89 STONE AS TRENCH DUG - SIDEWALL WEAK. KENNY ALLEN
DIGGING SA 4-10-89 OK TO COVER. 40⁺ TONS OF STONE USED. SA

DATE SYSTEM APPROVED 4-10-89 INSPECTOR S. Abel