

Preliminary

APPLICATION

SEWAGE DISPOSAL TESTING

MARYLAND STATE DEPARTMENT OF HEALTH

HOWARD COUNTY

ELLICOTT CITY

A 13195

F _____

DISTRICT 2

DATE 10/30/67

*1000 gal. septic tank, 400 sq. ft. dry-well
locate dry-well 90' from rear lot line
and 54' from left lot line, as seen in plan
facing lot from Calvin Circle. inlet depth may have to be
3 1/2 to 4' deep 7'
before effective area starts*

TO: THE COUNTY HEALTH OFFICER
ELLICOTT CITY, MARYLAND

I, HEREBY, APPLY FOR THE NECESSARY TESTS IN ORDER TO CONSTRUCT (OR RECONSTRUCT) A SEWAGE DISPOSAL SYSTEM.

PROPERTY OWNER Mt. Hebron, Inc.

ADDRESS 410 Mt. Hebron Drive, Ellicott City, Md. PHONE HO 5-2869

PROPERTY LOCATION:

SUBDIVISION Mt. Hebron, Inc. LOT NO. 101, Sec. 11

ROAD AND DESCRIPTION Calvin Circle

OCCUPANT _____ PHONE _____

PERSON TO CONSTRUCT SYSTEM _____

ADDRESS _____ PHONE _____

SIZE OF LOT 84' x 235' x 166' x 172' TYPE BLDG. 3
NUMBER OF BEDROOMS

IF NOT SINGLE RESIDENCE DESCRIBE _____

SIGNATURE OF APPLICANT H. J. Baker


APPROVED BY Robert F. Palmer FOR dry-well DATE 9/24/70
(KIND OF SYSTEM)

REJECTED BY _____ FOR _____ DATE _____
(KIND OF SYSTEM)

HOLD PENDING FURTHER TESTS _____ DATE _____

REASONS FOR REJECTION OR HOLDING _____

THIS IS NOT A PERMIT

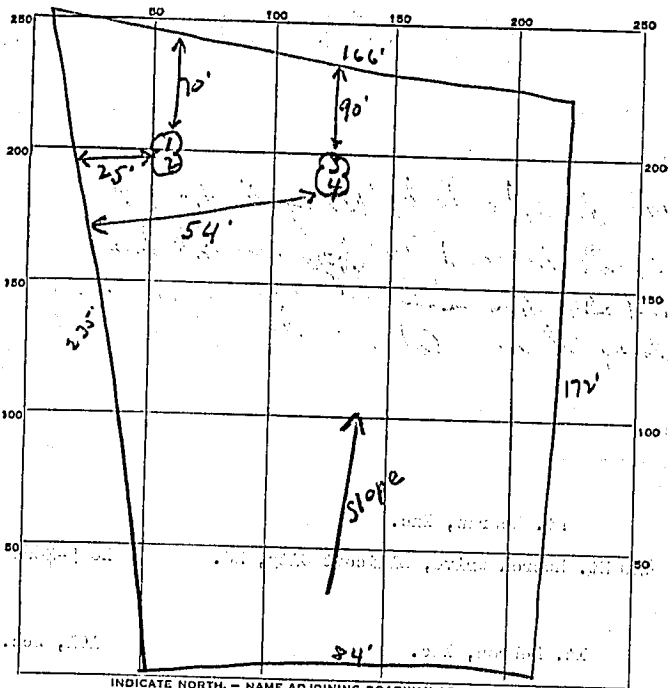

Calvin Circle

DATE	TEST NO.	DEPTH	PRE-WET		TEST - 1" DROP		TIME	
			START	STOP	START	STOP		
10/25/67	1	4 1/4'	10:30	10:34	10:34	10:41	7 min	
	2	9'	10:29	10:31	10:31	10:33	2 min	
	3	5'	10:35	10:38	10:38	10:42	4 min	
	4	10'	Not tested - same soil					

av. time
4 1/2 min
Depth 3'

SOIL AUGER FINDING _____

TESTED BY: JHK

REMARKS: Use hole 3-4