

12/21/70  
17/22/70

12/25/70 approved by JTB

# PERMIT

P 15590  
A 13195

SEWAGE DISPOSAL SYSTEM

MARYLAND STATE DEPARTMENT OF HEALTH

HOWARD COUNTY

ELLICOTT CITY

DISTRICT 2

**INDEXED**

DATE 10/19/70

Emerson Penga IS PERMITTED TO INSTALL X ALTER

ADDRESS Old Frederick Road, Woodstock, Md. PHONE 328-2481

A SEWAGE DISPOSAL SYSTEM LOCATED AT \_\_\_\_\_

SUBDIVISION Mt. Hebron, Inc. ROAD Calvin Circle LOT 101, Sec. 11

PROPERTY OWNER Mt. Hebron, Inc.

ADDRESS \_\_\_\_\_

SPECIFICATIONS - 3 bedrooms

DRAIN FIELD \_\_\_\_\_ DEPTH \_\_\_\_\_ FEET, BOTTOM AREA \_\_\_\_\_ SQ. FT.

SEEPAGE PITS \_\_\_\_\_ ABSORBENT SIDE-WALL AREA \_\_\_\_\_ SQ. FT.

SEPTIC TANK CAPACITY 1,000 GALLONS

FOR GARBAGE GRINDER, INCREASE DISPOSAL AREA 22% & TANK CAPACITY 50%.

OTHER Dry well - 400 sq. ft. Locate dry well 90 ft. from rear lot line and 54 ft.

from left lot line as seen when facing lot from Calvin Circle. Inlet depth may

have to be 3 1/2 to 4 ft. deep before effective area starts.


PLANS APPROVED BY Palmer F. Wine DATE 10/19/70

FILL SEPTIC TANK AND DISTRIBUTION BOX WITH WATER BEFORE CALLING FOR AN INSPECTION. COVER NO WORK UNTIL INSPECTED AND APPROVED.

NEITHER THE HOWARD COUNTY COMMISSIONERS NOR THE HEALTH DEPARTMENT IS RESPONSIBLE FOR THE SUCCESSFUL OPERATION OF ANY SYSTEM.

A 13195

$\frac{16 \frac{1}{2} \times 8}{4}$   
 $\frac{16 \frac{1}{2} \times 6 \frac{1}{2} \times 9}{540}$

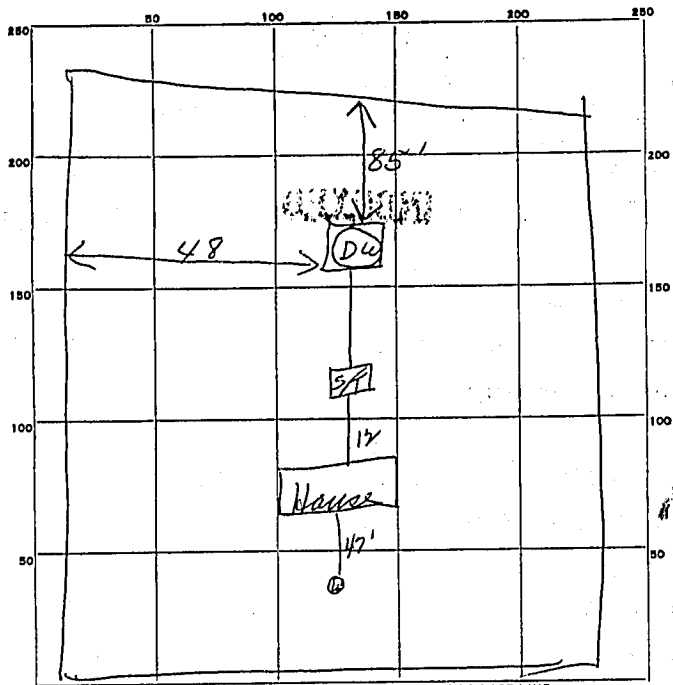

PERMIT CARD OK

SEPTIC TANK, LEVEL 1000 cent

CLEANOUTS OK

DISTRIBUTION BOX, LEVEL \_\_\_\_\_

TILE FIELD, DEPTH \_\_\_\_\_ FT. TRENCH WIDTH \_\_\_\_\_ FT.

GRAVEL DEPTH \_\_\_\_\_ IN. TOTAL LENGTH \_\_\_\_\_ FT.

NUMBER OF TRENCHES \_\_\_\_\_ TOTAL BOTTOM AREA \_\_\_\_\_

SEEPAGE PITS, INSIDE DIAMETER 15 X 15 9 FT. DEPTH BELOW INLET 9 FT.

ABSORBENT AREA 540 SQ. FT.

REMARKS left note to check septic tank and call JTW

DATE SYSTEM APPROVED 12/28/70 INSPECTOR JTW