

8/2/90
date as possible
8/6/90 / ASAP

File
8/2/90 @ P.C.O.
C.B.S.

PERMIT

SEWAGE DISPOSAL SYSTEM

MARYLAND STATE DEPARTMENT OF HEALTH

HOWARD COUNTY
BUREAU OF ENVIRONMENTAL HEALTH
461-9933

03-316335

P 46195

A 45411

DISTRICT 3rd

DATE 8/1/90

DATE SYSTEM APPROVED 8/6/90

INSPECTOR C.B.S.

INDEXED

Jade Enterprises

IS PERMITTED TO INSTALL ALTER

ADDRESS 3335 Marston Road, Westminster, Maryland 21157 PHONE 848-8979

SUBDIVISION Day View Acres ROAD 1950 Mt. View Road LOT 2

PROPERTY OWNER H. Calvin Day/Eileen M. Day

ADDRESS

~~IF GARBAGE GRINDER IS USED INCREASE SEPTIC TANK CAPACITY BY 50% AND ABSORPTION AREA BY 25%~~

GARBAGE GRINDER YES NO

SEPTIC TANK CAPACITY 1000 GALLONS NUMBER OF BEDROOMS 3

TRENCHES - 200 sq. ft. per bedroom. Trench to be 2 feet wide. Inlet 4 feet below original grade. Bottom maximum depth 8 feet below original grade. Effective area begins at 4 feet below original grade. 4 feet of stone below distribution pipe.

LOCATION - Start the first trench 80 feet from the right lot line and 90 feet from the rear lot line. Run trenches along contour toward right-rear corner of lot.

NOTE - No trench to exceed 100 feet in length. Provide 6" - 8" diameter cleanout and cap to grade or above on septic tank. 8-1-90 JEN

PLANS APPROVED BY C. Williams/CBS DATE 3/29/90

COVER NO WORK UNTIL INSPECTED AND APPROVED

NEITHER THE HOWARD COUNTY COUNCIL NOR THE HEALTH DEPARTMENT IS RESPONSIBLE FOR THE SUCCESSFUL OPERATION OF ANY SYSTEM

NOTE: CLEANOUT REQUIRED EVERY 70 FEET OF SEWER LINE AND/OR AT 90° SWEEPS IN LINES FROM HOUSE TO DRAIN FIELDS

NOTE: ALL PARTS OF SEPTIC SYSTEMS (I.E. TANK, DISTRIBUTION BOX, TRENCHES) TO BE 100 FEET FROM WELL (UNLESS OTHERWISE SPECIFICALLY AUTHORIZED)

NOTE: IF DEEP TRENCHES ARE USED CALL FOR INSPECTION BEFORE AND AFTER PLACING GRAVEL IN TRENCHES

NOTE: NO DRY WELL SHALL EXCEED 15 FOOT IN DIAMETER NO ABSORPTION TRENCH TO EXCEED 100 FEET IN LENGTH.

NOTE: ALL PIPE FROM HOUSE TO SEPTIC TANK MUST BE CAST IRON OR SCHEDULE 40 PVC OR ABS

PERMIT VOID AFTER TWO YEARS


NOTE: INSTALL STAND PIPE ON SEPTIC TANK AND DRY WELL. STAND PIPES MUST BE 6 INCHES IN DIAMETER. CAST IRON, CONCRETE OR TERRA COTTA OR PVC OR ABS ACCEPTED. IF TOP OF SEPTIC TANK IS DEEPER THAN 3 FEET, MANHOLE TO GRADE REQUIRED

NOTE: DISTRIBUTION BOXES MUST HAVE BAFFLES

***INSTALLER IS RESPONSIBLE FOR OBTAINING FINAL APROVAL ON THIS PERMIT**

*CALL 461-9933 FOR INSPECTION OF SEPTIC SYSTEMS.

A 45411

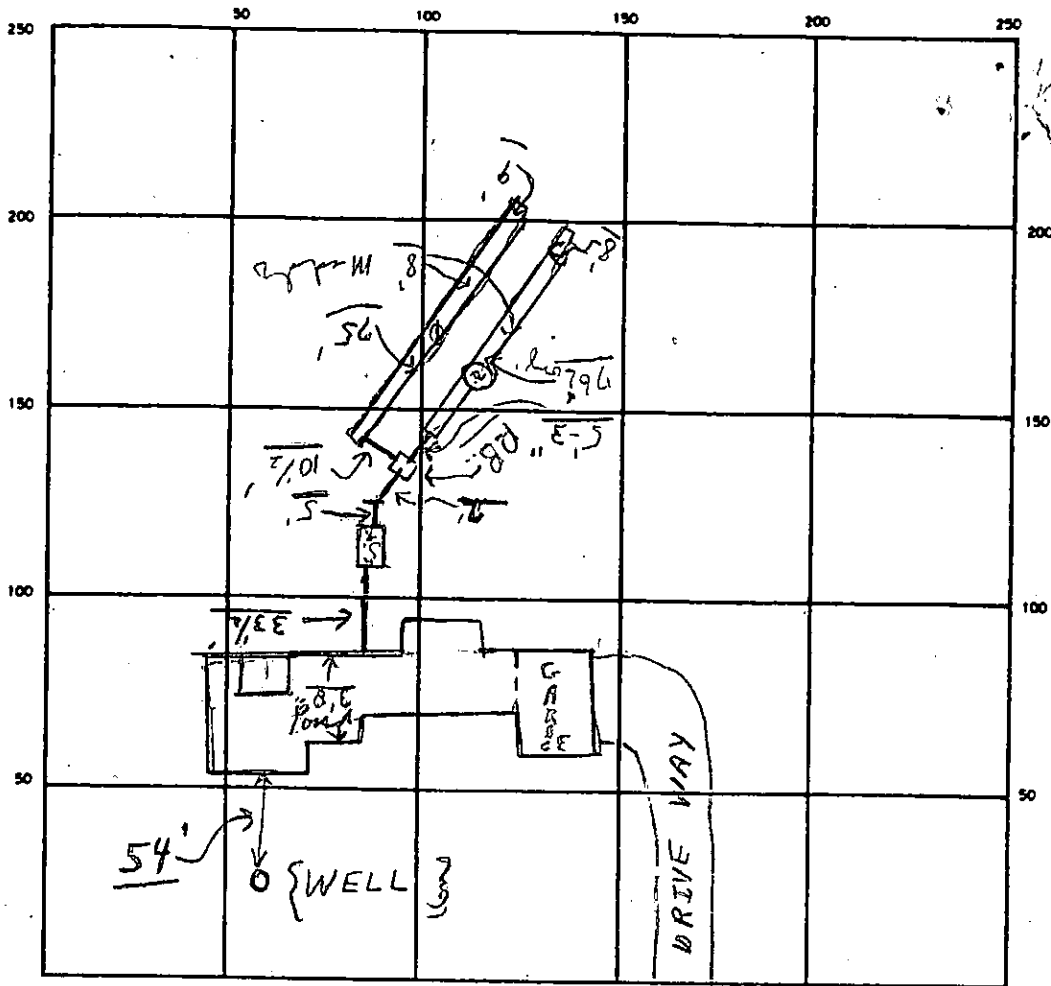

INDICATE NORTH - NAME ADJOINING ROADWAY AS BASE LINE

MT. VIEW ROAD S.T.

SEPTIC TANK. LEVEL OK CLEANOUTS OK

DISTRIBUTION BOX. LEVEL OK (Bottle is in-OK)

DRAIN FIELD/TILE FIELD. DEPTH 8⁺ FT. TRENCH WIDTH 1 2 FT. INLET DEPTH 4 FT.

EFFECTIVE GRAVEL DEPTH 4⁺ FT. TOTAL LENGTH (1) 75' (2) 76' 151 FT.

NUMBER OF TRENCHES 2 ONE SIDEWALL/BOTTOM AREA 604⁺ SQ. FT.

DRYWELL INSIDE DIAMETER FT. EFFECTIVE DEPTH BELOW INLET FT.

ABSORBENT AREA 604⁺ SQ. FT.

REMARKS P.M. 8/2/90 partial - tile for stones in trenches
8/2/90 Final - OK to cover all work.
C.W.

DATE SYSTEM APPROVED 8/6/90 INSPECTOR Charles Lynn Street

2/13/90
2-13-90
10:00am

APPLICATION

PERCOLATION TESTING

A 45711

P _____

HOWARD COUNTY HEALTH DEPARTMENT
BUREAU OF ENVIRONMENTAL HEALTH
P.O. BOX 476 ELLICOTT CITY, MARYLAND 21043
TELEPHONE: 461-9933

DISTRICT 3rd

DATE 1/10/90

Review ok.
No wet season soils
1-10-90 JEN

TO: THE COUNTY HEALTH OFFICER
ELLICOTT CITY, MARYLAND

I, HEREBY, APPLY FOR THE NECESSARY TEST IN ORDER TO CONSTRUCT (OR RECONSTRUCT) A SEWAGE DISPOSAL SYSTEM.

PROPERTY OWNER H. Calvin Day

ADDRESS 12395 Rt 99 Marriottsville PHONE 795-1234 W
442-1214 H

PROSPECTIVE BUYER Same

ADDRESS _____ PHONE _____

PROPERTY LOCATION:

SUBDIVISION Day View Acres LOT NO. 2

ROAD AND DESCRIPTION 1950 STAGE
MT View Road Rt 99

TAX MAP 9 PARCEL # 47

SIZE OF LOT 1 acre - Same Permitted TYPE BLDG. Single Family
(SINGLE FAMILY DWELLING OR COMMERCIAL)

THE SYSTEM INSTALLED UNDER THIS APPLICATION IS ACCEPTABLE ONLY UNTIL PUBLIC FACILITIES BECOME AVAILABLE. I FULLY UNDERSTAND THE FEE CONNECTED WITH THE FILING OF THIS PERC TEST APPLICATION IS NON-REFUNDABLE UNDER ANY CIRCUMSTANCES. I ALSO AGREE TO COMPLY

WITH ALL M.O.S.H.A. REQUIREMENTS IN TESTING THIS LOT. Signature of Applicant

APPROVED BY C. B. Street FOR 2' W, 8' Deep Shallow Trenches DATE 2/13/90
18" x 4' Perforated Holes 0 + 0

REJECTED BY _____ FOR _____ DATE _____

HOLD PENDING FURTHER TESTS _____ DATE _____

REASONS FOR REJECTION OR HOLDING 2/13/90 Need certified holes, well site + some

site. This is tested in wet season time.

and all holes are dig. C.B.S.

BOG. PERMIT SIGNED
AND RETURNED 4/16/90
31795 368ms

THIS IS NOT A PERMIT


HD-216

A45411

LOT #2

HOLE # 1
SOIL PROFILE

0'	-9' CLAY
	LOAM
4' - 12'	Sandy Loam
	NO STONE

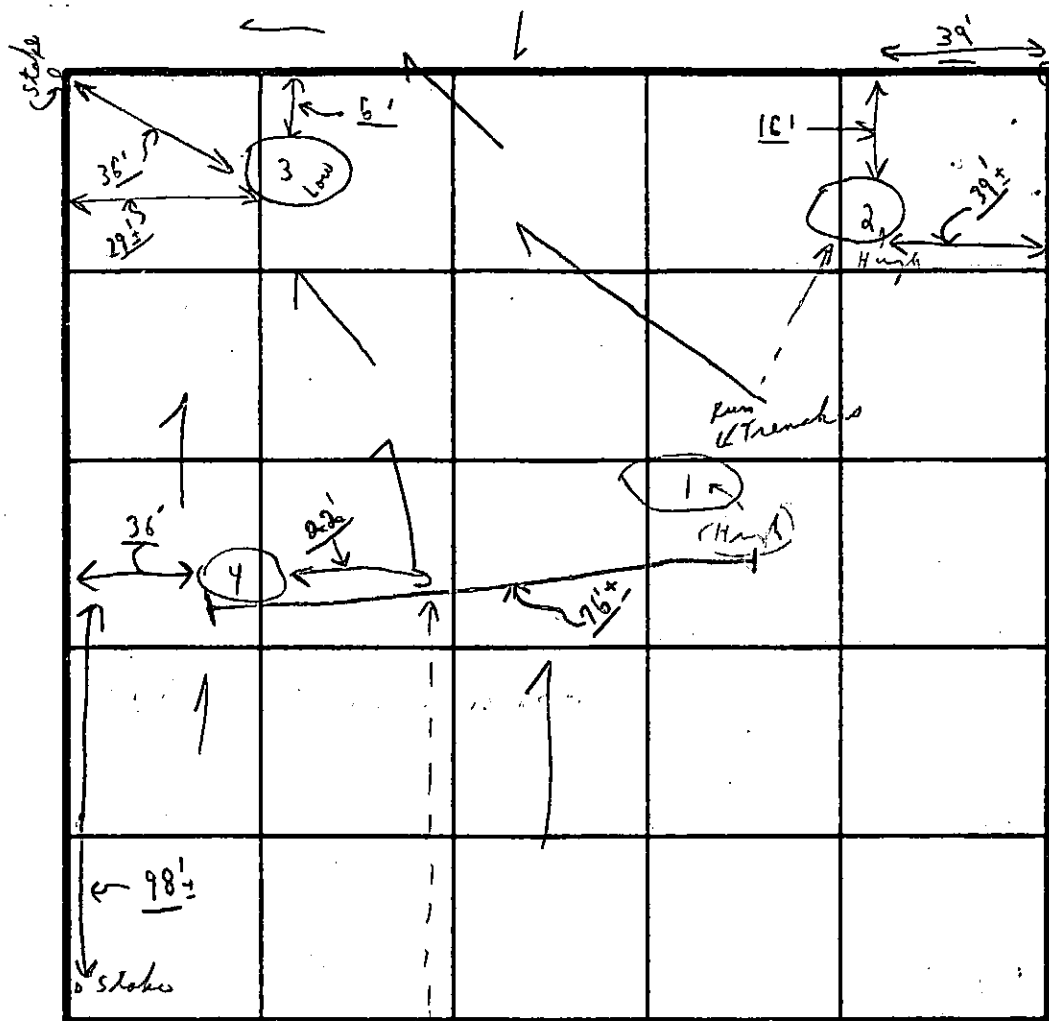

HOLE # 2
SOIL PROFILE

0'	0' - 4 1/2' CLAY
	4' - 11 1/10" LOAM
	SANDY
	TO BOTTOM
	NO STONE

INDICATE NORTH - NAME ADJOINING ROADWAY AS BASE LINE.
MOUNT VIEW RD.

X 22 min
Inlet
4'
Trench 2'-Wide
Depth 8" # HOLE

(LOW)
HOLE # 3
SOIL PROFILE

0'	3/2' CLAY
	3/2' - 12 1/2' SANDY LOAM TO DRY
	NO STONE

DATE	TEST NO.	DEPTH	PRE-WET START	PRE-WET STOP	TEST 1" DROP START	TEST 1" DROP STOP	TIME
2/13/90	1	4'	11:03	11:08	11:08	11:16	8 min
		12'	SANDY LOAM - SOME MELC				LOAM
	2	4'	10:34	10:36	10:36	10:38	2 min
		11' 10"	10:33	10:36	10:36	10:43	7 min
			LOAM - SANDY				
	3	3 1/2'	10:45	10:52	10:52	11:15	23 min
		6 1/2'	10:45	10:52	10:52	11:13	21 min
		12 1/2'	SANDY LOAM - 7% dry				
	4	4'	10:55	11:02	11:02	11:10	8 min
		12'	Caved @ 7' SANDY-LOAM		15%		
			Caved in				

SOIL PROFILE

0'	0' - 4' CLAY
	4' 1/2' LOAM
	TO BOTTOM
	NO STONE

REMARKS: 2/13/90 Tests in open Notes: { 2/13 { von matter in low hole per C.W. - H.C. Red } }
 TYPE OF SOIL: Tests for state - but soon holes near near lines
 TESTED BY: C.B.J. ONLY ALSO PRESENT { H. Duke + staff }
 (M. G. Day + another man)

C1 **1492** SEQUENCE NO. (DENV USE ONLY)
 (THIS NUMBER IS TO BE PUNCHED IN COLS. 3-6 ON ALL CARDS)

STATE OF MARYLAND
WELL COMPLETION REPORT
 FILL IN THIS FORM COMPLETELY
 PLEASE PRINT OR TYPE

THIS REPORT MUST BE SUBMITTED WITHIN
 45 DAYS AFTER WELL IS COMPLETED.
 COUNTY NUMBER **A# 45411**

ST/CO USE ONLY
 DATE Received [] [] [] [] [] []
 DATE WELL COMPLETED **041090**

Depth of Well **400**
 (TO NEAREST FOOT)

PERMIT NO.
 FROM "PERMIT TO DRILL WELL"
HO-88-1264

OWNER **DAY VIEW FARMS - DAY CALVIN**
 STREET OR RFD: last name **MT. VIEW ROAD** first name
 TOWN **WEST FRIENDSHIP, MD.**
 SUBDIVISION **DAY VIEW ACRES** SECTION **1** LOT **2**

WELL LOG
 Not required for driven wells

STATE THE KIND OF FORMATIONS PENETRATED, THEIR COLOR, DEPTH, THICKNESS AND IF WATER BEARING

DESCRIPTION (Use additional sheets if needed)	FEET		Check if water bearing
	FROM	TO	
Top soil	0	2	
Br. mica	2	40	
Tan mica	40	44	
Gray mica	44	60	
Br. mica	60	62	
Gray mica	62	78	
Br. mica	78	81	
Tan mica	81	95	
Gray mica	95	140	
Tan mica	140	185	
Gray mica	185	400	

GROUTING RECORD
 WELL HAS BEEN GROUTED (Circle Appropriate Box) **Y** **N**
 TYPE OF GROUTING MATERIAL
 CEMENT **CM** BENTONITE CLAY **BC**
 NO. OF BAGS **13** NO. OF POUNDS **1300**
 GALLONS OF WATER **65**
 DEPTH OF GROUT SEAL (to nearest foot)
 from **0** ft. to **47** ft.
 (enter 0 if from surface)

CASING RECORD
 casing types insert appropriate code below
ST **CO**
 STEEL CONCRETE
PL **OT**
 PLASTIC OTHER
 MAIN CASING TYPE Nominal diameter top (main) casing (nearest inch) Total depth of main casing (nearest foot)
ST **6** **ST**
 60 81 63 64 68 70

OTHER CASING (if used)
 diameter inch depth (feet) from to
 [] [] [] [] [] []

SCREEN RECORD
 screen type or open hole insert appropriate code below
ST **BR** **HO**
 STEEL BRASS OPEN HOLE
PL **OT**
 PLASTIC OTHER


C2
 DEPTH (nearest ft.)
 EACH SCREEN
 1 **HO** **ST** **400**
 8 9 11 15 17 21
 2 [] [] [] [] [] []
 23 24 26 30 32 36
 3 [] [] [] [] [] []
 38 39 41 45 47 51
 SLOT SIZE 1 2 3
 DIAMETER OF SCREEN [] [] [] (NEAREST INCH)
 56 60

GRAVEL PACK from **11** to **101**
 IF WELL DRILLED WAS FLOWING WELL INSERT F IN BOX 68

OEP USE ONLY (NOT TO BE FILLED IN BY DRILLER)
 T (E.R.O.S.) W Q
 70 [] 72 [] 74 75 76 [] [] []
 TELESCOPE CASING LOG INDICATOR OTHER DATA

C3
PUMPING TEST
 HOURS PUMPED (nearest hour) **3**
 PUMPING RATE (gal. per min. to nearest gal.) **6**
 METHOD USED TO MEASURE PUMPING RATE **Bucket**
 WATER LEVEL (distance from land surface)
 BEFORE PUMPING **56**
 WHEN PUMPING **168**
 TYPE OF PUMP USED (for test)
A air **P** piston **T** turbine
C centrifugal **R** rotary **O** other (describe below)
J jet **S** submersible

PUMP INSTALLED
 DRILLER WILL INSTALL PUMP YES **NO**
 IF DRILLER INSTALLS PUMP, THIS SECTION MUST BE COMPLETED FOR ALL WELLS EXCEPT HOME USE
 TYPE OF PUMP INSTALLED []
 PLACE (A,C,J,P,R,S,T,O) IN BOX - SEE ABOVE: []
 CAPACITY: GALLONS PER MINUTE (to nearest gallon) [] [] [] []
 PUMP HORSE POWER [] [] [] []
 PUMP COLUMN LENGTH (nearest ft.) [] [] [] []
 CASING HEIGHT (circle appropriate box and enter casing height)
+ above } LAND SURFACE [] (nearest foot)
- below }

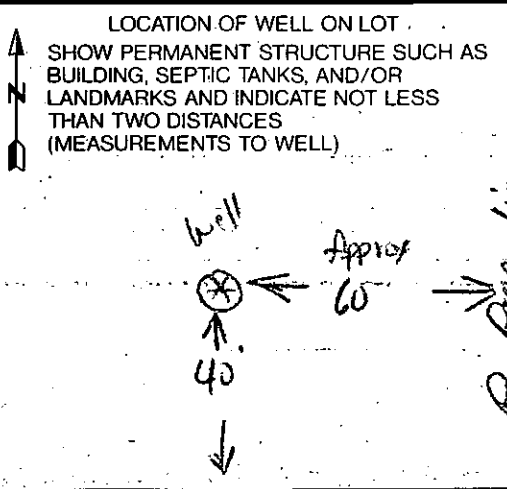

CIRCLE APPROPRIATE LETTER
A A WELL WAS ABANDONED AND SEALED WHEN THIS WELL WAS COMPLETED
E ELECTRIC LOG OBTAINED
P TEST WELL CONVERTED TO PRODUCTION WELL

I HEREBY CERTIFY THAT THIS WELL HAS BEEN CONSTRUCTED IN ACCORDANCE WITH COMAR 28.04.04 "WELL CONSTRUCTION" AND IN CONFORMANCE WITH ALL CONDITIONS STATED IN THE ABOVE CAPTIONED PERMIT, AND THAT THE INFORMATION PRESENTED HEREIN IS ACCURATE AND COMPLETE TO THE BEST OF MY KNOWLEDGE.

DRILLERS IDENT. NO. **410**
 DRILLERS SIGNATURE **Wanda K. Blount**
 (MUST MATCH SIGNATURE ON APPLICATION)
 SITE SUPERVISOR (sign. of driller or journeyman responsible for sitework if different from permittee)

9/10/90 AM

9/11/90

HOWARD COUNTY HEALTH DEPARTMENT
Bureau of Environmental Health
3525-H Ellicott Mills Drive
Ellicott City, MD 21043
461-9933

Final
oh
c. 80

APPLICATION FOR PITLESS ADAPTER, WELL PUMP AND PRESSURE TANK INSTALLATION

New Installation X Replacement _____
Receipt # 45543
Date 9/13/90
Name of Installer FEAGA Plumbing Htg Telephone 442-5729
License Number 6318
Certified Well Pump Installer _____ Well Driller _____ Registered Plumber X
Name of Property Owner CALVIN DAY Telephone 442-1214
Subdivision Day View Acres Lot # 2 Well Tag # HO-88-1264
Site Address 1950 Mt. View Rd

Pump
1. Type
a. Deep well jet _____
b. Shallow well jet _____
c. Submersible X
2. Make Goulds
3. Model # _____
4. Capacity 5 GPM
5. Pump exceeds well capacity Yes _____ No X
6. If Yes, is low pressure cutoff switch installed? Yes _____ No _____
7. What methods are used to protect the pump and electrical wiring from vibrations? Torque arrestors _____ Cable guards _____ Other X

Motor
1. Horsepower 1/4
2. RPM _____
3. Voltage _____
a. 110 _____
b. 220 X

Pitless Adapter
1. Make _____
2. Model # _____
3. Depth _____

Tank
1. Capacity 42
2. Pressure relief valve? Yes


Piping
1. Type plastic
2. Size 1/2
3. NSF and/or BOCA Code approved _____
4. Depth of supply line 200 ft

Well data
1. Depth _____ ft.
2. Yield _____ GPM
3. Static water level _____ ft.
4. Will water supply be disinfected by installer? _____

I understand that it is my responsibility to notify the Howard County Health Department when the installation is ready for inspection (otherwise this permit is null and void).

All information given above is true to the best of my knowledge.
Signature of Applicant: Kenny Feaga
Date: Sept 10, 1990

Note: A sticker indicating approval/status of the installation will be placed on the well casing at the time of the inspection.

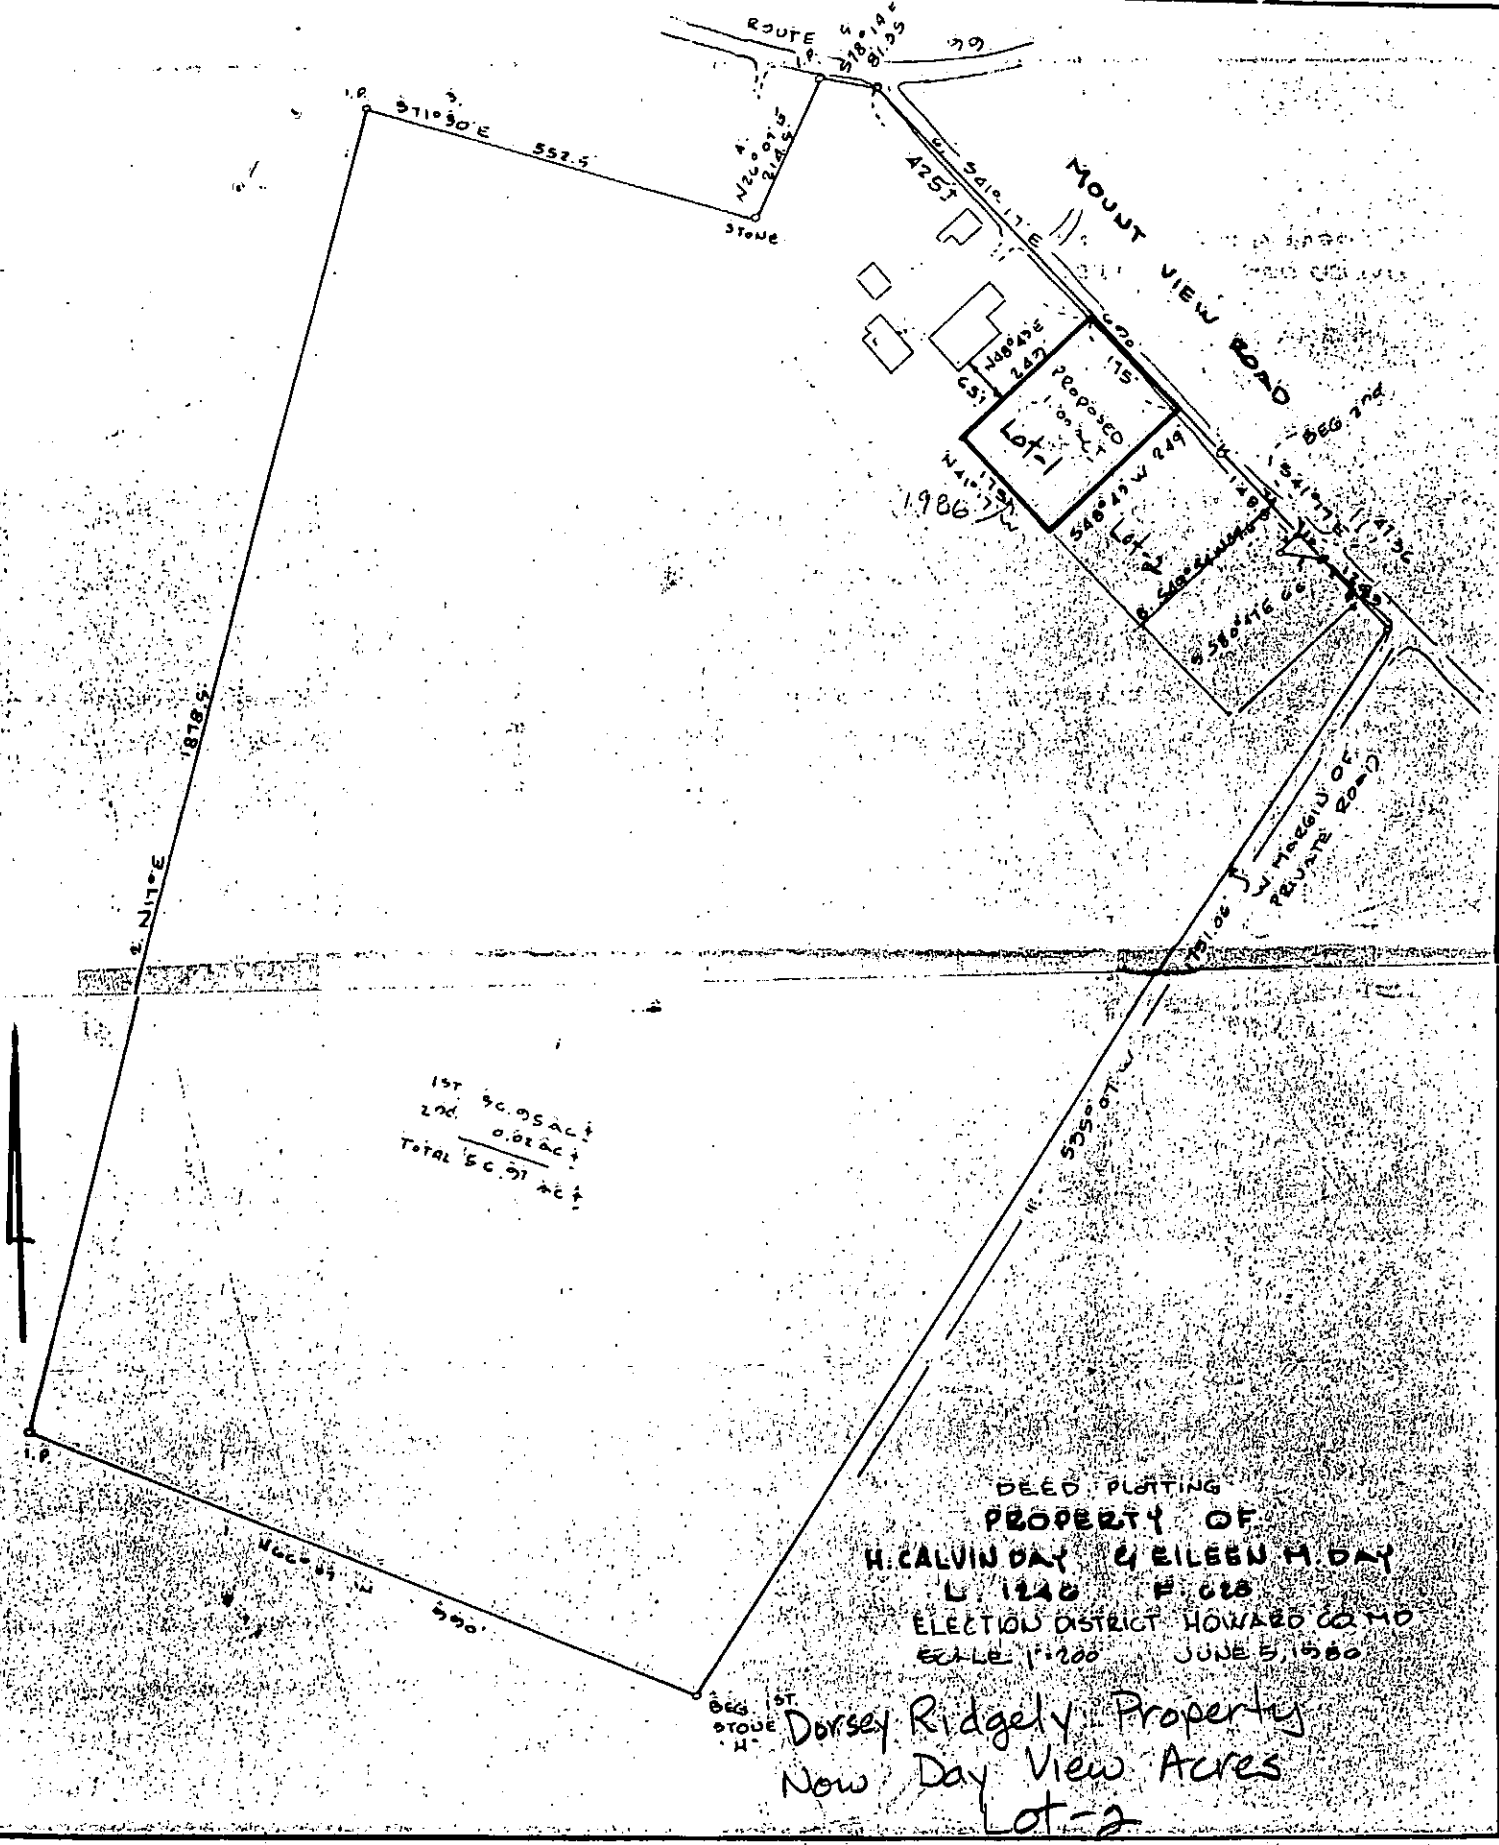

1st	90.05 AC ±
2nd	0.82 AC ±
Total	90.87 AC ±

DEED PLOTTING
 PROPERTY OF
 H. CALVIN DAY & EILEEN M. DAY
 L 1240 P 628
 ELECTION DISTRICT HOWARD CO MD
 SCALE 1"=200 JUNE 5, 1988

Dorsey Ridgely Property
 Now Day View Acres
 Lot-2


H. Calvin Day Prop.
 Map 9 Blk 24 P. 47

F-90-158

William E. Doyle

LAND SURVEYOR 5140

5317 EMERALD DRIVE SYKESVILLE, MARYLAND 21784 PHONE (301) 705-2210

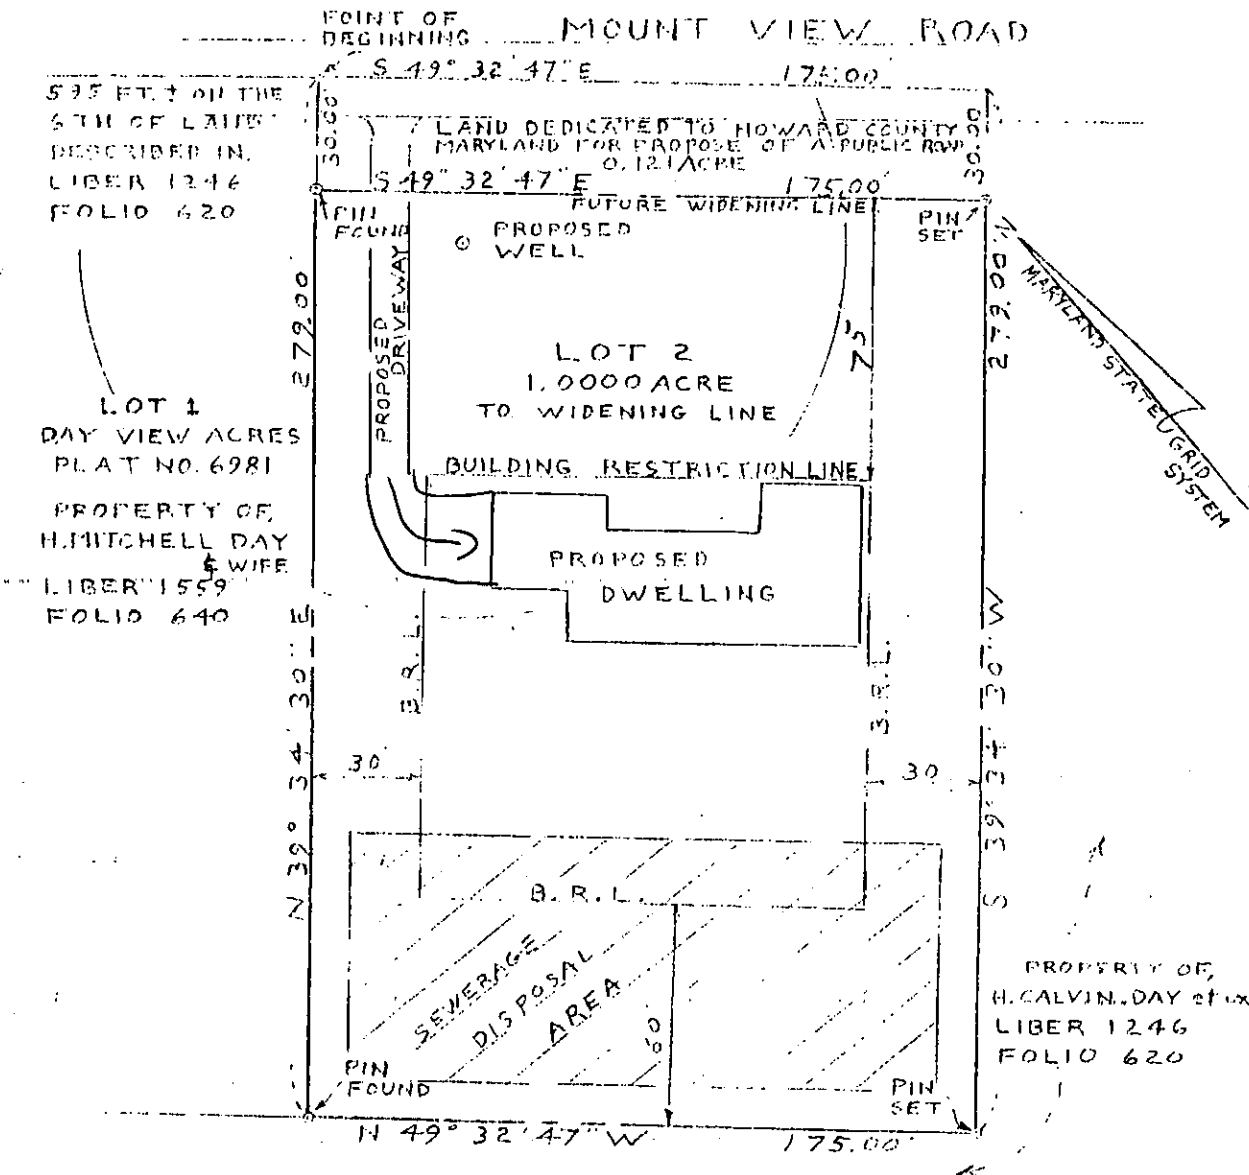

TITLE REFERENCE
 DEED DATED, MAY 1, 1984
 LIBER 1246, FOLIO 620
 HELEN L. MIHALOVICI & DORSEY RIDGELY JR.
 TO
 H. CALVIN DAY & EILEEN M. DAY
 his wife

LOT 2
 DAY VIEW ACRES
 PART OF PARCEL 47
 MOUNT VIEW ROAD
 PROPERTY OF
 H. CALVIN DAY & EILEEN M. DAY
 his wife
 ELECTION DISTRICT 3
 HOWARD COUNTY MARYLAND
 SCALE: 1" = 40'
 DRAWN: JANUARY 16, 1990




William E. Doyle

William E. Doyle

4/18/90 CRYSTAL PLEASE FILE Thanks C.B.D.

LAND SURVEYOR 8440

5312 EMERALD DRIVE SYKESVILLE, MARYLAND 21784 PHONE (301) 795-2210

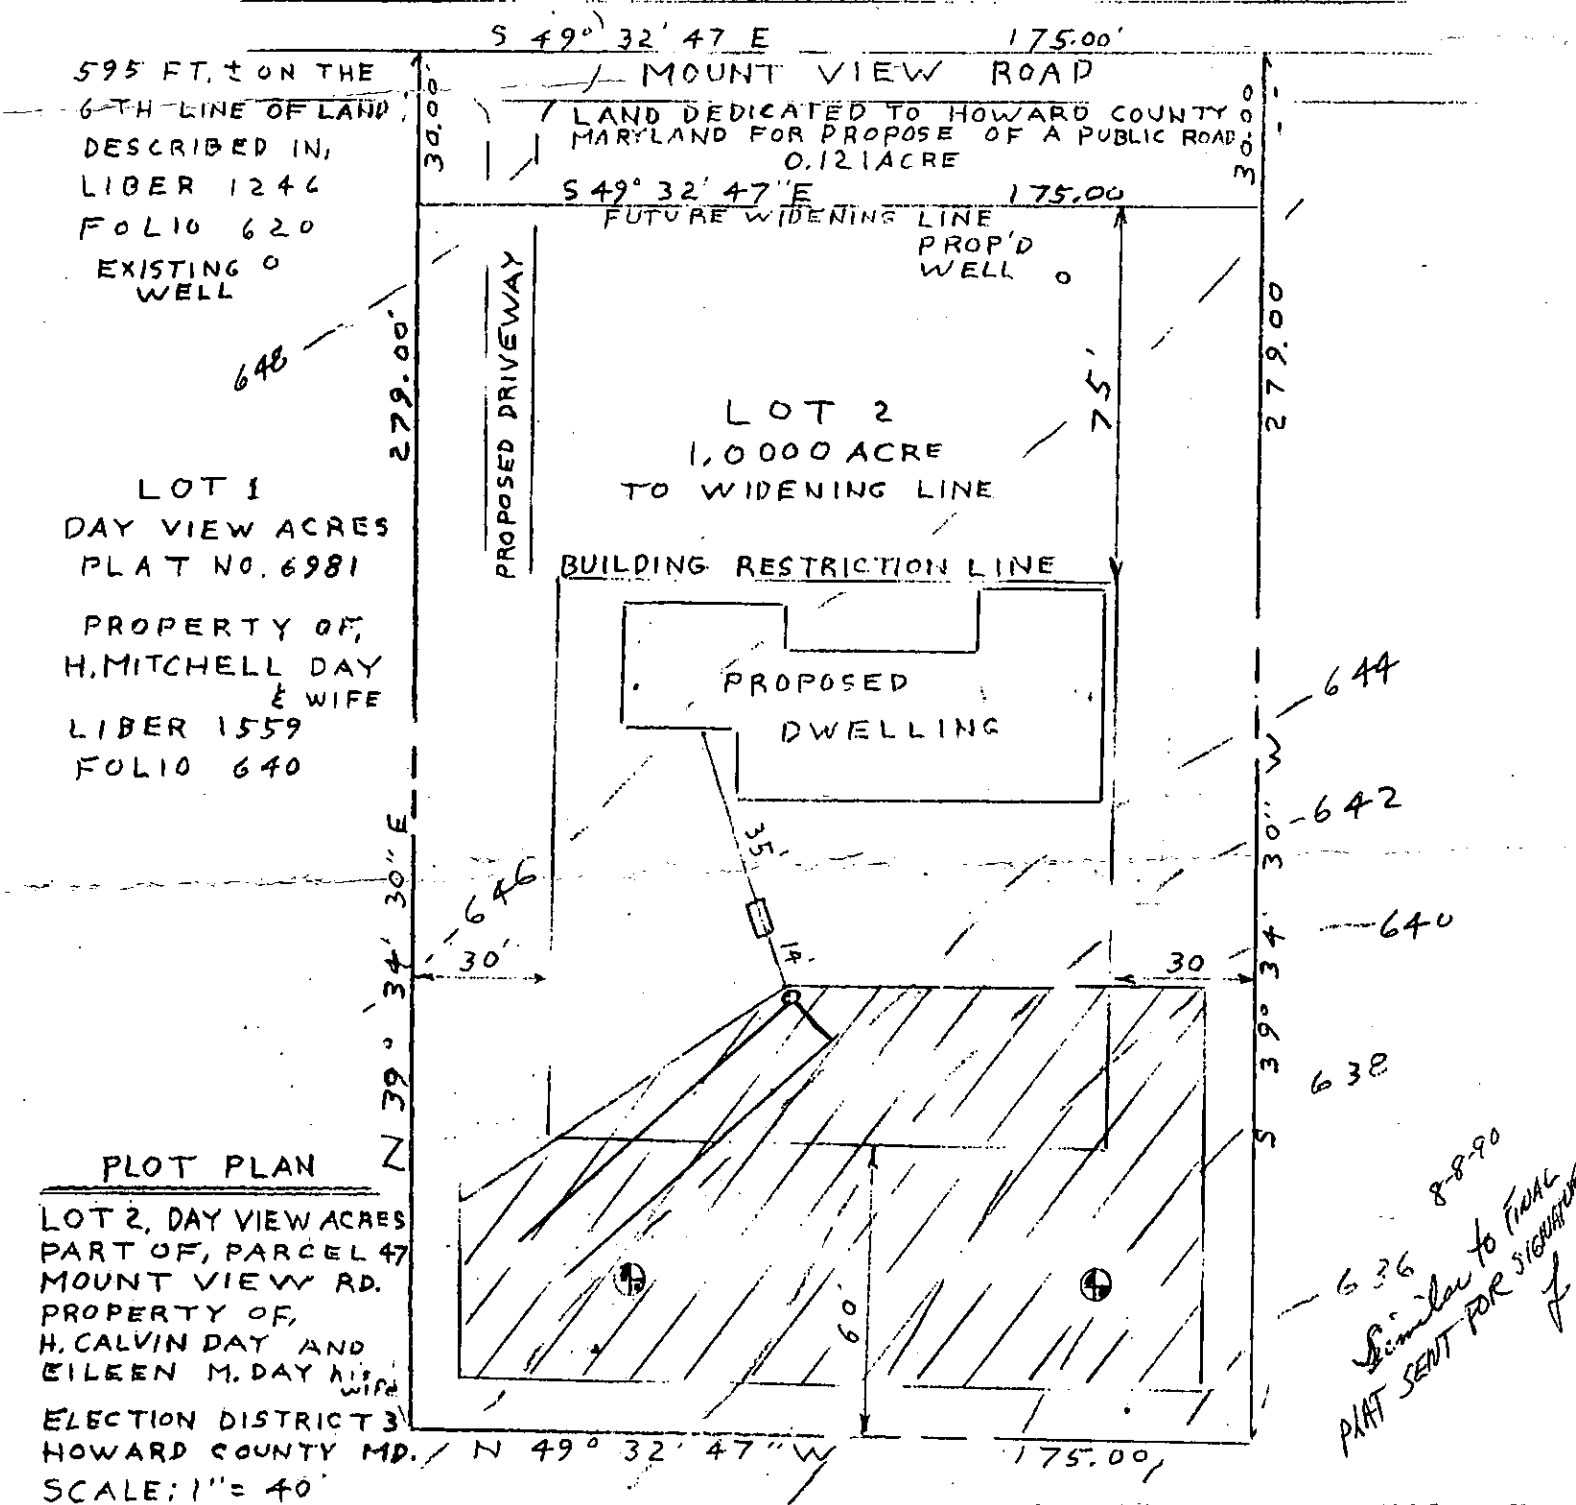

PLOT PLAN
 LOT 2, DAY VIEW ACRES
 PART OF, PARCEL 47
 MOUNT VIEW RD.
 PROPERTY OF,
 H. CALVIN DAY AND
 EILEEN M. DAY WIFE
 ELECTION DISTRICT 3
 HOWARD COUNTY MD.
 SCALE: 1" = 40'
 DRAWN: MARCH 26, 1990


EXIST, GRN. AT DISTR. BOX	644.40
INV. IN DISTR. BOX	640.90
INV. OUT OF SEPTIC TANK	641.18
INV. INTO SEPTIC TANK	641.58
INV. OUT OF DWELLING	642.28
FIRST FLOOR ELEV.	649.50
CELLAR ELEV.	640.50
WELL ELEV.	646.90
NO. OF BEDROOMS	3
ACREAGE	1.000 ACRE

APPROVED: FOR PRIVATE WATER AND PRIVATE SEWERAGE SYSTEMS
 HOWARD COUNTY HEALTH DEPARTMENT
Joseph Bodles
 SIGNATURE C.B.D. DATE 3.30.90

I CERTIFY THE ABOVE MEASUREMENTS AND ELEVATIONS ARE ACTUAL AND CORRECT FOR THIS PROPERTY.
 signed *William E. Doyle*



- THE LOT SHOWN HEREON COMPLIES WITH THE MINIMUM OWNERSHIP WIDTH AND LOT AREAS AS REQUIRED BY THE MARYLAND STATE DEPARTMENT OF HEALTH AND MENTAL HYGIENE.
- THIS AREA DESIGNATES A PRIVATE SEWERAGE EASEMENT OF APPROXIMATELY 10,000 SQUARE FEET AS REQUIRED BY THE MARYLAND STATE DEPARTMENT OF HEALTH AND MENTAL HYGIENE, FOR INDIVIDUAL SEWERAGE DISPOSAL. IMPROVEMENTS OF ANY NATURE IN THIS AREA ARE RESTRICTED UNTIL PUBLIC SEWERAGE IS AVAILABLE AND SERVICING ANY RESIDENTIAL STRUCTURES CONSTRUCTED ON THESE BUILDING SITES. THESE EASEMENTS SHALL BECOME NULL AND VOID UPON CONNECTION TO A PUBLIC SEWERAGE SYSTEM.
- ALL PERCOLATION TEST HOLES SHOWN HEREON HAVE BEEN FIELD LOCATED, SHOWN THUS (O).
- DEED REFERENCE: Liber: 1246 / Folio: 620

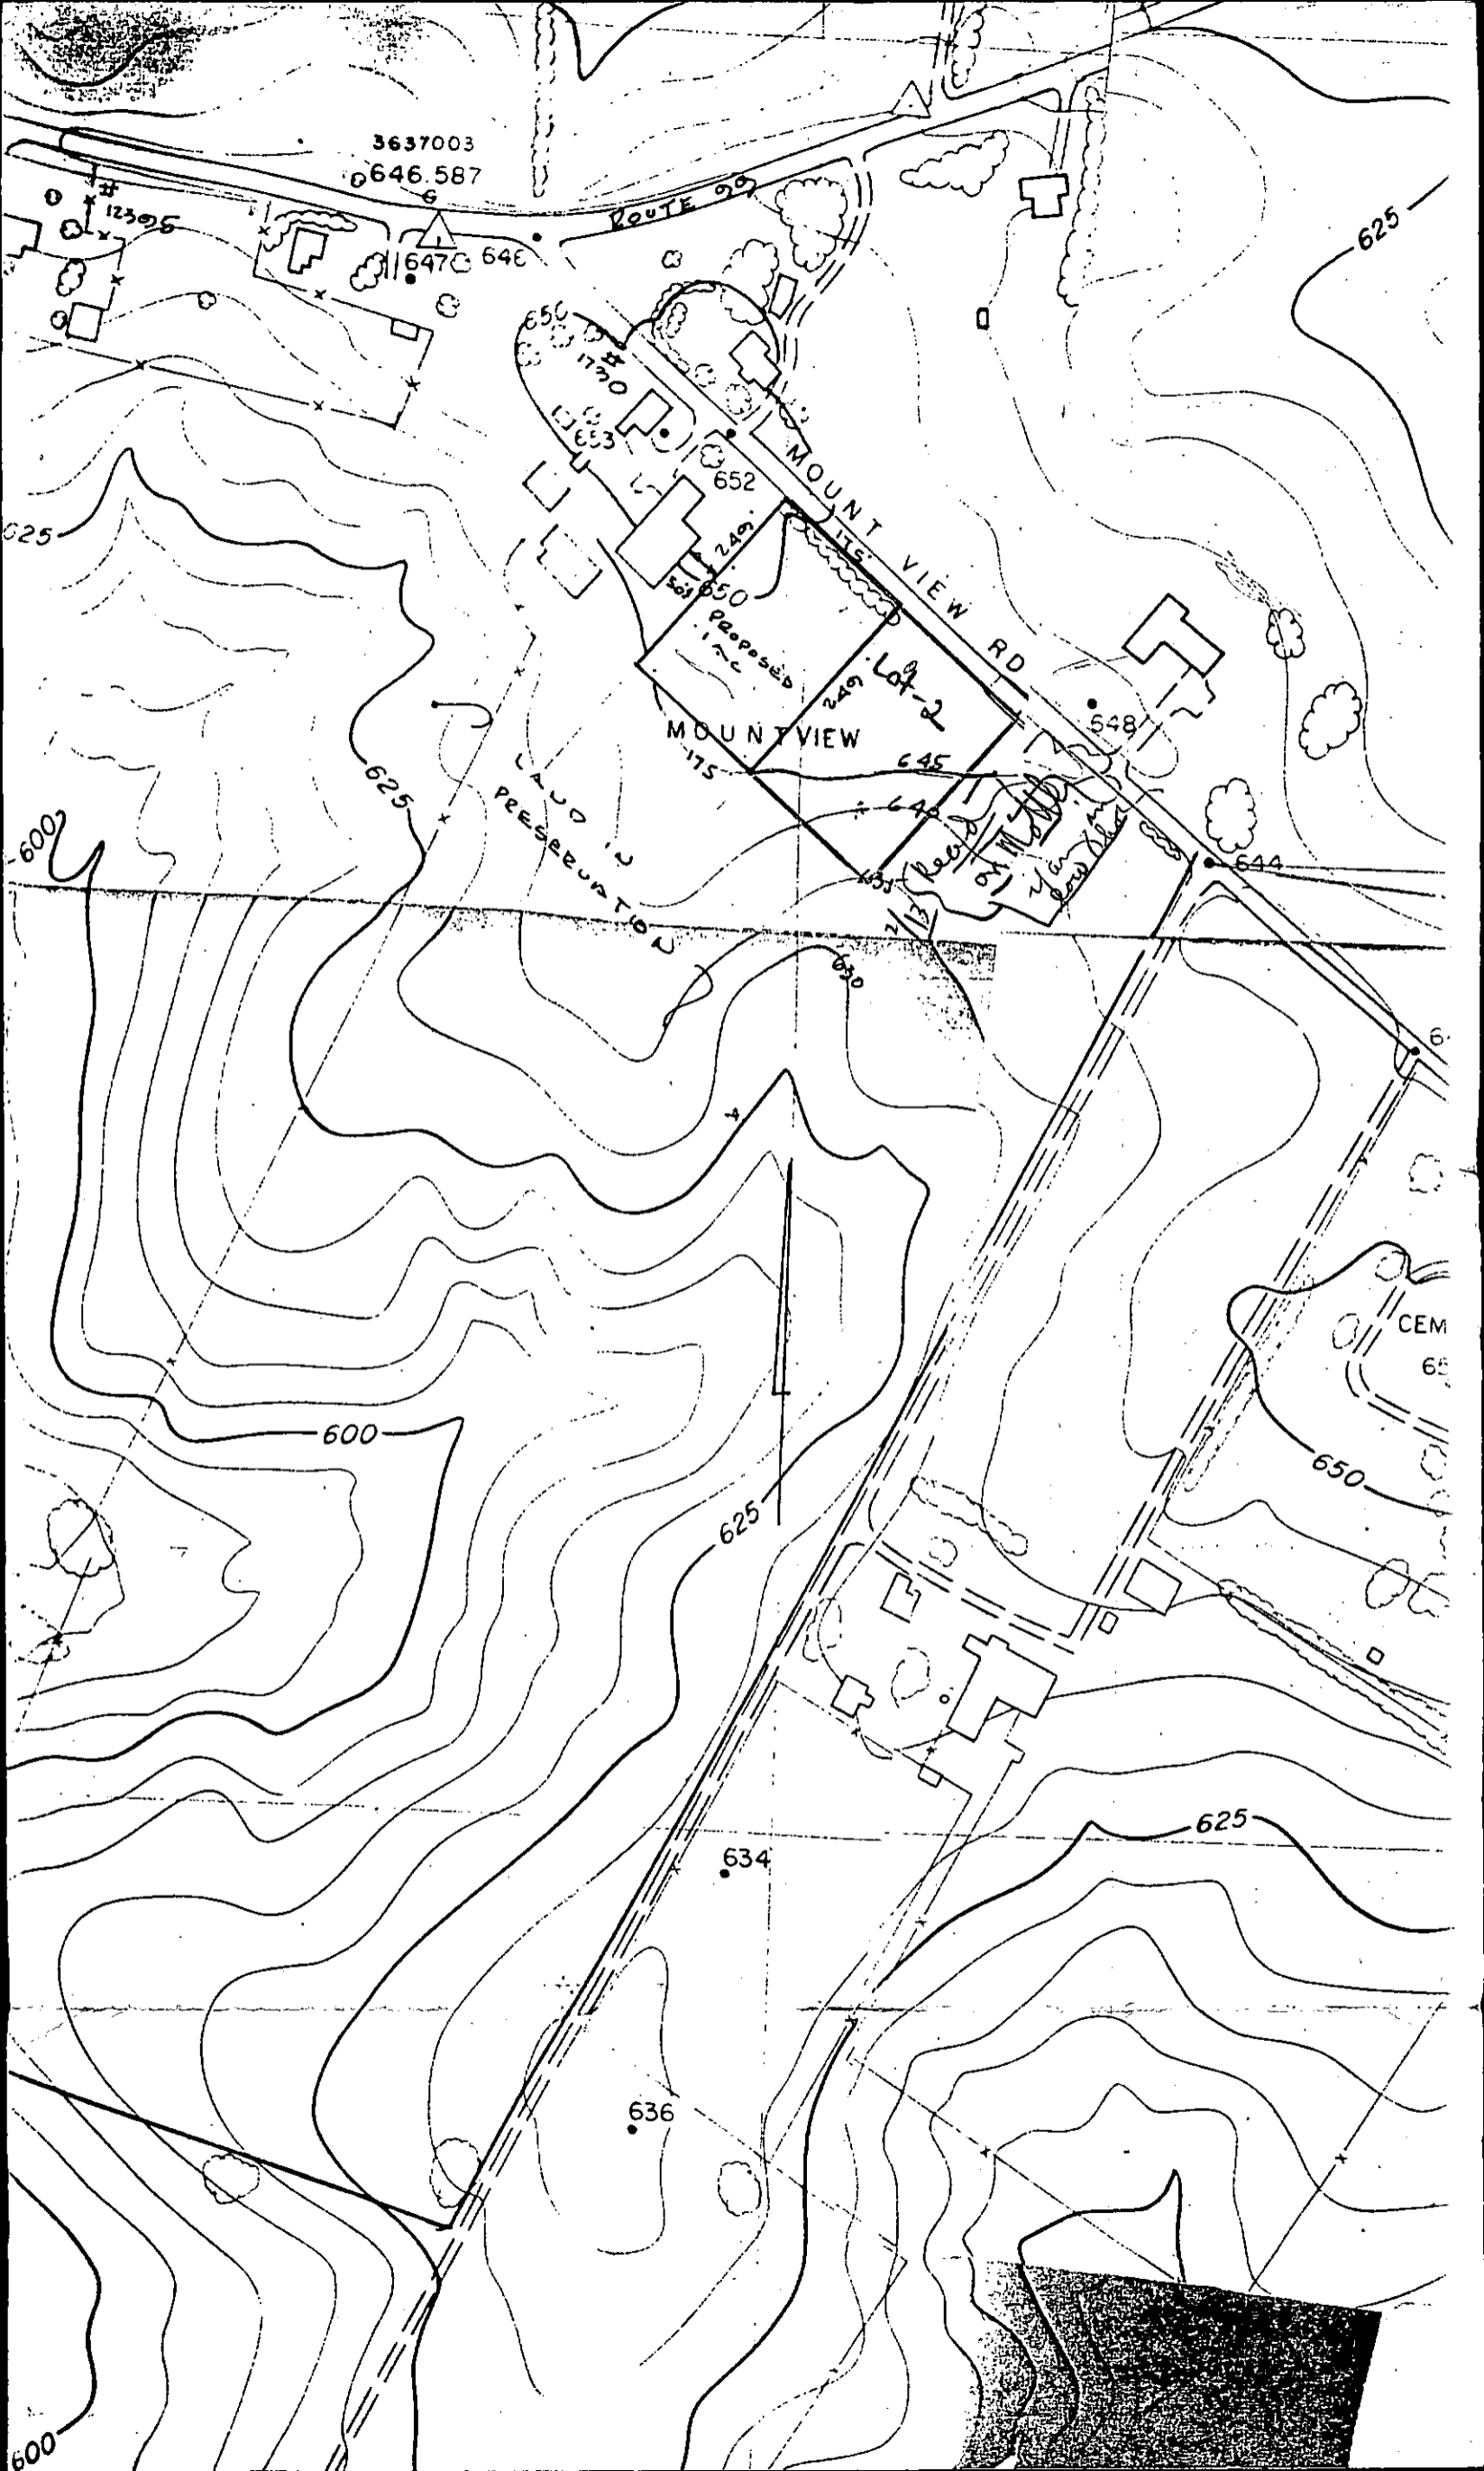

3637003

646.587

ROUTE 99

647C 64E

625

MOUNT VIEW RD

MOUNT VIEW

LAND PRESERVATION

Lot-2

CEM

600

625

650

625

634

636

600

ADJACENT

LOT 2

HUBBARD ASSOCIATES
251 JOSEPH SQUARE
COLUMBIA, MD 21044

DISTRIBUTION BOX
EXISTING ELEV. 651.3 ✓
INVERT 647.8 ✓ 647.3


TANK
EXISTING ELEV. 651.4 ✓
INVERT OUT 648.0 ✓
INVERT IN 648.3 ✓

INVERT @ HOUSE 648.5 ✓

BLDG. PERMIT SIGNED
AND RETURNED 2/9/98

71520

N 41°17' W 175.00'

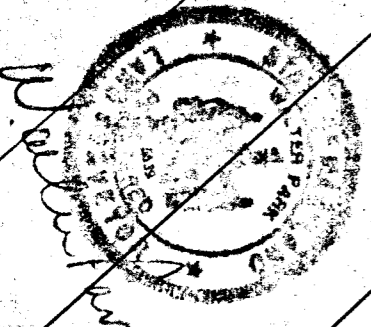

PROPOSED NEW LOT
P6nc TEST
DATE
2/13/98

PROPOSED 1 Acre
H. CALVIN DAY PROPERTY
L. 1746 F. 628
REMAINDER FACIL INTO FARM PRESERVATION
ELECTRIC DISTRIBUTION HOWARD CO. MD
SCALE 1"=20'
JANUARY, 1986

New
Lot
2/13/98

CALVIN DAY PROPERTY
Replacement well
HP-88-002
NO SAMPLE LOT

N 48°43' E
40-81-1560

249.00'

Well Pump & GROUT on 6/27

INLET 4"
BOTTOM 8"
158' DIAM


Elevations OK
Changes noted and copy
sent to Mr. Day

2/13/98
8:00 AM

ROUTE
909


MOUNT VIEW ROAD

F-87-56

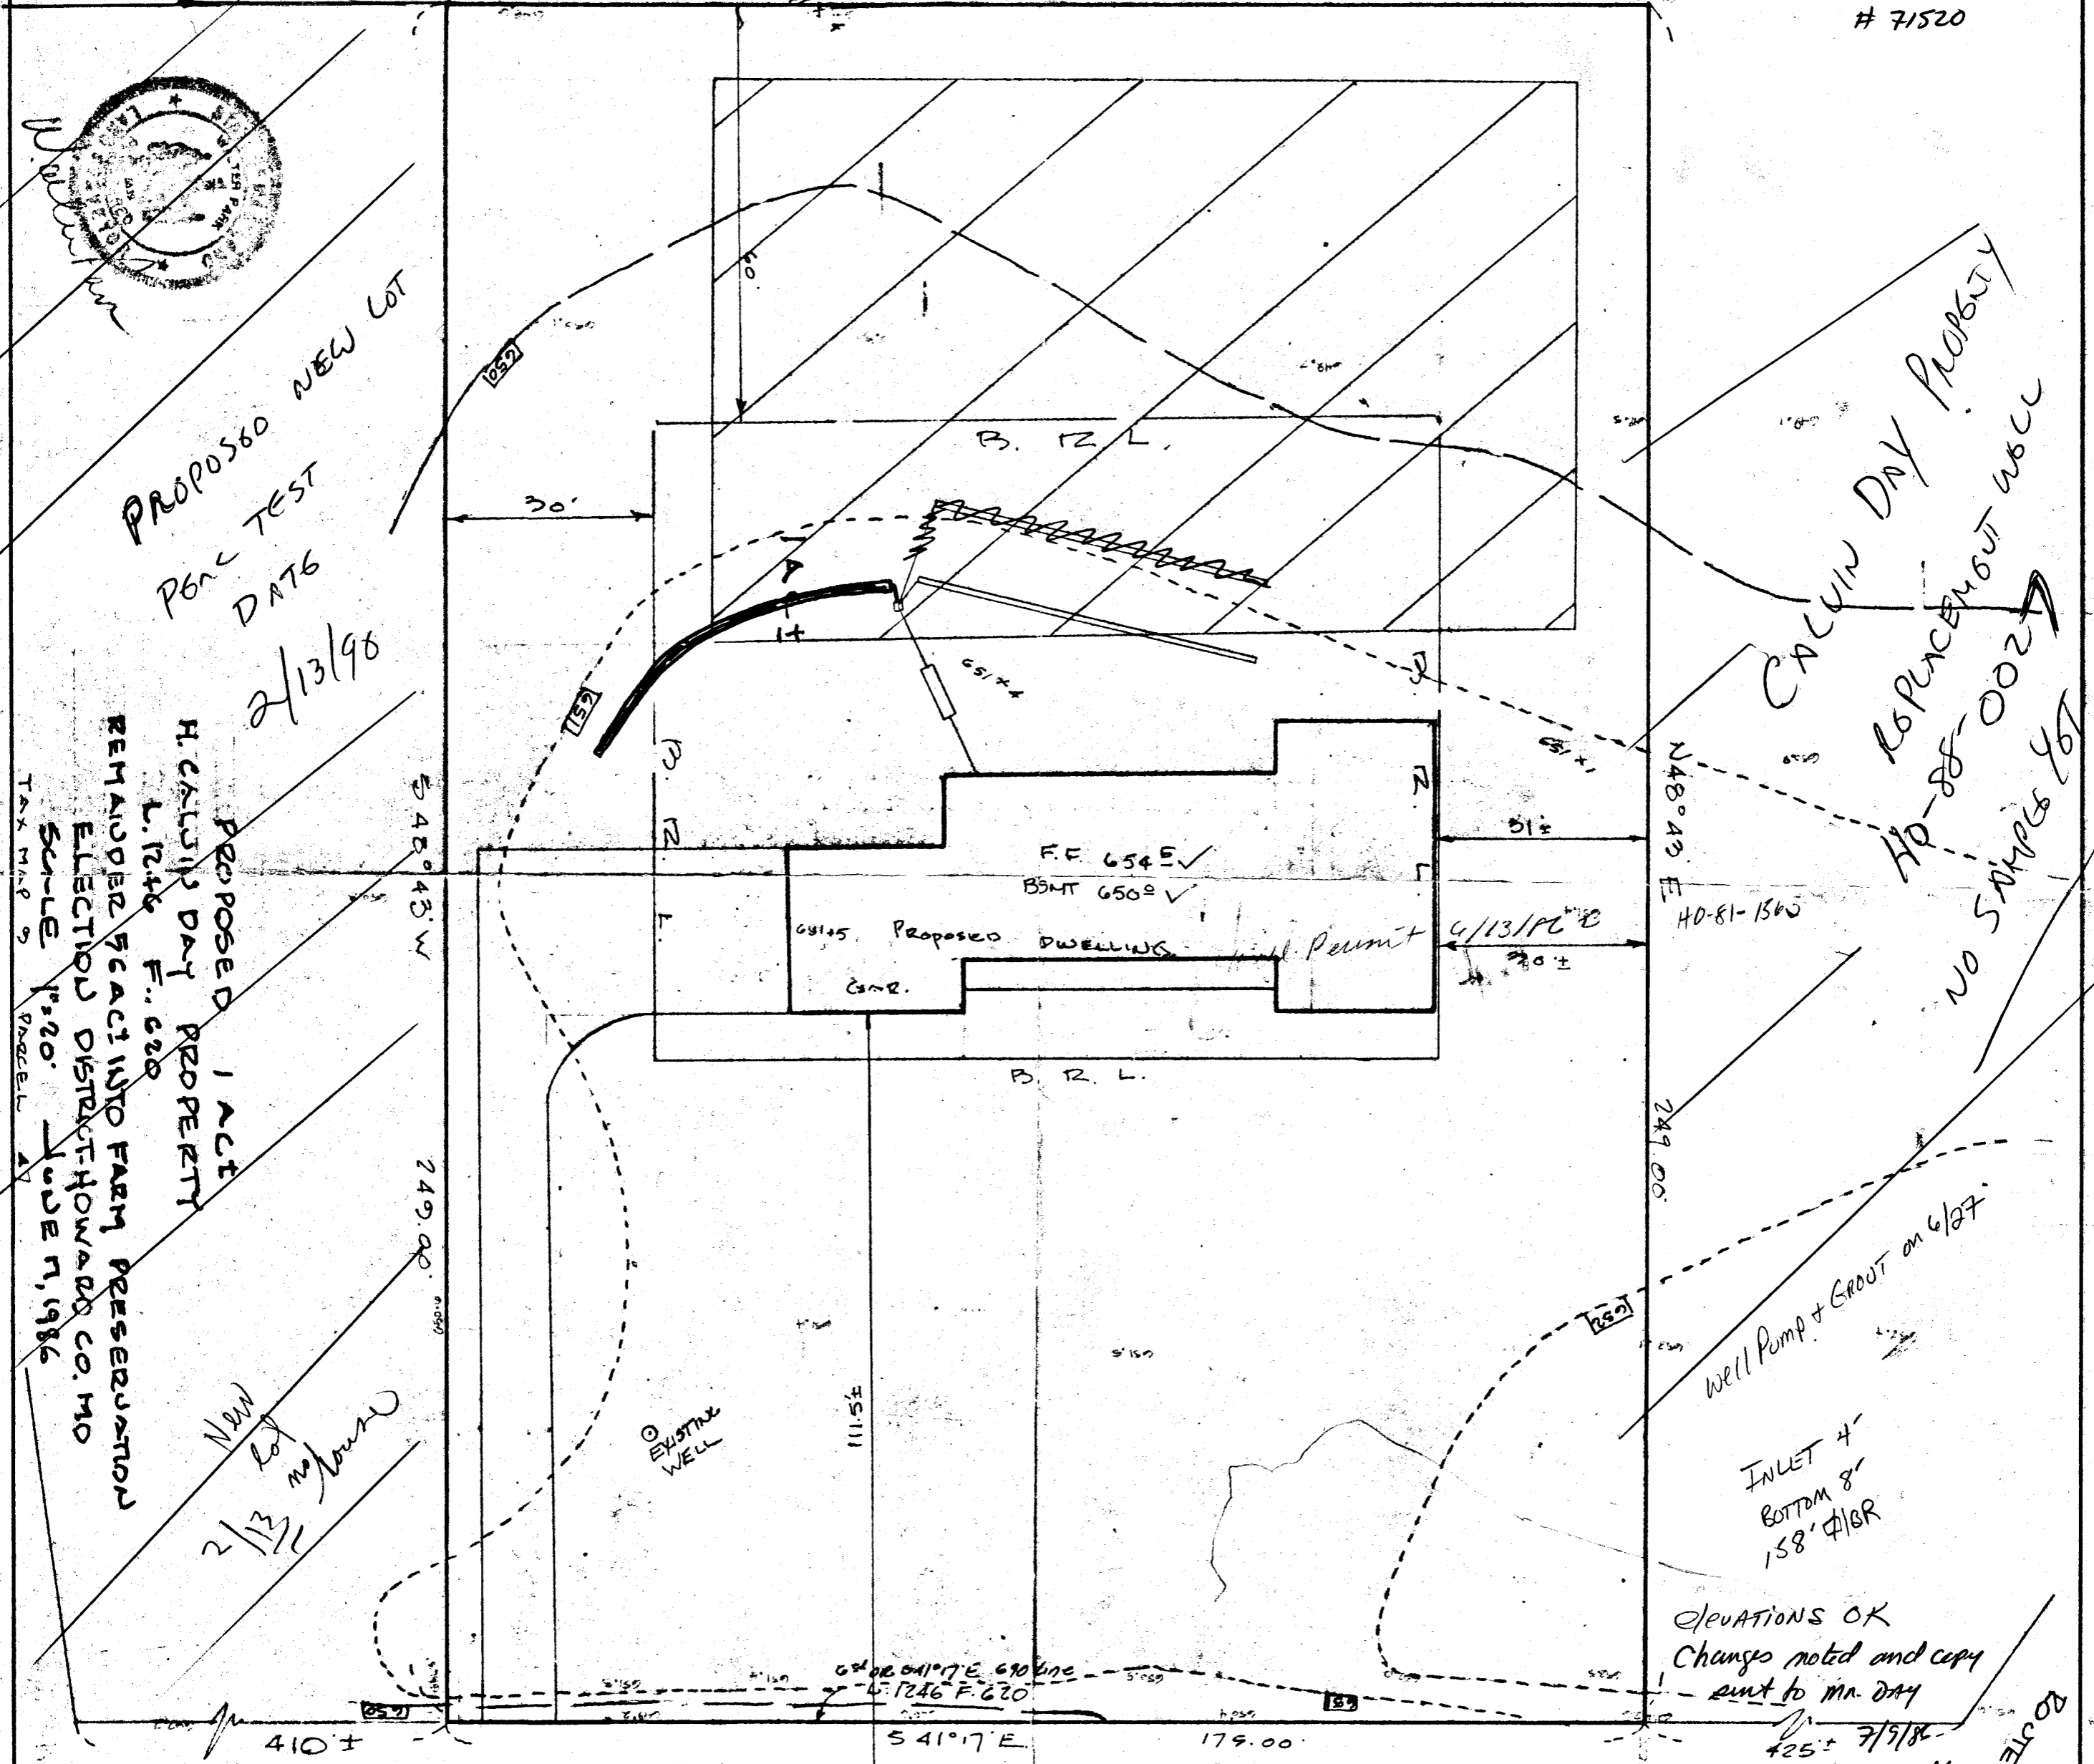


COORDINATE SCHEDULE		
NO.	NORTH	EAST
1	540361.0540	817130.8555
2	540247.5083	817264.0185
3	540224.3846	817244.9058
4	540032.4576	817086.2710
5	540146.0032	817953.1080
6	540337.9302	817111.7428


COORDINATES SHOWN HEREON ARE BASED ON THE MARYLAND STATE GRID SYSTEM AS PROJECTED BY HOWARD COUNTY GEODETIC CONTROL STATION 3637003

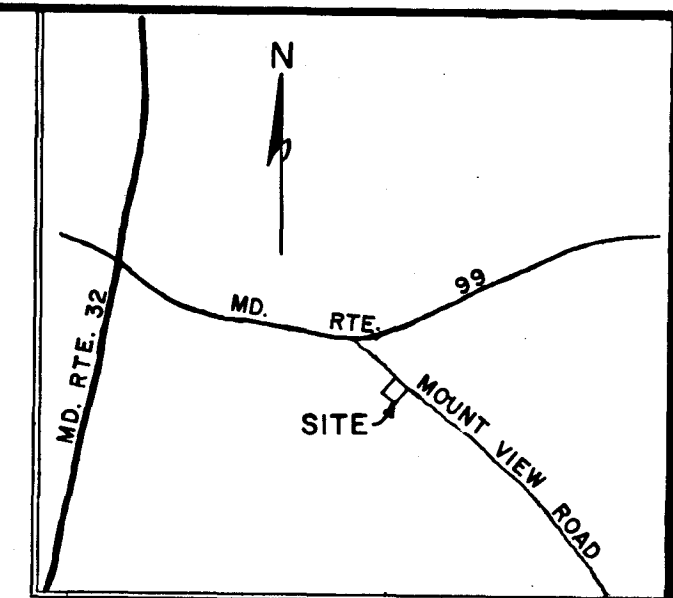

VICINITY MAP
SCALE: 1"=2000'

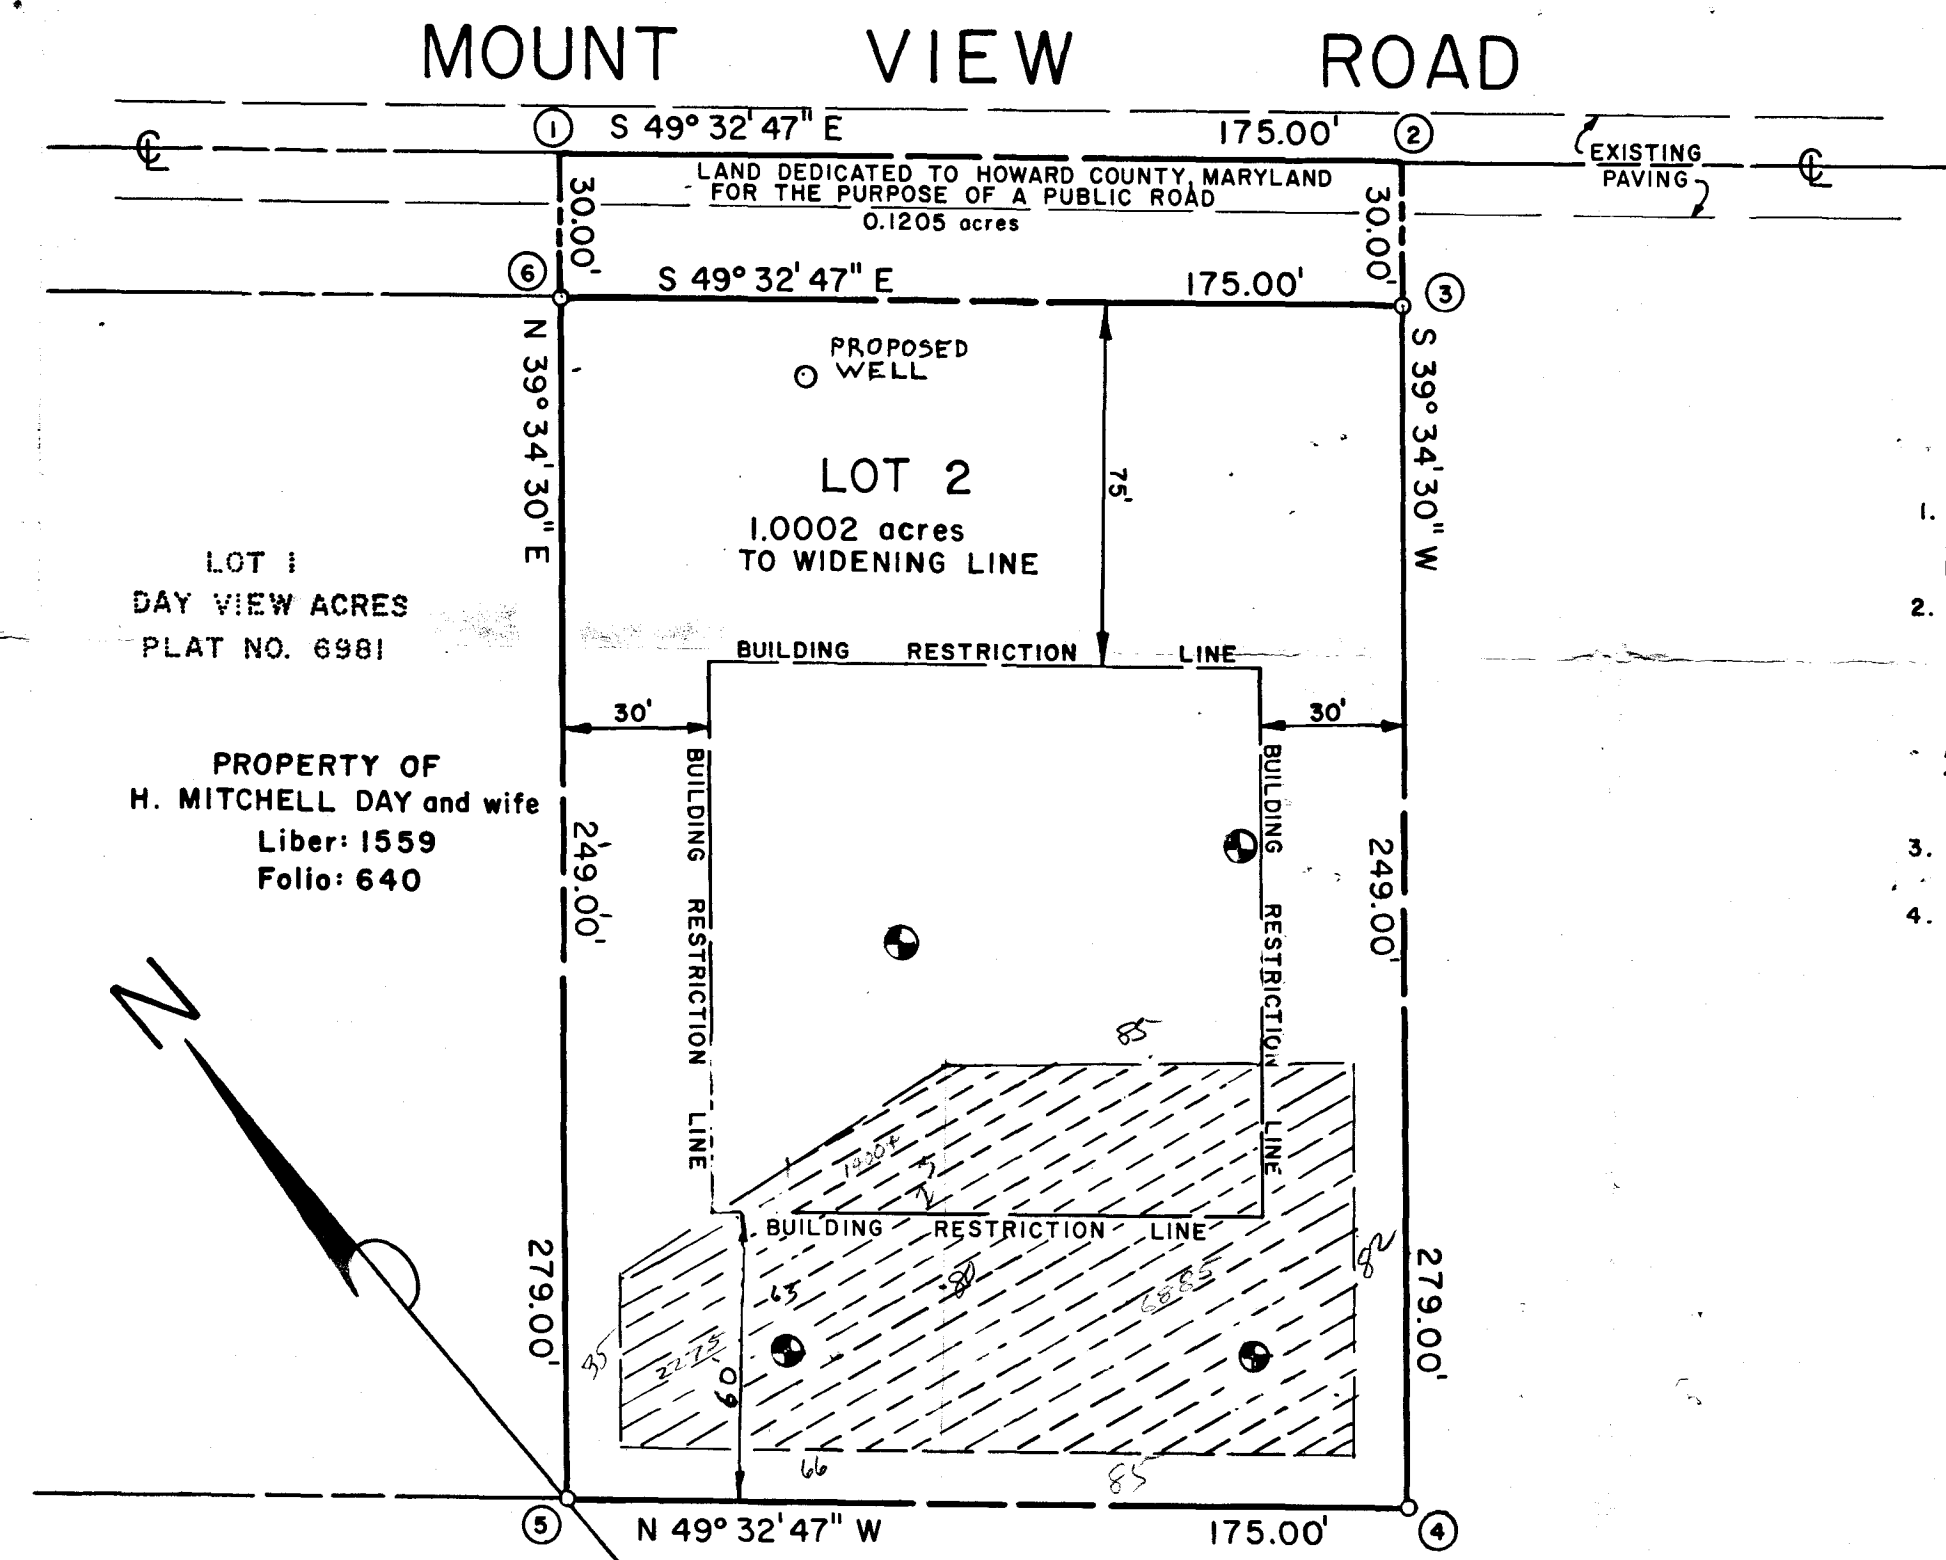

GENERAL NOTES

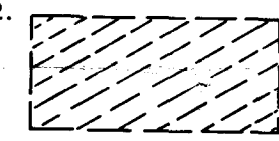1. THE LOT SHOWN HEREON COMPLIES WITH THE MINIMUM OWNERSHIP WIDTH AND LOT AREAS AS REQUIRED BY THE MARYLAND STATE DEPARTMENT OF HEALTH AND MENTAL HYGIENE.
2.  THIS AREA DESIGNATES A PRIVATE SEWERAGE EASEMENT OF APPROXIMATELY 10,000 SQUARE FEET AS REQUIRED BY THE MARYLAND STATE DEPARTMENT OF HEALTH AND MENTAL HYGIENE, FOR INDIVIDUAL SEWERAGE DISPOSAL. IMPROVEMENTS OF ANY NATURE IN THIS AREA ARE RESTRICTED UNTIL PUBLIC SEWERAGE IS AVAILABLE AND SERVICING ANY RESIDENTIAL STRUCTURES CONSTRUCTED ON THESE BUILDING SITES. THESE EASEMENTS SHALL BECOME NULL AND VOID UPON CONNECTION TO A PUBLIC SEWERAGE SYSTEM.
3. ALL PERCOLATION TEST HOLES SHOWN HEREON HAVE BEEN FIELD LOCATED, SHOWN THUS (O).
4. DEED REFERENCE: Liber: 1246 Folio: 620

*For Approval
Sept
Mt. View Rd.*

AREA TABULATIONS

TOTAL NUMBER OF LOTS: 1
 TOTAL AREA OF LOT: 1.0002 acres
 TOTAL AREA OF RIGHT OF WAY DEDICATION: 0.1205 acres
 TOTAL AREA OF FLOOD PLAIN DEDICATION: NONE
 TOTAL AREA OF THIS PLAT: 1.1207 acres

APPROVED: FOR PRIVATE WATER AND PRIVATE SEWERAGE SYSTEMS.
 HOWARD COUNTY HEALTH DEPARTMENT

APPROVED: HOWARD COUNTY OFFICE OF PLANNING AND ZONING

APPROVED: FOR STORM DRAIN SYSTEMS AND PUBLIC ROADS.
 HOWARD COUNTY DEPARTMENT OF PUBLIC WORKS.

OWNERS CERTIFICATE

WE, H. CALVIN DAY AND EILEEN M. DAY, HIS WIFE, OWNERS OF THE PROPERTY SHOWN AND DESCRIBED HEREON, HEREBY ADOPT THIS PLAN OF SUBDIVISION AND IN CONSIDERATION OF THE APPROVAL OF THIS FINAL PLAT BY THE OFFICE OF PLANNING AND ZONING, ESTABLISH THE MINIMUM BUILDING RESTRICTION LINES. ALL EASEMENTS OR RIGHT OF WAYS AFFECTING THIS PROPERTY ARE INCLUDED IN THIS PLAN OF SUBDIVISION.

OWNER: _____ DATE _____
 H. CALVIN DAY

OWNER: _____ DATE _____
 EILEEN M. DAY

WITNESS: _____ DATE _____

SURVEYORS CERTIFICATE

I HEREBY CERTIFY THAT THE FINAL PLAT SHOWN HEREON IS CORRECT, THAT IT IS A SUBDIVISION OF PART OF THAT LAND CONVEYED BY HELEN LEE MIHALOVICI AND B. DORSEY RIDGELY JR., PERSONAL REPRESENTATIVES OF THE ESTATE OF B. DORSEY RIDGELY UNTO H. CALVIN DAY AND EILEEN M. DAY, HIS WIFE, BY DEED DATED MAY 1, 1984, ETC., AND RECORDED AMONG THE LAND RECORDS OF HOWARD COUNTY, MARYLAND IN LIBER 1246, FOLIO 620, ETC. AND THAT ALL MONUMENTS ARE IN PLACE AS SHOWN IN ACCORDANCE WITH THE ANNOTATED CODE OF MARYLAND, AS AMENDED.

WILLIAM E. DOYLE REGISTERED LAND SURVEYOR 8440
 DATE _____



WILLIAM E. DOYLE
 REGISTERED LAND SURVEYOR 8440
 5312 EMERALD DRIVE
 SYKESVILLE, MARYLAND 21784
 PHONE: (301) 795-2210

RECORDED AS PLAT NO. _____ ON _____
 AMONG THE LAND RECORDS OF HOWARD COUNTY, MD.

LOT 2
DAY VIEW ACRES
 TAX MAP 9 PARCEL 47
 ELECTION DISTRICT 3
 HOWARD COUNTY, MARYLAND
 SCALE: 1"=40' DRAWN: FEBRUARY 31, 1990