

B 1 8511

SEQUENCE NO. (MDE USE ONLY)

STATE OF MARYLAND PERMIT TO DRILL WELL please print or type

STATE PERMIT NUMBER

HO - 94 - 1910 fill in this form completely

Date Received (APA)

OWNER INFORMATION

8 MM DD YY 13

Borke Joseph Last Name Owner First Name

414 Timbercove Circle Street or RFD

Longwood FL 32779 Town State Zip

B 3 LOCATION OF WELL

8 COUNTY HOWARD 21 CARRIAGE MILL FARMS 23 SUBDIVISION 42

SECTION 44 46 LOT 36 48 50

52 NEAREST TOWN COOKSVILLE 71

MILES FROM TOWN (enter 0 if in town) 1 M 73 76 77 78

DRILLER INFORMATION


David Kelly M W D 304 Driller's Name License No.

Jones Well Drilling Inc Firm Name

3700 Rush Rd JARRETSVILLE 21084 Address

David Kelly 10-13-98 Signature Date

B 4 1 2 DIRECTION OF WELL FROM TOWN (CIRCLE BOX)

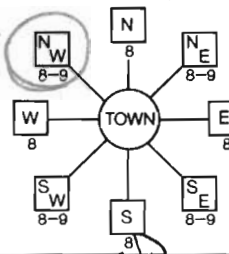

CARRIAGE MILL DR 11 NEAR WHAT ROAD 30

ON WHICH SIDE OF ROAD (CIRCLE APPROPRIATE BOX) NORTH 32 EAST WEST SOUTH

34 500 37 DISTANCE FROM ROAD ENTER FT OR MI 38 39

TAX MAP: 8 BLK: PARCEL 158

B 2 WELL INFORMATION

APPROX. PUMPING RATE (GAL. PER MIN.) 8 4 12

AVERAGE DAILY QUANTITY NEEDED (GAL. PER DAY) 14 400 20

USE FOR WATER (CIRCLE APPROPRIATE BOX)

- D DOMESTIC POTABLE SUPPLY & RESIDENTIAL IRRIGATION
F FARMING (LIVESTOCK WATERING & AGRICULTURAL IRRIGATION)
I INDUSTRIAL, COMMERCIAL, DEWATERING
P PUBLIC WATER SUPPLY WELL
T TEST, OBSERVATION, MONITORING
G GEO-THERMAL

NOT TO BE FILLED IN BY DRILLER HEALTH DEPARTMENT APPROVAL

HOWARD A43347 COUNTY NAME COUNTY NO.

STATE SIGNATURE INSERT S 41

DATE ISSUED 10/23/98 CO SIGNATURE EXP. DATE

NORTH GRID 544 000 EAST GRID 0793 000

APPROXIMATE DEPTH OF WELL 200 FEET

APPROXIMATE DIAMETER OF WELL 6 NEAREST INCH

METHOD OF DRILLING (circle one)

- BORED (or Augered) JETTED Jetted & DRIVEN
AIR-ROTary AIR-PERCussion ROTARY (Hydraulic Rotary)
CABLE REVERSE-ROTary DRIVE-POINT
other

REPLACEMENT OR DEEPEMED WELLS (CIRCLE APPROPRIATE BOX)

- N THIS WELL WILL NOT REPLACE AN EXISTING WELL
Y THIS WELL WILL REPLACE A WELL THAT WILL BE ABANDONED AND SEALED
S THIS WELL WILL REPLACE A WELL THAT WILL BE USED AS A STANDBY-CONTACT LOCAL APPROVING AUTHORITY FOR POLICY ON STANDBY WELLS
D THIS WELL WILL DEEPEMED AN EXISTING WELL

PERMIT NUMBER OF WELL TO BE REPLACED OR DEEPEMED (IF AVAILABLE) 41 52

Not to be filled in by driller (MDE OR COUNTY USE ONLY)

APPROX. PERMIT NUMBER 54 G A P 63

PERMIT No. HO - 94 - 1910

SPECIAL CONDITIONS

NOTE - APPROVING AUTHORITIES SHOULD USE SEPARATE SHEET IF NEEDED

SHOW MAJOR FEATURES OF BOX & LOCATE WELL WITH AN X

SOURCES OF DRILLING WATER 1. 2. 3.

WRITE THE BOX NUMBER FROM THE MAP HERE

E 790 3 N 540 4

DRAW A SKETCH BELOW SHOWING LOCATION OF WELL IN RELATION TO NEARBY TOWNS AND ROADS AND GIVE DISTANCE FROM WELL TO NEAREST ROAD JUNCTION






BALTIMORE NATIONAL PIKE  
 (I-70)  
 SHA Plots 42060, 42581, 42596 & 9268

Open Space Lot 33  
 CHANGED  
 COMMON LOT LINE  
 F 99-154 5/6/99

Farms - Phase 2"  
 13558

Use-in-common Ingress & Egress  
 for Lots 35, 36 & 37. Maintenance  
 recorded in the Land Records  
 County, MD  
 of 55, 56 & 37)

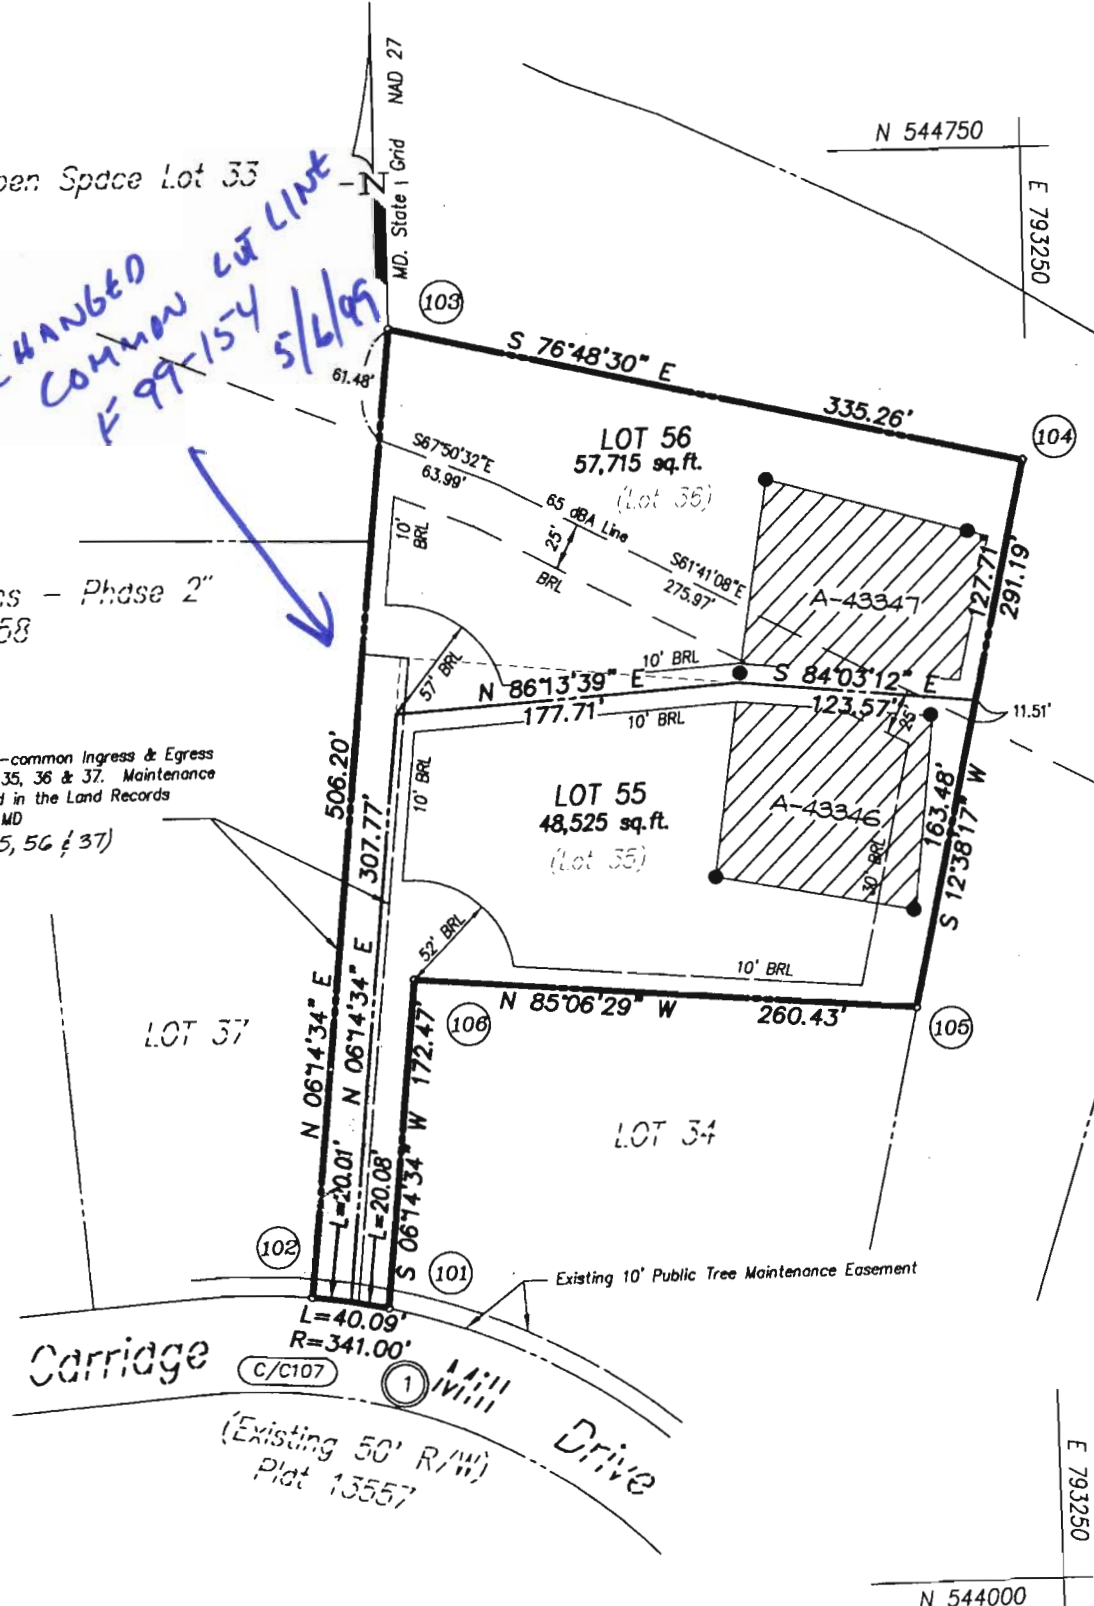

Open Space Lot 33

"Carriage Mill Farms - P.  
 Plat 13559

17. The 65 dBA noise contour (decibel) noise exposure per year 2010 based upon as value represents the average of vehicular traffic during Highway Administration e. line drawn on this plat is Chapter 5, Revised Febru. 65 dBA exposure.

18. FOR ALL APPLICABLE