


A# 07404

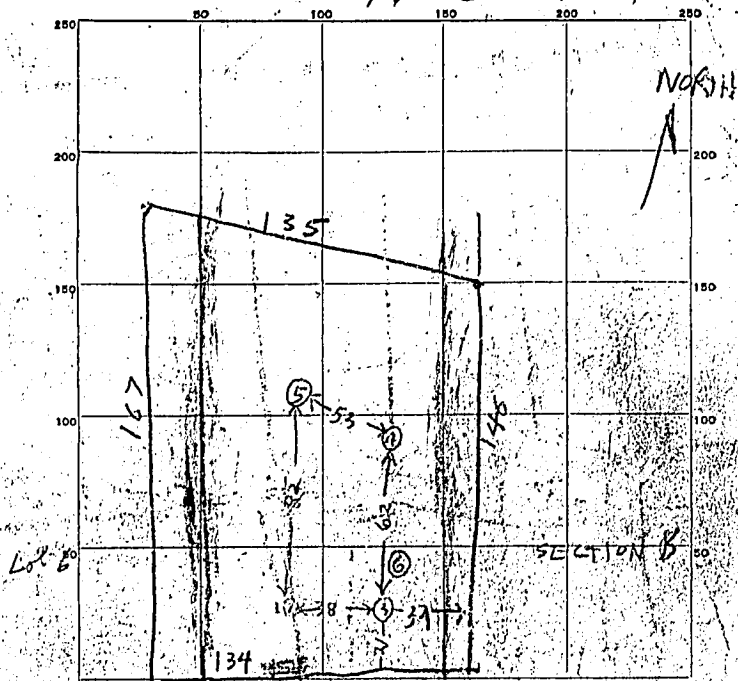

INDICATE NORTH, NAME ADJOINING ROADWAY AS BASE LINE.

CARROLL AVE T2. RT 32

DATE	TEST NO.	DEPTH	PRE-WET		TEST - 1" DROP		TIME
			START	STOP	START	STOP	
10/2/68	1	9 1/2	1025	1037	1037	1050	13
"	2	6	1029	1120	1120	1130	34
"	3	3	1042	1105	1105	1130	30
"	4	3	1055	1110	1110	1154	44
"	5	3	1109	1205	1205	1205	52
"	6	9	1145	1153	1153	1203	10

SOIL AUGER FINDING

TESTED BY *Raymond Hodges*

REMARKS

ALSO PRESENT LOT NO.