

8/31/71  
Fancy

blgd. permit  
signed 6/26/78

# PERMIT

SEWAGE DISPOSAL SYSTEM

MARYLAND STATE DEPARTMENT OF HEALTH

HOWARD COUNTY

## INDEXED

ELLICOTT CITY

DISTRICT 3

DATE 8/27/71

P 16250

A 13003

Jack Fyock IS PERMITTED TO INSTALL X ALTER

ADDRESS Ten Oaks Road, Glenolg, Md. PHONE 286-2939

A SEWAGE DISPOSAL SYSTEM LOCATED AT

12237 Carroll Mill Rd

SUBDIVISION Woodmark ROAD Pointer Hill Ct. LOT 22, Blk. B,

PROPERTY OWNER Anderson Appel, Wm. Sec. 2

ADDRESS 988-9298

SPECIFICATIONS - 5 bedrooms

DRAIN FIELD \_\_\_\_\_ DEPTH \_\_\_\_\_ FEET. BOTTOM AREA \_\_\_\_\_ SQ. FT.

SEEPAGE PITS \_\_\_\_\_ ABSORBENT SIDE-WALL AREA \_\_\_\_\_ SQ. FT.

SEPTIC TANK CAPACITY 1,800 GALLONS

FOR GARBAGE GRINDER, INCREASE DISPOSAL AREA 22% & TANK CAPACITY 50%.

OTHER Dry well - 100 sq. ft. absorbent sidewall area per bedroom to begin

below inlet pipe. Inlet 4 ft. Max. depth for dry well below original grade

is 13 ft. Place dry well 45 ft. from rear lot line and 45 ft. from right side line as

seen when facing from Pointer Hill Court.

PERMIT VOID AFTER THREE YEARS.

NOTE: ALL PIPE FROM HOUSE TO SEPTIC TANK MUST BE CAST IRON.

NOTE: INSTALL STAND PIPE ON SEPTIC TANK AND DRY WELL.


PLANS APPROVED BY D. W. Monaghan DATE 3/12/68

FILL SEPTIC TANK AND DISTRIBUTION BOX WITH WATER BEFORE CALLING FOR AN INSPECTION. COVER NO WORK UNTIL INSPECTED AND APPROVED.

NEITHER THE HOWARD COUNTY COMMISSIONERS NOR THE HEALTH DEPARTMENT IS RESPONSIBLE FOR THE SUCCESSFUL OPERATION OF ANY SYSTEM.

A 13003

11  
129  
01

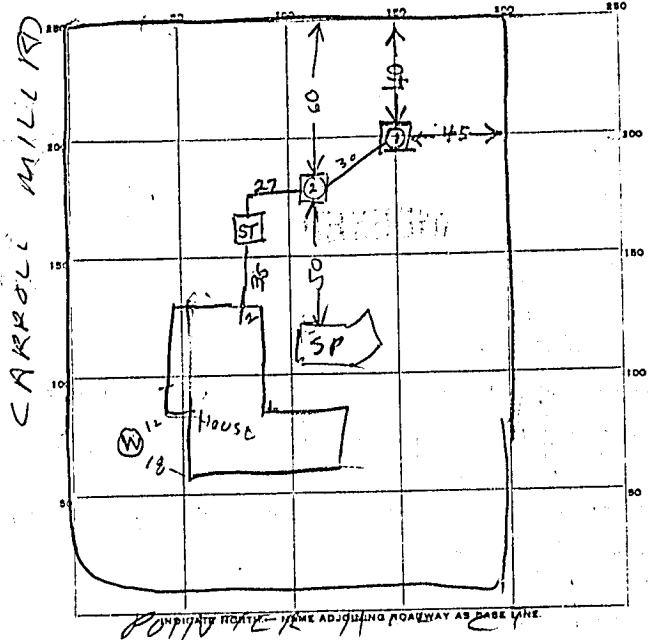

PERMIT CARD \_\_\_\_\_

SEPTIC TANK, LEVEL 011500 concrete CLEANOUTS OK  
Top 2' T below grade

DISTRIBUTION BOX, LEVEL \_\_\_\_\_

TILE FIELD, DEPTH \_\_\_\_\_ FT. TRENCH WIDTH \_\_\_\_\_ FT.

GRAVEL DEPTH \_\_\_\_\_ IN. TOTAL LENGTH \_\_\_\_\_ FT.

NUMBER OF TRENCHES \_\_\_\_\_ TOTAL BOTTOM AREA \_\_\_\_\_

SEEPAGE PITS, INSIDE DIAMETER \_\_\_\_\_ FT. DEPTH BELOW INLET \_\_\_\_\_ FT. 500 sq ft Required  
395 not counting stone 628 SQ. FT. counting stone for 5 bedroom house

REMARKS E/31/71 Dry Well #1 Inlet 4 1/2' below grade Depth  
below inlet in DFT. Inside diameter 9 FT 20% soft not counting stone  
Perimeter 41 FT. 328 sq ft counting stone  
Dry Well #2 Inlet 3 1/2' below grade Depth below Inlet 7 1/2' FT  
Inlet diameter 8 1/2' FT - 195 sq ft not counting stone Perimeter 40 FT -  
300 sq ft counting stone

DATE SYSTEM APPROVED 9/1/71 INSPECTOR Raymond Hodge

15  
16  
17  
28