

4:50

THIS REPORT
MUST BE SUBMITTED
WITHIN 30 DAYS
AFTER COMPLETION
OF THE WELL

WELL COMPLETION REPORT *A-13003*

WELL DESCRIPTION

Ho-15W-226
Permit Number
244 F. H. H. H. H.
Owner
Address *West First St*
Subdivision *Woodhart, MD*
Section *B* Lot *32*

WELL LOG
State the kind of formations penetrated, their color, their depth, their thickness, and if water-bearing

CASING AND SCREEN RECORD
State the kind and size and position of casing, liner, shoe, screen, and other accessories (if no casing used, give diameter of well).

WELL LOG	FEET from ___ to ___	CASING AND SCREEN RECORD	DIAM. (inches)	FEET from ___ to ___
<i>Brown Shale</i>	<i>0 - 35</i>	<i>Black Steel</i>	<i>6 7/8</i>	<i>0 - 7 1/2</i>
<i>Gray Rock of Flint</i>	<i>35 - 92 1/2</i>	<i>1 1/2" x 2" 11</i>	<i>1 1/2</i>	<i>45 - 95</i>

PUMPING TEST
Hours Pumped *3*
Type of Pump Used *air*
Pumping Rate *6*
Gallons per Minute *6*


WATER LEVEL
Distance from land surface to water)
Before Pumping *60* Ft.
When Pumping *215* Ft.

APPEARANCE OF WATER
Clear Cloudy
Taste _____
Odor _____

Height of Casing Above Land
Surface *2* Ft.

PUMP INSTALLED
Type _____
Capacity _____
Gallons per Minute _____
Gallons per Hour _____
Pump Column Length _____ Ft.

LOCATION OF WELL ON LOT
Show permanent structures such as building(s), septic tank, and/or other landmarks and indicate not less than 2 distances (measurements) to well.

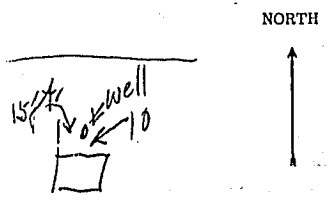

DATE WELL WAS COMPLETED

June 1968

I hereby affirm that this report contains no willful misrepresentations or falsifications and that information given in this report is true and complete to the best of my knowledge and belief.

John Green
John Green Well Driller
Well Driller License No.: *235*