

Tax ID - 05 - 378850

Ampt
5/1/91
✓ on site
only on piece
on septic

PERMIT

P 46225

SEWAGE DISPOSAL SYSTEM

A REPAIR

MARYLAND STATE DEPARTMENT OF HEALTH DISTRICT _____

HOWARD COUNTY

INDEXED

BUREAU OF ENVIRONMENTAL HEALTH

461-9933

DATE _____

DATE SYSTEM APPROVED 10/3/90

INSPECTOR R. Hoopes

Benjamin F. Gartrell

IS PERMITTED TO INSTALL _____ ALTER X

ADDRESS 1311 Hornell Drive, Silver Spring, Maryland 20905 PHONE 301-421-9088

SUBDIVISION Super Prop. ROAD 8340 Old Columbia Road LOT 10

PROPERTY OWNER George Weisman

ADDRESS 8340 Old Columbia Road
Columbia, Maryland

{ NON PUBLISHED T/C per
411 C. B. D.

IF GARBAGE GRINDERS USED INCREASE SEPTIC TANK CAPACITY BY 50% AND ABSORPTION AREA BY 25%.

GARBAGE GRINDER YES ~~XXXXXXXXXXXX~~ NO ~~XXXXXX~~

SEPTIC TANK CAPACITY _____ GALLONS NUMBER OF BEDROOMS _____

REPAIR - PURPOSE - CONNECT REPLACEMENT DWELLING TO EXISTING SEPTIC TANK.

PLANS APPROVED BY C. Williams DATE 8/03/90

COVER NO WORK UNTIL INSPECTED AND APPROVED


NEITHER THE HOWARD COUNTY COUNCIL NOR THE HEALTH DEPARTMENT IS RESPONSIBLE FOR THE SUCCESSFUL OPERATION OF ANY SYSTEM.

- NOTE: CLEANOUT REQUIRED EVERY 70 FEET OF SEWER LINE AND/OR AT 90° SWEEPS IN LINES FROM HOUSE TO DRAIN FIELDS
- NOTE: ALL PARTS OF SEPTIC SYSTEMS (I.E. TANK, DISTRIBUTION BOX, TRENCHES) TO BE 100 FEET FROM WELL (UNLESS OTHERWISE SPECIFICALLY AUTHORIZED)
- NOTE: IF DEEP TRENCHES ARE USED CALL FOR INSPECTION BEFORE AND AFTER PLACING GRAVEL IN TRENCHES)
- NOTE: NO DRY WELL SHALL EXCEED 15 FOOT IN DIAMETER NO ABSORPTION TRENCH TO EXCEED 100 FEET IN LENGTH.
- NOTE: ALL PIPE FROM HOUSE TO SEPTIC TANK MUST BE CAST IRON OR SCHEDULE 40 PVC OR ABS
- PERMIT VOID AFTER TWO YEARS
- NOTE: INSTALL STAND PIPE ON SEPTIC TANK AND DRY WELL. STAND PIPES MUST BE 6 INCHES IN DIAMETER. CAST IRON, CONCRETE OR TERRA COTTA OR PVC OR ABS ACCEPTED. IF TOP OF SEPTIC TANK IS DEEPER THAN 3 FEET, MANHOLE TO GRADE REQUIRED
- NOTE: DISTRIBUTION BOXES MUST HAVE BAFFLES

***INSTALLER IS RESPONSIBLE FOR OBTAINING FINAL APPROVAL ON THIS PERMIT**

*CALL 461-9933 FOR INSPECTION OF SEPTIC SYSTEMS.

P
46225

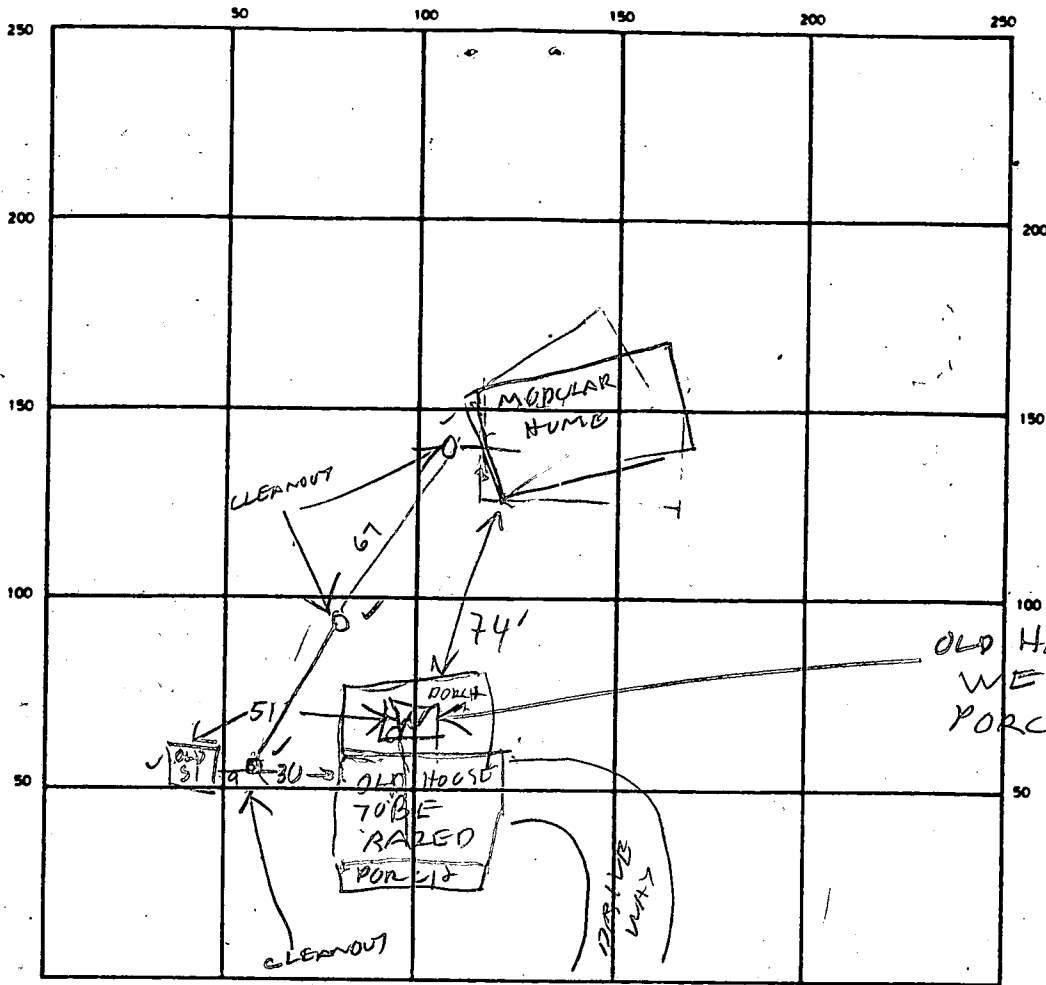

INDICATE NORTH - NAME ADJOINING ROADWAY AS BASE LINE
 OLD COLUMBIA RD

SEPTIC TANK. LEVEL _____ CLEANOUTS _____

DISTRIBUTION BOX. LEVEL _____

DRAIN FIELD/TILE FIELD. DEPTH _____ FT. TRENCH WIDTH _____ FT. INLET DEPTH _____ FT.

EFFECTIVE GRAVEL DEPTH _____ FT. TOTAL LENGTH _____ FT.

NUMBER OF TRENCHES _____ ONE SIDEWALL/BOTTOM AREA _____ SQ. FT.

DRYWELL INSIDE DIAMETER _____ FT. EFFECTIVE DEPTH BELOW INLET _____ FT.


ABSORBENT AREA _____ SQ. FT.

REMARKS _____

P.M. 5/1/91 Old house razed; only 1 home on site. File
 C.B.R.

DATE SYSTEM APPROVED 30 Oct 90 INSPECTOR Raymond Hodges

6/15/90
OK
c. b. d.
BDD

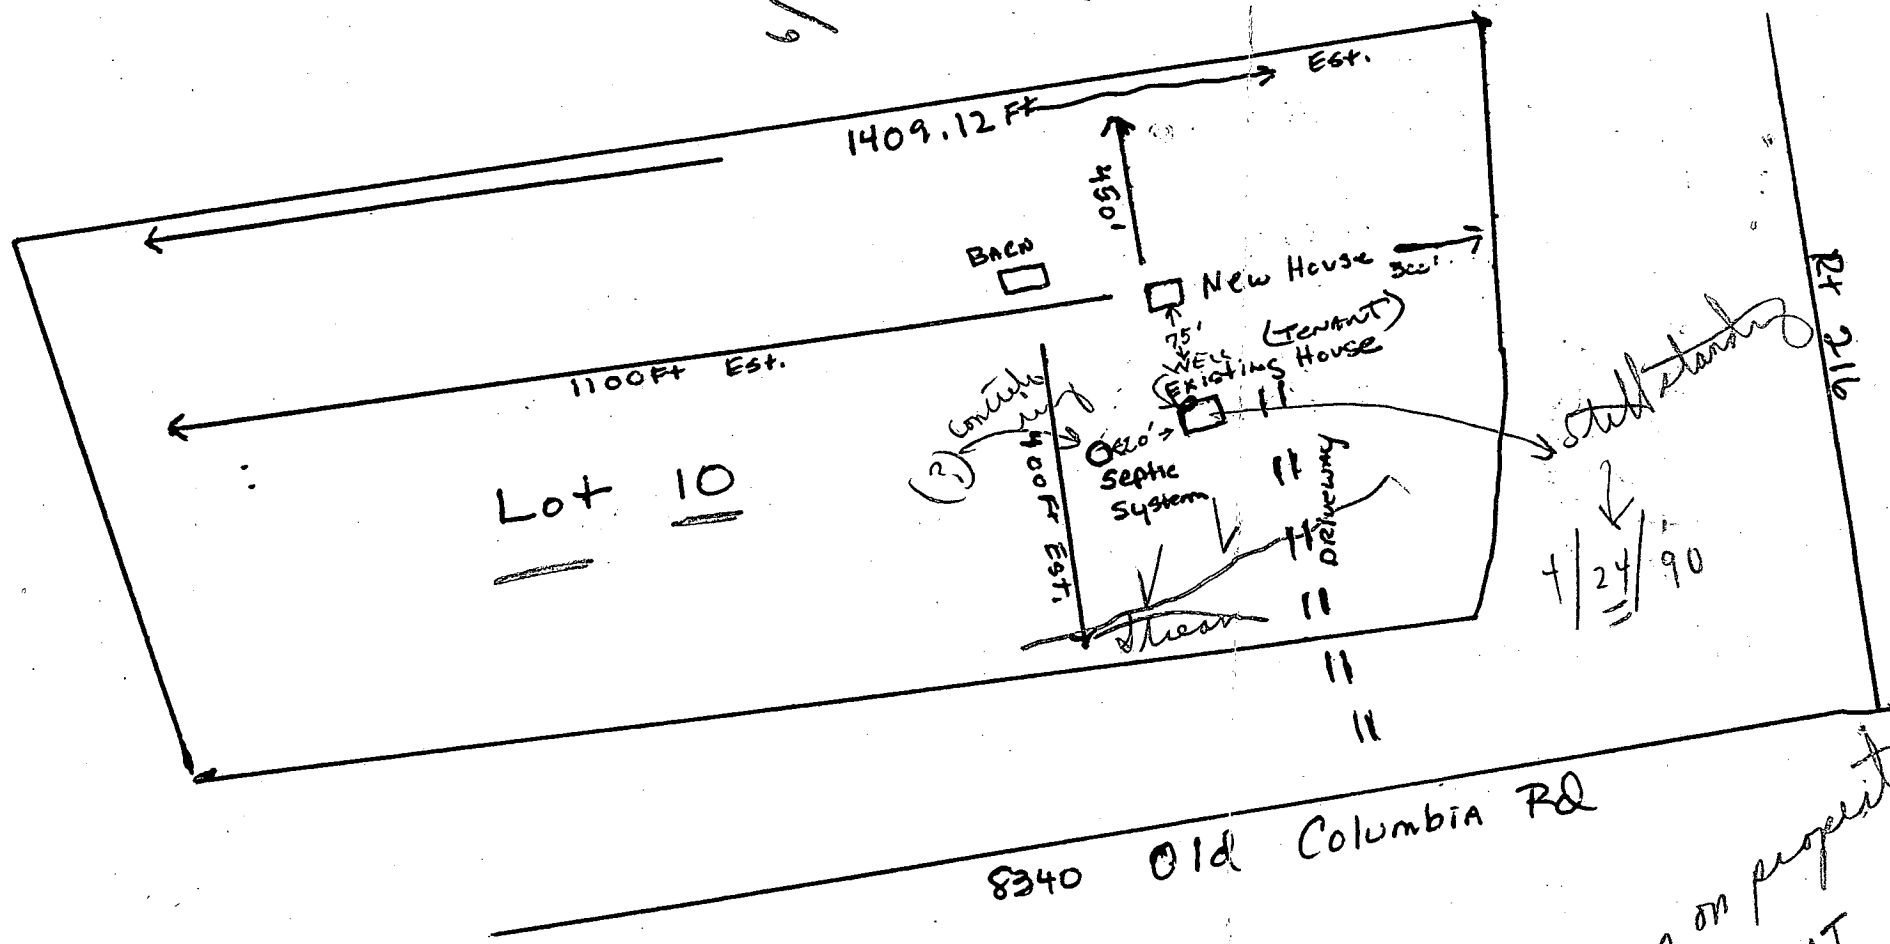


still standing
4/24/90


4/24/90 Dogs on property
WATCH OUT

IR PROPERTY
 Lot 9
 AT NO 4382

Existing Mo Pte E/C

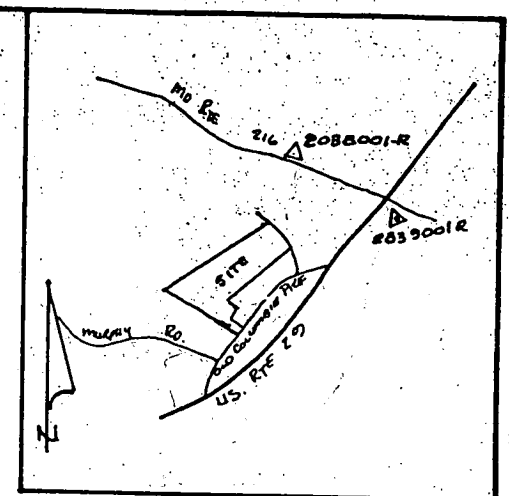

VICINITY MAP
 1" = 2000'

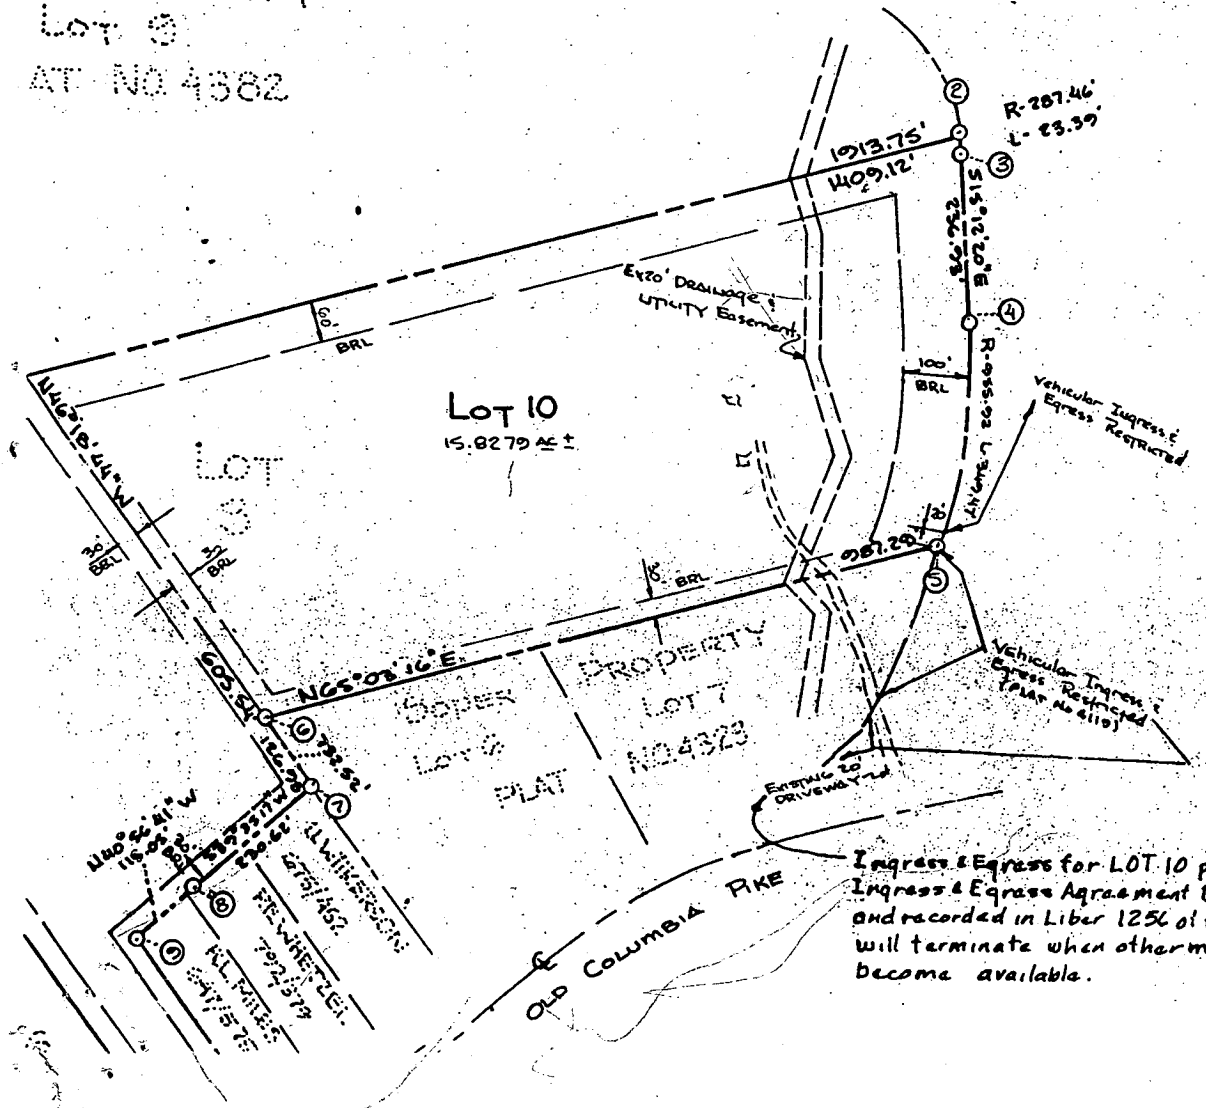

1913.75'
 409.12'

R-287.46'
 L-23.39'

LOT 10
 15,8279 AC ±

PROPERTY
 LOT 7
 NO 4323

Ingress & Egress for LOT 10 provided by an
 Ingress & Egress Agreement Dated June 5, 1984
 and recorded in Liber 1256 of folio 6A2. Agreement
 will terminate when other means of public access
 become available.

11 WILKINSONS
 6751 1/2 S.
 FR. WHEELER LEE
 792,579
 547,575

SITE INSPECTION SHEET

OWNER: Don Weisman, Jr. 490-0298

DATE REQUESTED: 8/4/99 11 AM

PHONE #: 8340 Old Columbia Rd


CONTRACTOR: J. Mayne

ADDRESS: _____

WELL TAG #: _____

COUNTY #: _____

PROPOSAL: replacement well requested, ex. hand dug mostly dry

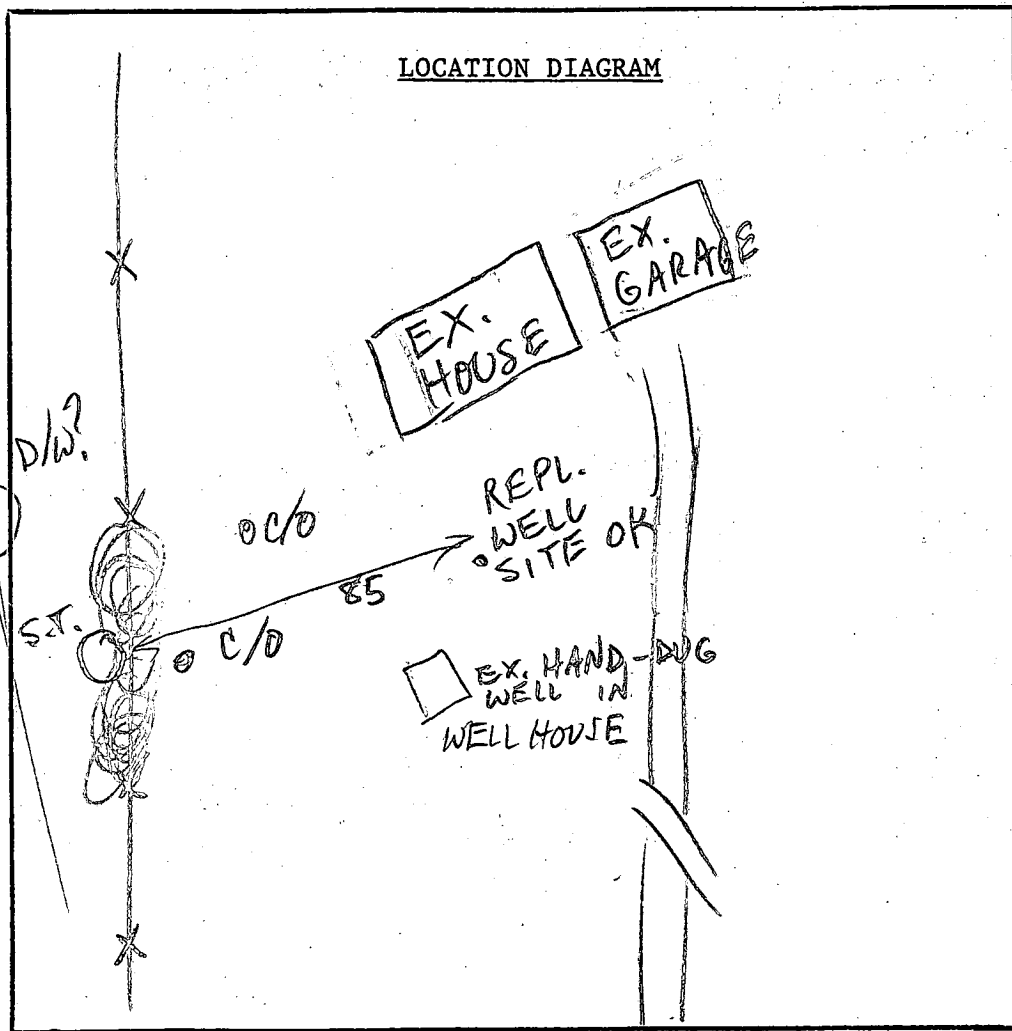

COMMENTS: OLD COLUMBIA ROAD

8/4/99 WELL SITE OK AS SHOWN (MD)

DATE: _____ INSPECTOR: _____

B 1 14392

SEQUENCE NO. (MDE USE ONLY)

STATE OF MARYLAND PERMIT TO DRILL WELL please print or type

STATE PERMIT NUMBER

HO-94-2356 fill in this form completely

Date Received (APA) 08 04 99

OWNER INFORMATION

Wheisman Don 8340 Old Columbia Rd. Columbia Md.


B 3 LOCATION OF WELL

Howard Soper Property Scaggsville

DRILLER INFORMATION

Joseph L. Mayne MS DO 24 5512 Ridge Rd. Mt. Airy 21771

B 4 DIRECTION OF WELL FROM TOWN (CIRCLE BOX)

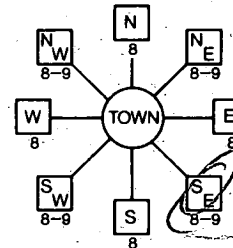

8340 Old Columbia Rd. NEAR WHAT ROAD

ON WHICH SIDE OF ROAD (CIRCLE APPROPRIATE BOX) DISTANCE FROM ROAD 310 ENTER FT OR MI 1.1 TAX MAP: 46 BLK: 3 PARCEL 332

B 2 WELL INFORMATION

APPROX. PUMPING RATE 5 GAL. PER MIN. AVERAGE DAILY QUANTITY NEEDED 500 GAL. PER DAY

USE FOR WATER (CIRCLE APPROPRIATE BOX)

- Domestic Potable Supply & Residential Irrigation (circled)
Farming (Livestock Watering & Agricultural Irrigation)
Industrial, Commercial, Dewatering
Public Water Supply Well
Test, Observation, Monitoring
Geo-Thermal

NOT TO BE FILLED IN BY DRILLER HEALTH DEPARTMENT APPROVAL

Howard COUNTY NAME Mark E. Rifkin 8/4/00 CO SIGNATURE DATE ISSUED

APPROXIMATE DEPTH OF WELL 300 FEET

APPROXIMATE DIAMETER OF WELL 6 INCH NEAREST INCH

METHOD OF DRILLING (circle one)

- Bored (or Augered)
Jetted
Jetted & Driven
Air-PerCussion
Rotary (Hydraulic Rotary)
Cable
Reverse-Rotary
Drive-Point
Other

SHOW MAJOR FEATURES OF BOX & LOCATE WELL WITH AN X

SOURCES OF DRILLING WATER 1. Well


WRITE THE BOX NUMBER FROM THE MAP HERE

E 8227 N 4727

REPLACEMENT OR DEEPEINED WELLS (CIRCLE APPROPRIATE BOX)

- This well will not replace an existing well
This well will replace a well that will be abandoned and sealed
This well will replace a well that will be used as a standby-contact local approving authority for policy on standby wells (circled)
This well will deepen an existing well

DRAW A SKETCH BELOW SHOWING LOCATION OF WELL IN RELATION TO NEARBY TOWNS AND ROADS AND GIVE DISTANCE FROM WELL TO NEAREST ROAD JUNCTION

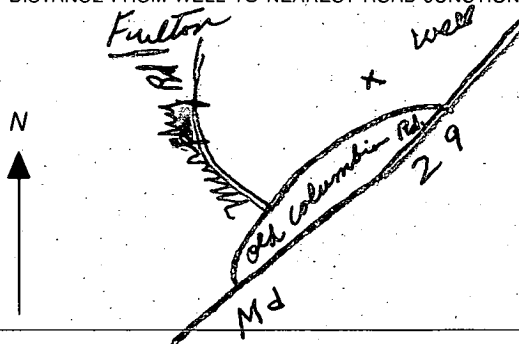

Not to be filled in by driller (MDE OR COUNTY USE ONLY)

APPROX. PERMIT NUMBER 54 G A P 63

PERMIT No. HO-94-2356

SPECIAL CONDITIONS

NOTE - APPROVING AUTHORITIES SHOULD USE SEPARATE SHEET IF NEEDED

C 1 06676 SEQUENCE NO. (MDE USE ONLY)

STATE OF MARYLAND WELL COMPLETION REPORT

THIS REPORT MUST BE SUBMITTED WITHIN 45 DAYS AFTER WELL IS COMPLETED.

1 2 3 6 (THIS NUMBER IS TO BE PUNCHED IN COLS. 3-6 ON ALL CARDS)

FILL IN THIS FORM COMPLETELY PLEASE PRINT OR TYPE

COUNTY NUMBER P 46225

ST/CO USE ONLY DATE RECEIVED

DATE WELL COMPLETED 8 5 99

DEPTH OF WELL 160' PERMIT NO. HO-94-2356

OWNER Weisman, Don STREET OR RFD 18340 Old Cole Rd TOWN Scaggsville SUBDIVISION SOPER PROP SECTION LOT 10

WELL LOG

Not required for driven wells.

STATE THE KIND OF FORMATIONS PENETRATED, THEIR COLOR, DEPTH, THICKNESS AND IF WATER BEARING

Table with columns: DESCRIPTION, FEET (FROM, TO), check if water bearing. Includes entries for Sand (0-57) and Gray Mica Rock (57-160).

GROUTING RECORD

WELL HAS BEEN GROUTED (Y/N) TYPE OF GROUTING MATERIAL (CM, BC) NO. OF BAGS 20 NO. OF POUNDS 7880

CASING RECORD

MAIN CASING TYPE (ST) Nominal diameter 6 Total depth 60

OTHER CASING (if used) diameter inch depth (feet) from to

SCREEN RECORD screen type or open hole (ST, BR, HO) insert appropriate code below

DEPTH (nearest ft.) table with rows 1-10 and columns 1-10. Includes handwritten values 59 and 160.

DIAMETER OF SCREEN (NEAREST INCH) 56 to 60

GRAVEL PACK IF WELL DRILLED WAS FLOWING WELL INSERT F IN BOX 68

MDE USE ONLY (NOT TO BE FILLED IN BY DRILLER) T (E.R.O.S.) W Q

TELESCOPE CASING LOG INDICATOR OTHER DATA


PUMPING TEST

HOURS PUMPED (nearest hour) 3 PUMPING RATE (gal. per min.) 12 METHOD USED TO MEASURE PUMPING RATE Air

PUMP INSTALLED

DRILLER WILL INSTALL PUMP (YES/NO) TYPE OF PUMP INSTALLED PLACE (A,C,J,P,R,S,T,O) IN BOX 29 CAPACITY: GALLONS PER MINUTE (to nearest gallon) 31 35

LOCATION OF WELL ON LOT SHOW PERMANENT STRUCTURE SUCH AS BUILDING, SEPTIC TANKS, AND /OR LANDMARKS AND INDICATE NOT LESS THAN TWO DISTANCES (MEASUREMENTS TO WELL)

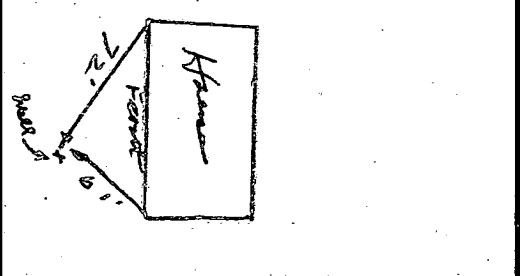

NUMBER OF UNSUCCESSFUL WELLS: 0 WELL HYDROFRACTURED (Y/N)

CIRCLE APPROPRIATE LETTER A WELL WAS ABANDONED AND SEALED WHEN THIS WELL WAS COMPLETED

I HEREBY CERTIFY THAT THIS WELL HAS BEEN CONSTRUCTED IN ACCORDANCE WITH COMAR 26.04.04 'WELL CONSTRUCTION'

DRILLERS LIC. NO. M 50024 DRILLERS SIGNATURE Joseph L. Mayne LIC. NO. M D

SITE SUPERVISOR (sign. of driller or journeyman responsible for sitework if different from permittee)