

Tax ID - 05-371295

PERMIT

SEWAGE DISPOSAL SYSTEM

MARYLAND STATE DEPARTMENT OF HEALTH DISTRICT _____

HOWARD COUNTY

BUREAU OF ENVIRONMENTAL HEALTH

461-9933

P 46288

A REPAIR

DATE 8/28/90

DATE SYSTEM APPROVED 7/16/90

INSPECTOR C.B.D.

INDEXED

Jack Fyock

IS PERMITTED TO INSTALL _____ ALTER X

ADDRESS _____ PHONE 988-9270

SUBDIVISION _____ ROAD 7365 Pindell School Rd LOT lot 5

PROPERTY OWNER Laverne Mr. Weight

ADDRESS 7365 Pindell School Road
Fulton, Maryland

IF GARBAGE GRINDER IS USED INCREASE SEPTIC TANK CAPACITY BY 60% AND ABSORPTION AREA BY 22%

GARBAGE GRINDER NO

SEPTIC TANK CAPACITY _____ GALLONS NUMBER OF BEDROOMS _____

REPAIR - CALL FOR INSPECTION WHEN GROUND IS OPENED SO SANITARIAN CAN RECOMMEND REPAIR.

Thursday 6/21/90 OK TO CONTINUE AS IS. (TO ^{FYOCK} SUBMIT DRAWING)

Recommend (1) Trench - 54' Long; 3 Bedrooms; 7' stone; 12' ditch depth; 2' wide

Note 59' Long at ^{Home} ✓ unless 4 1/2 to 5'

(see back →)

C.B.D. for

PLANS APPROVED BY C. Williams DATE 6/07/90

COVER NO WORK UNTIL INSPECTED AND APPROVED

NEITHER THE HOWARD COUNTY COUNCIL NOR THE HEALTH DEPARTMENT IS RESPONSIBLE FOR THE SUCCESSFUL OPERATION OF ANY SYSTEM

NOTE: CLEANOUT REQUIRED EVERY 70 FEET OF SEWER LINE AND/OR AT 90° SWEEPS IN LINES FROM HOUSE TO DRAIN FIELDS

NOTE: ALL PARTS OF SEPTIC SYSTEMS (I.E. TANK, DISTRIBUTION BOX, TRENCHES) TO BE 100 FEET FROM WELL (UNLESS OTHERWISE SPECIFICALLY AUTHORIZED)

NOTE: IF DEEP TRENCHES ARE USED CALL FOR INSPECTION BEFORE AND AFTER PLACING GRAVEL IN TRENCHES

NOTE: NO DRY WELL SHALL EXCEED 15 FOOT IN DIAMETER NO ABSORPTION TRENCH TO EXCEED 100 FEET IN LENGTH

NOTE: ALL PIPE FROM HOUSE TO SEPTIC TANK MUST BE CAST IRON OR SCHEDULE 40 PVC OR ABS

PERMIT VOID AFTER TWO YEARS

NOTE: INSTALL STAND PIPE ON SEPTIC TANK AND DRY WELL STAND PIPES MUST BE 6 INCHES IN DIAMETER. CAST IRON, CONCRETE OR TERRA COTTA OR PVC OR ABS ACCEPTED. IF TOP OF SEPTIC TANK IS DEEPER THAN 3 FEET, MANHOLE TO GRADE REQUIRED

NOTE: DISTRIBUTION BOXES MUST HAVE BAFFLES

***INSTALLER IS RESPONSIBLE FOR OBTAINING FINAL APPROVAL ON THIS PERMIT**


*CALL 461-9933 FOR INSPECTION OF SEPTIC SYSTEMS.

6/7/90
10:00 AM

added information of contract

well

P 46288

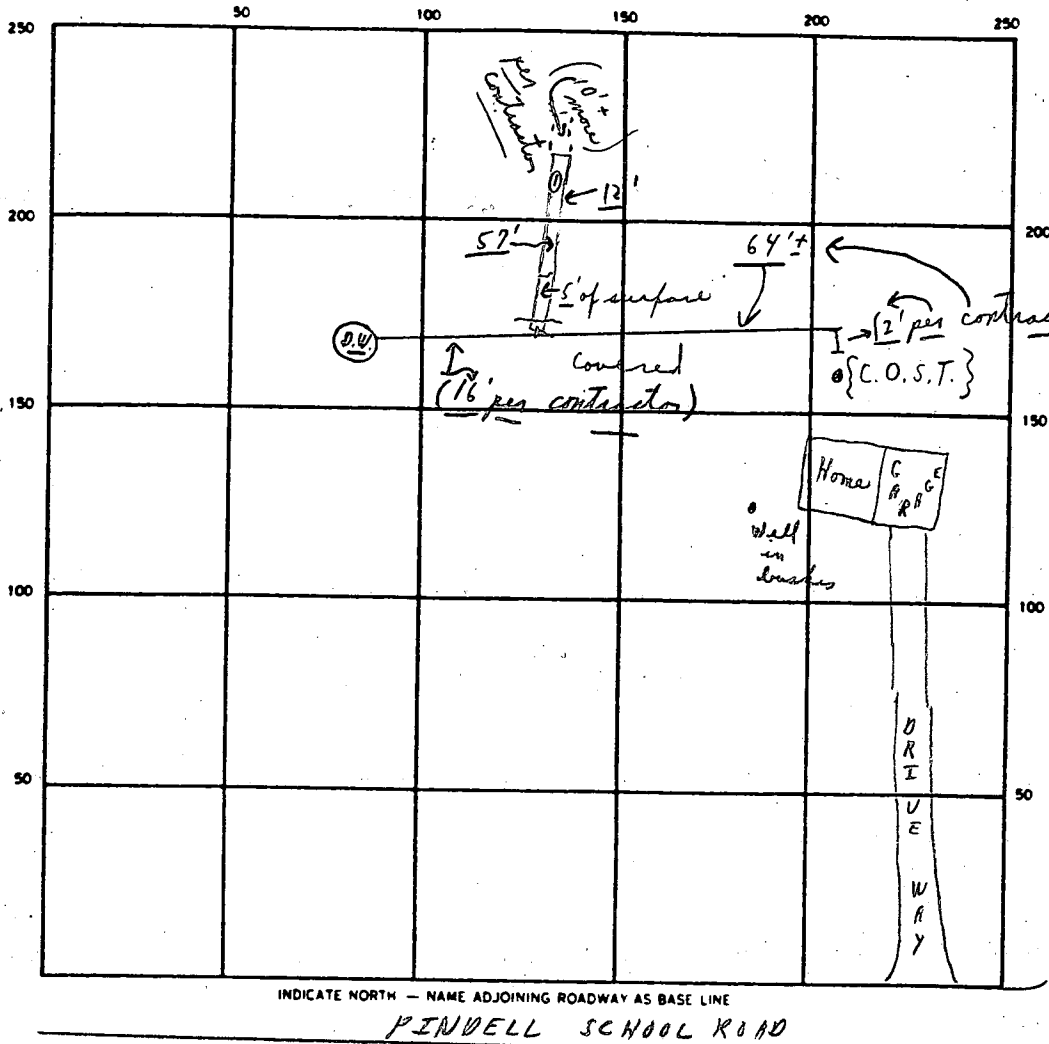

← Columbia

Fulton →

SEPTIC TANK. LEVEL Existing CLEANOUTS Existing at inspection
 DISTRIBUTION BOX. LEVEL (?) Using part of old system
 DRAIN FIELD/TILE FIELD. DEPTH 12 FT. TRENCH WIDTH 2 FT. INLET DEPTH 5 FT.
 EFFECTIVE GRAVEL DEPTH 7 FT. TOTAL LENGTH 57 FT. seen 67 Total
 NUMBER OF TRENCHES 1 ONE SIDEWALL/BOTTOM AREA { 399 + 70 } SQ. FT. = 469
 DRYWELL INSIDE DIAMETER _____ FT. EFFECTIVE DEPTH BELOW INLET _____ FT.
 ABSORBENT AREA 399 + 70 SQ. FT. = 469

REMARKS Partial → 6/7/90 Using part of existing system - ok to continue; left permit card; hold for a drawing before proceed.
7/16/90 Added information of contractor C. Beckett to drawing see above. Final.

DATE SYSTEM APPROVED 7/16/90 INSPECTOR Charles Bryan Street