

104 2/190 1072
Tax ID - 03 - 292827

PERMIT

SEWAGE DISPOSAL SYSTEM

DEPARTMENT OF HEALTH AND MENTAL HYGIENE

P 46473

A REPAIR

DISTRICT 3rd

DATE 10/2/90

DATE SYSTEM APPROVED 11/16/90

INSPECTOR RH

HOWARD COUNTY HEALTH DEPARTMENT
BUREAU OF ENVIRONMENTAL HEALTH
461-9933

INDEXED

C. Knudson IS PERMITTED TO INSTALL _____ ALTER X

ADDRESS 8455 Baltimore National Pike PHONE 465-2222

SUBDIVISION _____ LOT _____ ROAD 12925A Old National Pike

PROPERTY OWNER Ms. Laura Parker

ADDRESS 12925A Old National Pike
West Friendship, Maryland 21794

SEPTIC TANK CAPACITY _____ GALLONS

NUMBER OF BEDROOMS _____

_____ SQUARE FEET PER BEDROOM

LINEAR FEET OF TRENCH REQUIRED _____

REPAIR - PURPOSE - TO ESTABLISH SEPTIC SYSTEM CAPACITY FOR REPLACEMENT DWELLING -

BUILDING PERMIT SERIAL NUMBER: 34619

CALL FOR INSPECTION WHEN GROUND IS OPENED SO SANITARIAN CAN RECOMMEND REPAIR.

REPAIR AREA OK 10/2/90 RH

PLANS APPROVED BY C. Williams DATE 9/28/90

COVER NO WORK UNTIL INSPECTED AND APPROVED

NEITHER THE HOWARD COUNTY COUNCIL NOR THE HEALTH DEPARTMENT IS RESPONSIBLE FOR THE SUCCESSFUL OPERATION OF ANY SYSTEM

NOTE: CLEANOUT REQUIRED EVERY 70 FEET OF SEWER LINE AND/OR AT 90° SWEEPS IN LINES FROM HOUSE TO DRAIN FIELDS, 90° ELBOWS NOT ACCEPTABLE.

NOTE: ALL PARTS OF SEPTIC SYSTEMS (I.E. TANK, DISTRIBUTION BOX TRENCHES) TO BE 100 FEET FROM WELL (UNLESS OTHERWISE SPECIFICALLY AUTHORIZED)

NOTE: IF DEEP TRENCH(ES) ARE USED CALL FOR INSPECTION BEFORE AND AFTER PLACING GRAVEL IN TRENCH(ES)

NOTE: NO DRY WELL SHALL EXCEED 15 FOOT IN DIAMETER NO ABSORPTION TRENCH TO EXCEED 100 FEET IN LENGTH

NOTE: ALL PIPE FROM HOUSE TO SEPTIC TANK MUST BE CAST IRON OR SCHEDULE 35/40 PVC OR ABS



PERMIT VOID AFTER TWO YEARS

NOTE: INSTALL STAND PIPE ON SEPTIC TANK AND DRY WELL STAND PIPES MUST BE 6 INCHES IN DIAMETER CAST IRON. CONCRETE OR TERRA COTTA OR PVA OR ABS ACCEPTED. IF TOP OF SEPTIC TANK IS DEEPER THAN 3 FEET. MANHOLE TO GRADE REQUIRED.

NOTE: DISTRIBUTION BOXES MUST HAVE BAFFLES

***INSTALLER IS RESPONSIBLE FOR OBTAINING FINAL APPROVAL ON THIS PERMIT**

P 46473

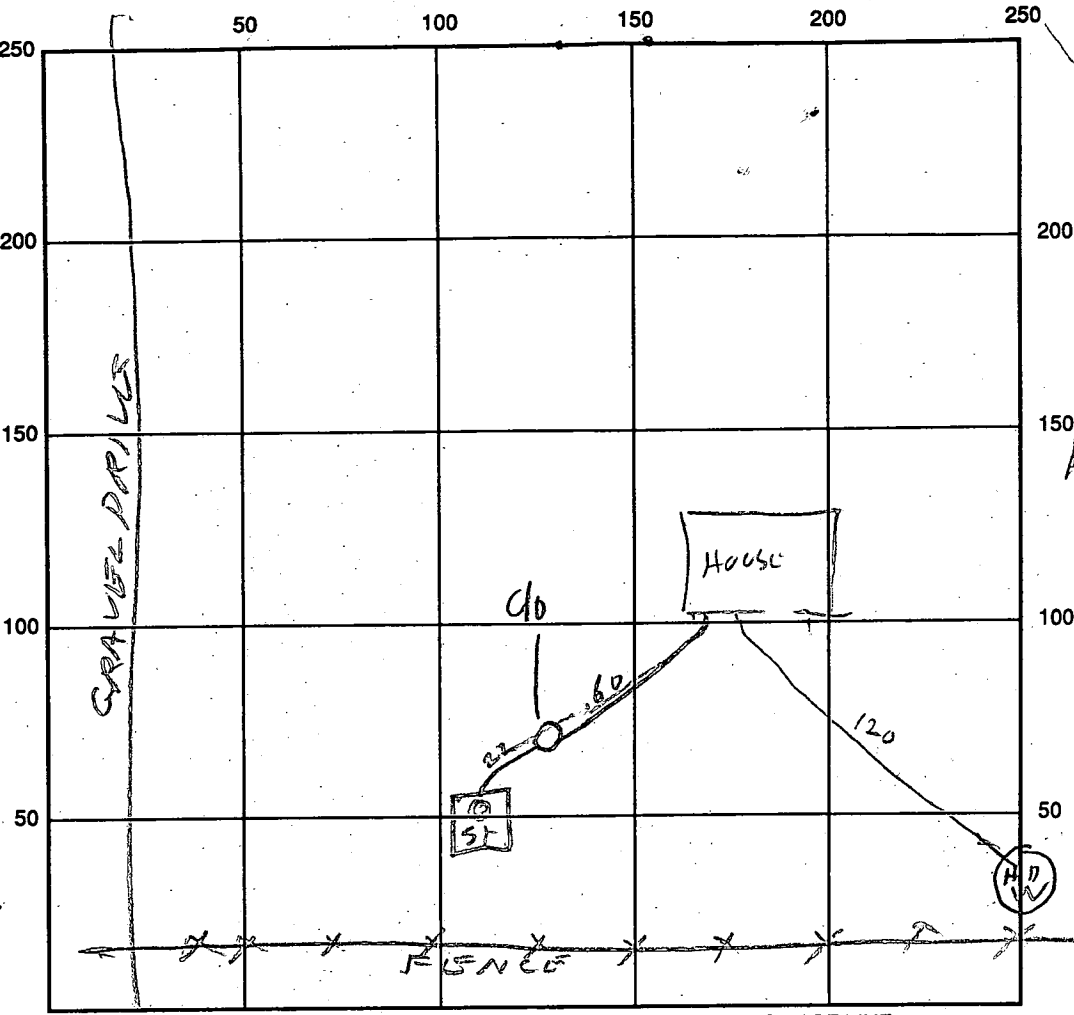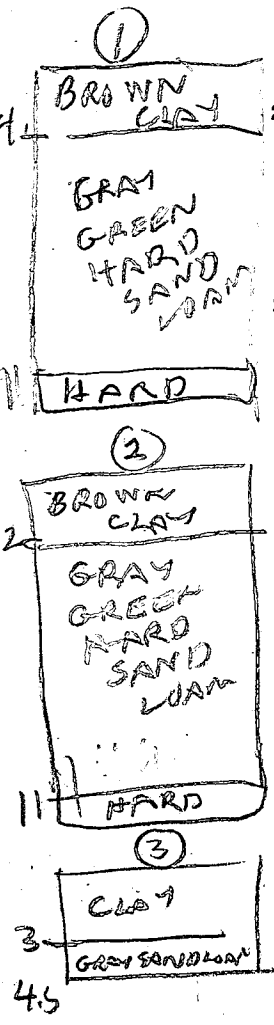

OLD ST SEPTIC TANK
 HDW = HAND DUG WELL

23

INDICATE NORTH - NAME ADJOINING ROADWAY AS BASE LINE

SEPTIC TANK LEVEL _____ CLEANOUTS _____

DISTRIBUTION BOX LEVEL _____

DRAIN FIELD/TITLE DEPTH _____ FT. TRENCH WIDTH _____ FT. INLET DEPTH _____ FT.

EFFECTIVE GRAVEL DEPTH _____ FT. TOTAL LENGTH _____ FT. 27/9

NUMBER OF TRENCHES _____ ONE SIDEWALL/BOTTOM AREA _____ SQ. FT.

DRYWALL INSIDE DIAMETER _____ FT. EFFECTIVE DEPTH BELOW INLET _____ FT.

ABSORBENT AREA _____ SQ. FT.

REMARKS	15	4	949	152	152	210	18
10/1/90	25	3	244	300	little perc		
10/1/90	25	5	311	326	little perc		
10/1/90	35	4.5	337	409	32 minute seepers	Test Shoot for Repair Perc	
7/1/86/90	HOUSE MOVED UP TO OLD SEPTIC TANK & OLD HAND DUG WELL BH						

DATE SYSTEM APPROVED 1/1/66/90 INSPECTOR Raymond Dodge

APPLICATION

PERCOLATION TESTING

Repair Perc

P _____

HOWARD COUNTY HEALTH DEPARTMENT
BUREAU OF ENVIRONMENTAL HEALTH
P.O. BOX 476 ELLICOTT CITY, MARYLAND 21043
TELEPHONE: 461-9933

DISTRICT _____

DATE _____

TO: THE COUNTY HEALTH OFFICER
ELLICOTT CITY, MARYLAND

I, HEREBY, APPLY FOR THE NECESSARY TEST IN ORDER TO CONSTRUCT (OR RECONSTRUCT) A SEWAGE DISPOSAL SYSTEM.

PROPERTY OWNER Laura Parker

ADDRESS 12925A Old National Pike 9 PHONE 1
W. Friendship Md 21794

PROSPECTIVE BUYER _____
ADDRESS _____ PHONE _____

PROPERTY LOCATION:

SUBDIVISION _____ LOT NO. _____

ROAD AND DESCRIPTION 12925A Old National PIKE

TAX MAP _____ PARCEL # _____

BLDG PERMIT SERIAL #

~~AND RETURNED~~ 10-11-90
Serial # 34619

SIZE OF LOT _____ TYPE BLDG SFD -
(SINGLE FAMILY DWELLING OR COMMERCIAL)

THE SYSTEM INSTALLED UNDER THIS APPLICATION IS ACCEPTABLE ONLY UNTIL PUBLIC FACILITIES BECOME AVAILABLE. I FULLY UNDERSTAND THE FEE CONNECTED WITH THE FILING OF THIS PERC TEST APPLICATION IS NON-REFUNDABLE UNDER ANY CIRCUMSTANCES. I ALSO AGREE TO COMPLY WITH ALL M.O.S.H.A. REQUIREMENTS IN TESTING THIS LOT.

(SIGNATURE OF APPLICANT)

APPROVED BY _____ FOR _____ DATE _____

REJECTED BY _____ FOR _____ DATE _____

HOLD PENDING FURTHER TESTS _____ DATE _____

REASONS FOR REJECTION OR HOLDING _____

HD-216







THIS IS NOT A PERMIT

REPAIR PERC

See Attached Plat

5 - LOWEST HOLE

SOIL PROFILE

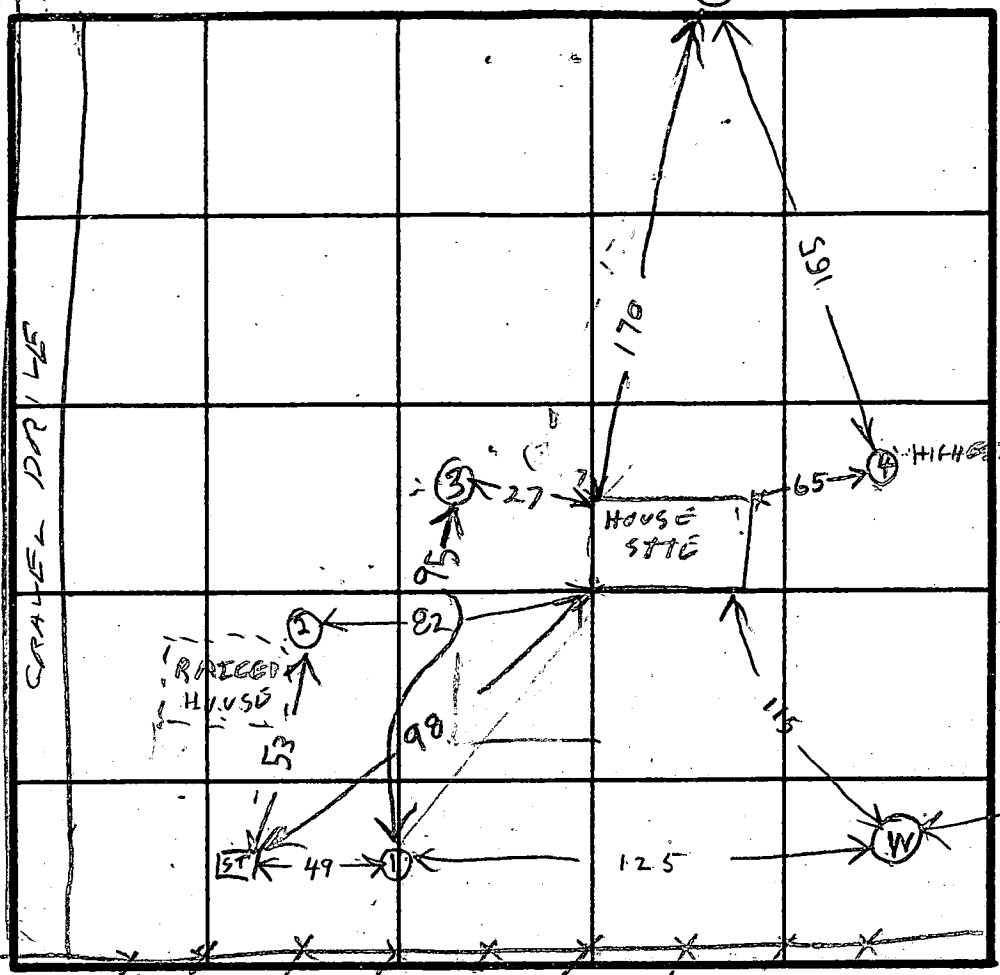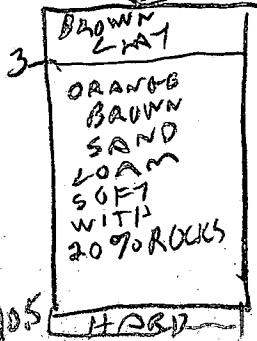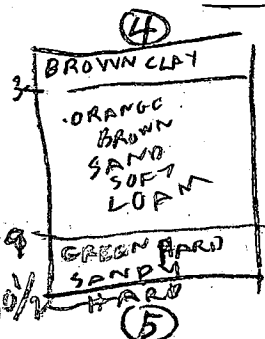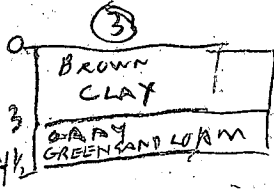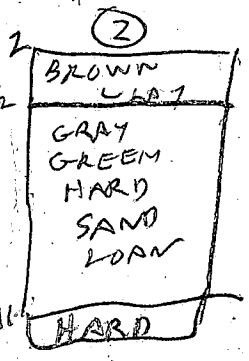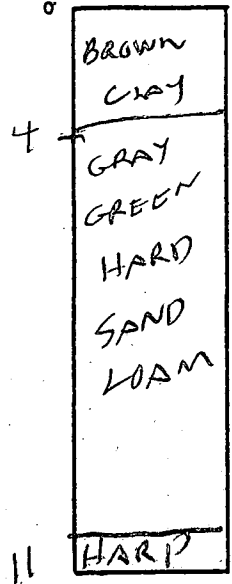

HAND DUG WELL STONE LINED OPEN TOP

INDICATE NORTH - NAME ADJOINING ROADWAY AS BASE LINE.

DATE	TEST NO.	DEPTH	PRE-WET		TEST - 1" DROP		TIME
			START	STOP	START	STOP	
10/2/90	1S	4	149	152	152	210	18
	1V	11	OK	SHALLOW			
10/2/90	2S	3	244	300	little perc		
	2M	5	311	326	little perc		
10/2/90	3V	11	FAIL				
10/2/90	3S	4.5	337	409	little perc	FAIL	
20/7/90	4S	4	1017	1018	1018	1019	1
20/7/90	4V	10.5	OK	SHALLOW	DRAIN FIELD		
20/7/90	5S	4	1025	1029	1029	1035	6
20/7/90	5V	10.5	OK	SHALLOW	DRAIN FIELD		

REMARKS _____

TYPE OF SOIL _____ 10/1/90 KETTERMAN & PALMER

TESTED BY R HODGES, 10/2/90 & 20/7/90 ALSO PRESENT OTIS KETTERMAN

WEST FRIENDSHIP

Rt 32

720'



NEW MANUFACTURED HOME

(SEE ATTACHED SHEET)

HO CO MP

635/331

135.40 A

2790'

JASON A. PARKER

553/704

66.05 A

P 17

3060'

JAMES W. HUDSON

150/577

195.5 A

P. 74

1240'

MARION HARLESS ET. AL

483/57

27.14 A P-151

ROOSEVELT NIXON

294/256

127.32 A

P. 90