

TexID - 03 - 299694

File

10/4/90 (2) P.C.O.'s

PERMIT

SEWAGE DISPOSAL SYSTEM

DEPARTMENT OF HEALTH AND MENTAL HYGIENE

P 46507

A REPAIR

DISTRICT _____

DATE 10/22/90

DATE SYSTEM APPROVED 10/5/90

INSPECTOR C.B.D. + J.G.
10/5/90

HOWARD COUNTY HEALTH DEPARTMENT
BUREAU OF ENVIRONMENTAL HEALTH
461-9933

INDEXED

Jack Fyock _____ IS PERMITTED TO INSTALL _____ ALTER

ADDRESS _____ PHONE 988-9270

SUBDIVISION _____ LOT 250 ROAD 11178 Douglas Avenue

PROPERTY OWNER Yunkins Gloria Fich
11178 Douglas Avenue

ADDRESS Marriottsville, Maryland 21043

SEPTIC TANK CAPACITY 1000 GALLONS

NUMBER OF BEDROOMS 3

_____ SQUARE FEET PER BEDROOM

LINEAR FEET OF TRENCH REQUIRED _____

REPAIR - PURPOSE - TO REPLACE EXISTING FAILING SEPTIC SYSTEM.
CALL FOR INSPECTION WHEN GROUND IS OPENED SO SANITARIAN CAN RECOMMEND REPAIR.

PLANS APPROVED BY C. Williams DATE 10/03/90

COVER NO WORK UNTIL INSPECTED AND APPROVED

NEITHER THE HOWARD COUNTY COUNCIL NOR THE HEALTH DEPARTMENT IS RESPONSIBLE FOR THE SUCCESSFUL OPERATION OF ANY SYSTEM

NOTE: CLEANOUT REQUIRED EVERY 70 FEET OF SEWER LINE AND/OR AT 90° SWEEPS IN LINES FROM HOUSE TO DRAIN FIELDS, 90° ELBOWS NOT ACCEPTABLE.

NOTE: ALL PARTS OF SEPTIC SYSTEMS (I.E. TANK, DISTRIBUTION BOX TRENCHES) TO BE 100 FEET FROM WELL (UNLESS OTHERWISE SPECIFICALLY AUTHORIZED)

NOTE: IF DEEP TRENCH(ES) ARE USED CALL FOR INSPECTION BEFORE AND AFTER PLACING GRAVEL IN TRENCH(ES)

NOTE: NO DRY WELL SHALL EXCEED 15 FOOT IN DIAMETER NO ABSORPTION TRENCH TO EXCEED 100 FEET IN LENGTH

NOTE: ALL PIPE FROM HOUSE TO SEPTIC TANK MUST BE CAST IRON OR SCHEDULE 35/40 PVC OR ABS


PERMIT VOID AFTER TWO YEARS

NOTE: INSTALL STAND PIPE ON SEPTIC TANK AND DRY WELL STAND PIPES MUST BE 6 INCHES IN DIAMETER CAST IRON. CONCRETE OR TERRA COTTA OR PVA OR ABS ACCEPTED. IF TOP OF SEPTIC TANK IS DEEPER THAN 3 FEET. MANHOLE TO GRADE REQUIRED.

NOTE: DISTRIBUTION BOXES MUST HAVE BAFFLES

***INSTALLER IS RESPONSIBLE FOR OBTAINING FINAL APPROVAL ON THIS PERMIT**

P 46507

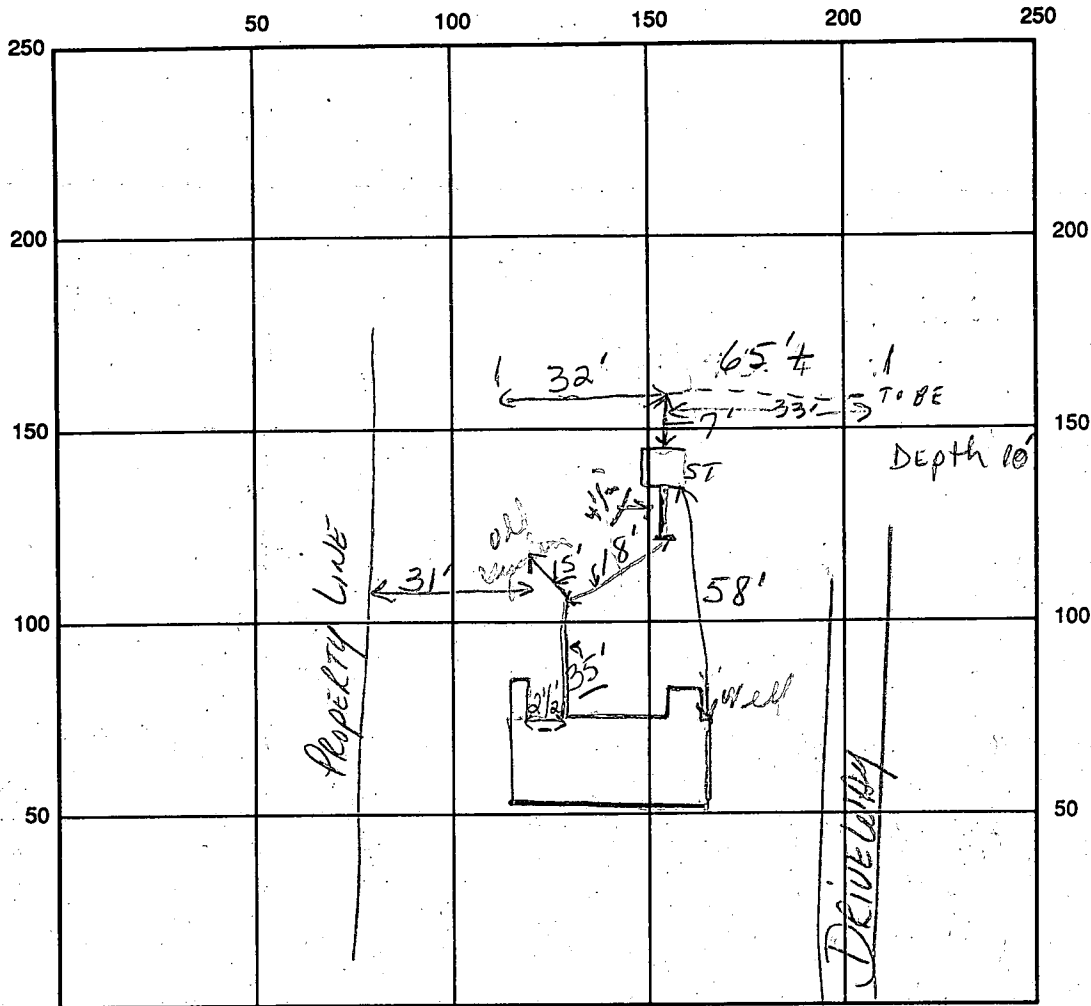

INDICATE NORTH - NAME ADJOINING ROADWAY AS BASE LINE

SEPTIC TANK LEVEL 1,000 GAL OK Douglas Road S.T.
CLEANOUTS A.M. NO
P.M. YES

DISTRIBUTION BOX LEVEL —————

DRAIN FIELD/TITLE DEPTH 10[±] FT. TRENCH WIDTH 2 FT. INLET DEPTH 2 FT.

EFFECTIVE GRAVEL DEPTH 8^{AVERAGE} FT. TOTAL LENGTH 65[±] FT.

NUMBER OF TRENCHES 1 ONE SIDEWALL/BOTTOM AREA 520[±] SQ. FT.

DRYWALL INSIDE DIAMETER ————— FT. EFFECTIVE DEPTH BELOW INLET ————— FT.

ABSORBENT AREA 520 SQ. FT.

REMARKS: A.M. 10-4-90 PARTIAL COVER FROM HOUSE TO SEPTIC TANK
TO PROVIDE DRAWING FROM SEPTIC TO TRENCHES J.B.G.
& DEPTH 10' LENGTH & INLET TO TRENCHES. C.B.
P.M. SEPTIC TANK ONLY - NO WORK ON TRENCH PARTIAL C.B. & J.B.G.
10/4 P.M. HOLD FOR A CALL. 10-5-90 TRENCH TO BE 65' ± 10' DEEP 2' WIDE
TO COVER AS FINISH - MATERIAL ON SITE J.B.G. & C.B.

DATE SYSTEM APPROVED 10/5/90 INSPECTOR C.B. [Signature]

J.B.G.