

12-13-90
am

Tax ID-02-197332

PERMIT

SEWAGE DISPOSAL SYSTEM

MARYLAND STATE DEPARTMENT OF HEALTH DISTRICT _____

HOWARD COUNTY

BUREAU OF ENVIRONMENTAL HEALTH
461-9933

P 46689

A REPAIR

DATE 12/11/90

DATE SYSTEM APPROVED 12/13/90

INSPECTOR M. Ripkin

INDEXED

Jenkins Brothers IS PERMITTED TO INSTALL _____ ALTER X

ADDRESS Route 144, Ellicott City, Maryland 21043 PHONE 465-6646

SUBDIVISION _____ ROAD 2376 Daniels Road LOT _____

PROPERTY OWNER Smith
2376 Daniels Road

ADDRESS Ellicott City, Maryland 21043

IF GARBAGE GRINDER IS USED INCREASE SEPTIC TANK CAPACITY BY 50% AND ABSORPTION AREA BY 22%.

GARBAGE GRINDER? YES _____ NO _____

SEPTIC TANK CAPACITY _____ GALLONS NUMBER OF BEDROOMS 3

REPAIR - PURPOSE - TO REPLACE FAILING SEPTIC SYSTEM.

CALL FOR INSPECTION WHEN GROUND IS OPENED SO SANITARIAN CAN RECOMMEND REPAIR.

PLANS APPROVED BY C. Williams DATE 12/11/90

COVER NO WORK UNTIL INSPECTED AND APPROVED

NEITHER THE HOWARD COUNTY COUNCIL NOR THE HEALTH DEPARTMENT IS RESPONSIBLE FOR THE SUCCESSFUL OPERATION OF ANY SYSTEM

NOTE: CLEANOUT REQUIRED EVERY 70 FEET OF SEWER LINE AND/OR AT 90° SWEEPS IN LINES FROM HOUSE TO DRAIN FIELDS

NOTE: ALL PARTS OF SEPTIC SYSTEMS (I.E. TANK, DISTRIBUTION BOX, TRENCHES) TO BE 100 FEET FROM WELL (UNLESS OTHERWISE SPECIFICALLY AUTHORIZED)

NOTE: IF DEEP TRENCHES ARE USED CALL FOR INSPECTION BEFORE AND AFTER PLACING GRAVEL IN TRENCHES

NOTE: NO DRY WELL SHALL EXCEED 15 FOOT IN DIAMETER NO ABSORPTION TRENCH TO EXCEED 100 FEET IN LENGTH.

NOTE: ALL PIPE FROM HOUSE TO SEPTIC TANK MUST BE CAST IRON OR SCHEDULE 40 PVC OR ABS

PERMIT VOID AFTER TWO YEARS


NOTE: INSTALL STAND PIPE ON SEPTIC TANK AND DRY WELL. STAND PIPES MUST BE 6 INCHES IN DIAMETER. CAST IRON, CONCRETE OR TERRA COTTA OR PVC OR ABS ACCEPTED. IF TOP OF SEPTIC TANK IS DEEPER THAN 3 FEET, MANHOLE TO GRADE REQUIRED

NOTE: DISTRIBUTION BOXES MUST HAVE BAFFLES

***INSTALLER IS RESPONSIBLE FOR OBTAINING FINAL APROVAL ON THIS PERMIT**

*CALL 461-9933 FOR INSPECTION OF SEPTIC SYSTEMS.

R 46689

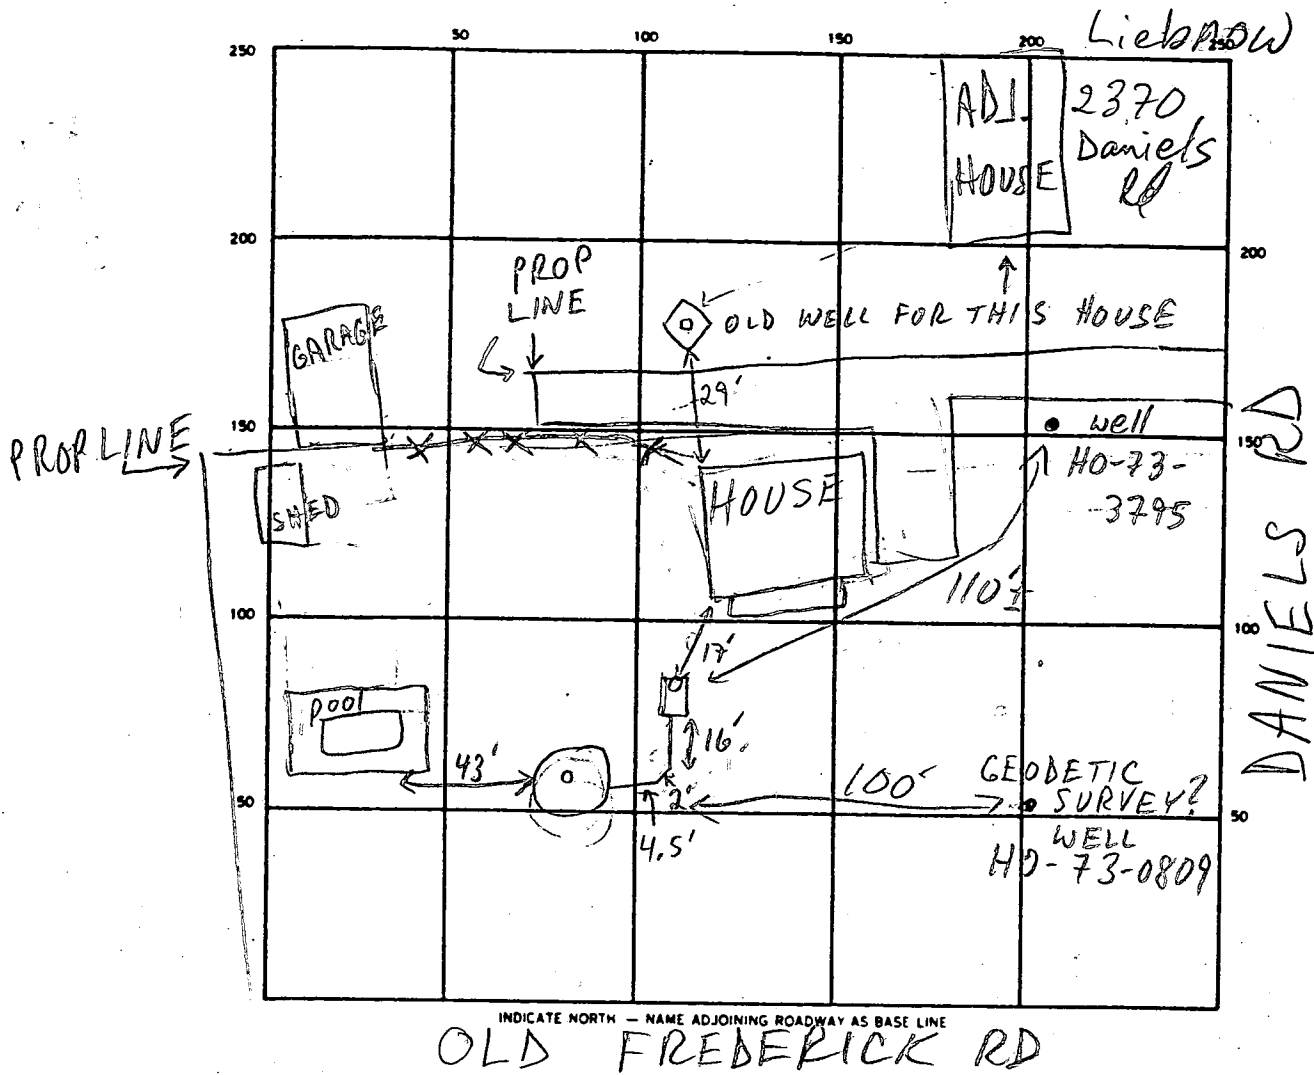

INDICATE NORTH - NAME ADJOINING ROADWAY AS BASE LINE

OLD FREDERICK RD

SEPTIC TANK LEVEL 1000 GAL - OK S.T. OK D/W OK

DISTRIBUTION BOX LEVEL

DRAIN FIELD/TILE FIELD DEPTH FT. TRENCH WIDTH FT. INLET DEPTH FT.

EFFECTIVE GRAVEL DEPTH FT. TOTAL LENGTH FT.

NUMBER OF TRENCHES ONE SIDEWALL/BOTTOM AREA SQ. FT.

DRYWELL INSIDE DIAMETER FT. EFFECTIVE DEPTH BELOW INLET FT.

ABSORBENT AREA SQ. FT.

REMARKS 12/13/90 SYSTEM PROBLEM NOT FAILING D/W, BUT
CLOG IN LINE FROM S.T. TO D/W - LINE REPLACED MR

OLD WELL ON ADJ PROP NEEDS TO BE ABANDONED MR

DATE SYSTEM APPROVED 12/13/90 INSPECTOR M. Rifkin

PERMIT

SEWAGE DISPOSAL SYSTEM

MARYLAND STATE DEPARTMENT OF HEALTH

HOWARD COUNTY

ELLICOTT CITY

INDEXED

DISTRICT 2

BLDG. PERMIT SIGNED
AND RETURNED 5/20/80
Serial # 43308

DATE 7/11/74

Roland Barth

IS PERMITTED TO INSTALL ALTER

ADDRESS Clarksville Pike, Ellicott City, Md.

PHONE 730-8495

A SEWAGE DISPOSAL-SYSTEM LOCATED AT _____

SUBDIVISION _____

ROAD 2376 Daniels Rd.

LOT _____

(Corner of Daniels Rd. & Old Frederick Rd.)

PROPERTY OWNER Charles Brown ~~Robert C. Liebner~~

ADDRESS Ruth Smith

SPECIFICATIONS - 2 bedrooms or 3 bedrooms

DRAIN FIELD _____ DEPTH _____ FEET, BOTTOM AREA _____ SQ. FT.

SEEPAGE PITS _____ ABSORBENT SIDE-WALL AREA _____ SQ. FT.

SEPTIC TANK CAPACITY 1,000 GALLONS and will be located no closer than 10 ft. from the

FOR GARBAGE GRINDER, INCREASE DISPOSAL AREA 22% & TANK CAPACITY 50%. house.

OTHER The dry well will be located 45 ft. from the south corner of the house (in a southerly direction), and 108 ft. from the Northwest corner of the property (measured from the Northwest-southwest property line. Dry well specifications: the inlet will enter the dry well at an declination of 3 or 4 ft. below ground surface. The maximum depth of the dry well will be 12 ft. below ground level. There will be no less than 112 ft. of sidewall area per bedroom for a total minimum area of 336 sq. ft.

NOTE: ALL PIPE FROM HOUSE TO DRY WELL MUST BE CAST IRON.

PERMIT VOID AFTER THREE YEARS.

NOTE: INSTALL STAND PIPE ON SEPTIC TANK AND DRY WELL.

BLDG. PERMIT SIGNED

AND RETURNED 10/16/80
Serial # 8176-Prod

PLANS APPROVED BY R. T. Moorefield

DATE 1/2/74


FILL SEPTIC TANK AND DISTRIBUTION BOX WITH WATER BEFORE CALLING FOR AN INSPECTION. COVER NO WORK UNTIL INSPECTED AND APPROVED.

NEITHER THE HOWARD COUNTY COMMISSIONERS NOR THE HEALTH DEPARTMENT IS RESPONSIBLE FOR THE SUCCESSFUL OPERATION OF ANY SYSTEM.

Building Permit
AND RETURNED 9/28/81
Serial # 47839

Howard County Health Dept.
3716 Court Place
Ellicott City, Maryland 21043

A 193022

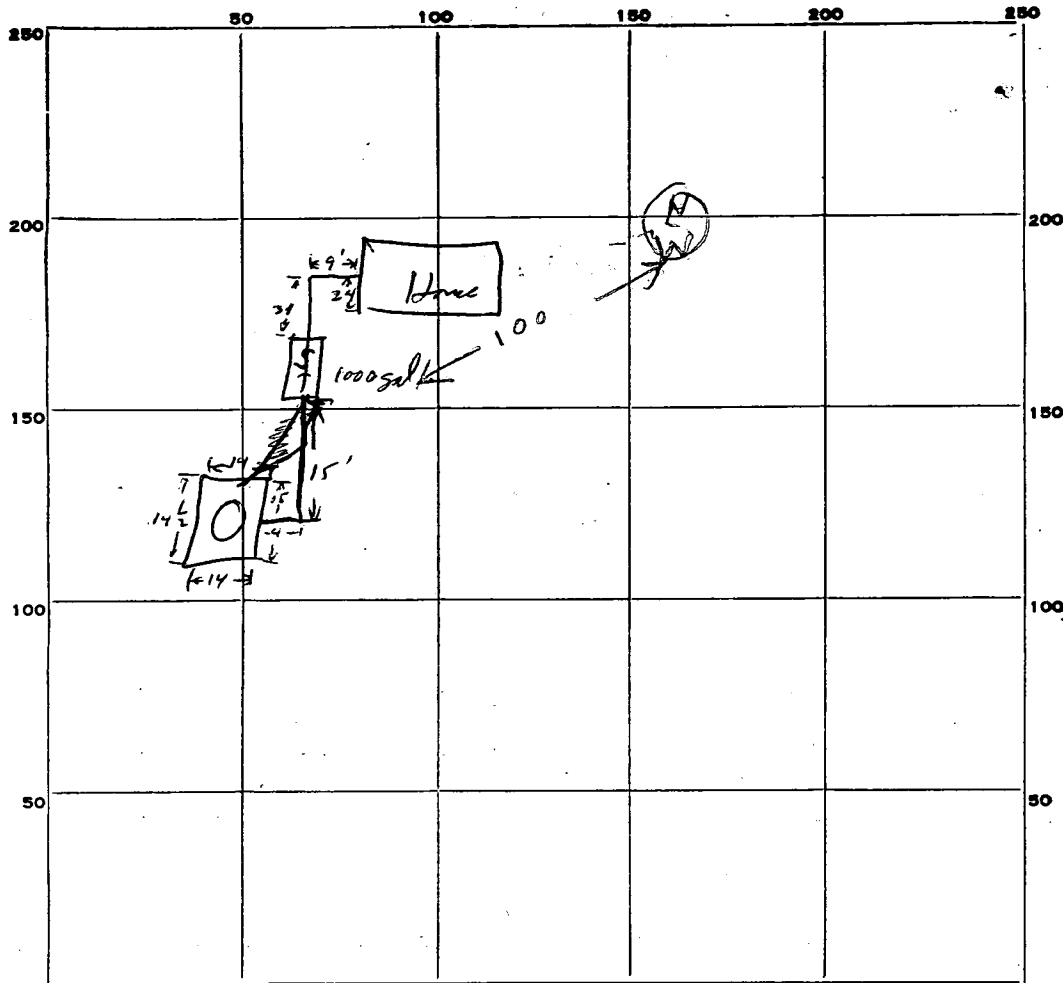

INDICATE NORTH. - NAME ADJOINING ROADWAY AS BASE LINE.

Old Fredrick Rd.

PERMIT CARD _____

SEPTIC TANK, LEVEL

CLEANOUTS

~~DISTRIBUTION BOX, LEVEL~~ _____

~~TILE FIELD, DEPTH~~ _____ FT. ~~TRENCH WIDTH~~ _____ FT.

~~GRAVEL DEPTH~~ _____ IN. ~~TOTAL LENGTH~~ _____ FT.

~~NUMBER OF TRENCHES~~ _____ ~~TOTAL BOTTOM AREA~~ _____

SEEPAGE PITS, ^{Perimeter} INSIDE DIAMETER 57 1/2 FT. DEPTH BELOW INLET 7 1/2 FT.

ABSORBENT AREA 431 SQ. FT.

57.5
2.5
287.5
402.5
431.25

REMARKS _____

DATE SYSTEM APPROVED

7/12/74

INSPECTOR

R. Moore

4-12' holes
on 10,000 ft.

L. Preliminary

APPLICATION

A 19302

SEWAGE DISPOSAL TESTING

P _____

12/4/73
9:30 AM

STATE OF MARYLAND - DEPARTMENT OF HEALTH AND MENTAL HYGIENE

DISTRICT 2

HOWARD COUNTY HEALTH DEPARTMENT
ENVIRONMENTAL HEALTH SERVICES

DATE 11/14/73

P. O. BOX 476, ELLICOTT CITY, MARYLAND 21043
TELEPHONE: 465-5000, EXT. 356

The septic tank will be no smaller than 1000 gal. capacity, and ~~shall~~ ^{will be located} no closer than 10 feet from the house. The Dry well will be located 45 feet from the south corner of the house (in a southerly direction), and 08 feet from the Northwest corner of the property (measured from the Northwest-Southeast property line.)

3rd
pm 9/11/74

Dry well specifications: The inlet will enter the drywell at an elevation of 12 feet below ground surface. The maximum depth of the dry well will be 12 feet below ground level. There will be no less than 112 feet of sidewall area per bedroom for a total minimum area of 336 square feet.

TO: THE COUNTY HEALTH OFFICER
ELLICOTT CITY, MARYLAND

I, HEREBY, APPLY FOR THE NECESSARY TEST IN ORDER TO CONSTRUCT (OR RECONSTRUCT) A SEWAGE DISPOSAL SYSTEM.

PROPERTY OWNER Charles T. Webb

ADDRESS 2370 Daniels Road, Ellicott City, Md. PHONE 465-3049

PROPERTY LOCATION:

SUBDIVISION _____ LOT NO. _____

ROAD AND DESCRIPTION Daniels Rd.

SIZE OF LOT 1.5133 acres TYPE BLDG. Existing house
3

IF NOT SINGLE RESIDENCE DESCRIBE _____
NUMBER OF BEDROOMS (Single Fmly. Dwllg.)

THE SYSTEM INSTALLED UNDER THIS APPLICATION IS ACCEPTABLE ONLY UNTIL PUBLIC FACILITIES BECOME AVAILABLE.

SIGNATURE OF APPLICANT Charles J. Webb

APPROVED BY Robert T. Moorefield FOR Dry well DATE 1/2/74
(KIND OF SYSTEM)

REJECTED BY _____ FOR _____ DATE _____
(KIND OF SYSTEM)

HOLD PENDING FURTHER TESTS _____ DATE _____

REASONS FOR REJECTION OR HOLDING _____

THIS IS NOT A PERMIT

SECRET

SECRET

INDICATE NORTH - NAME ADJOINING ROADWAY AS BASE LINE.

DATE	TEST NO.	DEPTH	PRE-WET		TEST - 1" DROP		TIME
			START	STOP	START	STOP	

REMARKS _____

TYPE OF SOIL _____

APPLICATION

A 19302

SEWAGE DISPOSAL TESTING

P _____

STATE OF MARYLAND - DEPARTMENT OF HEALTH AND MENTAL HYGIENE

HOWARD COUNTY HEALTH DEPARTMENT
ENVIRONMENTAL HEALTH SERVICES
P. O. BOX 476, ELLICOTT CITY, MARYLAND 21043
TELEPHONE: 465-5000, EXT. 356

DISTRICT 2

DATE 11/14/73

TO: THE COUNTY HEALTH OFFICER
ELLICOTT CITY, MARYLAND

I, HEREBY, APPLY FOR THE NECESSARY TEST IN ORDER TO CONSTRUCT (OR RECONSTRUCT) A SEWAGE DISPOSAL SYSTEM.

PROPERTY OWNER Charles T. Webb

ADDRESS 2370 Daniels Road, Ellicott City, Md. PHONE 465-3049

PROPERTY LOCATION:

SUBDIVISION _____ LOT NO. _____

ROAD AND DESCRIPTION Daniels Rd.

SIZE OF LOT 1.5133 acres TYPE BLDG. Existing house
3

IF NOT SINGLE RESIDENCE DESCRIBE _____
NUMBER OF BEDROOMS.
(Single Fmly. Dwlg.)

THE SYSTEM INSTALLED UNDER THIS APPLICATION IS ACCEPTABLE ONLY UNTIL PUBLIC FACILITIES BECOME AVAILABLE.

SIGNATURE OF APPLICANT Charles J. Webb


APPROVED BY _____ FOR _____ DATE _____
(KIND OF SYSTEM)

REJECTED BY _____ FOR _____ DATE _____
(KIND OF SYSTEM)

HOLD PENDING FURTHER TESTS _____ DATE _____

REASONS FOR REJECTION OR HOLDING _____

THIS IS NOT A PERMIT

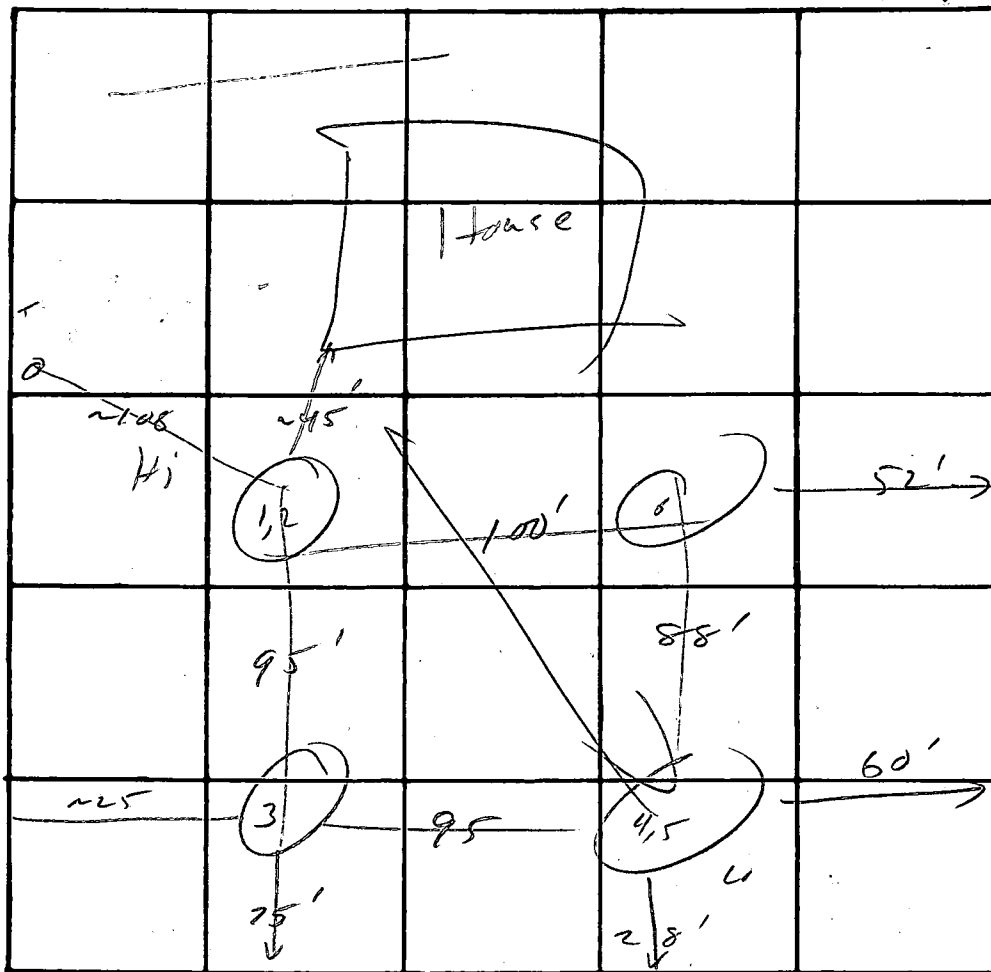

INDICATE NORTH. - NAME ADJOINING ROADWAY AS BASE LINE.

test dug to Old Fredrick Rd.

@ 11-12' granite rocks

DATE	TEST NO.	DEPTH	PRE-WET		TEST - 1" DROP		TIME
			START	STOP	START	STOP	
12/4/23	1	10/12	948	950	950	954	4
	2	4	951	955	955	1005	10
	3		Vis	Sand (brown)			
	4	4	10 ¹⁴	10 ¹⁵	10 ¹⁵	10 ²⁰	5
	5	10/12	1004	1006	1006	1008	12
	6	10	Vis -	dark loam, rock @ ~ 8 1/2' (granite)			

loamy sand w/ small rocks

Clay to 2 1/2' becomes sand below

Use #3 as First Repair

adjacent property has no apparent problems

REMARKS

RZ

TYPE OF SOIL

B 1 7918

OWNER BROWN CHARLES

STREET OR RFD 8848 B Toward-Camden BLV.

CITY ELLICOTT CITY MD 21043

DATE 9/4/74

POST OFFICE 2:30

B 1 CONTINUED

DRILLER INFORMATION

DATE 8/12/74 LICENSE NUMBER 209

HAWARD Dillon

SIGNATURE [Signature]

B 2

WELL INFORMATION

APPROXIMATE DEPTH OF WELL 160 FEET

APPROXIMATE DIAMETER OF WELL 6 (NEAREST INCH)

METHOD OF DRILLING USED (CIRCLE APPROPRIATE METHOD)

DRIVEN ROTARY (HYDRAULIC ROTARY)

REVERSE ROTARY DRIVE-POINT

REPLACEMENT OR DEEPEMED WELLS (CIRCLE APPROPRIATE BOX)

THIS WELL WILL NOT REPLACE AN EXISTING WELL

THIS WELL WILL REPLACE AN EXISTING WELL THAT IS ABANDONED AND SEALED

THIS WELL WILL REPLACE AN EXISTING WELL TO BE USED AS A STANDBY

THIS WELL WILL DEEPEN AN EXISTING WELL (ENTER DEPTH OF WELL)

NO. OF COPIES FILLED IN BY DRILLER (CIRCLE IF ONLY)

DATE 8/15/74

[Signature]

B 3

COUNTY HARVARD

SUBDIVISION 2A

SECTION 44

MILES FROM TOWN CENTER 3

B 4

DIRECTION FROM TOWN (CIRCLE APPROPRIATE BOX)

WEST EAST NORTHWEST SOUTHWEST

NAME OF ROAD RT 99 OLD FREDERICK RD

DIRECTION FROM ROAD (CIRCLE APPROPRIATE BOX)

WEST EAST NORTH SOUTH

DISTANCE FROM ROAD (ENTER DISTANCE AND CIRCLE APPROPRIATE BOX) 100

DRAW A SKETCH OF THE LOCATION OF WELL IN RELATION TO THE ROAD AND STREAMS WITH NORTH IN THE DIRECTION OF THE ARROW. A RANGE FROM WELL TO NEAREST ROAD JUNCTION OR STREAM CROSSING IS SKETCHED ALSO SHOW, BY MEANS OF AN "X", THE WELL LOCATION IN THE MAP AND THE BOX NUMBER FROM THE WELL LOCATION MAP.

*Clearing open hole 20' corner of Rt. 99 & Daniels Rd. well depth 150' rd. MD * 99 - 70 log*

couple of hundred in on Daniels Rd. - says says Well.

OK HVK 9-4-74

BOY NUMBER 850

530

DEPTH COORDINATE 80 81 82 83 84 85

POST COORDINATE 87 88 89 90 91 92 93

ELEVATION AT WELL HEAD (FEET) 98 99 100 101

NO. OF COPIES FILLED IN BY DRILLER (CIRCLE IF ONLY)

DATE 8/15/74

[Signature]

B 1 1579 SEQUENCE NO. WRA USE ONLY
(THIS NUMBER IS TO BE PUNCHED IN COLS. 3-6 ON ALL CARDS)


STATE OF MARYLAND
APPLICATION FOR PERMIT TO DRILL WELL

WRA PERMIT NUMBER
H0-73-3795
fill in this form completely

DATE RECEIVED 2/9/81
8 (WRA USE ONLY) 13
OWNER INFORMATION
BROWN CHARLES E
LAST NAME OWNER FIRST NAME
2376 DANIELS RD
STREET OR RFD
ELLICOTT CITY 21043
TOWN STATE ZIP


B 3 LOCATION OF WELL
COUNTY HOWARD
SUBDIVISION
SECTION LOT
NEAREST TOWN ELLICOTT CITY
MILES FROM TOWN (enter 0 if in town)

B 1 CONTINUED DRILLER INFORMATION
HOWARD DILLON 209
DRILLER'S NAME LICENSE NO. 80
Howard Dillon 2/6/81
SIGNATURE DATE

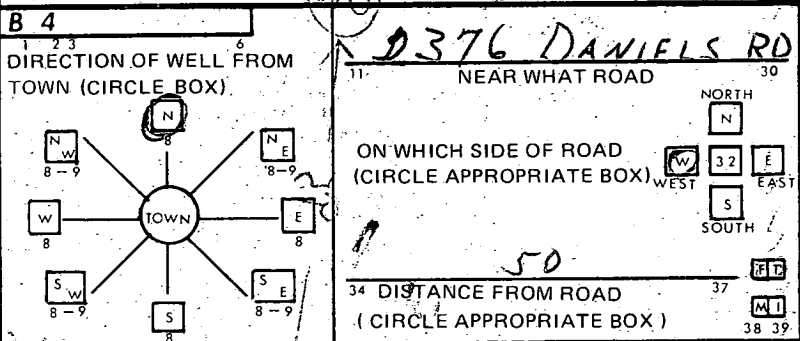


B 2 WELL INFORMATION
APPROX. PUMPING RATE (GAL. PER MIN)
AVERAGE DAILY QUANTITY NEEDED (GAL. PER DAY)

- USE FOR WATER (CIRCLE APPROPRIATE BOX)
- HOME (SINGLE OR DOUBLE HOUSEHOLD UNIT ONLY)
 - FARMING (LIVESTOCK WATERING & AGRICULTURAL IRRIGATION)
 - INDUSTRIAL, COMMERCIAL, STATE AND FEDERAL GOV. OTHER (REQUIRES APPROPRIATION PERMIT)
 - PUBLIC OR PRIVATE WATER COMPANY (REQUIRES APPROPRIATION PERMIT AND STATE HEALTH DEPARTMENT APPROVAL)
 - TEST, OBSERVATION, MONITORING (MAY REQUIRE APPROPRIATION PERMIT)

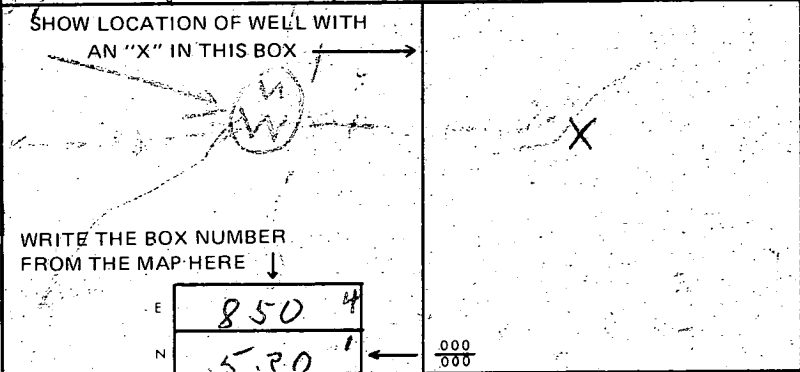

APPROXIMATE DEPTH OF WELL 101 p 100 FEET
APPROXIMATE DIAMETER OF WELL 6 INCH

Method of Drilling (circle one)
BORED (OR AUGERED) JETTED JETTED & DRIVEN
AIR ROTARY AIR PERCUSSION ROTARY (HYDRAULIC)
CABLE REVERSE ROTARY DRIVE POINT
other

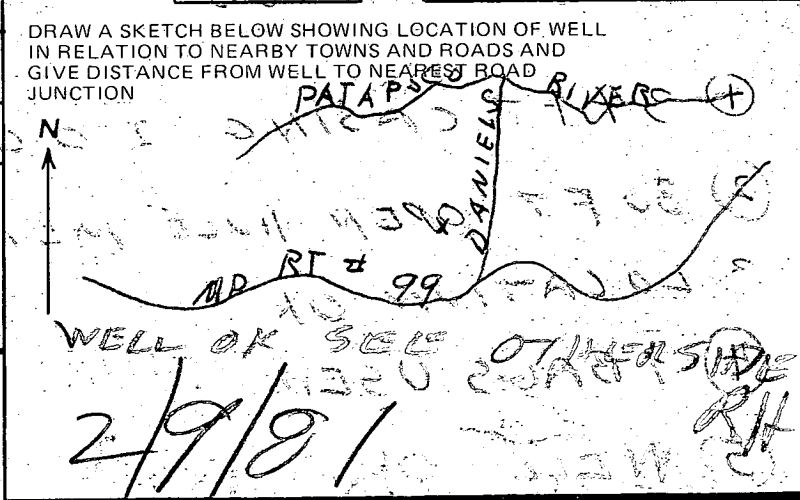


REPLACEMENT OR DEEPEMED WELLS (Circle Appropriate Box)
 THIS WELL WILL NOT REPLACE AN EXISTING WELL
 THIS WELL WILL REPLACE A WELL THAT WILL BE ABANDONED AND SEALED
 THIS WELL WILL REPLACE A WELL THAT WILL BE USED AS A STANDBY
 THIS WELL WILL DEEPEMED AN EXISTING WELL
PERMIT NUMBER OF WELL TO BE REPLACED OR DEEPEMED (IF AVAILABLE)

B 4 NOT TO BE FILLED IN BY DRILLER HEALTH DEPARTMENT APPROVAL
HOWARD COUNTY NAME
710302 COUNTY NO.

Not to be filled in by driller (WRA USE ONLY)
APPROX. PERMIT NUMBER GAP
FORCE INITIALS CONDITIONS
WRITE INITIALS IN BOX

EHA SIGNATURE STATE HEALTH CIRCLE BOX
MO DAY YR Frank Skinner Sanitarian 2/6/81
CO SIGNATURE DATE
NORTH 531 EAST 0854 ELEV. (FT.)
GRID 50 55 GRID 57 63 65 68

B 5 SPECIAL CONDITIONS (WRA USE ONLY)

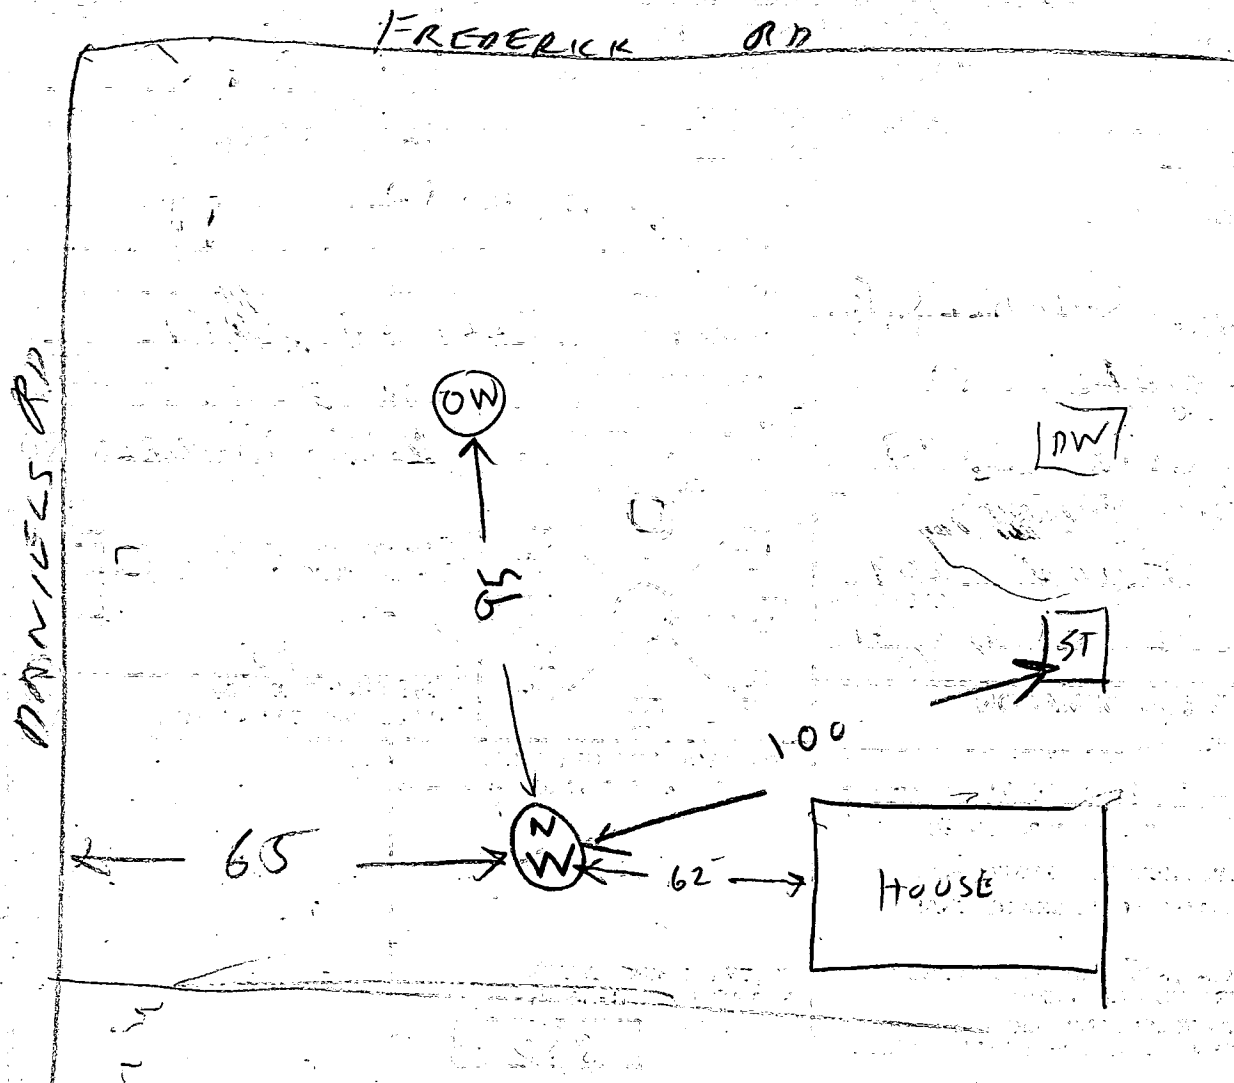

- 2/9/81
- ① 34 FT CASING 20 FT OF GROUND
 - ② 30 FT OPEN HOLE MEASURED WITH A STRING
 - ③ LOCATION OK
 - ④ 7 BAGS USED
 - ⑤ WELL OK

6

BH

C 4740
 SEQUENCE NO. (WRA USE ONLY)
 2 3 (SEQ. NO.)
 (THIS NUMBER IS TO BE PUNCHED IN COLUMNS 3-6 ON ALL CARDS)

STATE OF MARYLAND
 WATER RESOURCES ADMINISTRATION
 TAWES STATE OFFICE BLDG., ANNAPOLIS, MD. 21401
 WELL COMPLETION REPORT

THIS REPORT MUST BE SUBMITTED WITHIN 30 DAYS AFTER WELL COMPLETION
 FILL IN THIS FORM COMPLETELY
 COUNTY NUMBER

DATE RECEIVED (WRA USE ONLY) 10/14/74
 DATE WELL COMPLETED 15 16 17 18 19 20
 DEPTH OF WELL 150 (TO NEAREST FOOT)
 PERMIT NO. FROM "PERMIT TO DRILL WELL" AC-72-0809
 28 29 30 31 32 33 34 35 36 37
 DRILLERS IDENTIFICATION NO. 209

OWNER BROWN CHARLES
 LAST NAME FIRST NAME
 STREET OR RFD ELLICOTT CITY MD POST OFFICE 21043

WELL LOG

STATE THE KIND OF FORMATIONS PENETRATED, THEIR COLOR, DEPTH, THICKNESS AND IF WATER BEARING

DESCRIPTION (USE ADDITIONAL SHEETS IF NECESSARY)	FEET		CHECK IF WATER BEARING
	FROM	TO	
Clay	0	10	
Sand Stone	10	50	
Granite Rock	50	150 X	

GROUTING RECORD

WELL HAS BEEN GROUTED (CIRCLE APPROPRIATE BOX) YES NO
 44 44
 TYPE OF GROUTING MATERIAL (CIRCLE BOX)
 CEMENT BENTONITE CLAY
 45 46 45 46
 NO. OF BAGS 6 NO. OF POUNDS 587
 GALLONS OF WATER 70
 DEPTH OF GROUT SEAL (TO NEAREST FOOT)
 FROM 0 FT. TO 23 FT.
 (ENTER 0 IF FROM SURFACE)

CASING RECORD

INSERT APPROPRIATE CODE BELOW

STEEL CONCRETE
 PLASTIC OTHER
 MAIN CASING TYPE S T
 NOMINAL DIAMETER TOP (MAIN) CASING (NEAREST INCH) 6
 TOTAL DEPTH OF MAIN CASING (NEAREST FOOT) 23

OTHER CASING (IF USED)

EACH CASING	DIAMETER (INCH)	DEPTH (FEET) FROM	TO

SCREEN RECORD

INSERT APPROPRIATE CODE BELOW

STEEL BRASS OR BRONZE OPEN HOLE
 PLASTIC OTHER
 C 2
 1 2 3 (SEQ. NO.) 6
 DEPTH (NEAREST WHOLE FOOT)
 FROM 23 TO 150
 8 9 11 15 17 21
 23 24 26 30 32 36
 38 39 41 45 47 51
 SLOT SIZE 1, 2, 3

DIAMETER OF SCREEN 56 (NEAREST INCH)
 FROM 56 TO 60
 GRAVEL PACK 153
 IF WELL DRILLED WAS A FLOWING WELL CIRCLE BOX 68 F

WRA USE ONLY (NOT TO BE FILLED IN BY DRILLER) (E.R.O.S.)

TELESCOPE CASING 70 LOG INDICATOR 72 OTHER DATA AVAILABLE 74 75 76

PUMPING TEST

HOURS PUMPED (TO NEAREST HOUR) 6
 PUMPING RATE (GALLONS PER MINUTE TO NEAREST GALLON) 1
 11 15
 METHOD USED TO MEASURE PUMPING RATE TIME

WATER LEVEL: (DISTANCE FROM LAND SURFACE)

BEFORE PUMPING 50 (NEAREST FOOT)
 17 20
 WHEN PUMPING 150 (NEAREST FOOT)
 22 25

TYPE OF PUMPED USED (CIRCLE APPROPRIATE BOX) (FOR PUMPING TEST)

HAIR PISTON TURBINE
 27 27 27
 CENTRIFUGAL ROTARY OTHER (DESCRIBE BELOW)
 27 27 27
 JET SUBMERSIBLE
 27 27

PUMP INSTALLED


TYPE OF PUMP (WRITE APPROPRIATE LETTER IN BOX - SEE ABOVE: A, C, J, P, R, S, T, O) 29

DRILLER WILL INSTALL PUMP (CIRCLE APPROPRIATE BOX) YES NO

CAPACITY:
 GALLONS PER MINUTE (TO NEAREST GALLON) 31 35
 PUMP HORSE POWER 37 41
 PUMP COLUMN LENGTH (NEAREST FOOT) 43 47

CASING HEIGHT (CIRCLE APPROPRIATE BOX AND ENTER CASING HEIGHT)

ABOVE BELOW
 LAND SURFACE 2 (NEAREST FOOT)
 49 50 51

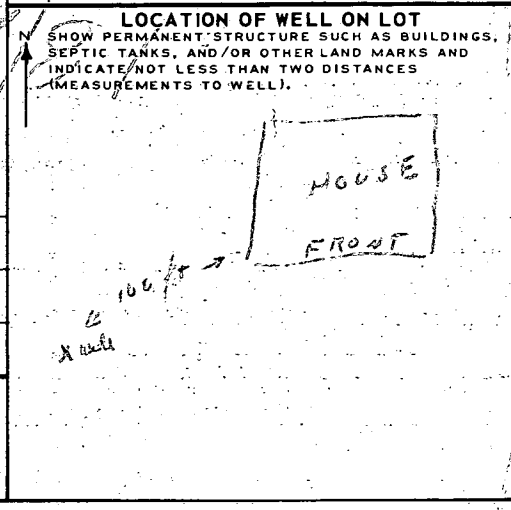

CIRCLE APPROPRIATE BOXES

A WELL WAS ABANDONED AND SEALED WHEN THIS WELL WAS COMPLETED
 ELECTRIC LOG OBTAINED
 TEST WELL CONVERTED TO PRODUCTION WELL


I HEREBY CERTIFY THAT I HAVE COMPLIED WITH ALL CONDITIONS STATED ON THE ABOVE-CAPTIONED "PERMIT TO DRILL WELL", AND THAT INFORMATION CONTAINED IN THIS REPORT IS TRUE, ACCURATE, AND COMPLETE TO THE BEST OF MY KNOWLEDGE, INFORMATION AND BELIEF.

DRILLERS NAME
 (PLEASE PRINT) HOWARD DILLON
 SIGNATURE Howard Dillon


David E. Boyd
548/412

Charles T. Webb
234/77
2.063 Ac. ±

Edwin Reinhardt
179/394

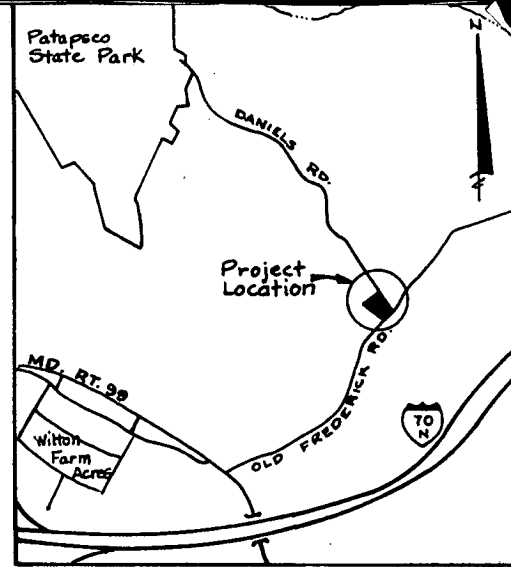

Vicinity Map
1" = 2000'

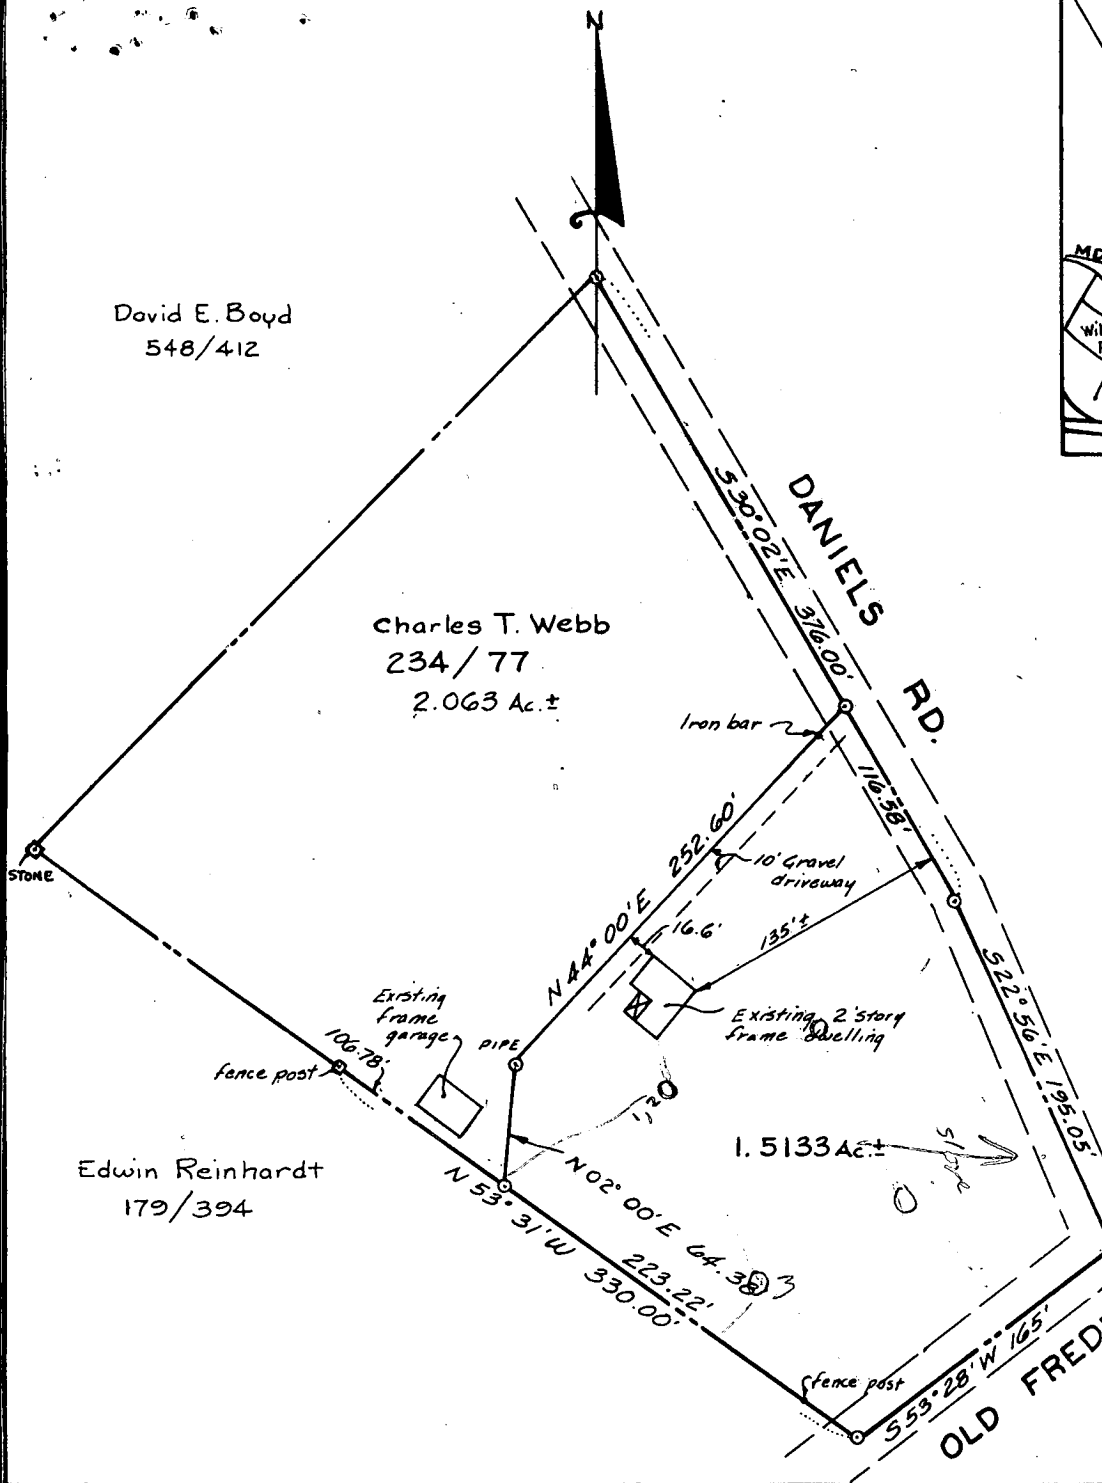

PROPERTY OF: CHARLES T. WEBB
2nd. ELECTION DISTRICT
HOWARD COUNTY, MD.

Scale: 1" = 100' November 7, 1973
Dwn. H.R.M.

- GENERAL NOTES**
- Property shown hereon located on tax map 18
 - Title Reference: Liber 234 folio 77
 - Total Number of Lots: 1
 - Total Area of Tract: 1.5133 Ac. ±
 - Zoned:
 - No new buildings to be constructed at a distance less than the building restriction Lines as shown.

APPROVED: For Private Water And Private Sewerage Systems, Howard County Health Department

County Health Officer _____ Date _____

APPROVED: Howard County Office of Planning & Zoning

Planning Director _____ Date _____

Chief, Division of Land Development and Transportation Planning _____ Date _____

APPROVED: For Public Water, Public Sewerage and Storm Drainage Systems and Roads
HOWARD COUNTY DEPARTMENT OF PUBLIC WORKS

Director _____ Date _____

Chief, Bureau of Highways _____ Date _____

OWNER CERTIFICATE:

I, the undersigned owner of the property shown hereon, my heirs or assigns, adopt this plan of subdivision and do hereby establish the building restriction line shown hereon in order to comply with the general plan of highways of Howard County and including the land dedicated hereon for the widening of Old Frederick Road.

Charles T. Webb
Mary H. Webb Nov 12/1973

WALTER PARK
HUDKINS ASSOCIATES • 231 Joseph Square
Columbia, Md. 21044