

7/9/73

off 7-9-73  
18521  
15805  
A

# PERMIT

SEWAGE DISPOSAL SYSTEM

MARYLAND STATE DEPARTMENT OF HEALTH

HOWARD COUNTY

ELLICOTT CITY

DISTRICT 4th

## INDEXED

DATE 5/24/73

Jack Fyock

IS PERMITTED TO INSTALL  ALTER

ADDRESS Ten Oaks Road, Glenelg, Maryland PHONE 286-2939

A SEWAGE DISPOSAL SYSTEM LOCATED AT \_\_\_\_\_

SUBDIVISION \_\_\_\_\_ ROAD Carr's Mill Road LOT B

PROPERTY OWNER Russell C. and Dorothy M. Long

ADDRESS 4982 Eliots Oak Road, Columbia, Maryland 21043

SPECIFICATIONS 4 bedrooms

DRAIN FIELD \_\_\_\_\_ DEPTH \_\_\_\_\_ FEET, BOTTOM AREA \_\_\_\_\_ SQ. FT.

SEEPAGE PITS \_\_\_\_\_ ABSORBENT SIDE-WALL AREA \_\_\_\_\_ SQ. FT.

SEPTIC TANK CAPACITY 1250 GALLONS

FOR GARBAGE GRINDER, INCREASE DISPOSAL AREA 22% & TANK CAPACITY 50%.


OTHER Dry Well - One dry well and trench. Dig dry well pit 12 ft. square - set top and block for 10 ft. diameter and fill in rest of pit with gravel. Inlet pipe to be 5 ft. below original grade. Dry well to be 6 1/2 ft. deep below inlet pipe. Maximum depth for dry well is 11 1/2 ft. below original grade. Trench - come off dry well with 5 ft. of solid pipe and begin trench. Trench - 2 ft. wide - 35 ft. long and 11 to 11 1/2 ft. deep with 5 to 6 ft. of gravel in trench. Call for inspection of trench before gravel is installed. Place dry well center at point 60 ft. from right side line and 42 ft. in front of electric pole #480514 as seen when facing from front of lot. Trench is to go to right dry well - parallel with front lot line. NOTE: ALL PIPE FROM HOUSE TO DRY WELL MUST BE CAST IRON. PERMIT VOID AFTER THREE YEARS. NOTE: INSTALL STAND PIPE ON SEPTIC TANK AND DRY WELL.

PLANS APPROVED BY Donald W. Monaghan DATE 4/30/71

FILL SEPTIC TANK AND DISTRIBUTION BOX WITH WATER BEFORE CALLING FOR AN INSPECTION. COVER NO WORK UNTIL INSPECTED AND APPROVED.

NEITHER THE HOWARD COUNTY COMMISSIONERS NOR THE HEALTH DEPARTMENT IS RESPONSIBLE FOR THE SUCCESSFUL OPERATION OF ANY SYSTEM.

A 15805-

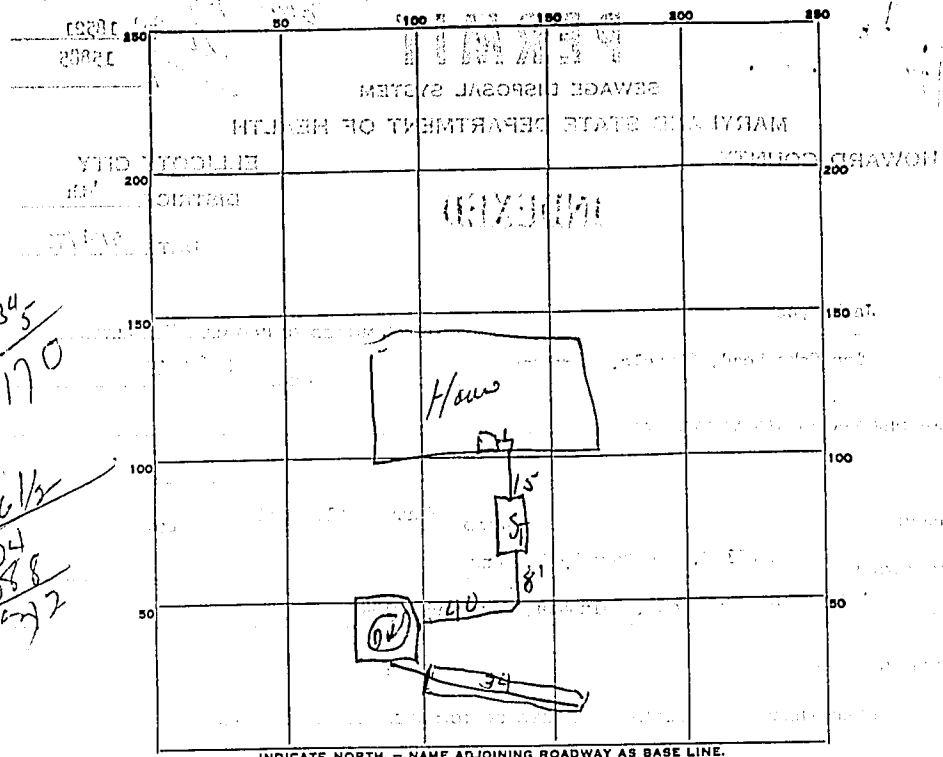

$\frac{345}{170}$   
 $\frac{24}{6\frac{1}{2}}$   
 $\frac{34}{388}$   
 $\frac{372}{2}$

PERMIT CARD OK  
 SEPTIC TANK, LEVEL OK CLEANOUTS OK  
 DISTRIBUTION BOX, LEVEL \_\_\_\_\_  
 TILE FIELD, DEPTH 12 FT. TRENCH WIDTH 2 FT.  
 GRAVEL DEPTH 60 IN. TOTAL LENGTH 34 FT.  
 NUMBER OF TRENCHES \_\_\_\_\_ TOTAL BOTTOM AREA \_\_\_\_\_  
 SEEPAGE PITS, INSIDE DIAMETER 48 FT. DEPTH BELOW INLET 61/2 FT.  
 ABSORBENT AREA 312 SQ. FT. + 170 inside system = 482

REMARKS \_\_\_\_\_

\_\_\_\_\_

\_\_\_\_\_

\_\_\_\_\_

DATE SYSTEM APPROVED 7/9/73 INSPECTOR [Signature]