

10/29/92  
[Handwritten initials]

1 of 2 D - 03-313778

# PERMIT

## SEWAGE DISPOSAL SYSTEM

### DEPARTMENT OF HEALTH AND MENTAL HYGIENE

P 48624

A 47544

DISTRICT \_\_\_\_\_

DATE 10/29/92

DATE SYSTEM APPROVED 10/30/92

INSPECTOR C.B. [initials]

#### HOWARD COUNTY HEALTH DEPARTMENT

BUREAU OF ENVIRONMENTAL HEALTH

313-2640

### INDEXED

Techno-Magic Plumbing & Heating IS PERMITTED TO INSTALL  ALTER

ADDRESS 952 Waterbury Heights Drive, Crownsville, MD 21032 PHONE 987-3230

SUBDIVISION Kings Grant LOT 2 ROAD 3207 Parliament Place

PROPERTY OWNER Mr. and Mrs. Vartan and Anahid Yousefian

ADDRESS \_\_\_\_\_

SEPTIC TANK CAPACITY 1250 GALLONS

NUMBER OF BEDROOMS 4

180 SQUARE FEET PER BEDROOM

LINEAR FEET OF TRENCH REQUIRED 144

\*\*SITE INSPECTION REQUIRED OF HOUSE EXCAVATION BEFORE SEPTIC PERMIT ISSUANCE. \*\*

*(OK TO SET DIST. BOX UP TO 10' FURTHER BACK ON LOT THAN SPECIFIED.)*  
*10/29/92*

TRENCHES - Trench to be 2 feet wide. Inlet 5 feet below original grade. Bottom maximum Depth 10 feet below original grade. Effective area begins at 5 feet below original grade. 5 feet of stone below distribution pipe.

LOCATION - Place the distribution box 172 feet from the front lot line and 182 feet from the right side of the lot as seen when facing the lot from ~~Dead Ahead Court~~. Run the trenches along contour toward the back lot line. *PARLIAMENT PLACE*

NOTE - NO trench to exceed 100 feet in length. Provide 6" - 8" diameter cleanout and cap to grade or above on septic tank. *OK 4/13/92 RIF*

PLANS APPROVED BY Raymond Hodges Revised DATE 10/29/91

COVER NO WORK UNTIL INSPECTED AND APPROVED

NEITHER THE HOWARD COUNTY COUNCIL NOR THE HEALTH DEPARTMENT IS RESPONSIBLE FOR THE SUCCESSFUL OPERATION OF ANY SYSTEM

NOTE: CLEANOUT REQUIRED EVERY 70 FEET OF SEWER LINE AND/OR AT 90° SWEEPS IN LINES FROM HOUSE TO DRAIN FIELDS, 90° ELBOWS NOT ACCEPTABLE.

NOTE: ALL PARTS OF SEPTIC SYSTEMS (I.E. TANK, DISTRIBUTION BOX TRENCHES) TO BE 100 FEET FROM WELL (UNLESS OTHERWISE SPECIFICALLY AUTHORIZED)

NOTE: IF DEEP TRENCH(ES) ARE USED CALL FOR INSPECTION BEFORE AND AFTER PLACING GRAVEL IN TRENCH(ES)

NOTE: NO DRY WELL SHALL EXCEED 15 FOOT IN DIAMETER NO ABSORPTION TRENCH TO EXCEED 100 FEET IN LENGTH

NOTE: ALL PIPE FROM HOUSE TO SEPTIC TANK MUST BE CAST IRON OR SCHEDULE 35/40 PVC OR ABS

PERMIT VOID AFTER TWO YEARS


BLDG. PERMIT SIGNED AND RETURNED 4/29/93  
*Serial # 48198 - deck*

NOTE: INSTALL STAND PIPE ON SEPTIC TANK AND DRY WELL STAND PIPES MUST BE 6 INCHES IN DIAMETER CAST IRON. CONCRETE OR TERRA COTTA OR PVA OR ABS ACCEPTED. IF TOP OF SEPTIC TANK IS DEEPER THAN 3 FEET. MANHOLE TO GRADE REQUIRED.

NOTE: DISTRIBUTION BOXES MUST HAVE BAFFLES

**\*INSTALLER IS RESPONSIBLE FOR OBTAINING FINAL APPROVAL ON THIS PERMIT**

A 47544

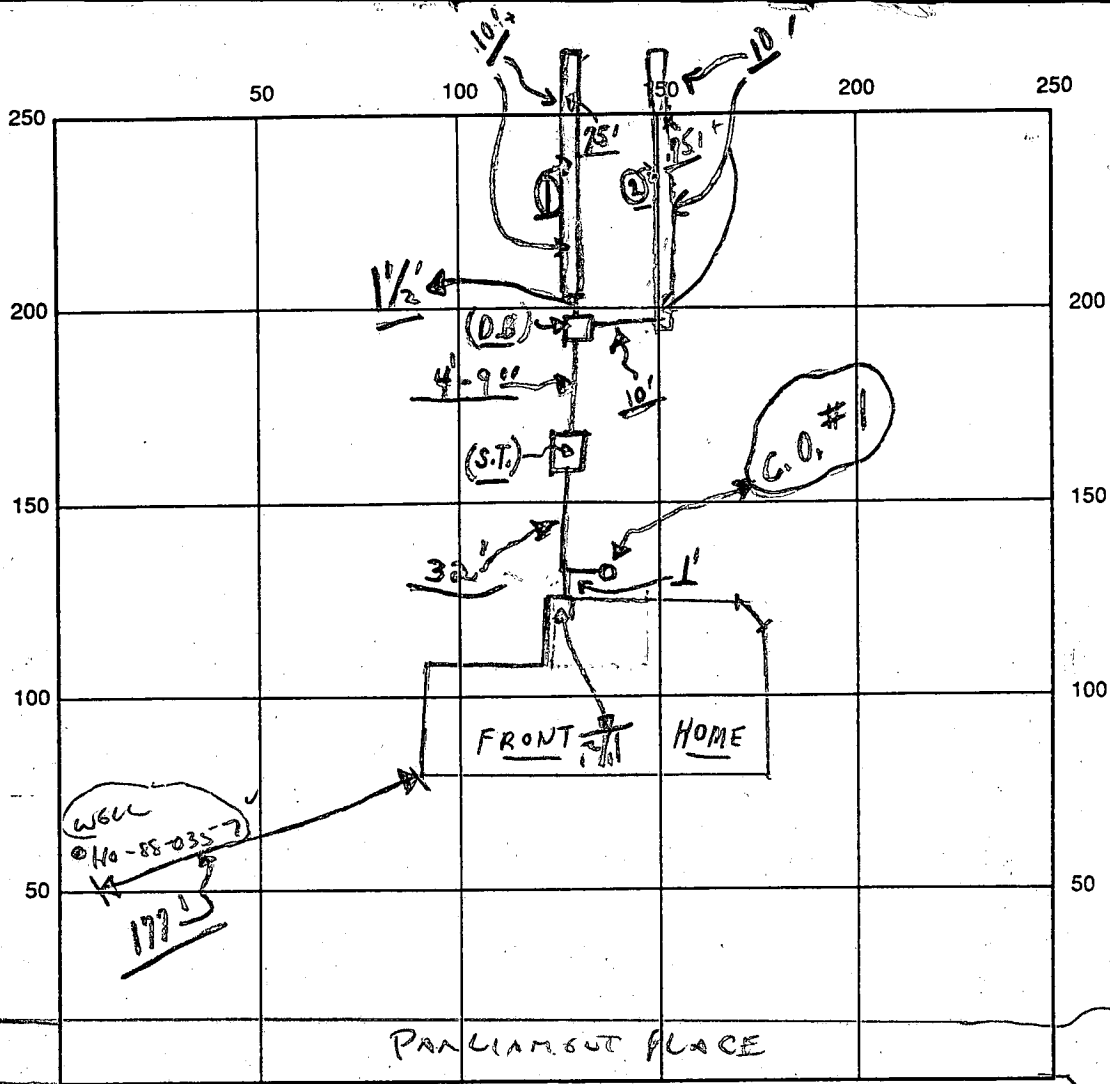

INDICATE NORTH - NAME ADJOINING ROADWAY AS BASE LINE

SEPTIC TANK LEVEL OK CLEANOUTS (No S.T. to be put on) C.O. #1 OK

DISTRIBUTION BOX LEVEL OK (Baffle in)

DRAIN FIELD/TITLE DEPTH 10<sup>+</sup> FT. TRENCH WIDTH 2 FT. INLET DEPTH 5 FT.

EFFECTIVE GRAVEL DEPTH 5 FT. TOTAL LENGTH 150 FT. } = 150'

NUMBER OF TRENCHES 2 ONE SIDEWALL/BOTTOM AREA 750 SQ. FT.

DRYWALL INSIDE DIAMETER — FT. EFFECTIVE DEPTH BELOW INLET — FT.

ABSORBENT AREA 750 SQ. FT.

REMARKS: 10/29/92 PAS-INSTALLATION INSP. OK TO ADJUST TANK LOCATION TO PROVIDE CLEARANCE FOR 20-25' DECK. CW.

A. 10/30/92 OK for stones in #0 trench. Partial OK to cover from house to access table. B. Late P.M. - Partial OK to cover #0 trench except for ends + middle, c.B. Very late - Final OK to cover as per c.B. (Material on site)

DATE SYSTEM APPROVED 10/30/92 INSPECTOR Charles Bryan Streater

# APPLICATION

PERCOLATION TESTING

A 47544  
P \_\_\_\_\_

HOWARD COUNTY HEALTH DEPARTMENT  
BUREAU OF ENVIRONMENTAL HEALTH  
P.O. BOX 476 ELLICOTT CITY, MARYLAND 21043  
TELEPHONE: 461-9933

DISTRICT \_\_\_\_\_

DATE 10-10-91

TO: THE COUNTY HEALTH OFFICER  
ELLICOTT CITY, MARYLAND

I HEREBY APPLY FOR THE NECESSARY TEST IN ORDER TO CONSTRUCT (OR RECONSTRUCT) A SEWAGE DISPOSAL SYSTEM.

PROPERTY OWNER Mr & Mrs. Vartan and Anahid Yousefian

ADDRESS ~~Parliament Place, West Friendship~~ 1250 Newfield Rd. Balt 2207  
PHONE 747-0187

PROSPECTIVE BUYER Agent BORIS GHAZARIAN PH. #. 987-3230

ADDRESS 952 Waterbury Heights Dr. Crownsville, MD. 21032  
PHONE \_\_\_\_\_

PROPERTY LOCATION:

SUBDIVISION KING GRANT LOT NO. 2

ROAD AND DESCRIPTION Rt 32 North (almost 3 miles before RT 70) make Right  
at parliament place Second lot on the left (3207 PARLIAMENT PLACE)

TAX MAP \_\_\_\_\_ PARCEL # \_\_\_\_\_

SIZE OF LOT 3.2 AC. TYPE BLDG. S.F.D.  
(SINGLE FAMILY DWELLING OR COMMERCIAL)

THE SYSTEM INSTALLED UNDER THIS APPLICATION IS ACCEPTABLE ONLY UNTIL PUBLIC FACILITIES BECOME AVAILABLE. I FULLY UNDERSTAND THE FEE CONNECTED WITH THE FILING OF THIS PERC TEST APPLICATION IS NON-REFUNDABLE UNDER ANY CIRCUMSTANCES. I ALSO AGREE TO COMPLY WITH ALL M.O.S.H.A. REQUIREMENTS IN TESTING THIS LOT.

Vartan Yousefian Anahid Yousefian  
(SIGNATURE OF APPLICANT)

APPROVED BY \_\_\_\_\_ FOR \_\_\_\_\_ DATE \_\_\_\_\_

REJECTED BY \_\_\_\_\_ FOR \_\_\_\_\_ DATE \_\_\_\_\_

HOLD PENDING FURTHER TESTS \_\_\_\_\_ DATE \_\_\_\_\_

REASONS FOR REJECTION OR HOLDING 10/30/91. PERC OK MUST CHANGE RH  
Mar 91 Send Specs to owner & agent above RH

HD-216


BLDG. PERMIT # \_\_\_\_\_  
4/3/92  
Serial # 411833-5 ED

# THIS IS NOT A PERMIT



4 bedroom

*10/29  
10/29  
note sent to owner  
10-11-91*

① SOIL PROFILE:

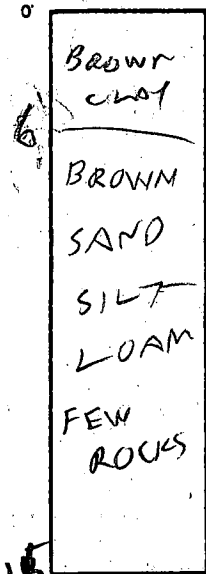

⑤

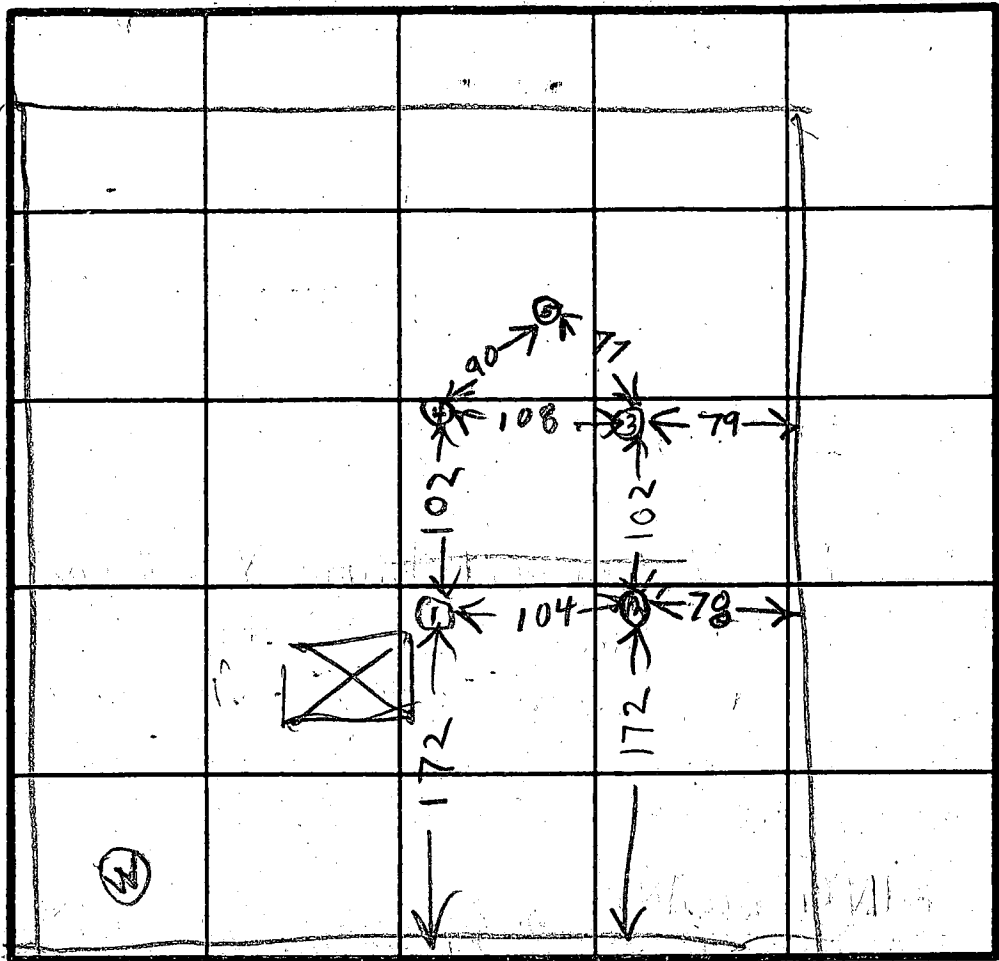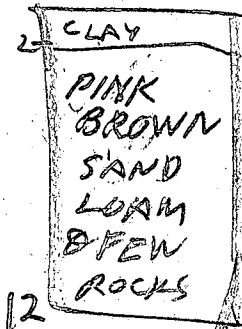

INDICATE NORTH - NAME ADJOINING ROADWAY AS BASE LINE.

DEAD AHEAD CT

DATE	TEST NO.	DEPTH	PRE-WET		TEST - 1' DROP		TIME	
			START	STOP	START	STOP		
29 Oct 19	1 S	5	1035	1058	1058	12025	10	
	1 P	7.5	1041	1049	1049	1059	10	
	1 V	13	OK BELOW 6 FT					
	2 S	6	1052	1020	1020	1205	45	
	2 V	13	FAIL SLOW SHELF					
	3 S	4.50	1056	1057	1057	1058	1	
	3 V	17	OK					
	4 S	4.5	1102	1104	1104	1107	3	
	4 V	13	OK					
	1 EV	15	OK BELOW 6 FT					
	5 S	3	1214	1216	1216	129	3	
	5 V	12	OK					

REMARKS \_\_\_\_\_




TYPE OF SOIL \_\_\_\_\_

TESTED BY RAYMOND HODGES

OWNER VARTAN YOUSEFIAN

BUILDING BORIS GHAZARIAN  
ALSO PRESENT

WORKER Danny Wecker etc

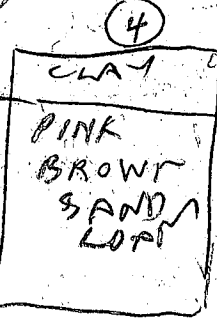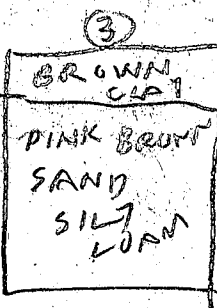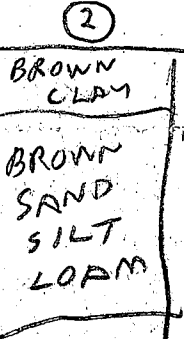

# APPLICATION

PERCOLATION TESTING

A 36594

P \_\_\_\_\_

HOWARD COUNTY HEALTH DEPARTMENT  
BUREAU OF ENVIRONMENTAL HEALTH  
P.O. BOX 476 ELLICOTT CITY, MARYLAND 21043  
TELEPHONE: 461-9933

DISTRICT \_\_\_\_\_

DATE \_\_\_\_\_

TO: THE COUNTY HEALTH OFFICER  
ELLICOTT CITY, MARYLAND

I, HEREBY, APPLY FOR THE NECESSARY TEST IN ORDER TO CONSTRUCT (OR RECONSTRUCT) A SEWAGE DISPOSAL SYSTEM.

PROPERTY OWNER \_\_\_\_\_

ADDRESS \_\_\_\_\_ PHONE \_\_\_\_\_

PROSPECTIVE BUYER \_\_\_\_\_

ADDRESS \_\_\_\_\_ PHONE \_\_\_\_\_

PROPERTY LOCATION:

SUBDIVISION MOBERLY PROP LOT NO. 44

ROAD AND DESCRIPTION Rt 32 off West Ivory Rd

TAX MAP \_\_\_\_\_ PARCEL # \_\_\_\_\_

SIZE OF LOT \_\_\_\_\_ TYPE BLDG. \_\_\_\_\_  
(SINGLE FAMILY DWELLING OR COMMERCIAL)

THE SYSTEM INSTALLED UNDER THIS APPLICATION IS ACCEPTABLE ONLY UNTIL PUBLIC FACILITIES BECOME AVAILABLE. I FULLY UNDERSTAND THE FEE CONNECTED WITH THE FILING OF THIS PERC TEST APPLICATION IS NON-REFUNDABLE UNDER ANY CIRCUMSTANCES. I ALSO AGREE TO COMPLY WITH ALL M.O.S.H.A. REQUIREMENTS IN TESTING THIS LOT.

(SIGNATURE OF APPLICANT)

APPROVED BY \_\_\_\_\_ FOR \_\_\_\_\_ DATE \_\_\_\_\_

REJECTED BY \_\_\_\_\_ FOR \_\_\_\_\_ DATE \_\_\_\_\_

HOLD PENDING FURTHER TESTS \_\_\_\_\_ DATE \_\_\_\_\_

REASONS FOR REJECTION OR HOLDING \_\_\_\_\_


\_\_\_\_\_

\_\_\_\_\_

# THIS IS NOT A PERMIT

Lot 44

# MOBERLY PROP.

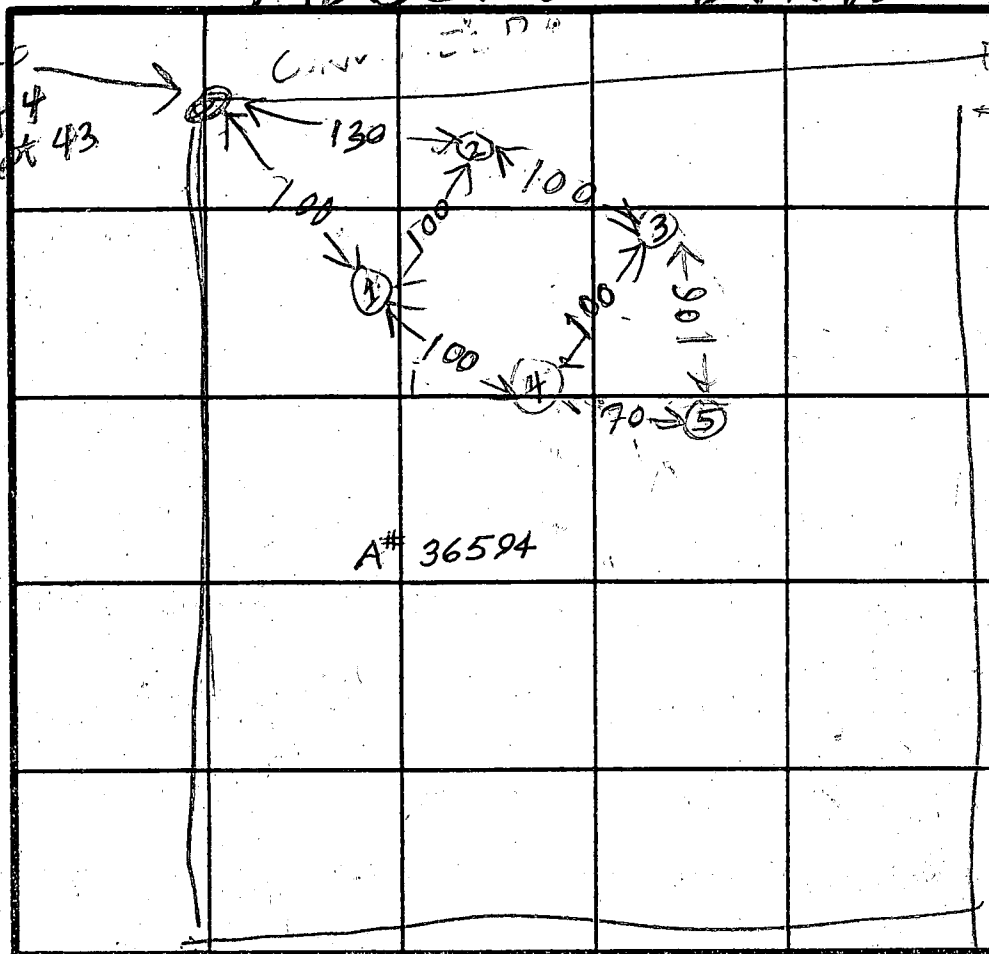

SOIL PROFILE

5.5  
 15  
 ①  
 TAN CLAY TOPSOIL  
 YELLOW BROWN SAND LOAM

5  
 13.5  
 ②  
 BROWN CLAY TOPSOIL  
 TAN BROWN SAND LOAM & SOME SAPROPHITES

3  
 ③  
 BROWN & RED CLAY  
 BROWN SAND LOAM & SOME MILK

11  
 3  
 ④  
 RED BROWN CLAY  
 RED BROWN SAND LOAM & SOME SAPROPHITES  
 EH-12-1079

HOLE #  
 ③ = HIGHEST  
 ②④ = MEDIUM  
 ① = LOWEST

INDICATE NORTH - NAME ADJOINING ROADWAY AS BASE LINE.

ROUTE 3 &

DATE	TEST NO.	DEPTH	PRE-WET		TEST - 1" DROP		TIME
			START	STOP	START	STOP	
2/27/86	①S	4.5	1248	1252	1252	1231	SLOW
	1V	14	LOOKS	OK			
	②S	4.5	1254	112	112	132	SLOW
	2V	13.5	LOOKS	OK			
	3S	4	111	115	115	124	9
	3M	7	1259	108	108	124	16
	3V	11	LOOKS	OK			
	4S	3	101	104	104	109	5
	4V	12	LOOKS	OK			
	⑤N	6.5	148	213	213	213	SLOW
	2M	5.5	153	156	156	200	4
	5S	4	345	347	347	352	5
2/28/86	5V	11	LOOKS	OK			

⑤  
 BROWN CLAY  
 BROWN SAND LOAM

REMARKS: Holes dug per survey on stake EXCEPT ⑤ WHICH WAS EXTRA  
 TYPE OF SOIL: RHODGES  
 TESTED BY: RHODGES  
 ALSO PRESENT: KETTERMANS

C1 6698 SEQUENCE NO. (DENV USE ONLY)

STATE OF MARYLAND WELL COMPLETION REPORT

THIS REPORT MUST BE SUBMITTED WITHIN 45 DAYS AFTER WELL IS COMPLETED.

(THIS NUMBER IS TO BE PUNCHED IN COLS: 3-6 ON ALL CARDS)

COUNTY NUMBER R-36594

DATE RECEIVED

DATE WELL COMPLETED 060199

DEPTH OF WELL 200 (TO NEAREST FOOT)

PERMIT NO. FROM "PERMIT TO DRILL WELL" H0-88-0357

OWNER HOWARD ESTATES DEV. STREET OR RD Regents Row DEED AREA 2000 TOWN GLENELG SUBDIVISION GLEU MOOR SECTION LOT 2

WELL LOG Not required for driven wells STATE THE KIND OF FORMATIONS PENETRATED, THEIR COLOR, DEPTH, THICKNESS AND IF WATER BEARING

Table with columns: DESCRIPTION (Use additional sheets if needed), FEET (FROM, TO), Check if water bearing. Rows include: TOP SOIL (0-2), RED CLAY (2-6), BR. MICA (6-65), TAN MICA (65-120), BLUE MICA (120-200).

GROUTING RECORD WELL HAS BEEN GROUTED (Y) NO (N) TYPE OF GROUTING MATERIAL CEMENT (CM) BENTONITE CLAY (BC) NO. OF BAGS 25 NO. OF POUNDS 2200 GALLONS OF WATER 115 DEPTH OF GROUT SEAL (to nearest foot) from 0 to 53 ft.

CASING RECORD casing types insert appropriate code below: ST CO STEEL CONCRETE PL OT PLASTIC OTHER MAIN CASING TYPE ST Nominal diameter top (main) casing (nearest inch) 60 61 Total depth of main casing (nearest foot) 72 70

OTHER CASING (if used) diameter inch depth (feet) from to

SCREEN RECORD screen type or open hole insert appropriate code below: ST BR HO STEEL BRASS OPEN HOLE PL OT PLASTIC OTHER

DEPTH (nearest ft.) 170 72 200

CIRCLE APPROPRIATE LETTER A WELL WAS ABANDONED AND SEALED WHEN THIS WELL WAS COMPLETED E ELECTRIC LOG OBTAINED P TEST WELL CONVERTED TO PRODUCTION WELL

I HEREBY CERTIFY THAT THIS WELL HAS BEEN CONSTRUCTED IN ACCORDANCE WITH COMAR 10.17.13 "WELL CONSTRUCTION" AND IN CONFORMANCE WITH ALL CONDITIONS STATED IN THE ABOVE CAPTIONED PERMIT, AND THAT THE INFORMATION PRESENTED HEREIN IS ACCURATE AND COMPLETE TO THE BEST OF MY KNOWLEDGE.

DRILLERS IDENT. NO. 41

DRILLERS SIGNATURE (MUST MATCH SIGNATURE ON APPLICATION)

SITE SUPERVISOR (sign. of driller or journeyman responsible for sitework if different from permittee)


SLOT SIZE 1 2 3 DIAMETER OF SCREEN (NEAREST INCH) 56 60

GRAVEL PACK IF WELL DRILLED WAS FLOWING WELL INSERT F IN BOX 68

OEP USE ONLY (NOT TO BE FILLED IN BY DRILLER) T (E.R.O.S.) WQ 70 72 74 75 76 TELESCOPE CASING LOG INDICATOR OTHER DATA


PUMPING TEST HOURS PUMPED (nearest hour) 3 PUMPING RATE (gal. per min. to nearest gal.) 10 METHOD USED TO MEASURE PUMPING RATE Built WATER LEVEL (distance from land surface) BEFORE PUMPING 31 WHEN PUMPING 69 TYPE OF PUMP USED (for test) A air P piston T turbine C centrifugal R rotary O other (describe below) J jet S submersible

PUMP INSTALLED DRILLER WILL INSTALL PUMP YES (NO) IF DRILLER INSTALLS PUMP, THIS SECTION MUST BE COMPLETED FOR ALL WELLS EXCEPT HOME USE TYPE OF PUMP INSTALLED PLACE (A,C,J,P,R,S,T,O) IN BOX - SEE ABOVE: CAPACITY: GALLONS PER MINUTE (to nearest gallon) PUMP HORSE POWER PUMP COLUMN LENGTH (nearest ft.) CASING HEIGHT (circle appropriate box and enter casing height) + above - below LAND SURFACE (nearest foot)

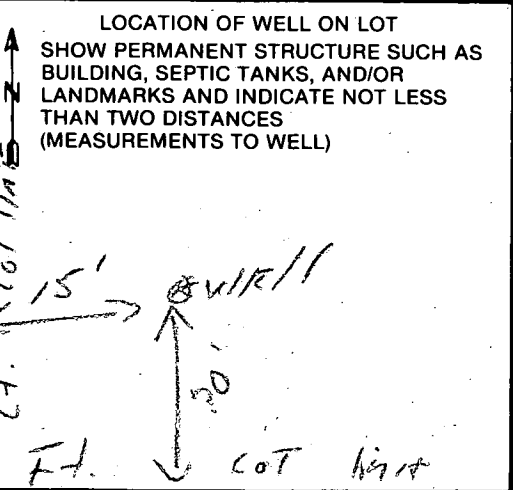

COUNTY

Owner Name: *VARTAN YOUSEFIAN*  
 Property Address: *lot #2 Parliament Ave*  
 Owner Signature: *Vartan Yousefian*  
 Date:

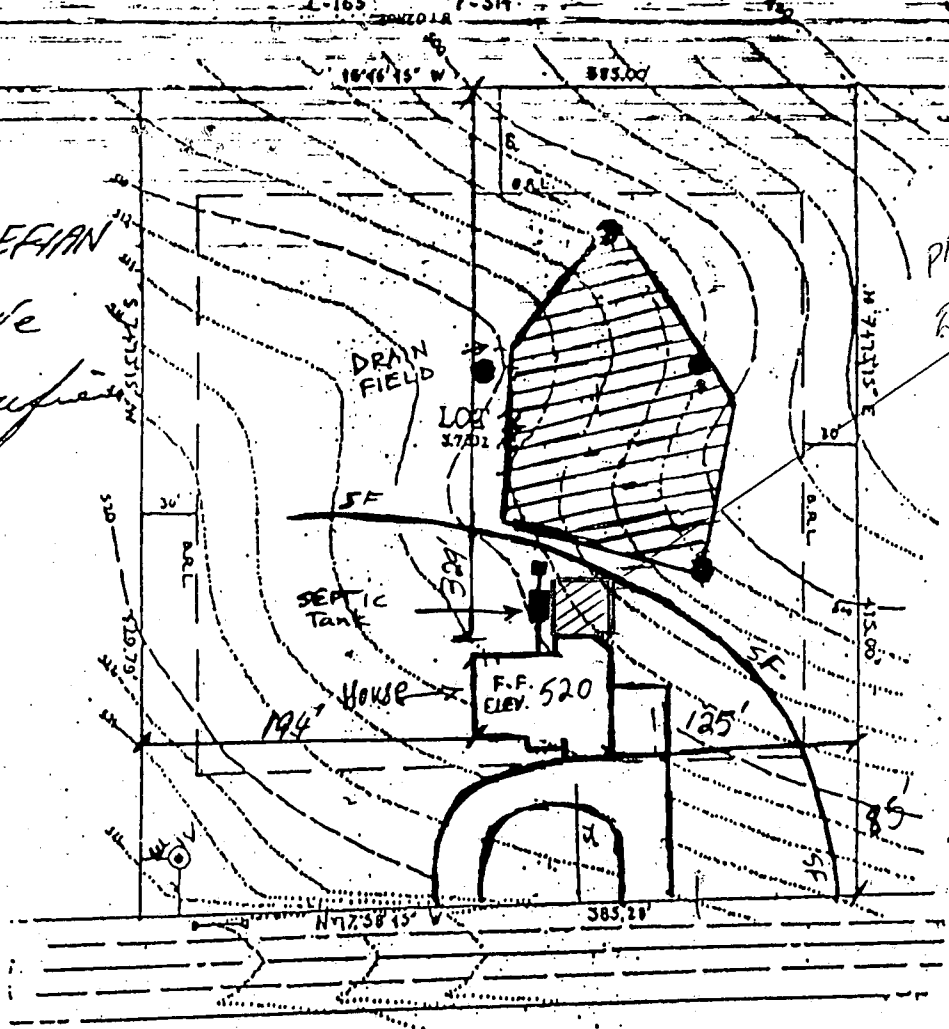

PARLIAMENT PLACE

*4/29/93*  
*OK TO SIGN*  
*BP 48198*  
*B. Hodge*

- 507 Elevation at distribution box
- 506.8 Elevation at inlet to trench
- 507.2 Elevation at outlet from septic tank
- 507.5 Elevation at inlet to septic tank
- 509.5 Elevation at house basement
- 508.5 Elevation at pipe coming from house
- 525 Elevation at well water


*33814*

SCALE 1"=100'

Owner Name: VARTAN YOUSEFIAN  
 Property Address: 1st #2 Parliament Ave  
 Owner Signature: Vartan Yousefian  
 Date:

KINGS GRANT  
LOT 2  
4 BEDROOMS

TANK 32 HOUSE  
46' DIST BOX - KEY

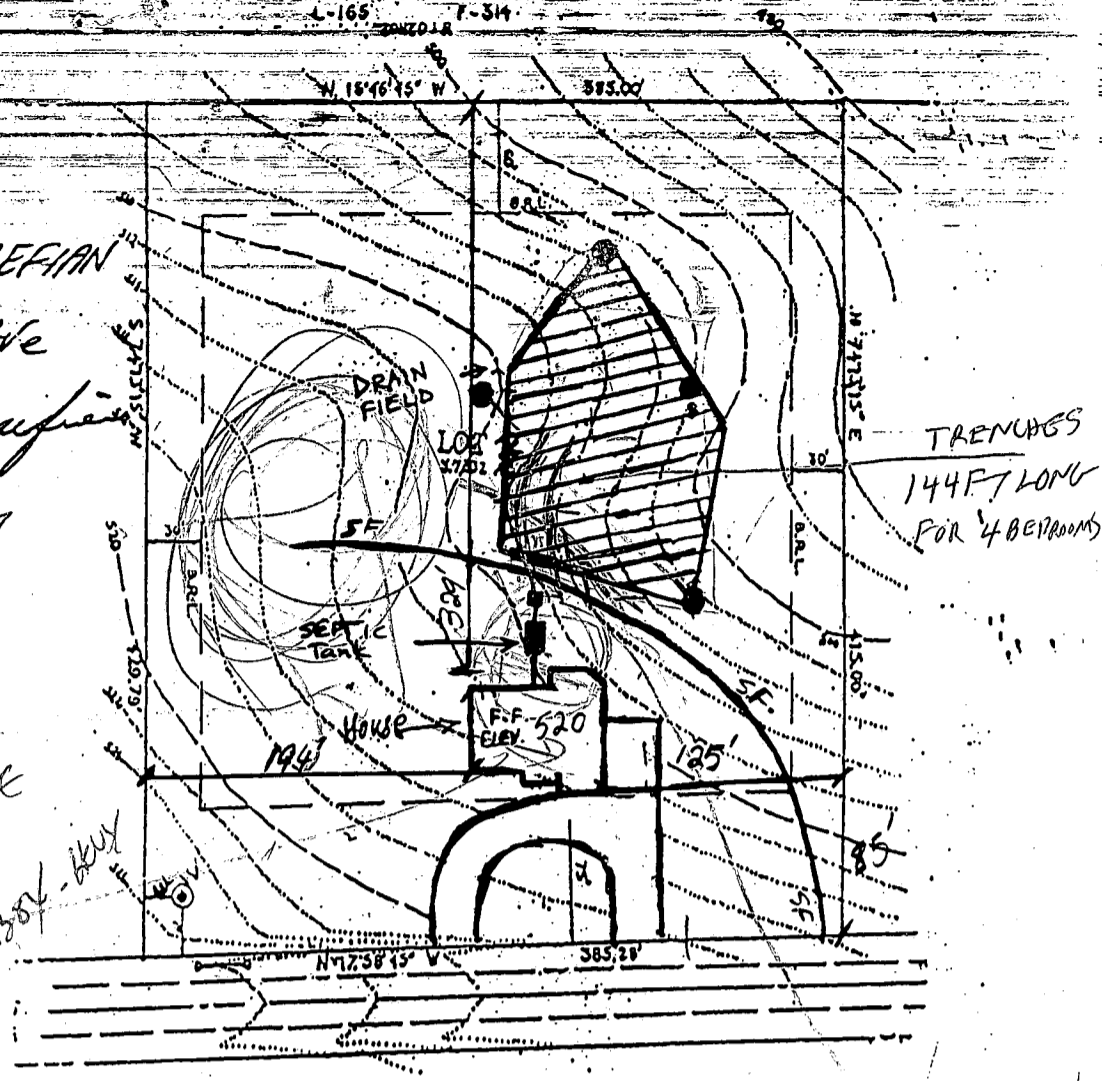

PARLIAMENT PLACE

- 507 Elevation at distribution box
- 506.8 Elevation at inlet to trench
- 507.2 Elevation at outlet from septic tank
- 507.5 Elevation at inlet to septic tank
- 509.5 Elevation at house basement
- 508.5 Elevation at pipe coming from house
- 525 Elevation at well water

PLANS PREPARED BY  
 STEPHEN E DAVIES  
 9051 BRANTON AVENUE PIKE EC 21043  
 410-750 0007

SCALE 1"=100'

4/1/92  
 PLANS NOT QUITE RIGHT  
 MUST CALL OWNER (BID)

4/3/92  
 REVISED PLANS OK  
 AFTER RED LINE CORRECTIONS  
 & ADDITIONS & SPECIAL LETTER ABOUT  
 HOUSE EXCAVATION INSPECTION  
 BUDGES  
 BP 41833

DRAWN BY _____	PERCOLATION TEST PLAT	SCALE 1" = 100'	REVISIONS	
TRACED BY _____	PART OF PARCEL	DATE _____	DATE	BY
CHECKED BY _____	TAX MAP	PROJECT NO. _____		
DRAWING NO. _____	DEED REFERENCE _____	APPROVED _____		