

~~Preliminary~~ Check with Mr. Wine before
believing

APPLICATION

A 10169

F _____

SEWAGE DISPOSAL TESTING

MARYLAND STATE DEPARTMENT OF HEALTH

HOWARD COUNTY

ELLICOTT CITY

Septic tank - 750 gal.
Drywell - 438 sq. ft. sidewall area
below inlet pipe.

DISTRICT 4

DATE 5/13/65

Locate drywell in area tested, approximately ~~475~~⁵⁰⁰ ft. from where left side line intersects back lot line and in the area between 35 ft. to 85 ft. from the left side line as lot is seen when facing it from Carr's Mill Rd.

TO: THE COUNTY HEALTH OFFICER
ELLICOTT CITY, MARYLAND

Mill Rd.

I, HEREBY, APPLY FOR THE NECESSARY TESTS IN ORDER TO CONSTRUCT (OR RECONSTRUCT) A SEWAGE DISPOSAL SYSTEM.

PROPERTY OWNER Elisa Seals

ADDRESS Carr's Mill Rd., Woodbine, Md. PHONE _____

PROPERTY LOCATION:

SUBDIVISION _____ LOT NO. _____

ROAD AND DESCRIPTION Carr's Mill Rd. - across from Howard County dump

OCCUPANT _____ PHONE _____

PERSON TO CONSTRUCT SYSTEM _____

ADDRESS _____ PHONE _____

SIZE OF LOT 7.717 acres TYPE BLDG. 3 NUMBER OF BEDROOMS

IF NOT SINGLE RESIDENCE DESCRIBE _____

SIGNATURE OF APPLICANT Elmer Eugene Mullins


APPROVED BY R. Fletcher FOR Drywell DATE 6/14/65
(KIND OF SYSTEM)

REJECTED BY _____ FOR _____ DATE _____
(KIND OF SYSTEM)

HOLD PENDING FURTHER TESTS _____ DATE _____

REASONS FOR REJECTION OR HOLDING _____

THIS IS NOT A PERMIT

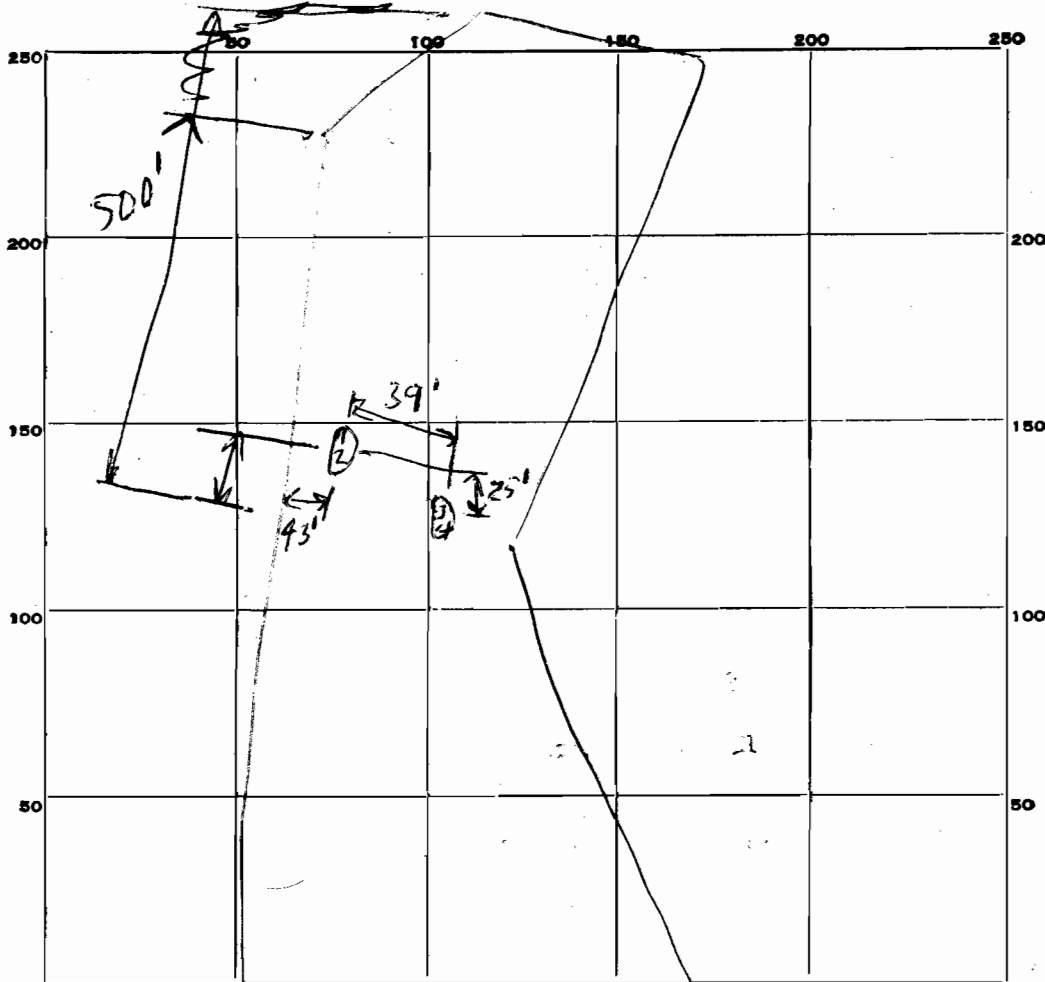

INDICATE NORTH. - NAME ADJOINING ROADWAY AS BASE LINE.

Carrs Mill Rd

DATE	TEST NO.	DEPTH	PRE-WET		TEST - 1" DROP		TIME
			START	STOP	START	STOP	
5/19/65	1	4 ft	10:50	10:56	10:56	11:15	19 min.
	2	9 ft	10:54	11:02	11:02	11:15	13 min.
	3	4 1/2 ft	11:00	11:08	11:08	11:22	14 min.
	4	9 ft	10:58	11:05	11:05	11:12	7 min.

16
2132
2

SOIL AUGER FINDING _____
 TESTED BY JHEPDP 5/19/65
 REMARKS Human Ditch